



CITY OF CANNON BEACH

WATER RESILIENCY PHASE 1 – SEISMIC IMPROVEMENTS

ADDENDUM TO ITB - 4

DATE: August 28, 2023

TO: Potential Bidders

The following change is hereby added to and made part of ITB for the Water Resiliency Phase 1: Seismic Improvements Project.

Questions, Answers, Clarifications and Revisions:

1. Specification 00 01 20 Schedules and Checklist – Schedule has been updated to account for the extension of the bid due date. Due to an unexpected supply issue for a key project component, the bid opening is being extended by 14 days.
 - Bid Due Date – Sept. 13th, 2023
 - Notice of Intent to Award (Estimated) – Sept. 15th, 2023
 - City Council Approval of Award (Estimated) – Oct. 3rd, 2023
 - Notice of Award (Estimated) – Oct. 6th, 2023
 - Anticipated Contractor Start (Estimated) – Oct. 9th, 2023
2. Specification 00 11 13 Invitation to Bidders – Bid due date has been updated to September 13th, 2023 in the first paragraph.
3. Specification 01 10 00 Summary
 - Updated Work Sequence paragraph A in section 1.05.A
 - Updated Water Shut down requirements in section 1.05.B.3
4. Plan Set
 - C102
 - General Notes
 1. City, contractor, and engineer to have a meeting to discuss coordination, responsibilities, and limitations related to water shutdowns.
 - Added North Reservoir Shut Down Notes:
 1. Provide the city one week notice before requiring water shut down to perform work.
 2. City will be able to drain the north reservoir prior to connection work.
 3. Contractor shall minimize the shutdown to no more than 8-hour window. The shutdown window will need to be overnight during a weekday.

4. The city will refill the tank upon completion of the work performed during the shutdown period.
- C103 Added “Or approved equal” to actuator, valve, and flex-tend detail.
 - C104
 - General Notes
 1. City, Contractor, and Engineer to have a meeting to discuss coordination, responsibilities, and limitations related to water shutdowns.
 - Added South Reservoir Shut Down Notes:
 1. Provide the city one week notice before requiring water shut down to perform work.
 2. City will be able to drain the south reservoir prior to the shutdown period. As a result the contractor will not be limited to an 8 hour shut down window.
 3. The city will refill the tank upon completion of the work performed during the shutdown period.
 4. Shut down shall not occur during the high-water demand periods of july/august, labor day weekend, memorial day weekend, and oregon spring break.
 - C105 Added “Or approved equal” to actuator, valve, and flex-tend detail.
 - C106 Added “Or approved equal” to actuator and valve note.



Karen La Bonte
Public Works Director

ADDENDUM NO. 4

**SECTION 00 01 20
SCHEDULES AND CHECKLIST**

ITEMS	DATE
SUBMITTAL AND REVIEW BY BUSINESS OREGON	FRIDAY JULY 14, 2023
INVITATION TO BID (ITB) ISSUED	WEDNESDAY JULY 26, 2023
MANDATORY PRE-BID MEETING	THURSDAY AUGUST 10, 2023 10:00 AM
REQUEST DEADLINE FOR: SUBSTITUTION, CLARIFICATION, OR CHANGE AND SOLICITATION PROTEST DEADLINE	WEDNESDAY AUGUST 16, 2023
LAST ADDENDA ISSUED	MONDAY AUGUST 28, 2023
BIDS DUE/ BID OPENING	WEDNESDAY SEPTEMBER 13, 2023 2:00 PM
FIRST-TIER SUBCONTRACTOR DISCLOSURE	WEDNESDAY SEPTEMBER 13, 2023 4:00 PM
NOTICE OF INTENT TO AWARD (ESTIMATED)	FRIDAY SEPTEMBER 15, 2023
CITY COUNCIL APPROVAL OF AWARD (ESTIMATED)	TUESDAY OCTOBER 3, 2023
NOTICE OF AWARD (ESTIMATED)	OCTOBER 6, 2023
ANTICIPATED CONTRACT START / NOTICE TO PROCEED (ESTIMATED)	OCTOBER 9, 2023
ANTICIPATED SUBSTANTIAL COMPLETION	JANUARY 19, 2024
ANTICIPATED FINAL COMPLETION (ESTIMATED)	MARCH 29, 2024

NOTE: The City of Cannon Beach reserves the right to deviate from this schedule. With current supply chain issues, the project timeline may need to be adjusted accordingly.

BID REQUIREMENTS CHECKLIST

The following is a listing of bid submission components.

SECTION	SECTION NAME	SUBMIT TIME
00 41 00	SIGNED BID FORM – ALL PAGES	SUBMIT WITH BID
	CONSTRUCTION CONTRACTORS BOARD LICENSE	SUBMIT WITH BID
00 41 10	BIDDER RESPONSIBILITY INFORMATION FORM – ALL PAGES	SUBMIT WITH BID
00 41 20	BID BOND	SUBMIT WITH BID
00 41 30	BIDDERS WARRANTY	SUBMIT WITH BID
00 41 40	BIDDERS CERTIFICATIONS	SUBMIT WITH BID
00 41 50	FIRST-TIER SUBCONTRACTOR DISCLOSURE	SUBMIT WITH BID OR WITHIN 2 HOURS AFTER
00 41 60	CERTIFICATE OF NON-COLLUSION	SUBMIT WITH BID
00 41 70	CONTRACTOR'S CERTIFICATION REGARDING DRUG TESTING PROGRAM	SUBMIT WITH BID
00 41 80	PUBLIC IMPROVEMENT CONTRACT	SUBMIT WITH BID
00 72 30	OREGON STATUTORY PUBLIC WORKS BOND	SUBMIT WITH BID
00 72 40	CERTIFICATION OF WORKERS COMPENSATION COVERAGE	SUBMIT WITH BID
00 73 00	ANY ADDITIONAL ITEMS SPECIFIED IN SUPPLEMENTARY INSTRUCTIONS TO BIDDERS	SUBMIT WITH BID

The bid requirements checklist is provided for the bidder's convenience. Bidder is advised to thoroughly review the Invitation to Bid documents to be certain that it has met all requirements and included all required documents, forms and information in its bid. In the event of a conflict between the bid requirements checklist and other Invitation to Bid documents, other Invitation to Bid documents shall take precedence.

END OF SECTION

ADDENDUM NO. 4

**SECTION 00 11 13
INVITATION TO BID**

Sealed bids for the **Cannon Beach Water Resiliency Project Phase 1 – Seismic Improvements** Project will be received by Karen La Bonte, Public Works Director, for the Owner, City of Cannon Beach, at 163 E Gower, Cannon Beach, Oregon 97110 at **2:00 p.m., Pacific Time, on Wednesday, September 13, 2023**, at which time and place they will be publicly opened and read aloud at the address listed above unless government restrictions prevent that from happening. In that case, the City will arrange for a virtual bid opening via Zoom. No bids will be accepted after this time.

All bidders shall submit, in a separate, sealed envelope, within two working hours of the bid opening time, on the bid date, a completed First-Tier Subcontractor Disclosure Form in compliance with ORS 279C.370.

In general, the elements of work include, but are not limited to:

- Removal of roadway materials and watermain structures, valves and piping.
- Site Grading
- Watermain
- Reservoir Improvements
- Isolation Valve Installation
- Electrical Controls Installation
- Shake Alarm System Installation

Responsive bidders shall demonstrate proven experience working around sensitive, critical infrastructure like watermain, reservoirs, seismic control panels, work within City limits, etc.

Project bidding documents are available electronically by contacting Tessa Schutt at schutt@ci.cannon-beach.or.us or 503-436-8048, or can be viewed at City of Cannon Beach, at 163 E Gower, Cannon Beach, Oregon 97110.

This PROJECT IS subject to both Prevailing Wage Rates and Davis Bacon. All bidders shall comply with the provisions of ORS 279C.800-870 [workers on public works to be paid not less than prevailing rate of wage for projects over \$50,000.00] and the Federal Department of Labor's Davis-Bacon Wage Determination. Contractors submitting bids are required to be registered with the Construction Contractor's Board.

A mandatory pre-bid conference will be held **Thursday, August 10 at 10:00 am** at the public works yard site located at 365 Elk Creek Road, Cannon Beach, OR 97110.

Statements made by the City's Representative OR City Personnel at the conference are not binding on the City unless confirmed by written addendum by the City.

Bid security in the amount of not less than 5% of the bid must accompany each bid in accordance with the Instructions to Bidders. The Owner reserves the right to reject any bid not in compliance with all prescribed public bidding procedures and requirements, may reject a bid that does not comply with requirement to demonstrate bidder's responsibility under ORS 279C.375(3)(b), and may reject, for good cause, any or all bids upon a finding of the Owner that it is in the public interest to do so in accordance with ORS 279C.395. The Owner reserves the right to waive any bid irregularities or informalities. No bidder may withdraw or modify the bidder's bid after the hour set for the opening thereof, until after the lapse of 30 days from the bid opening.

The selected contractor and all contractors performing work within the City are required to obtain a City business license prior to start of work.

Advertised in the Astorian (Tu/Th/Sa) July 27, 29; August 1, 3, 5, 8, 10, 12, 15, 17, 19.

Advertised in the DJC (M/W/F) July 26, 28, 31; August 2, 4, 9, 11, 14, 16, 18, 21.

BY ORDER OF THE CITY OF CANNON BEACH

END OF SECTION

ADDENDUM NO. 4

**SECTION 01 10 00
SUMMARY**

PART 1 GENERAL

1.01 PROJECT

- A. Project Name: **Cannon Beach Water Resiliency Project Phase 1 - Seismic Improvements**
- B. Owner's Name: City of Cannon Beach
- C. Engineer's Name: Windsor Engineers.
- D. Additional Project contact information is specified in Section 00 01 02 - Project Information.
- E. Summary Project Description: The project consists of the construction of or improvements to reservoir tanks, valves, and watermain pipe as it relates to seismic activities. An addition of an isolation valve to aid in dividing the city's water system into smaller zones in case of a seismic emergency.

1.02 CONTRACT DESCRIPTION

- A. Contract Type: A single prime contract based on a Contractor Provided Bid as described in Document 00 41 80 – Example Public Improvement Contract Form

1.03 OWNER OCCUPANCY

- A. Owner intends to occupy the Project upon Substantial Completion.
- B. Cooperate with Owner to minimize conflict and to facilitate Owner's operations.
- C. Schedule the Work to accommodate Owner occupancy.

1.04 CONTRACTOR USE OF SITE AND PREMISES

- A. Provide access to and from site as required by law and by Owner:
 - 1. Do not obstruct roadways, sidewalks, or other public ways without permit.

1.05 WORK SEQUENCE

- A. There are four sites within this project. It is required that work activities that significantly impacts water operations (i.e. shutdowns) would be isolated to one site at a time with substantial completion of work being completed before starting at the next location. The city is fine with site grading and electrical work being done at multiple sites as long as it doesn't prolong impacts to the city, water supply, and tourist activities.
- B. The following tasks must be done one at a time and coordinated with the city, neighboring properties, and other jurisdictions.
 - 1. Temporary traffic control
 - 2. Road / access closures
 - 3. Watermain shutdown / connections
 - a. General
 - 1) City, Contractor, and Engineer to have a meeting to discuss coordination, responsibilities, and limitations related to water shutdowns.
 - b. North Reservoir
 - 1) Provide the city one week notice before requiring water shut down to perform work.
 - 2) City will be able to drain the north reservoir prior to connection work.
 - 3) Contractor shall minimize the shutdown to no more than 8-hour window. The shutdown window will need to be overnight during a weekday.
 - 4) The City will refill the tank upon completion of the work performed during the shutdown period.
 - c. South Reservoir

- 1) Provide the city one week notice before requiring water shut down to perform work.
- 2) City will be able to drain the south reservoir prior to the shutdown period. As a result the Contractor will not be limited to an 8 hour shut down window.
- 3) The City will refill the tank upon completion of the work performed during the shutdown period.
- 4) Shut down shall not occur during the high-water demand periods of July/August, Labor Day Weekend, Memorial Day Weekend, and Oregon spring break.

1.06 SPECIFICATION SECTIONS APPLICABLE TO EVERY CONTRACT

- A. Unless otherwise noted, provisions of the sections listed below apply to every contract. Specific items of work listed under individual contract descriptions constitute exceptions.
- B. Section 01 20 00 - Price and Payment Procedures.
- C. Section 01 22 00 - Unit Prices.
- D. Section 01 32 16 - Construction Progress Schedule.
- E. Section 01 40 00 - Quality Requirements.
- F. Section 01 41 00 – Regulatory Requirements
- G. Section 01 50 00 - Temporary Facilities and Controls.
- H. Section 01 51 00 – Temporary Utilities
- I. Section 01 55 00 – Vehicular Access and Parking
- J. Section 01 57 13 - Temporary Erosion and Sediment Control
- K. Section 01 58 13 - Temporary Project Signage.

PART 2 PRODUCTS - NOT USED

PART 3 EXECUTION - NOT USED

END OF SECTION

ENGINEERING PLANS

FOR

WATER RESILIENCY PROJECT

PHASE 1 - SEISMIC IMPROVEMENTS

CITY OF CANNON BEACH, OR 97110

PREPARED FOR:
CITY OF CANNON BEACH
163 E. GOWER, PO BOX 368
CANNON BEACH, OREGON 97110
CONTACT: KAREN LA BONTE
PHONE: (503) 436-8068
EMAIL: LABONTE@CI.CANNON-BEACH.OR.COM



VICINITY MAP
NOT TO SCALE



PREPARED BY:



**WINDSOR
ENGINEERS**

Vancouver, WA
Duluth + Minneapolis, MN
www.windsorengineers.com

Copyright 2022 By Windsor Engineers, LLC
All Rights Reserved.



CONTACT: TRAVIS TORMANEN
PHONE: (360) 903-9281
EMAIL: TTORMANEN@WINDSORENGINEERS.COM

PROJECT NUMBER: 20198.3



LOCATION MAP
NOT TO SCALE

SHEET INDEX

- G001 COVER SHEET
- G002 CIVIL NOTES AND ABBREVIATIONS
- G003 LEGENDS
- G004 KEY PLAN - NORTH
- G005 KEY PLAN - CENTER
- G006 KEY PLAN - SOUTH
- C000 EXISTING CONDITIONS AND DEMOLITION PLAN - MAIN RESERVOIR
- C001 EXISTING DETAILS - MAIN RESERVOIR
- C002 EXISTING CONDITIONS AND DEMOLITION PLAN - NORTH RESERVOIR
- C003 EXISTING DETAILS - NORTH RESERVOIR
- C004 EXISTING CONDITIONS AND DEMOLITION PLAN- TOLOVANA RESERVOIR
- C005 EXISTING DETAILS - SOUTH-TOLOVANA RESERVOIR
- C006 EXISTING CONDITIONS - ISOLATION VALVE 4
- C100 SITE & EROSION CONTROL PLAN - MAIN RESERVOIR
- C101 VAULT AND VALVE DETAILS - MAIN RESERVOIR
- C102 SITE & EROSION CONTROL PLAN - NORTH RESERVOIR
- C103 VAULT AND VALVE DETAILS - NORTH RESERVOIR
- C104 SITE & EROSION CONTROL PLAN - TOLOVANA RESERVOIR
- C105 VAULT AND VALVE DETAILS- TOLOVANA RESERVOIR
- C106 SITE & EROSION CONTROL PLAN - ISOLATION VALVE 4
- C190 SITE DETAILS
- C191 SITE DETAILS
- C290 TRAFFIC CONTROL - TOLOVANA RESERVOIR
- C291 TRAFFIC CONTROL - ISOLATION VALVE 4
- C292 TRAFFIC CONTROL DETAILS
- C293 TRAFFIC CONTROL DETAILS
- C294 TRAFFIC CONTROL DETAILS
- C590 WATER DETAILS
- C591 WATER DETAILS
- E001 COVER SHEET - ELECTRICAL
- E101 SITE PLAN - MAIN RESERVOIR
- E102 SITE PLAN - SOUTH TOLOVANA RESERVOIR
- E103 SITE PLAN - NORTH RESERVOIR
- E204 SITE PLAN ISOLATION VALVE 4
- E501 DETAILS - ELECTRICAL
- E502 RESERVOIR ONE-LINE DIAGRAM
- E601 RESERVOIR ONE-LINE DIAGRAM
- E602 ISOLATION VALVE ONE-LINE DIAGRAM
- E701 TYPICAL CONTROL PANEL ELEVATIONS
- E801 SCADA NETWORK DIAGRAM

CITY OF CANNON BEACH			
BY _____	DATE _____		
PUBLIC WORKS DIRECTOR			
BY _____	DATE _____		
CITY ENGINEER			
BY _____	DATE _____		
COMMUNITY DEVELOPMENT DIRECTOR			
BY _____	DATE _____		
FIRE MARSHAL			

REVISIONS:

1	8/24/2023	ADDENDUM #1
4	8/28/2023	ADDENDUM #4

PLOT DATE: 02/28/2023 4:23 PM - FILE: C:\Users\MARCUSJ\OneDrive - Windsor Engineers\05_Projects\2020\20198-3 Cannon Beach Seismic Valves\02_Drawings\01_Working\04_Final Sheets\20198-3_titles.dwg

PROJECT NOTES

UTILITY IMPROVEMENTS TO THE CITY'S WATERMAIN. IMPROVEMENTS WILL BE SITE SPECIFIC AND LIMITED TO A SMALL AREA OVER THE WATERMAIN TO ADD SEISMIC VALVES AND POWER TO OPERATE THE VALVES. THE WORK WILL ENTAIL PLACING A VAULT OR MANHOLE STRUCTURE OVER THE EXISTING WATERMAIN TO BE ABLE TO HOUSE AND ADD THE NEEDED SEISMIC VALVES TO THE SYSTEM. IN ADDITION TO THE VAULTS AND MANHOLES ROUGHLY 20' OF PIPE WILL BE REPLACED. THERE ARE A COUPLE PLACES WHERE ASBESTOS CONCRETE PIPE WILL BE REMOVED AND REPLACED WITH A PLASTIC C900 PIPE.

PARCEL NO.(S): VARIES - CITY OF CANNON BEACH

SITE ADDRESS: VARIES - CITY OF CANNON BEACH

QUARTER SECTION: VARIES - CITY OF CANNON BEACH

COUNTY: CLATSOP

CRITICAL AREAS:

1. NO CRITICAL AREAS ARE WITHIN THE CONSTRUCTION LIMITS OF THE PROJECT.

CONTACT INFORMATION

APPLICANT / PROPERTY OWNER

CITY OF CANNON BEACH
CONTACT:
TREVOR MOUNT (503) 436-8066
MOUNT@CI.CANNON-BEACH.OR.US

SURVEYOR
ONION PEAK
CONTACT:
ERICK WHITE (503) 440-4403
ERICK.OPD@GMAIL.COM

GEOTECHNICAL ENGINEER
PALI CONSULTING
CONTACT:
TOM BLACKWOOD (503) 502-0820
TIM@PALI-CONSULTING.COM

REPRESENTATIVE / CONTACT

WINDSOR ENGINEERS, LLC
27300 NE 10TH AVE.
RIDGEFIELD, WA 98642
CONTACT:
TRAVIS TORMANEN (320) 903-9281
TTORMANEN@WINDSORENGINEERS.COM

GENERAL ABBREVIATIONS

(E)	EXISTING
C	CONCRETE
CB	CATCH BASIN
CL	CENTERLINE
CNS	COMPACTED NATIVE SOIL
CO	CLEAN OUT
CR	CURB RETURN
D	DIRT / DRAINAGE
DCDA	DOUBLE CHECK DETECTOR ASSEMBLY
FG	FINISHED GRADE
FH	FIRE HYDRANT
FL	FLOW LINE
FM	FORCE MAIN
G	NATURAL GAS (LOW PRESSURE)
GB	GRADE BREAK
HP	HIGH POINT
LF	LINEAR FOOT
LP	LOW POINT
MG	NATURAL GAS (MEDIUM PRESSURE)
MG	MATCH EXISTING GRADE
MH	MANHOLE
NS	NATIVE SOIL
NTS	NOT TO SCALE
P	PAVEMENT
PC	POINT OF CURVATURE
POC	POINT OF CONNECTION
POS	POINT OF SERVICE
PP	POWER POLE
PT	POINT OF TANGENCY
R	RADIUS
ROW	RIGHT OF WAY
S	SLOPE / SANITARY
SAN	SEWER SEWER
SSMH	SANITARY MANHOLE
STA	STATION
STM	STORM DRAIN
STMH	STORM MANHOLE
TBD	TO BE DETERMINED
TBL	TO BE RELOCATED BY RESPECTIVE UTILITY
TBR	TO BE REMOVED BY CONTRACTOR
TC	TOP OF CURB
TOE	TOE OF BANK
TOP	TOP OF BANK
TP	TELEPHONE POLE
U	UNDERGROUND
VIP	VERIFY IN FIELD PRIOR TO CONSTRUCTION
W	WATER MAIN
XFMR	TRANSFORMER

GENERAL PLAN NOTES

1. CONTRACTOR TO VERIFY ALL UTILITY LOCATIONS AND DEPTHS PRIOR TO CONSTRUCTION. A MINIMUM OF TWO FULL BUSINESS DAYS PRIOR TO BEGINNING CONSTRUCTION, THE CONTRACTOR SHALL CALL 811 (UTILITY NOTIFICATION CENTER) FOR LOCATION MARK-UP OF EXISTING UTILITIES
2. ALL CONSTRUCTION, MATERIALS, AND WORKMANSHIP SHALL CONFORM TO THE LATEST STANDARDS AND PRACTICES OF CLATSOP COUNTY AND THE LATEST EDITION OF THE "STANDARD SPECIFICATIONS FOR ROAD, BRIDGE, AND MUNICIPAL CONSTRUCTION" PREPARED BY OSDOT
3. IN CASE OF A CONFLICT BETWEEN THE REGULATORY STANDARDS OR SPECIFICATIONS, THE MORE STRINGENT REQUIREMENT WILL PREVAIL.
4. ANY CHANGES TO THE DESIGN AND/OR CONSTRUCTION SHALL BE APPROVED BY THE OWNER OR ENGINEER.
5. APPROVAL OF THESE PLANS DOES NOT CONSTITUTE AN APPROVAL OF ANY OTHER CONSTRUCTION NOT SPECIFICALLY SHOWN ON THE PLANS. PLANS FOR STRUCTURES SUCH AS BRIDGES, BUILDINGS, TANKS, VAULTS, ROCKERIES, AND RETAINING WALLS MAY REQUIRE A SEPARATE REVIEW AND APPROVAL BY THE BUILDING DEPARTMENT PRIOR TO CONSTRUCTION.
6. A COPY OF THESE APPROVED PLANS SHALL BE ON THE JOB SITE WHENEVER CONSTRUCTION IS IN PROGRESS.
7. IT SHALL BE THE CONTRACTOR'S RESPONSIBILITY TO OBTAIN ALL CONSTRUCTION EASEMENTS AND PERMITS NECESSARY TO PERFORM THE WORK.
8. THE CONTRACTOR IS RESPONSIBLE FOR ALL CONSTRUCTION STAKING.
9. PUBLIC AND PRIVATE DRAINAGEWAYS SHALL BE PROTECTED FROM POLLUTION. NO MATERIAL IS TO BE DISCHARGED TO OR DEPOSITED IN STORMWATER SYSTEMS THAT MAY RESULT IN VIOLATION OF STATE OR FEDERAL WATER QUALITY STANDARDS.
10. ALL CONSTRUCTION WITHIN THE PUBLIC RIGHT-OF-WAY SHALL HAVE AN APPROVED PUBLIC RIGHT-OF-WAY WORK PERMIT PRIOR TO ANY CONSTRUCTION ACTIVITY WITHIN THE RIGHT-OF-WAY.
11. THE CONTRACTOR SHALL BE RESPONSIBLE FOR PROVIDING ADEQUATE SAFEGUARDS, SAFETY DEVICES, PROTECTIVE EQUIPMENT, FLAGGERS, AND ANY OTHER NEEDED ACTIONS TO PROTECT THE LIFE, HEALTH, AND SAFETY OF THE PUBLIC, AND TO PROTECT PROPERTY IN CONNECTION WITH THE PERFORMANCE OF WORK COVERED BY THE CONTRACTOR. ALL TRAFFIC CONTROL DEVICES SHALL CONFORM TO THE LATEST ADOPTED EDITION OF THE "MANUAL ON UNIFORM TRAFFIC CONTROL DEVICES" (MUTCD) PUBLISHED BY THE U.S. DEPARTMENT OF TRANSPORTATION. TWO-WAY TRAFFIC MUST BE MAINTAINED AT ALL TIMES ON THE ADJACENT PUBLIC STREETS.
12. ANY PUBLIC OR PRIVATE CURB, GUTTER, SIDEWALK, OR ASPHALT DAMAGED DURING CONSTRUCTION SHALL BE REPAIRED TO CITY/COUNTY STANDARDS AND PRACTICES.
13. THE CONTRACTOR SHALL BE RESPONSIBLE FOR MAINTAINING THE INTEGRITY OF ADJACENT UTILITIES WHICH MAY INCLUDE, BUT ARE NOT LIMITED TO, WATER, SANITARY SEWER, STORMWATER, POWER, TELEPHONE, CABLE TV, GAS, IRRIGATION, AND STREET LIGHTING. THE CONTRACTOR SHALL NOTIFY RESIDENTS AND BUSINESSES 48 HOURS IN ADVANCE OF ANY WORK AFFECTING ACCESS OR SERVICE AND SHALL MINIMIZE INTERRUPTIONS TO DRIVEWAYS FOR RESIDENTS AND BUSINESSES ADJACENT TO THE PROJECT.
14. ALL LAWN AND VEGETATED AREAS DISTURBED WILL BE RESTORED TO ORIGINAL CONDITION. ANY DISBURANCE OR DAMAGE TO OTHER PROPERTY ON ADJACENT PARCELS OR IN THE PUBLIC RIGHT OF WAY SHALL ALSO BE REPAIRED OR RESTORED TO ORIGINAL CONDITION.
15. ALL MATERIALS AND METHODS OF CONSTRUCTION AND INSTALLATION FOR WATER, SANITARY SEWER, AND STORM FACILITIES SHALL CONFORM TO THE CITY OF CANNON BEACH DESIGN GUIDELINES. CONSTRUCTION SHALL BE AS PER THE MOST CURRENT STANDARD DETAIL CONTAINED THEREIN.
16. THE TYPES, LOCATIONS, SIZES AND/OR DEPTHS OF EXISTING UNDERGROUND UTILITIES AND STRUCTURES AS SHOWN ON THE DRAWINGS ARE APPROXIMATE AND WERE OBTAINED FROM SOURCES OF VARYING RELIABILITY. THE CONTRACTOR IS CAUTIONED THAT ONLY ACTUAL EXCAVATION WILL REVEAL THE TYPES, EXTENT, SIZES, LOCATIONS, AND DEPTHS OF UTILITIES. A REASONABLE EFFORT HAS BEEN MADE TO LOCATE AND DELINEATE ALL KNOWN UNDERGROUND UTILITIES. THE CONTRACTOR SHALL VERIFY THE LOCATION OF AND PROVIDE PROTECTION FOR ALL UTILITIES AND STRUCTURES.
17. EXISTING UTILITIES DAMAGED BY THE CONTRACTOR SHALL BE REPAIRED BY THE CONTRACTOR OR BY THE UTILITY.
18. WHERE THE CONTRACTOR MUST RELOCATE WATER AND GAS UTILITIES, SHUTDOWN SHALL ONLY BE ACCOMPLISHED BY THE CITY OR UTILITY PURVEYOR.
19. ALL OPEN TRENCHES THAT IMPACT PUBLIC ACCESS OR OTHER PROJECT WORK ACCESS OUTSIDE OF THIS PROJECTS SITE, MUST BE STEEL PLATED OR BACKFILLED AND PAVED WITH AT LEAST 2" OF COLD MIX TO ADJACENT EXISTING GRADE AT THE END OF EACH WORKDAY.
20. NOTIFY ADJACENT RESIDENCES AT LEAST ONE DAY PRIOR TO COMMENCING WORK ADJACENT TO THEIR RESIDENCES.
21. SAWCUT ALL PAVEMENT JOINT LINES, WHERE THERE IS A PREVIOUS PAVING EDGE OR CRACK WITHIN 5' OF THE SAWCUT EDGE, REMOVE THE PAVEMENT TO THE PREVIOUS PAVING EDGE.
22. THE CONTRACTOR SHALL COMPLY WITH OREGON REQUIREMENTS FOR TRENCH SAFETY.
23. THE CONTRACTOR SHALL REPLACE ALL SURVEY MONUMENTS THAT ARE DESTROYED BY THE CONSTRUCTION.
24. ALL WATER PIPING SHALL BE CONSTRUCTED WITH 3' MINIMUM COVER, 1' VERTICAL SEPARATION BETWEEN UTILITIES, AND A MINIMUM OF 10' HORIZONTAL SEPARATION AND 18" ABOVE SEWER LINES, UNLESS OTHERWISE NOTED.
25. THE CONTRACTOR SHALL RESTORE PAVEMENT AND LANDSCAPING DISTURBED BY THE CONSTRUCTION TO THE PREVIOUSLY UNDISTURBED CONDITION.
26. CONTRACTOR TO DISPOSE OF TREES, SHRUBS, SOD AND OTHER DEBRIS IN A PROPER MANNER OF THE CONTRACTOR'S CHOOSING.
27. CONTRACTOR IS RESPONSIBLE FOR KEEPING ALL ROADS, SIDEWALK, AND TRAILS CLEAN AND CLEAR FROM CONSTRUCTION MATERIAL AND DEBRIS.

GENERAL CIVIL NOTES

SURVEY
TOPOGRAPHIC SURVEY BY: ONION PEAK
HORIZONTAL DATUM: OREGON STATE PLANES NORTH ZONE
ELEVATION DATUM: NAD 83

STORM DRAINAGE:
ON-SITE STORM SEWER IMPROVEMENTS SHALL CONFORM TO THE LATEST VERSION OF THE DEQ, AND CONFORM TO ODOT SPECIFICATIONS WHERE NOTED.

THE CONTRACTOR SHALL MAINTAIN 6" MINIMUM VERTICAL AND 3' MINIMUM HORIZONTAL CLEARANCE (OUTSIDE SURFACES) BETWEEN STORM DRAIN PIPES AND OTHER UTILITY PIPES AND CONDUITS. FOR CROSSINGS OF SANITARY SEWER LINES, THE OREGON HEALTH AUTHORITY CRITERIA APPLY.

STORM DRAIN PIPE, BENDS, AND FITTINGS SHALL BE PVC, ASTM D 3034, SDR 35, OR SMOOTH INTERIOR, HIGH DENSITY POLYETHYLENE CORRUGATED PIPE AASHTO M252 OR M284, TYPE S AS PRODUCED AND SPECIFIED BY ADS, PRODUCT NAME N12, OR APPROVED EQUAL. ALL STORM SEWER FITTINGS AND PIPE JOINTS SHALL BE GASKETED.

PERFORATED PIPE SHALL BE ADS SINGLE WALL PERFORATED PIPE WITH SOCK OR APPROVED EQUAL.

ALL STORM SEWER PIPE SHALL HAVE A MINIMUM 12" DIAMETER WITHIN ROADWAY

ALL ON-SITE STORMWATER FACILITIES SHALL BE PRIVATELY MAINTAINED BY THE CURRENT OR FUTURE PROPERTY OWNER(S).

ALL VAULT, UTILITY BOX, INLET, MANHOLE AND CLEANOUT RIMS SHALL BE ADJUSTED TO FINISH GRADE UNLESS OTHERWISE NOTED.

IT SHALL BE THE CONTRACTOR'S RESPONSIBILITY TO PROTECT AND MAINTAIN ANY STORM SYSTEM PIPING TO EXISTING DRAINAGE APPURTENANCES TO REMAIN.

SANITARY SEWER:
ON-SITE (PRIVATE) SANITARY SEWER IMPROVEMENTS SHALL CONFORM TO THE LATEST VERSION OF THE DEQ, AND ODOT SPECIFICATIONS WHERE NOTED AND THE CITY OF CANNON BEACH GENERAL REQUIREMENTS.

SANITARY SEWER PIPE SHALL BE POLYVINYL CHLORIDE (PVC) AND CONFORM TO ASTM D3034, SDR35.

CONTRACTOR SHALL COORDINATE ALL BUILDING SANITARY CONNECTIONS WITH PLUMBING PLAN PRIOR TO CONSTRUCTION.

CONTRACTOR IS RESPONSIBLE FOR ALL PERMITS AND INSPECTIONS.

WATER:
ALL WATERMAIN INSTALLATION, DISINFECTION AND TESTING SHALL COMPLY WITH ODOT STANDARD SPECIFICATIONS, UNIFORM PLUMBING CODE, AND CITY OF CANNON BEACH WATER DESIGN AND CONSTRUCTION STANDARDS.

STANDARD DETAIL STATEMENT
ALL MATERIALS AND METHODS OF CONSTRUCTION AND INSTALLATION FOR WATER, SEWER, STORM WATER FACILITIES, AND EROSION CONTROL MEASURES, SHALL CONFORM TO CITY OF CANNON BEACH ENGINEERING SERVICES "TOLEDO DEVELOPMENT GUIDELINES." CONSTRUCTION SHALL BE AS PER THE MOST CURRENT STANDARD DETAIL CONTAINED THEREIN.

GRADING & EROSION CONTROL NOTES

NO GRADING WITHIN 2' OF ADJACENT PARCELS PER IBC.

STRIP ORGANICS PER GEOTECH REPORT. RE-DEPOSIT ABOVE COMPACTED FILL TO A MAX DEPTH OF 6" (12" IN LANDSCAPE AREAS).

FINISH GRADE CONTOURS ARE TO TOP OF FINISHED SURFACE IN IMPERVIOUS AREAS AND TOP OF REPLACED STRIPPINGS IN PERVIOUS AREAS.

STRIPPINGS TO REMAIN ON SITE AND BE RE-DISTRIBUTED OVER LANDSCAPE AREAS AFTER ALL GRADING ACTIVITIES ARE COMPLETED. CONTRACTOR SHALL BE RESPONSIBLE FOR HAUL-OFF OF EXCESS MATERIAL.

CUT AND FILL QUANTITIES ARE BASED ON GENERAL SITE GRADING ESTABLISHED FROM THE STRIPPED GRADE TO THE FINISHED PROPOSED SUBGRADE AND TRENCH SPOILS. THESE VOLUMES DO NOT TAKE INTO ACCOUNT ANY UNKNOWN SOIL DEPOSITS OR OVER-EXCAVATION OF NON-ORGANIC MATERIALS THAT ARE DISCOVERED ON SITE, NOR WET WEATHER CONDITIONS. CONTRACTOR SHALL BE RESPONSIBLE TO PRODUCE INDEPENDENT GRADING VOLUMES AS WELL AS ACCOUNT FOR OBSERVATION OF MEASURES DIRECTED WITHIN THE GEOTECHNICAL REPORT OR AS DIRECTED BY THE GEOTECHNICAL ENGINEER DURING THE COURSE OF CONSTRUCTION.

PRIOR TO ACCEPTANCE OF THE COMPACTED SUB-GRADE, THE CONTRACTOR SHALL PROVIDE A TEST ROLL IN THE PRESENCE OF OWNER / CITY REPRESENTATIVE UNLESS OTHERWISE APPROVED BY THE GEOTECHNICAL ENGINEER.

AMERICANS WITH DISABILITIES ACT (ADA) NOTES

1. CONTRACTORS SHALL EXERCISE APPROPRIATE CARE AND PRECISION IN CONSTRUCTION OF ADA ACCESSIBLE COMPONENTS ON THE PROJECT. THE ADA COMPONENTS MUST COMPLY WITH ALL LOCAL, STATE, AND FEDERAL ACCESSIBILITY RULES, CODES, AND REGULATIONS.
2. FINISHED SURFACES ALONG THE ACCESSIBLE PATH OF TRAVEL FROM PARKING STALLS, PUBLIC TRANSPORTATION, AND PEDESTRIAN ACCESS WAYS TO THE POINT(S) OF ACCESSIBLE BUILDING INGRESS AND EGRESS SHALL COMPLY WITH ADA CODE REQUIREMENTS.
3. PARKING SPACE AND AISLE SLOPE SHALL NOT EXCEED 1:48 (1/4" PER FOOT OR NOMINALLY 2.0%) IN ANY DIRECTION.
4. CURB RAMP SLOPE SHALL NOT EXCEED 1:12 (8.3%) AND RAMP LENGTH IS LIMITED TO 15 FEET.
5. LANDINGS SHALL BE PROVIDED AT EACH END OF RAMPS, SHALL HAVE POSITIVE DRAINAGE, AND SHALL NOT EXCEED 1:48 (1/4"PER FOOT OR NOMINALLY 2.0%) IN ANY DIRECTION.
6. PATH OF TRAVEL ALONG ACCESSIBLE ROUTE SHALL PROVIDE A MINIMUM OF 36 INCH UNOBSTRUCTED WIDTH OF TRAVEL. SLOPE SHALL BE NO GREATER THAN 1:20 (5.0% OR 5/8" PER FOOT) IN THE DIRECTION OF TRAVEL, AND SHALL NOT EXCEED 1:48 (1/4" PER FOOT OR NOMINALLY 2.0%) IN CROSS SLOPE. WHERE PATH OF TRAVEL BE GREATER THAN 1:20 (5.0%), AN ACCESSIBLE RAMP WITH A MAXIMUM SLOPE OF 1:12 (8.3%) FOR A MAXIMUM DISTANCE OF 30 FEET SHALL BE PROVIDED INCLUDING HANDRAILS. THE RAMP SHALL HAVE ACCESSIBLE HAND RAILS AND LANDINGS ON EACH END WITH A SLOPE IN ANY DIRECTION NOT EXCEEDING 1:48 (1/4" PER FOOT OR NOMINALLY 2.0%).
7. DOORWAYS SHALL HAVE A LANDING AREA ON THE EXTERIOR SIDE OF THE DOOR THAT IS SLOPED NO MORE THAN 1:48 (1/4" PER FOOT OR NOMINALLY 2.0%) FOR POSITIVE DRAINAGE. THIS LANDING AREA SHALL BE NO LESS THAN 60 INCHES (5 FEET) LONG, EXCEPT HERE OTHERWISE PERMITTED BY ACCESSIBILITY STANDARDS FOR ALTERNATIVE DOORWAY OPENING CONDITIONS AND APPROVED BY THE OWNER'S REPRESENTATIVE.
8. WHERE PEDESTRIAN ACCESS ROUTES ARE CONTAINED WITHIN A STREET OR HIGHWAY RIGHT-OF-WAY, THE GRADE OF THE PEDESTRIAN ACCESS ROUTE IS PERMITTED TO EQUAL THE GENERAL GRADE ESTABLISHED FOR THE ADJACENT STREET OR HIGHWAY, EXCEPT THAT WHERE PEDESTRIAN ACCESS ROUTES ARE CONTAINED WITHIN PEDESTRIAN STREET CROSSINGS A MAXIMUM GRADE OF 5 PERCENT IS REQUIRED. (EXCEPT FROM PROWAG)

GENERAL FIRE NOTES

1. GENERAL FIRE SAFETY PRECAUTIONS SHALL BE MAINTAINED, IN ACCORDANCE WITH CHAPTER 33 OF THE INTERNATIONAL FIRE CODE; FIRE SAFETY DURING CONSTRUCTION
2. ALL WORK SUBJECT TO FIELD INSPECTION AND CORRECTION(S) AS IDENTIFIED AT THE TIME OF THE ON-SITE INSPECTION; ALL WORK SHALL BE COMPLIANT WITH THE APPLICABLE STANDARDS AND CODES; TO INCLUDE THE ADOPTED EDITION OF THE INTERNATIONAL FIRE CODE AND THE CITY'S MUNICIPAL CODE.
3. ALL FIRE ALARM AND FIRE SPRINKLERS SHALL BE SUBMITTED SEPARATELY AND DIRECTLY TO THE FIRE MARSHAL.
4. MODIFICATIONS FOR FUTURE TENANT IMPROVEMENT(S) MAY REQUIRE AN ALTERNATE PLANS RE-SUBMITTAL.
5. APPENDIX D FOR FIRE APPARATUS ACCESS ROADSALL ON-SITE PRIVATE UNDERGROUND FIRE SUPPRESSION WATER SUPPLY SHALL BE SUBMITTED TO THE FIRE MARSHAL (THIS INCLUDES PRIVATE HYDRANTS, UNDERGROUND FOR FDC'S AND FIRE SPRINKLER UNDERGROUND CONNECTIONS).
6. IFC APPENDIX D FIRE APPARATUS ACCESS ROADS. WHERE HYDRANTS ARE ON A FIRE APPARATUS ACCESS ROAD, THE MINIMUM WITH OF THE ROAD SHALL BE 26 FEET FOR A DISTANCE OF 20 FEET; 10 FEET IN EITHER DIRECTION.
7. IFC 503.3 MARKING WHERE REQUIRED BY THE FIRE CODE OFFICIAL, APPROVED SIGNS OR OTHER APPROVED NOTICES OR MARKINGS THAT INCLUDE THE WORDS NO PARKING FIRE LANE SHALL BE PROVIDED FOR FIRE APPARATUS ACCESS ROADS TO IDENTIFY SUCH ROADS OR PROHIBIT THE OBSTRUCTION THEREOF. THE MEANS BY WHICH FIRE LANES ARE DESIGNATED SHALL BE MAINTAINED IN A CLEAN AND LEGIBLE CONDITION AT ALL TIMES AND BE REPLACED OR REPAIRED WHEN NECESSARY TO PROVIDE ADEQUATE VISIBILITY.
8. IFC D103.6 FIRE APPARATUS ACCESS PARKING RESTRICTIONS--SIGNS; REQUIRED ROADWAYS MUST HAVE SIGNAGE FOR PARKING RESTRICTIONS AS FOLLOWS: SIGNS FOR NO-PARKING--FIRE LANE SHALL COMPLY WITH A MINIMUM DIMENSION OF 12 INCHES WIDE BY 18 INCHES HIGH AND HAVE RED LETTERS ON A WHITE REFLECTIVE BACKGROUND. SIGNS SHALL BE PROVIDED ON BOTH SIDES OF ALL STREETS THAT ARE LESS THAN 26 IN WIDTH IN ACCORDANCE WITH LOCAL STANDARDS FOR ACCESS AND FUTURE ENFORCEMENT; SIGNS FOR NO-PARKING MUST BE PROVIDED ON ONE SIDE OF ALL STREETS THAT ARE BETWEEN 26 AND 32 IN WIDTH ACCORDANCE WITH LOCAL STANDARDS FOR ACCESS AND FUTURE ENFORCEMENT.
9. IFC 506 WHERE REQUIRED ACCESS IS RESTRICTED WITH A GATE, AN APPROVED PADLOCK OR KEY SWITCH (FOR ELECTRONIC/AUTOMATED GATES) SHALL BE PROVIDED TO ALLOW FIRE DEPARTMENT ACCESS.
10. IFC 503.1.1 / D102 / D103 ROADWAYS TO ACCESS STRUCTURES: THE PERIMETER OF ALL STRUCTURES MUST BE WITHIN 150 FEET OF AN APPROVED ACCESS ROAD WITH A MINIMUM CLEAR WIDTH OF 20 FEET (26 FEET WHERE A HYDRANT IS LOCATED). BUILDING SHALL BE INSTALLED WITH AUTOMATIC FIRE SPRINKLERS AS AN ALTERNATIVE TO DISTANCE FROM A FIRE ACCESS ROAD.
11. IFC 507.5.4 FIRE PROTECTION WATER SUPPLY: UNOBSTRUCTED ACCESS TO FIRE HYDRANTS SHALL BE MAINTAINED AT ALL TIMES. THE FIRE DEPARTMENT SHALL NOT BE DETERRED OR HINDERED FROM GAINING IMMEDIATE ACCESS TO FIRE PROTECTION EQUIPMENT OR FIRE HYDRANTS REQUIRED ACCESS ROADWAYS AND HYDRANTS SHALL BE SERVICEABLE AND UNOBSTRUCTED PRIOR TO COMBUSTIBLE CONSTRUCTION.



Know what's below.
Call before you dig.

CALL 2 BUSINESS DAYS BEFORE YOU DIG.
CAUTION UTILITY INFORMATION IS APPROXIMATE.
VERIFY ALL UTILITIES PRIOR TO CONSTRUCTION.

Revisions:



1	8/24/2023	ADDENDUM #1
4	8/28/2023	ADDENDUM #4


LINE IS 1" ON FULL
SCALE DRAWING



WINDSOR ENGINEERS

Ridgefield, WA
Duluth + Minneapolis, MN
www.windsorengineers.com
Project No: 20198.3

Copyright 2023 By Windsor Engineers, LLC
All Rights Reserved.

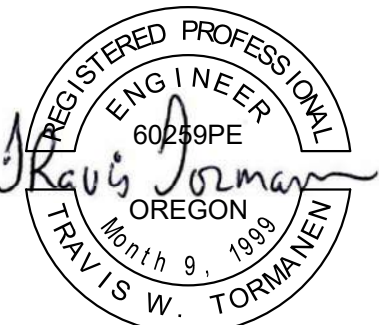

WATER RESILIENCY PROJECT
PHASE 1 - SEISMIC IMPROVEMENTS
CITY OF CANNON BEACH, OR 97110

ENGINEERING PLAN











Issue Date: 8/28/2023

CIVIL NOTES AND ABBREVIATIONS

G002

Project Manager TWT
Drawn by TJM
Checked by MRL

PLOT DATE: 02/20/2023 4:23 PM - FILE: C:\Users\MARCUSJ\OneDrive - Windsor Engineers\05_Projects\2020\20198.3 Cannon Beach Seismic Valves\02_Drawings\01_Working\04_Final Sheets\20198.3_Legends.dwg

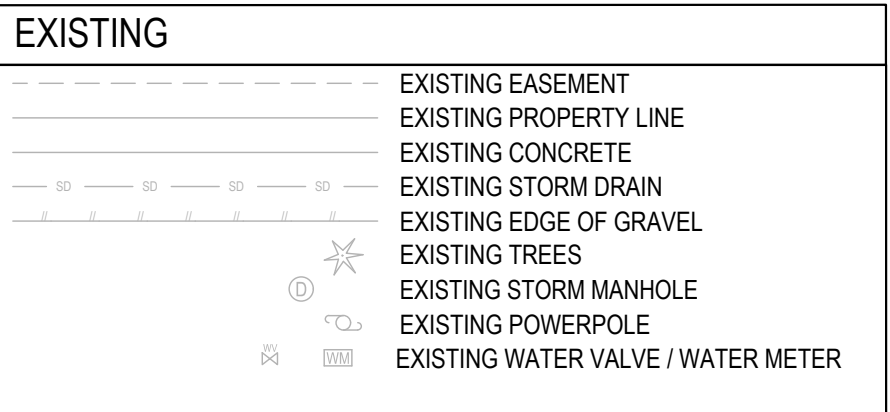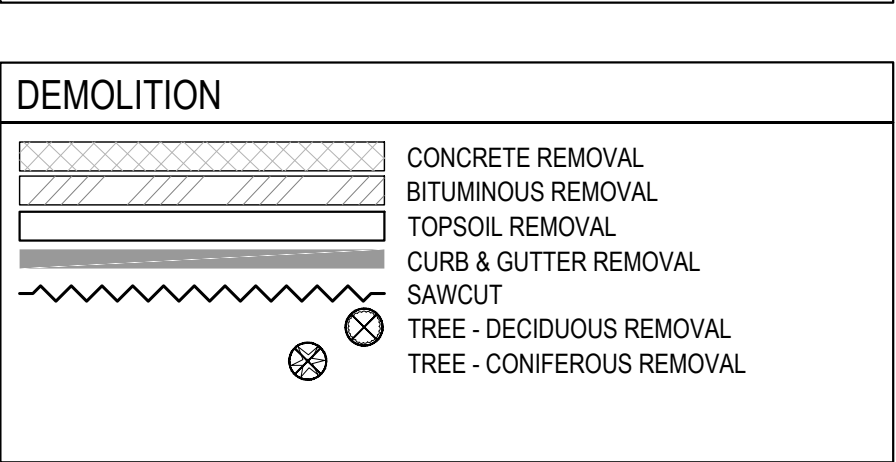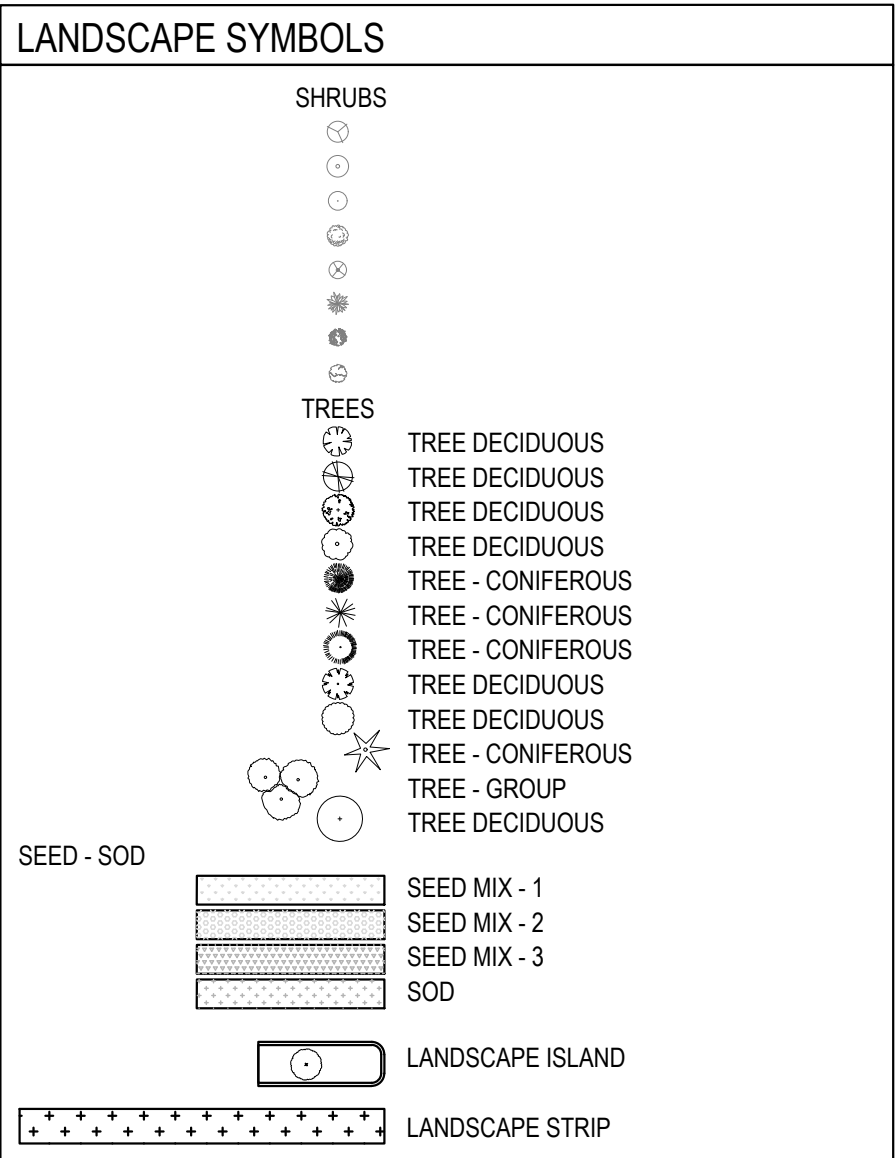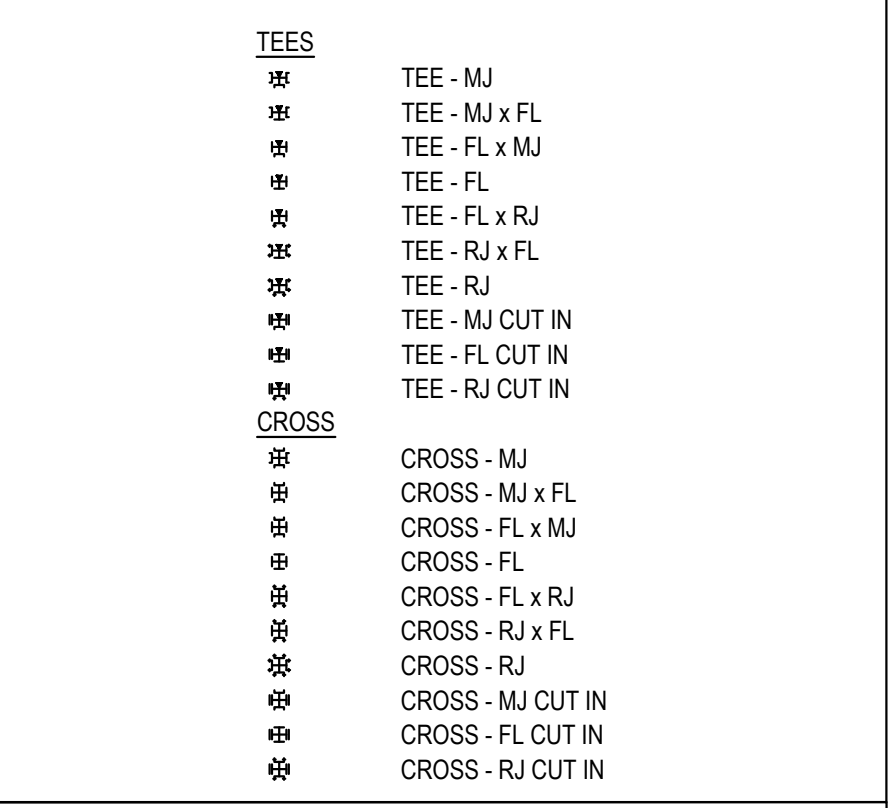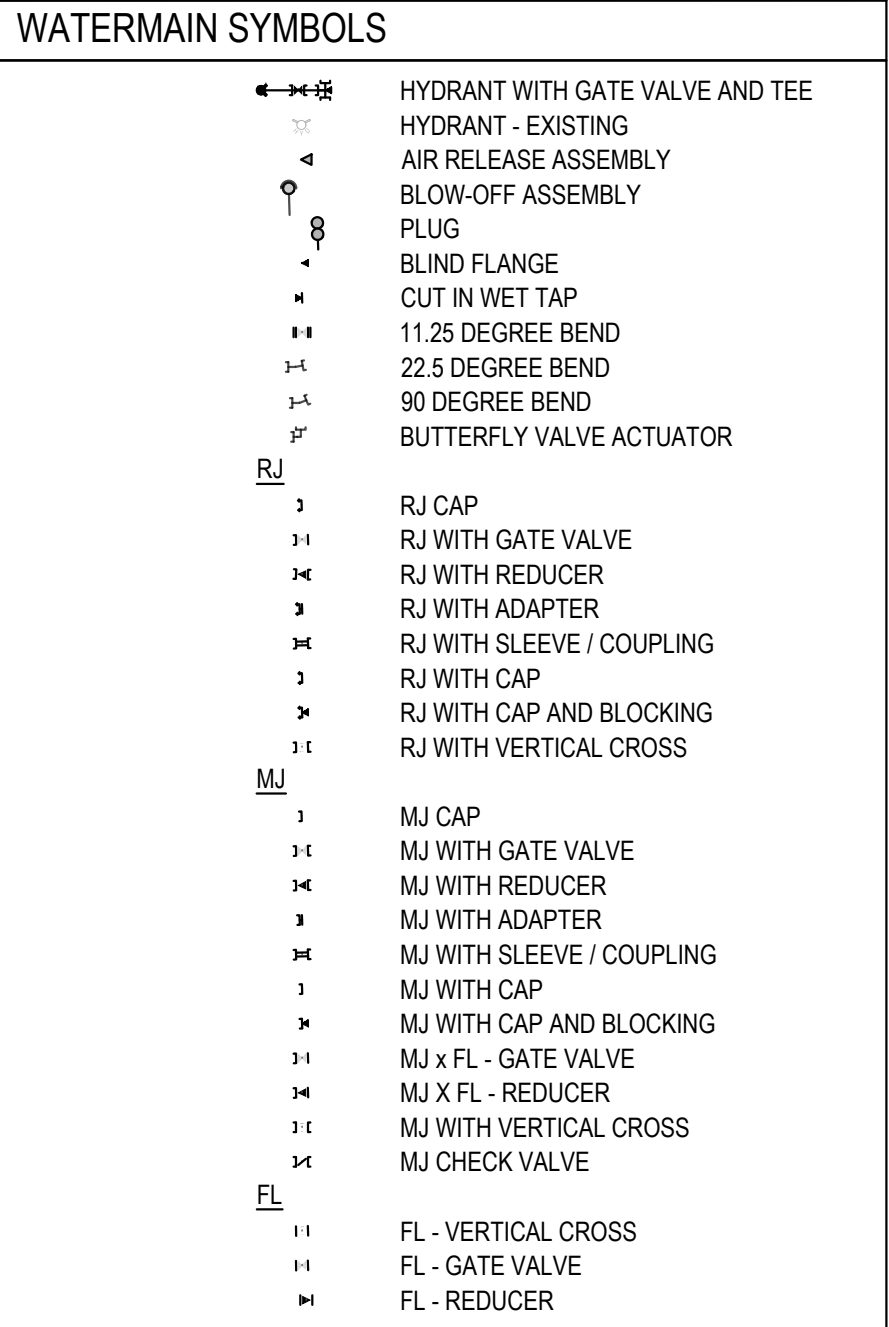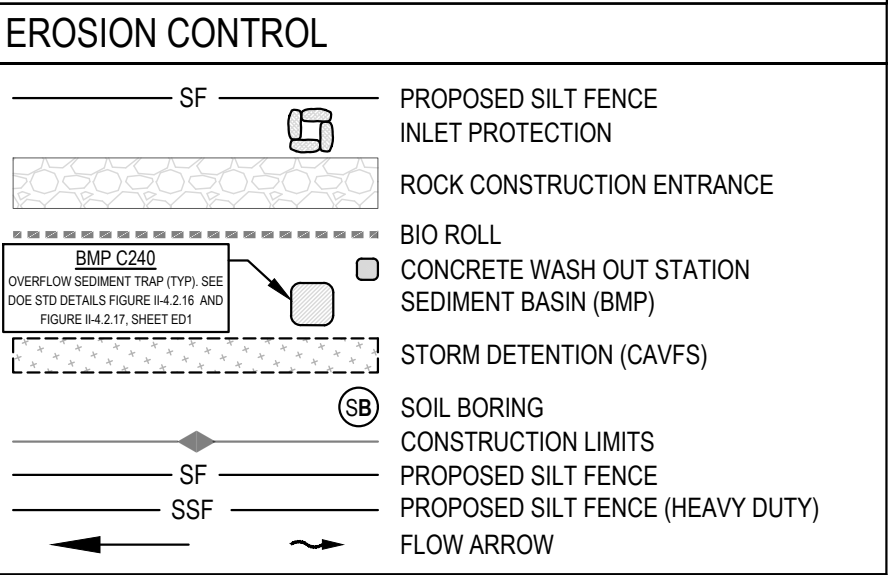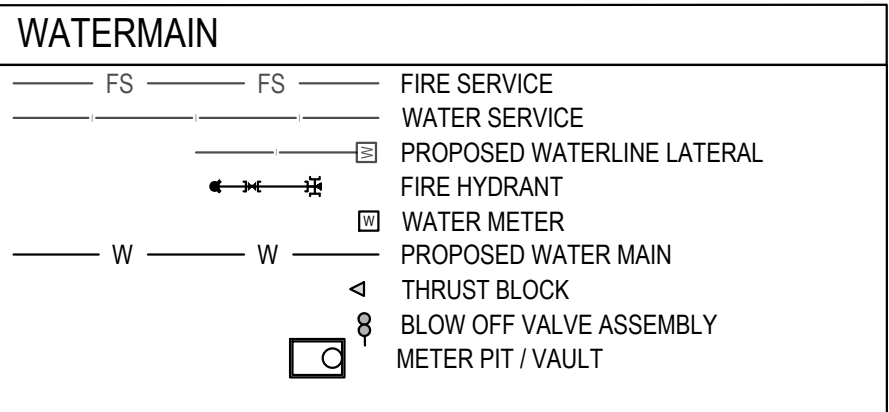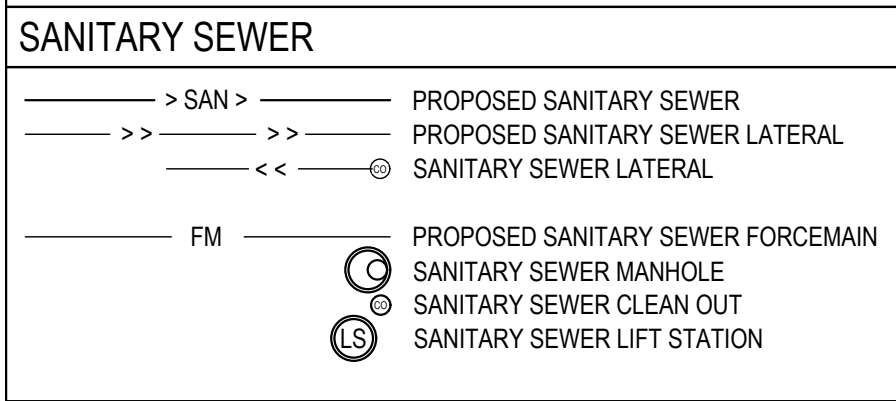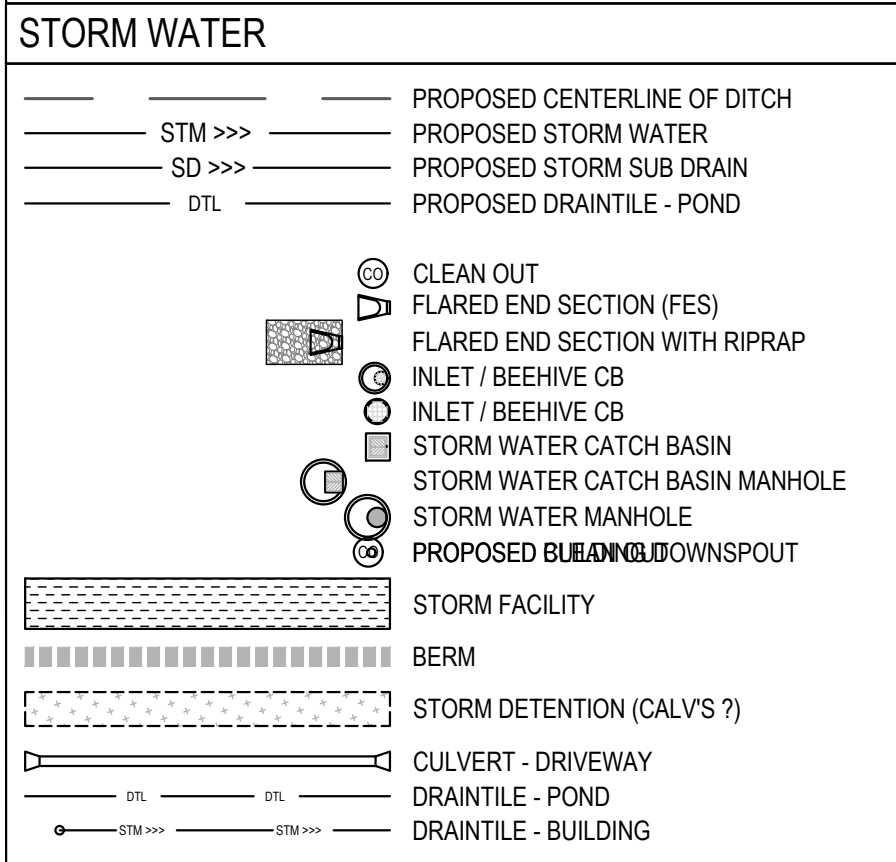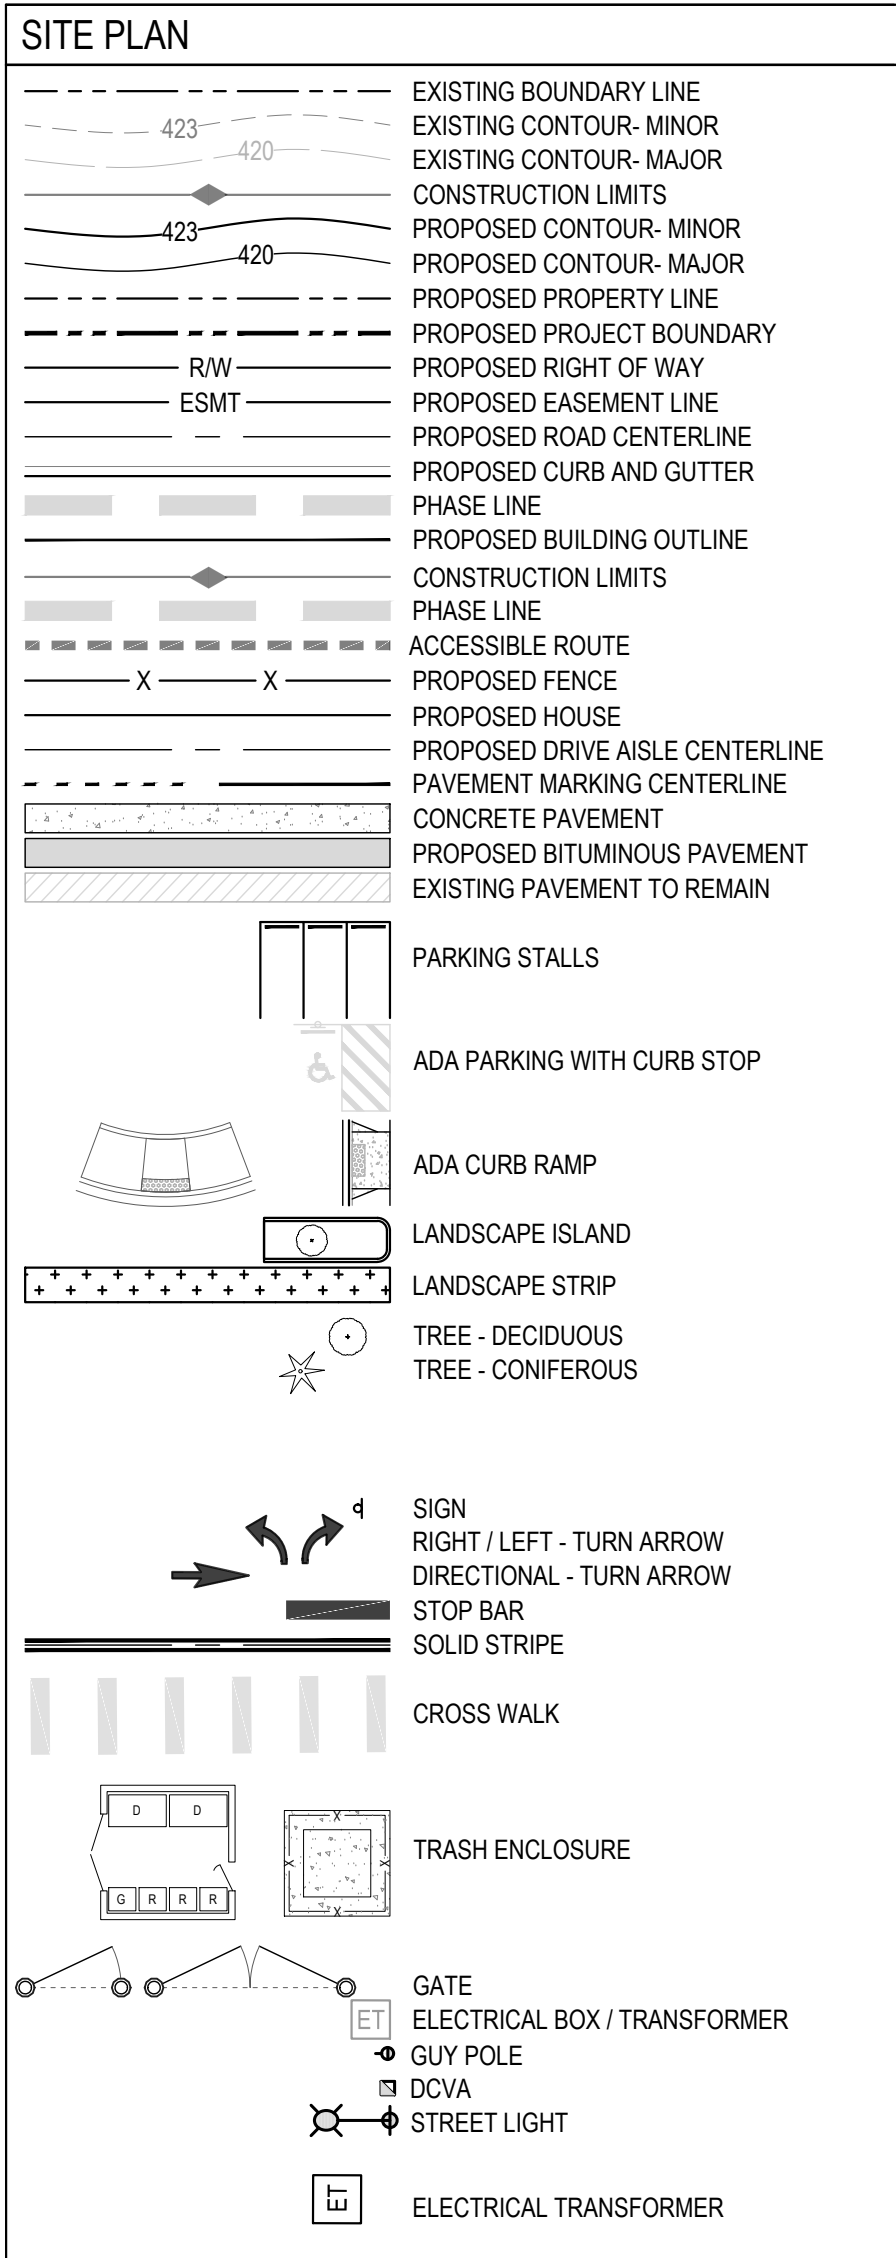

GENERAL ABBREVIATIONS


(E)	EXISTING
C	CONCRETE
CB	CATCH BASIN
CL	CENTERLINE
CNS	COMPACTED NATIVE SOIL
CO	CLEAN OUT
CR	CURB RETURN
D	DIRT / DRAINAGE
FG	FINISHED GRADE
FH	FIRE HYDRANT
FL	FLOW LINE
FM	FORCE MAIN
G	NATURAL GAS (LOW PRESSURE)
GB	GRADE BREAK
HP	HIGH POINT
LF	LINEAR FOOT
LP	LOW POINT
MG	NATURAL GAS (MEDIUM PRESSURE)
MG	MATCH EXISTING GRADE
MH	MANHOLE
NS	NATIVE SOIL
NTS	NOT TO SCALE
P	PAVEMENT
PC	POINT OF CURVATURE
POC	POINT OF CONNECTION
POS	POINT OF SERVICE
PP	POWER POLE
PT	POINT OF TANGENCY
R	RADIUS
ROW	RIGHT OF WAY
S	SLOPE / SANITARY
SAN	SEWER SEWER
SSMH	SANITARY MANHOLE
STA	STATION
STM	STORM DRAIN
STMH	STORM MANHOLE
TBD	TO BE DETERMINED
TBL	TO BE RELOCATED BY RESPECTIVE UTILITY
TBR	TO BE REMOVED BY CONTRACTOR
TC	TOP OF CURB
TOE	TOE OF BANK
TOP	TOP OF BANK
TP	TELEPHONE POLE
U	UNDERGROUND
VIP	VERIFY IN FIELD PRIOR TO CONSTRUCTION
W	WATER MAIN

SITE - ABBREVIATIONS

FFE	FIRST FLOOR FINISH ELEVATION
LLE	LOWER LEVEL FINISH ELEVATION
WO	WALKOUT
LO	LOOKOUT

GRADING LEGEND / ABBREVIATIONS

TC: 391.49
FL: 390.99
TW: 391.49
BW: 380.99
GB: GRADE BREAK
LP: LOW POINT
HP: HIGH POINT
FC: FLUSH CURB
MG: MATCH GRADE
FL: FLOWLINE
SW: SIDEWALK
TC: TOP OF CURB
FG: FINISH GRADE (DEFAULT- IF NOT LABELED)

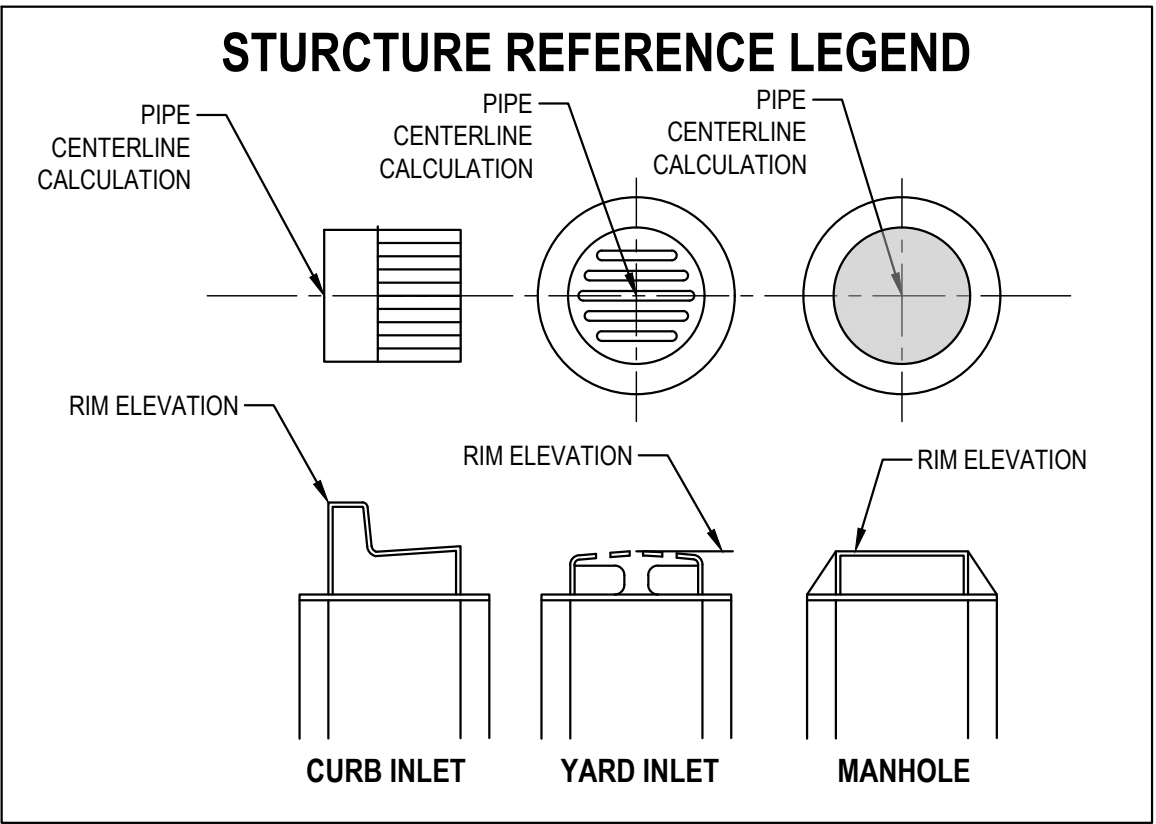

811
Know what's below.
Call before you dig.
CALL 2 BUSINESS DAYS BEFORE YOU DIG.
CAUTION: UTILITY INFORMATION IS APPROXIMATE.
VERIFY ALL UTILITIES PRIOR TO CONSTRUCTION.

Revisions:

1	8/24/2023	ADDENDUM #1
4	8/28/2023	ADDENDUM #4

LINE IS 1" ON FULL SCALE DRAWING

WINDSOR ENGINEERS
Ridgefield, WA
Duluth + Minneapolis, MN
www.windsorengineers.com
Project No: 20198.3
Copyright 2023 By Windsor Engineers, LLC
All Rights Reserved.

REGISTERED PROFESSIONAL ENGINEER
60239PE
OREGON
March 9, 1993
TRAVIS W. TORMANN
EXPIRES: 06-30-24

**WATER RESILIENCY PROJECT
PHASE 1 - SEISMIC IMPROVEMENTS**
CITY OF CANNON BEACH, OR 97110


ENGINEERING PLAN
Issue Date: 8/28/2023

Project Manager: TWT
Drawn by: TJM
Checked by: MRL

LEGENDS

G003

PLOT DATE: 8/28/2023 4:23 PM - FILE: C:\Users\MARCUSJ\OneDrive - Windsor Engineers\05 Projects\2020\20198-3 Cannon Beach Seismic Values\02 Drawings\04 Working\04_Final Sheets\20198-3_KEY.dwg

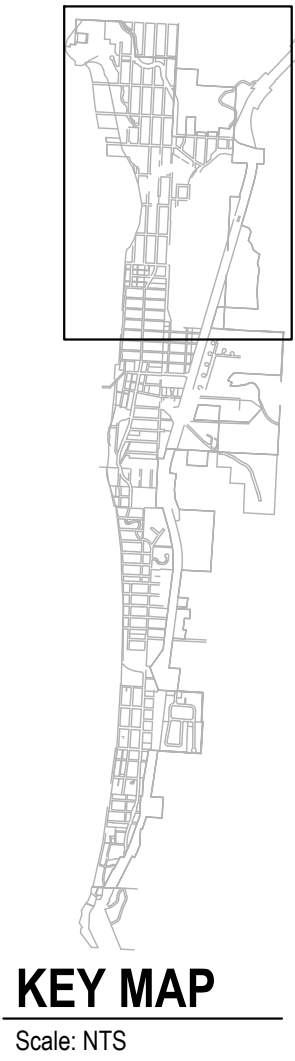

Know what's **below.**
Call before you dig.
CALL 2 BUSINESS DAYS BEFORE YOU DIG.
CAUTION UTILITY INFORMATION IS APPROXIMATE.
VERIFY ALL UTILITIES PRIOR TO CONSTRUCTION.

Revisions:		
1	8/24/2023	ADDENDUM #1
4	8/28/2023	ADDENDUM #4

LINE IS 1" ON FULL
SCALE DRAWING



WINDSOR ENGINEERS
Ridgefield, WA
Duluth + Minneapolis, MN
www.windsorengineers.com
Project No: 20198.3
Copyright 2023 By Windsor Engineers, LLC
All Rights Reserved.



**WATER RESILIENCY PROJECT
PHASE 1 - SEISMIC IMPROVEMENTS**
CITY OF CANNON BEACH, OR 97110


ENGINEERING PLAN
Issue Date: 8/28/2023

Project Manager TWT
Drawn by TJM
Checked by MRL

KEY PLAN - NORTH

G004

PLOT DATE: 8/28/2023 4:23 PM - FILE: C:\Users\MARCUSJ\OneDrive - Windsor Engineers\05 Projects\2020\20198 - Cannon Beach Seismic Valves\02 Drawings\04 Working\04_Final Sheets\20198.3_KEY.dwg

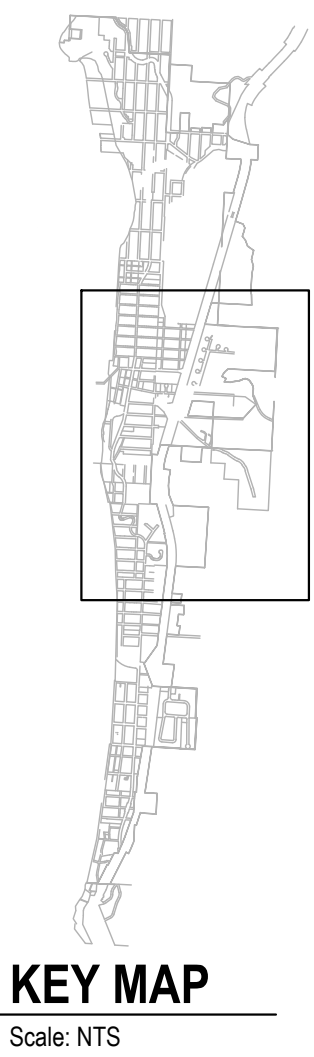

Know what's below.
Call before you dig.

CALL 2 BUSINESS DAYS BEFORE YOU DIG.
CAUTION UTILITY INFORMATION IS APPROXIMATE.
VERIFY ALL UTILITIES PRIOR TO CONSTRUCTION.

Revisions:		
1	8/24/2023	ADDENDUM #1
4	8/28/2023	ADDENDUM #4

LINE IS 1" ON FULL SCALE DRAWING

WINDSOR ENGINEERS
 Ridgefield, WA
 Duluth + Minneapolis, MN
www.windsorengineers.com
 Project No: 20198.3
Copyright 2023 By Windsor Engineers, LLC
 All Rights Reserved.



WATER RESILIENCY PROJECT
PHASE 1 - SEISMIC IMPROVEMENTS
CITY OF CANNON BEACH, OR 97110


ENGINEERING PLAN
Issue Date: 8/28/2023

Project Manager TWT
Drawn by TJM
Checked by MRL

KEY PLAN - CENTER

G005

PLOT DATE: 8/28/2023 4:24 PM - FILE: C:\Users\MARCUS\OneDrive - Windsor Engineers\05 Projects\2020\20198-3 Cannon Beach Seismic Valves\02 Drawings\04 Working\04_Final Sheets\20198-3_KEY.dwg

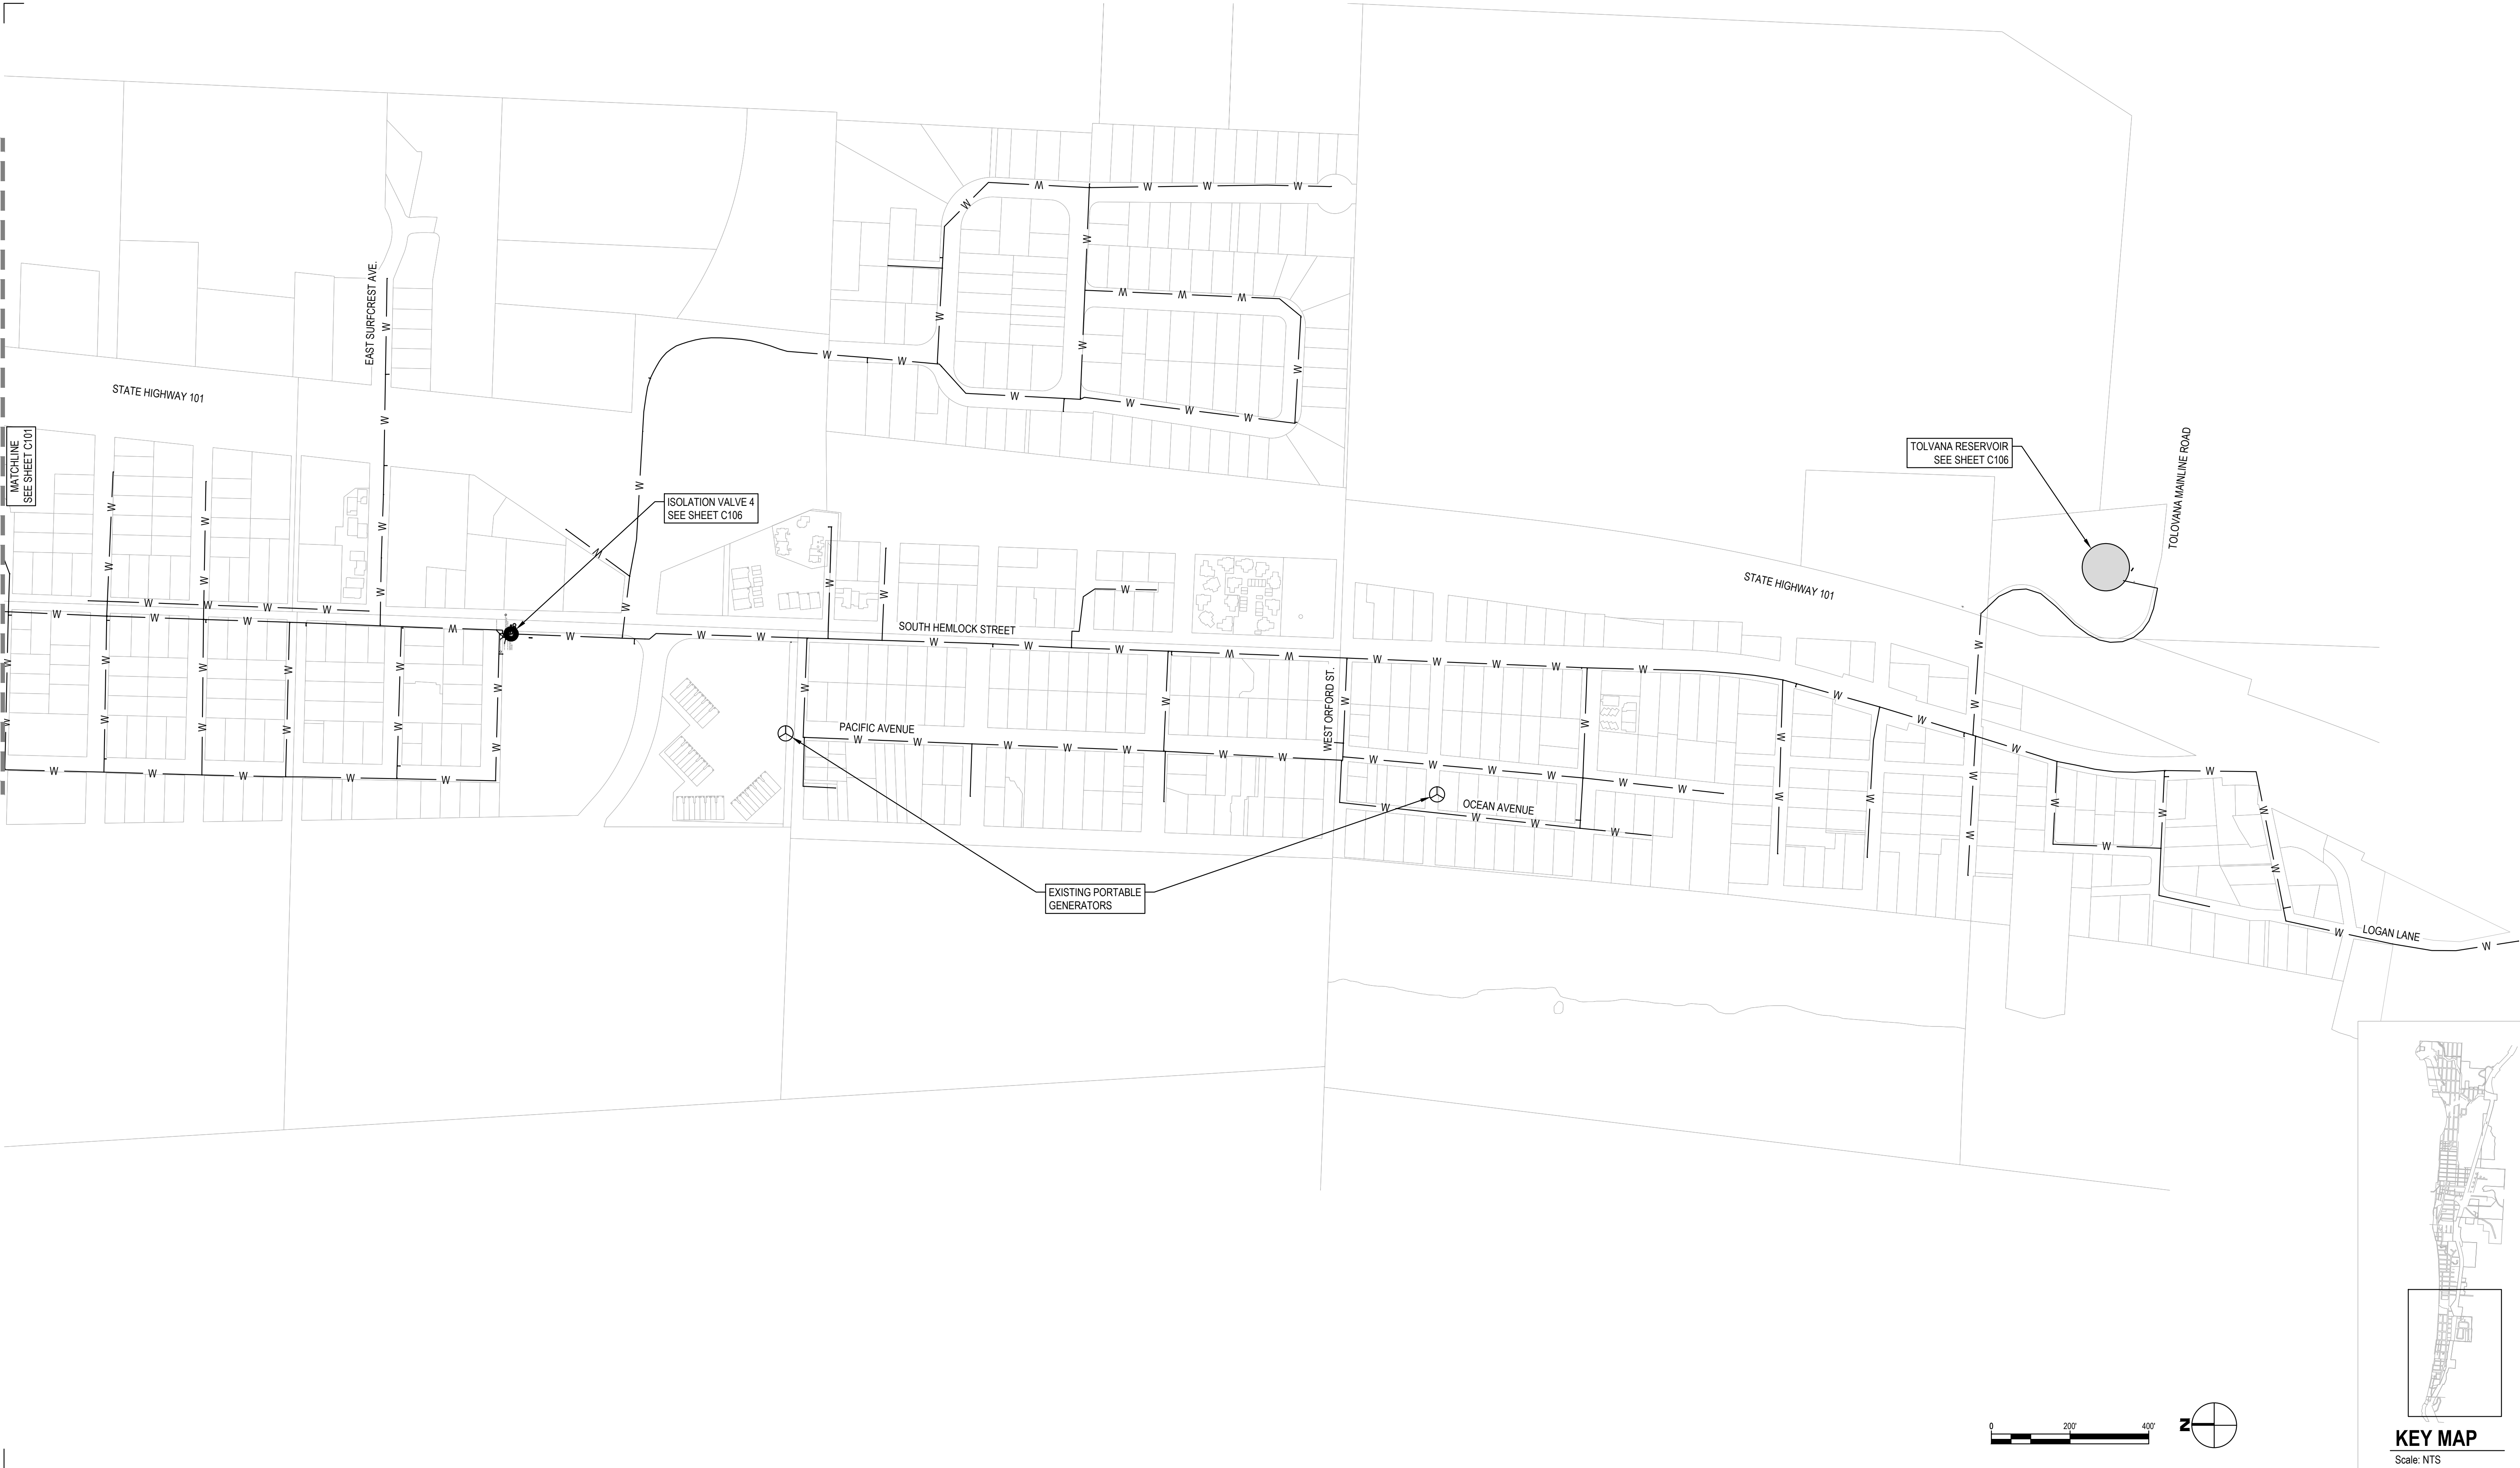


KEY MAP
Scale: NTS



Know what's **below.**
Call before you dig.

CALL 2 BUSINESS DAYS BEFORE YOU DIG.
CAUTION: UTILITY INFORMATION IS APPROXIMATE.
VERIFY ALL UTILITIES PRIOR TO CONSTRUCTION.

Revisions:

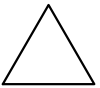

1	8/24/2023	ADDENDUM #1
4	8/28/2023	ADDENDUM #4

LINE IS 1" ON FULL
SCALE DRAWING



WINDSOR ENGINEERS

Ridgefield, WA
Duluth + Minneapolis, MN
www.windsorengineers.com
Project No: 20198.3

Copyright 2023 By Windsor Engineers, LLC
All Rights Reserved.



EXPIRES: 06-30-24

WATER RESILIENCY PROJECT
PHASE 1 - SEISMIC IMPROVEMENTS
CITY OF CANNON BEACH, OR 97110

ENGINEERING PLAN


Issue Date: 8/28/2023

Project Manager TWT
Drawn by TJM
Checked by MRL

KEY PLAN - SOUTH


G006

PLOT DATE: 8/28/2023 4:24 PM - FILE: C:\Users\MARCUSJ\OneDrive - Windsor Engineers\05 Projects\2020\20198.3 Cannon Beach Seismic Valves\02 Drawings\01 Working\04 Final Sheets\20198.3_exc.dwg

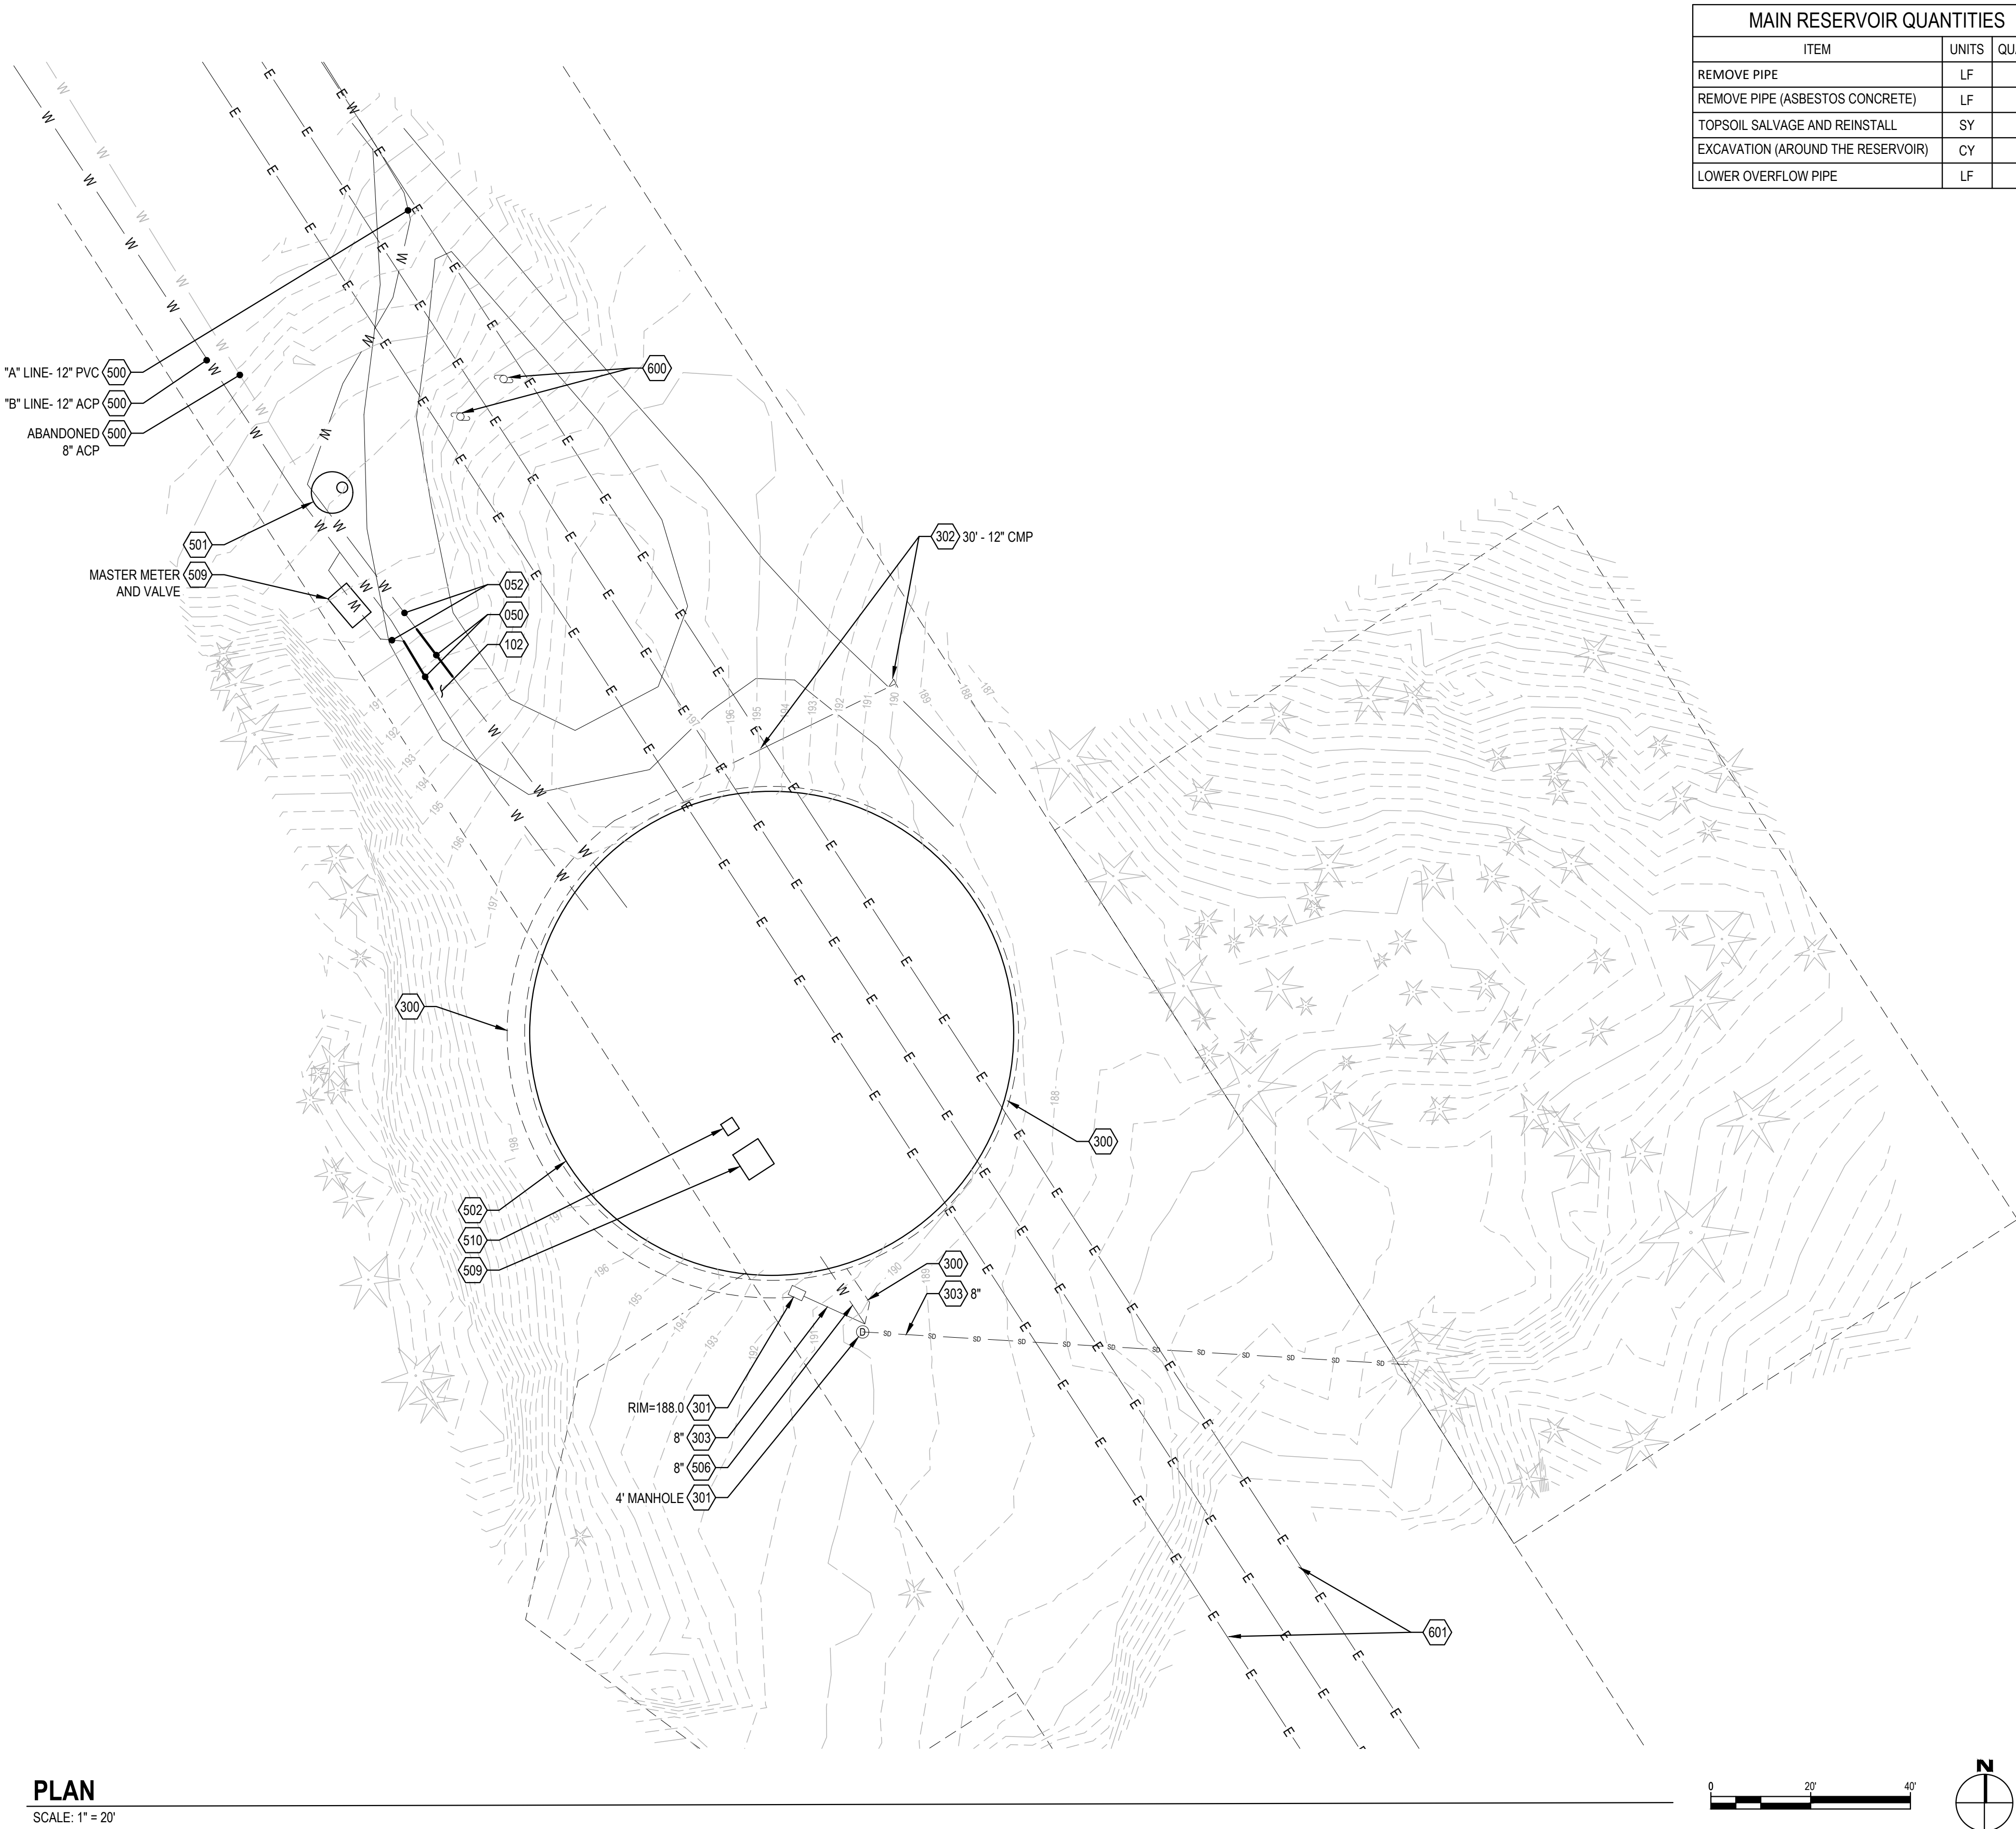

- 050 DEMOLITION**
- 050 REMOVE PIPE AS NEEDED TO INSTALL NEW VAULTS, FITTINGS AND VALVES. SEE SITE PLANS AND DETAILS FOR PROPOSED EQUIPMENT.
 - 051 SAWCUT FULL DEPTH AND REMOVE PAVING
 - 052 POTHOLE TO LOCATE EXISTING PIPES PRIOR TO BEGINNING CONSTRUCTION- SHOWN LOCATIONS ARE BASED ON RECORD PLANS AND FIELD LOCATES
 - 053 REMOVE EXISTING VAULT, VALVES, METERS, FITTINGS AND PIPE.
 - 054 CLEARING AND GRUBBING AS NEEDED FOR NEW POWER
- 100 SITE PLAN NOTES**
- 100 EXISTING CHAIN LINK FENCE
 - 101 GRAVEL EDGE
 - 102 SALVAGE TOPSOIL IN ALL AREAS OF EXCAVATION AND GRADING
- 300 STORMWATER**
- 300 EXISTING 6" UNDERDRAIN
 - 301 EXISTING STORM STRUCTURE
 - 302 EXISTING DAYLIGHT PIPE - INLET = 187.5 OUTLET = 186.5
 - 303 EXISTING CONCRETE PIPE
 - 304 EXISTING HDPE PIPE
- 500 WATER**
- 500 EXISTING WATER TRUNK LINE
 - 501 EXISTING ALTITUDE CONTROL VALVE AND VAULT
 - 502 EXISTING RESERVOIR TANK
 - 503 EXISTING PUMP HOUSE
 - 504 EXISTING FIRE HYDRANT
 - 505 EXISTING DI OVERFLOW PIPE
 - 506 EXISTING DI WATER PIPE
 - 507 EXISTING PVC WATER LINE
 - 508 EXISTING ASBESTOS CONCRETE WATER LINE
 - 509 EXISTING VAULT
 - 510 EXISTING ROOF HATCH
 - 511 EXISTING ROOF VENT
- 600 DRY UTILITIES**
- 600 EXISTING OVERHEAD POWER POLE
 - 601 EXISTING OVERHEAD POWER
 - 602 EXISTING CELLULAR CONTROL BOX
 - 603 EXISTING UTILITY BOX
 - 604 UNDERGROUND POWER AND COMMUNICATIONS TO US101

GENERAL SHEET NOTES:
1. ALL ASBESTOS CONCRETE PIPE REMOVED NEEDS TO BE REMOVED AND DISPOSED OF IN ACCORDANCE WITH OREGON DEQ RULES 340, DIVISION 248. AS WELL AS ANY LOCAL REQUIREMENTS INCLUDING OREGON OSHA AND CONSTRUCTION CONTRACTORS BOARD.

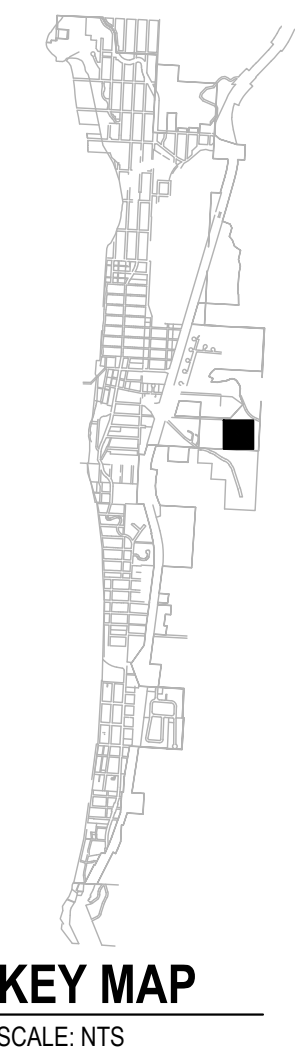

Know what's **below.**
Call before you dig.

CALL 2 BUSINESS DAYS BEFORE YOU DIG.
CAUTION UTILITY INFORMATION IS APPROXIMATE.
VERIFY ALL UTILITIES PRIOR TO CONSTRUCTION.

Revisions:



1	8/24/2023	ADDENDUM #1
4	8/28/2023	ADDENDUM #4

LINE IS 1" ON FULL
SCALE DRAWING



WINDSOR ENGINEERS

Ridgefield, WA
Duluth + Minneapolis, MN
www.windsorengineers.com
Project No: 20198.3

Copyright 2023 By Windsor Engineers, LLC
All Rights Reserved.










**WATER RESILIENCY PROJECT
PHASE 1 - SEISMIC IMPROVEMENTS**
CITY OF CANNON BEACH, OR 97110

ENGINEERING PLAN
Issue Date: 8/28/2023

Project Manager: TWT
Drawn by: TJM
Checked by: MRL

**EXISTING CONDITIONS AND DEMOLITION PLAN
- MAIN RESERVOIR**

C000

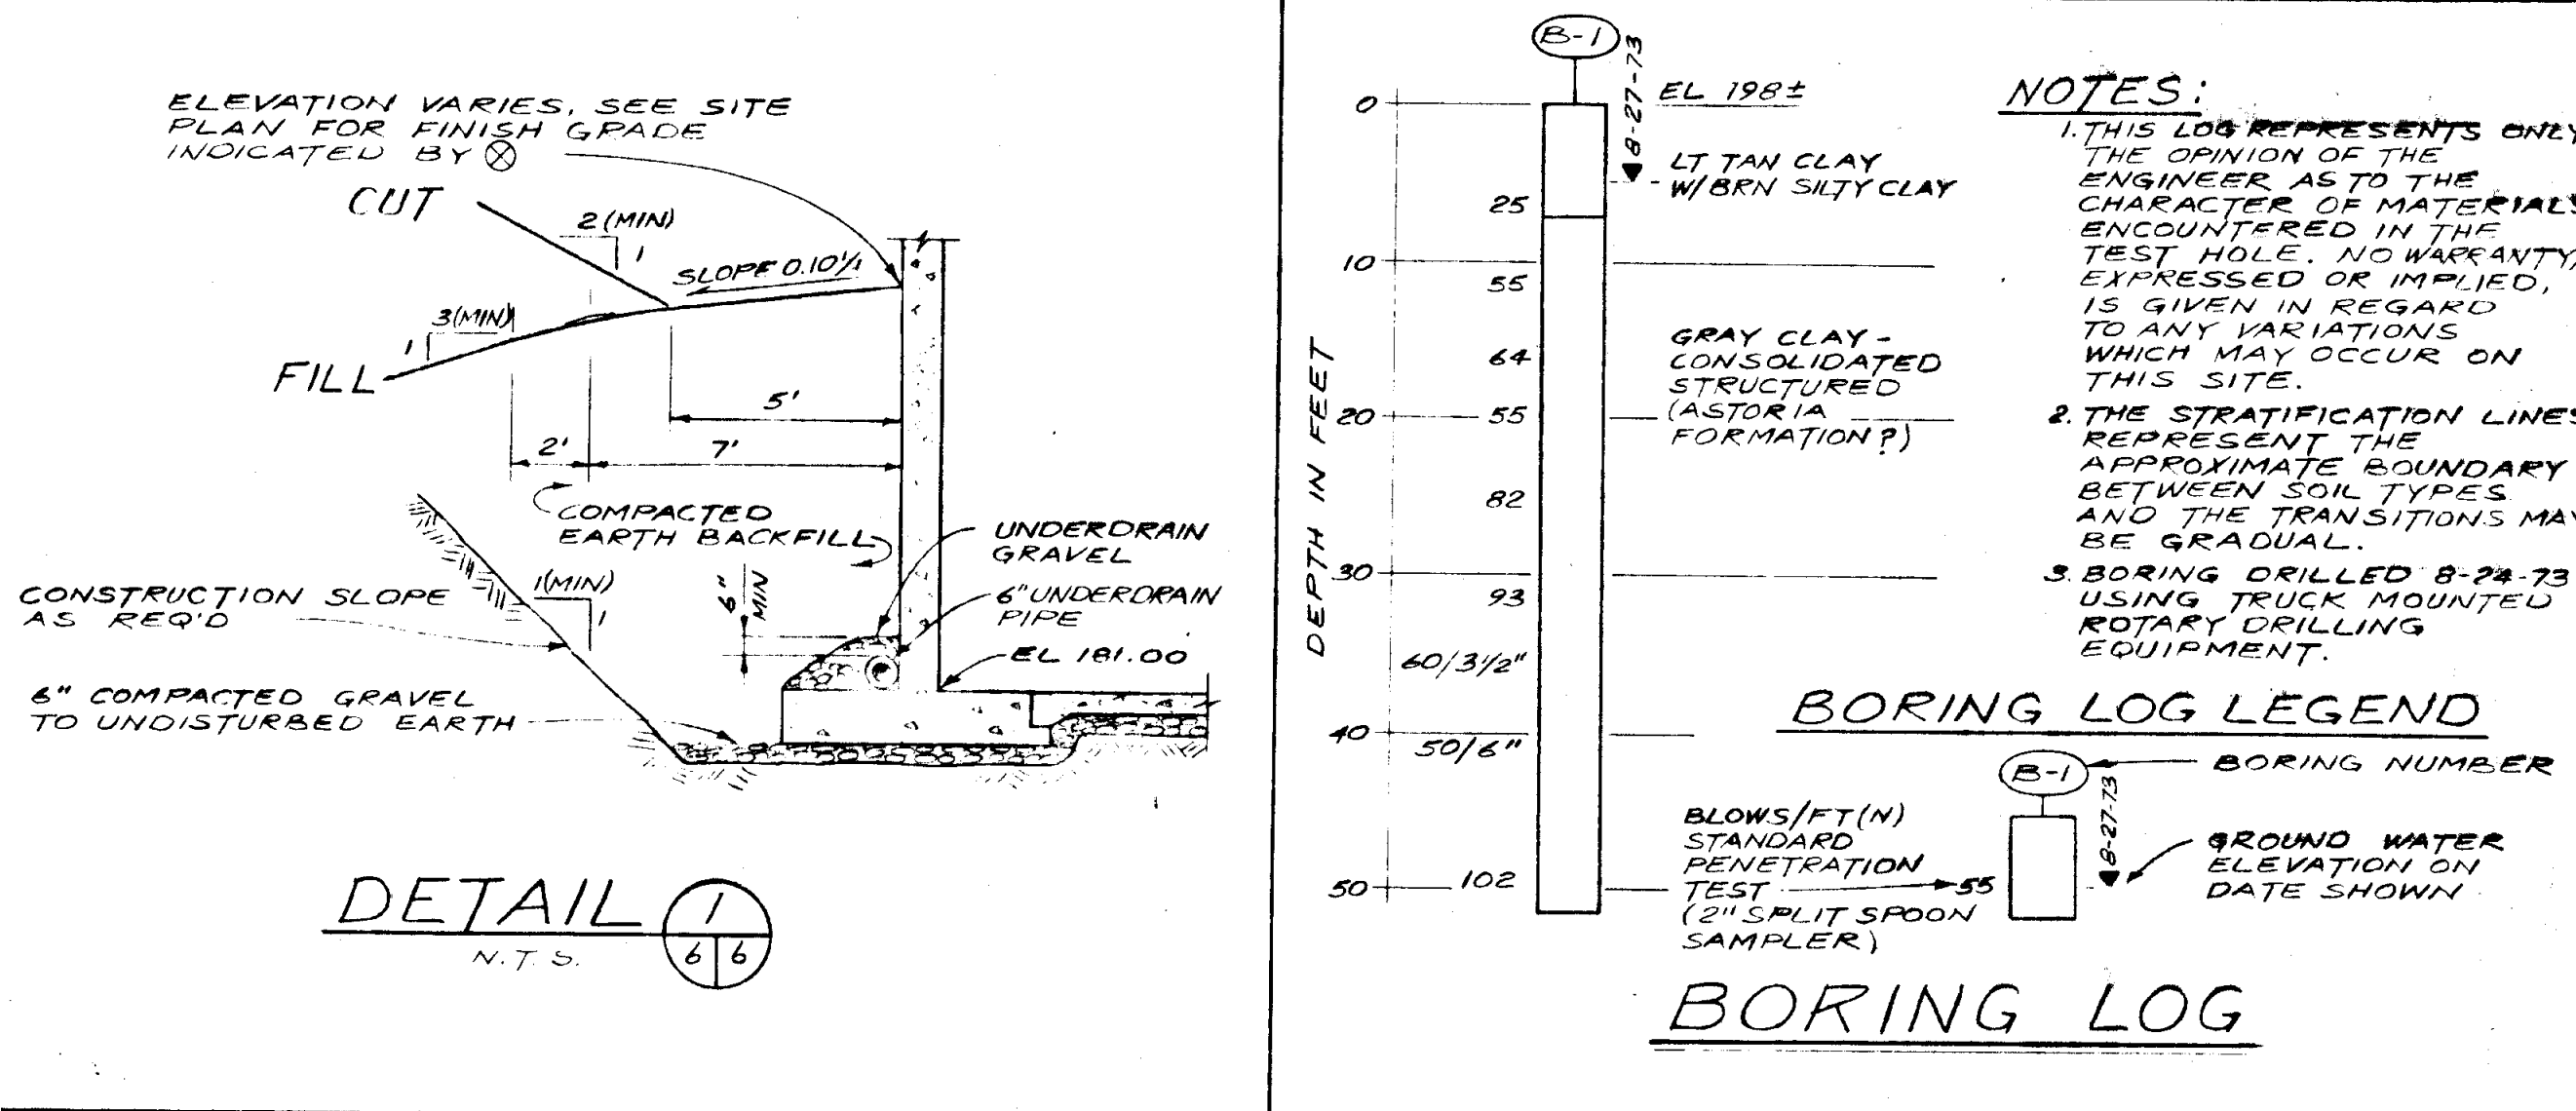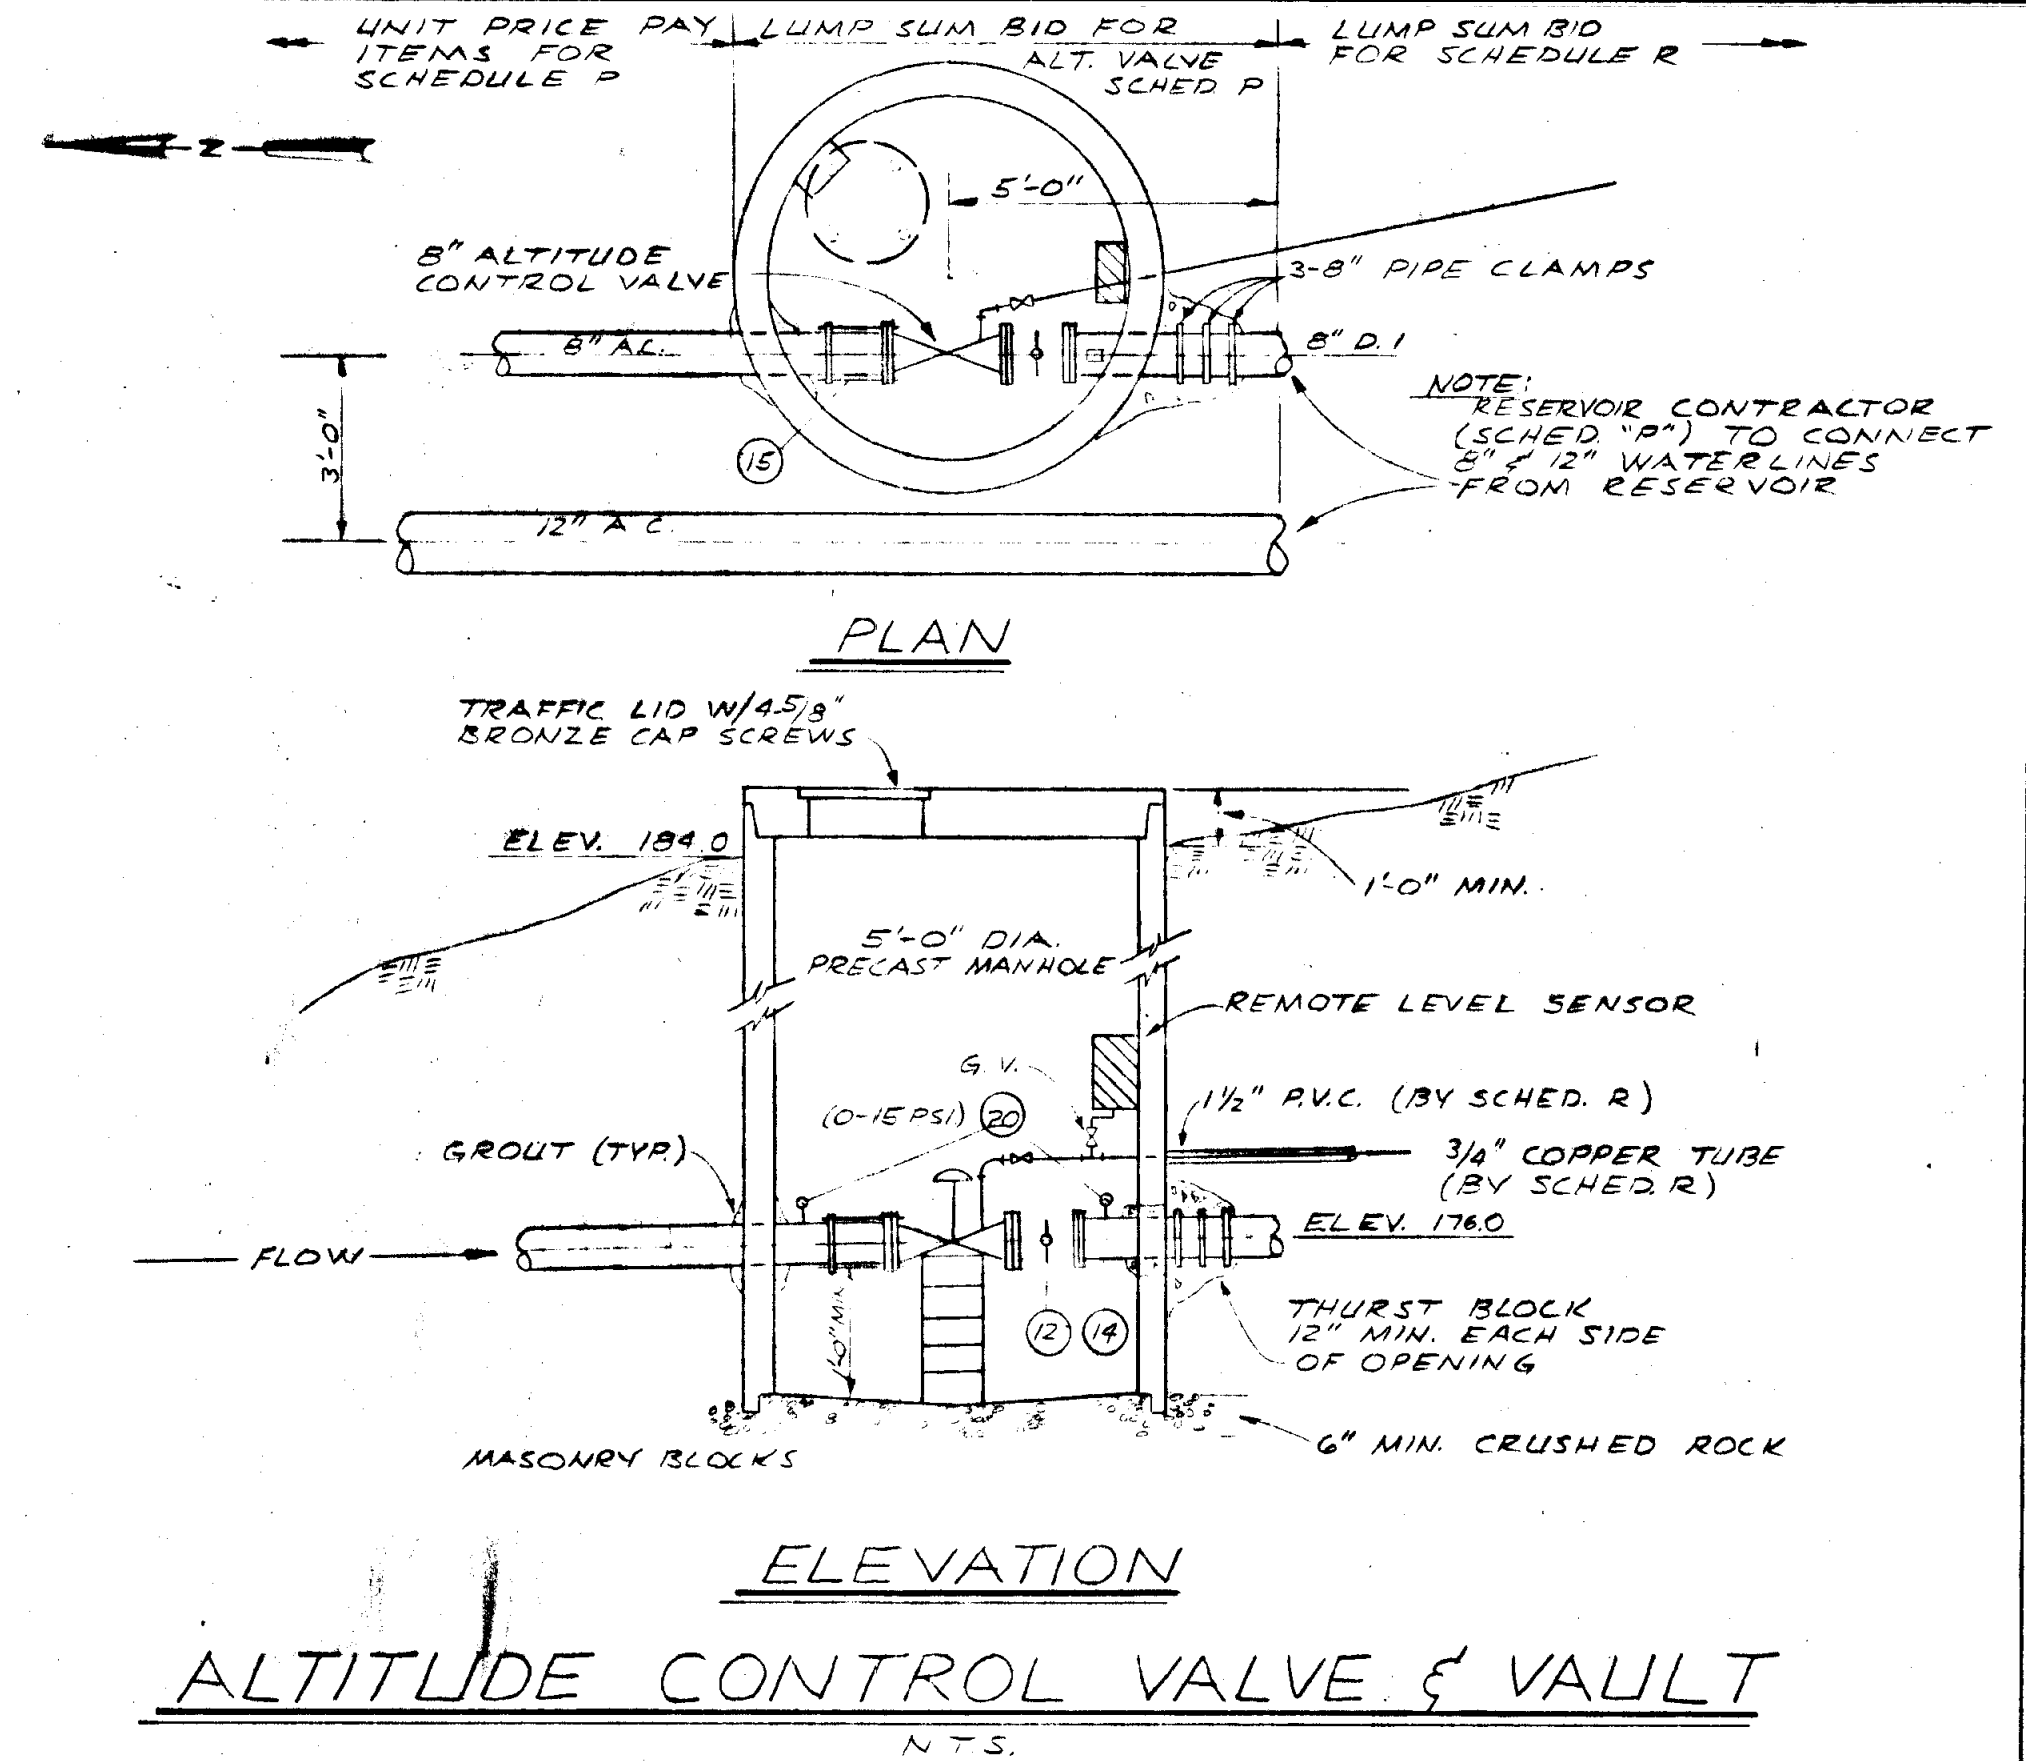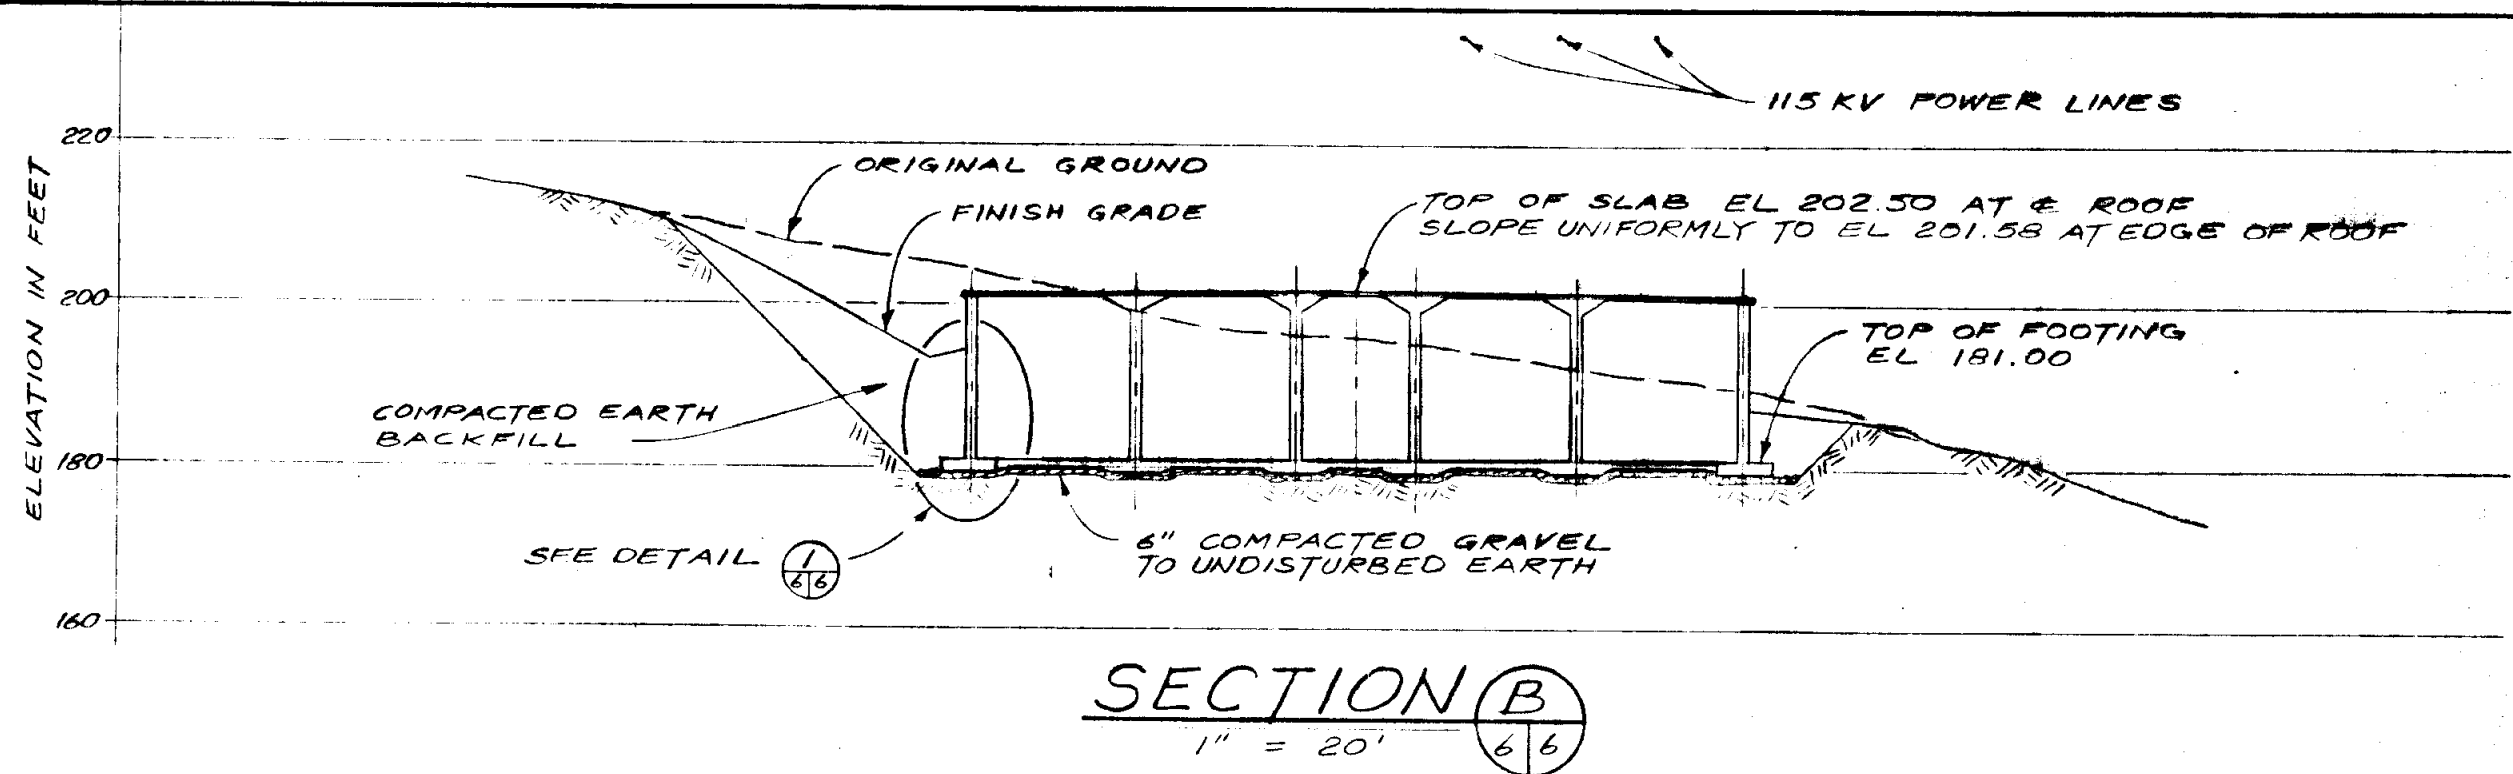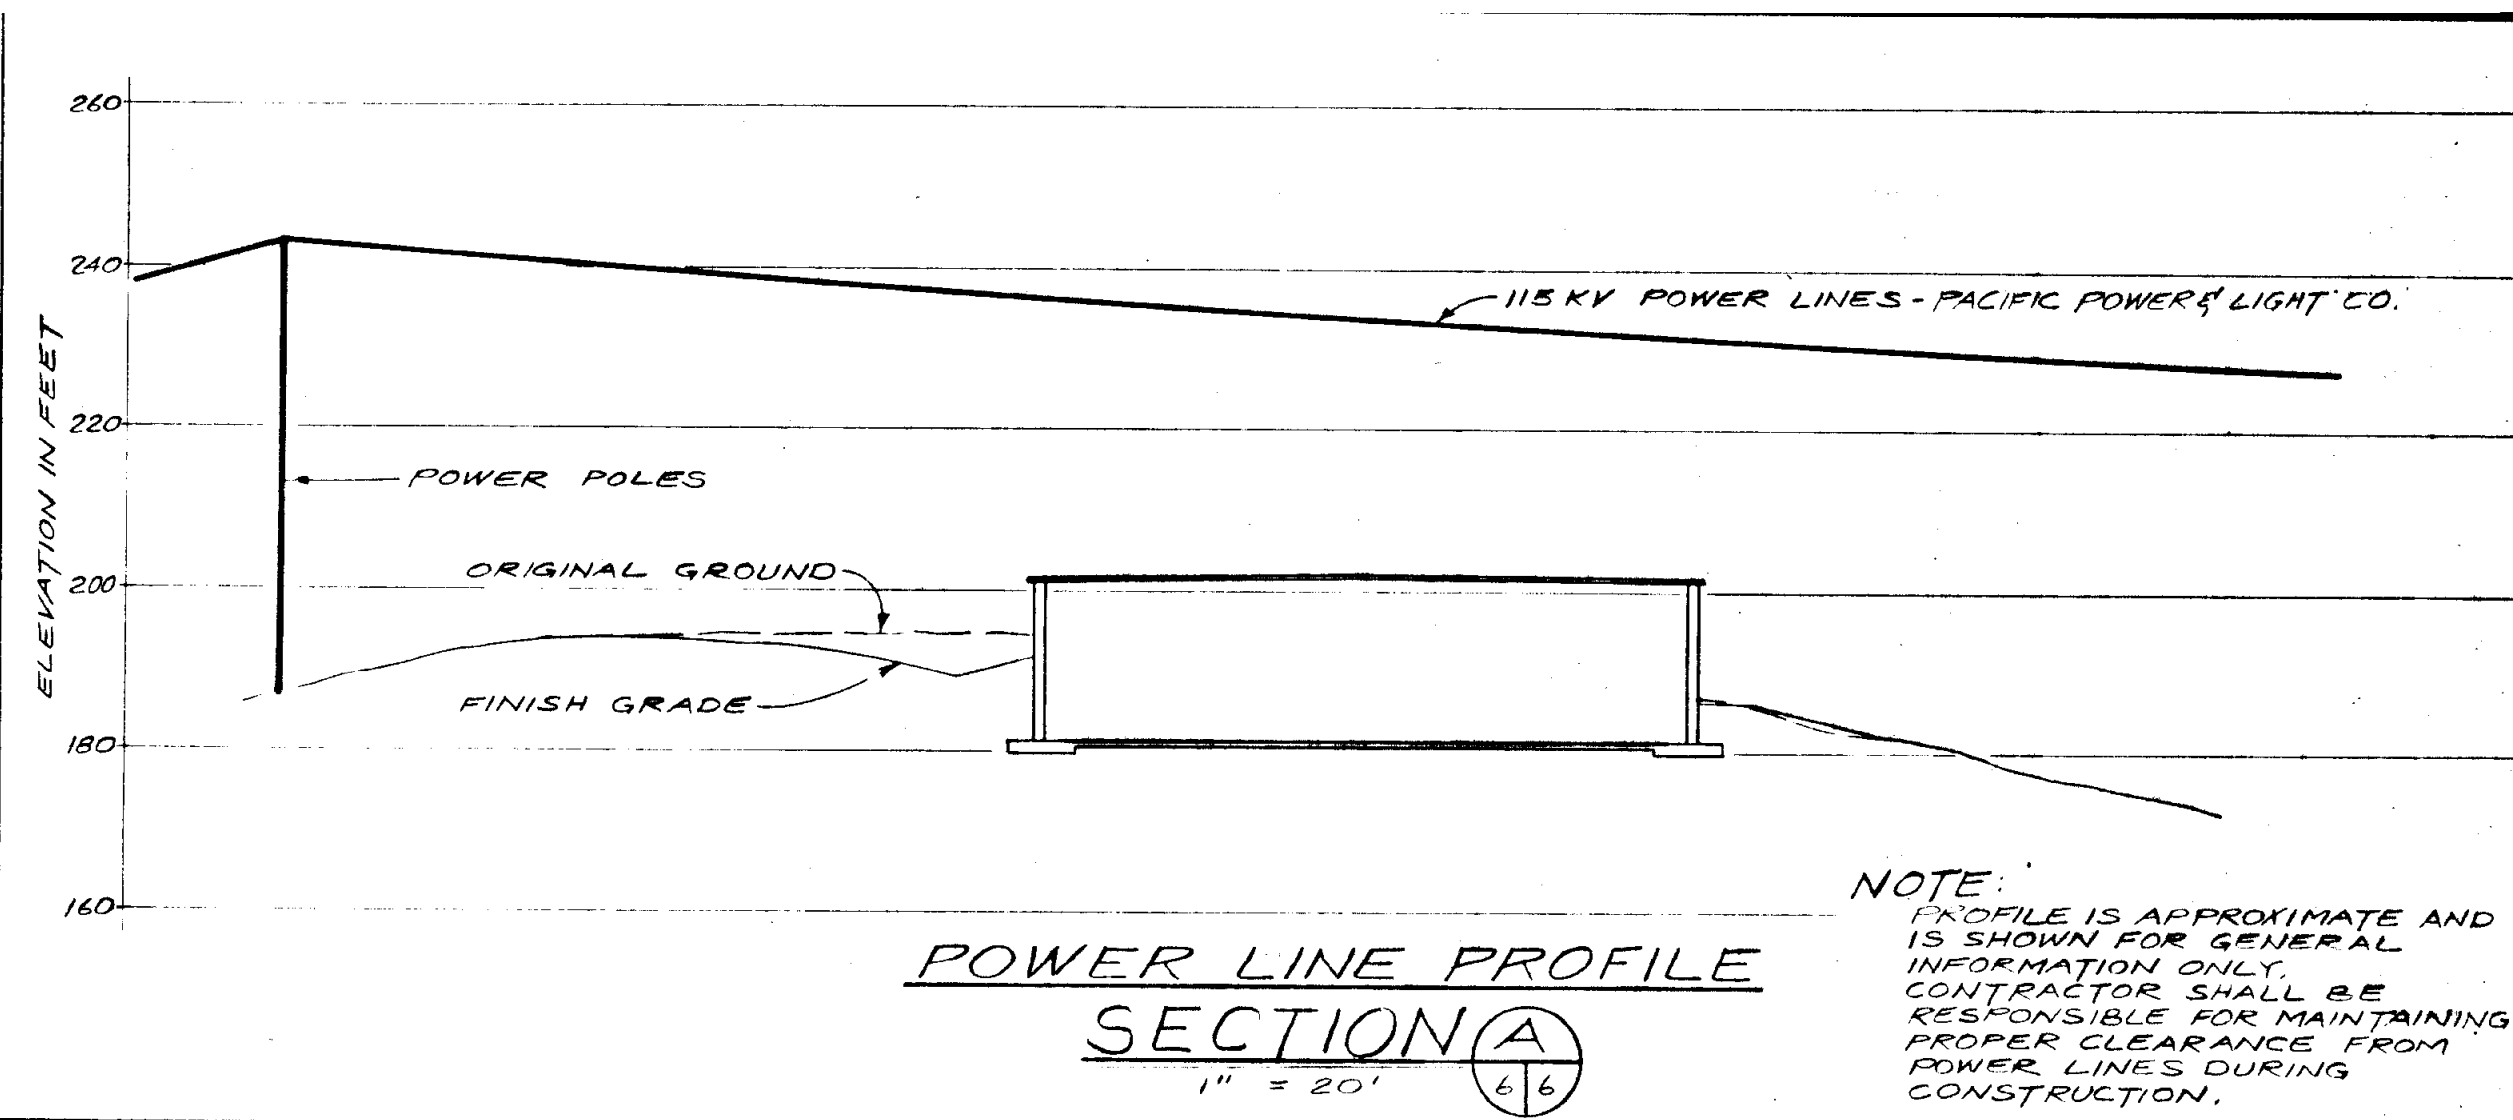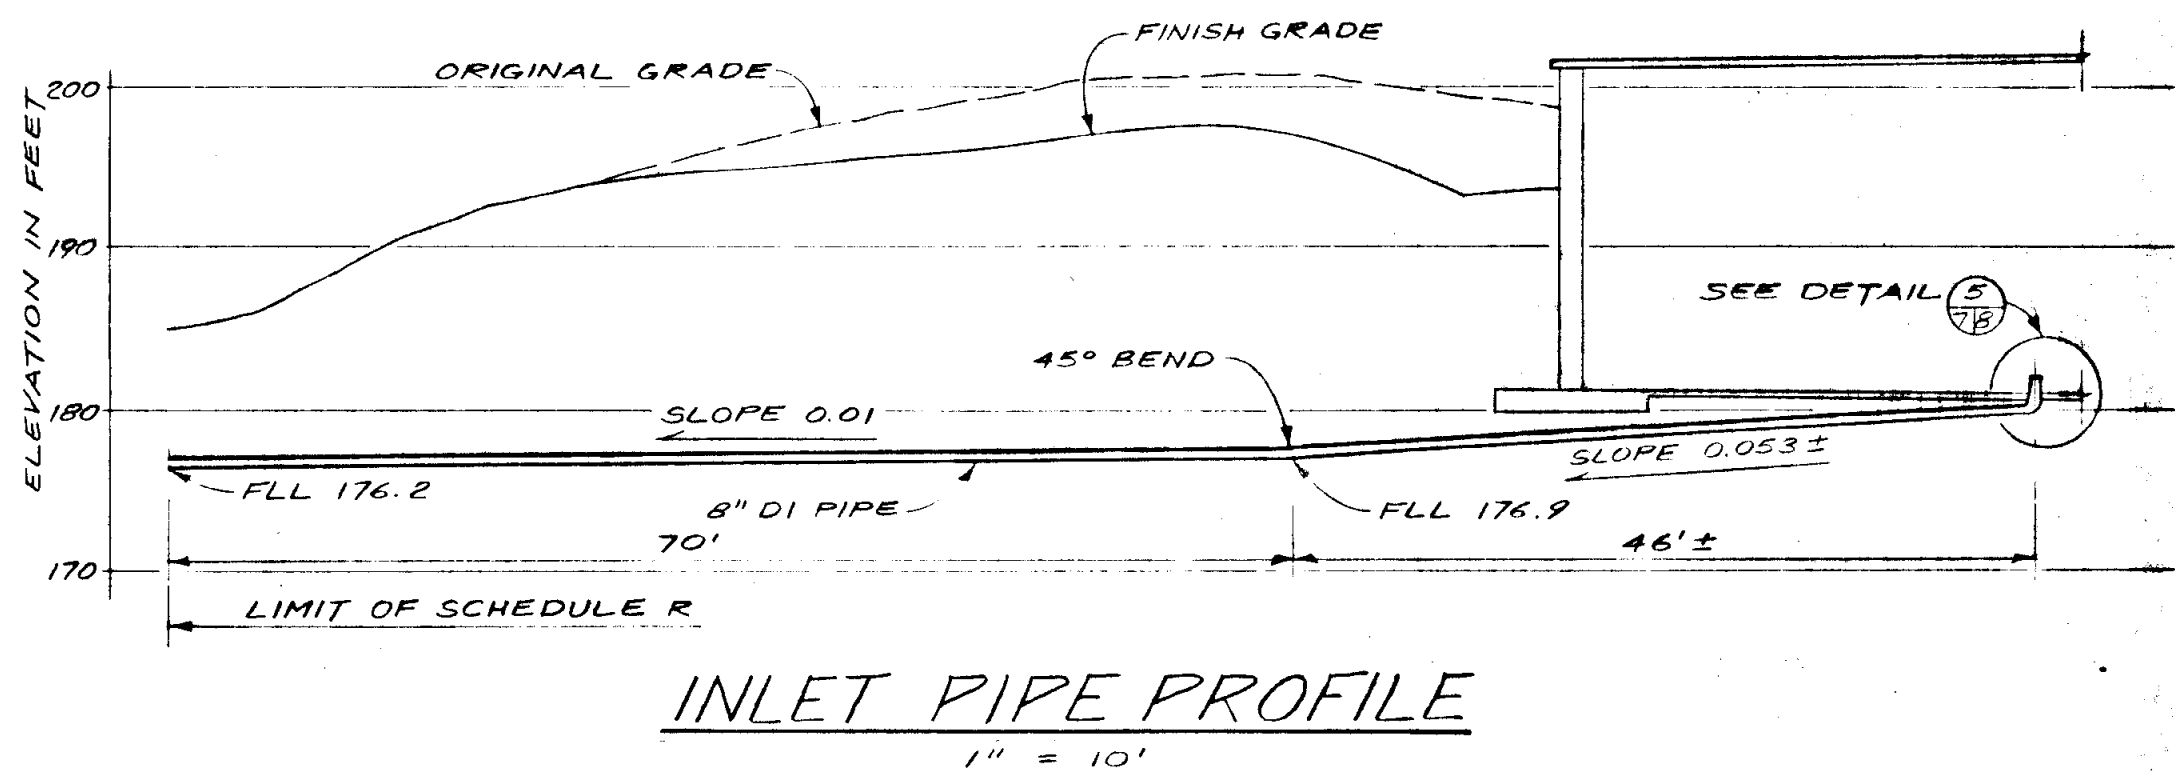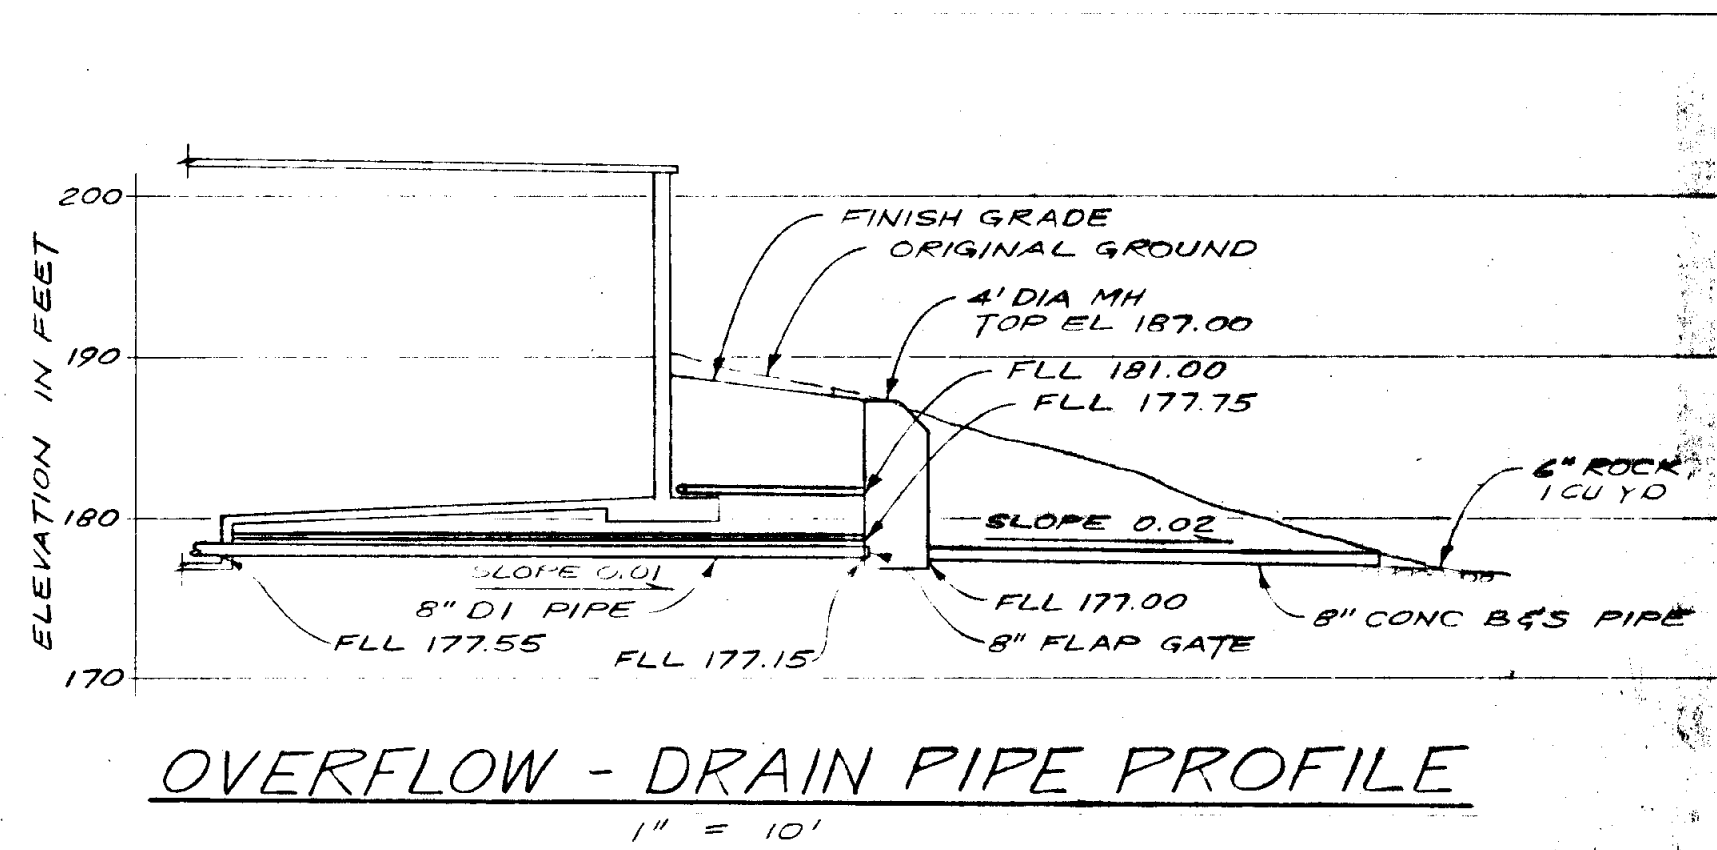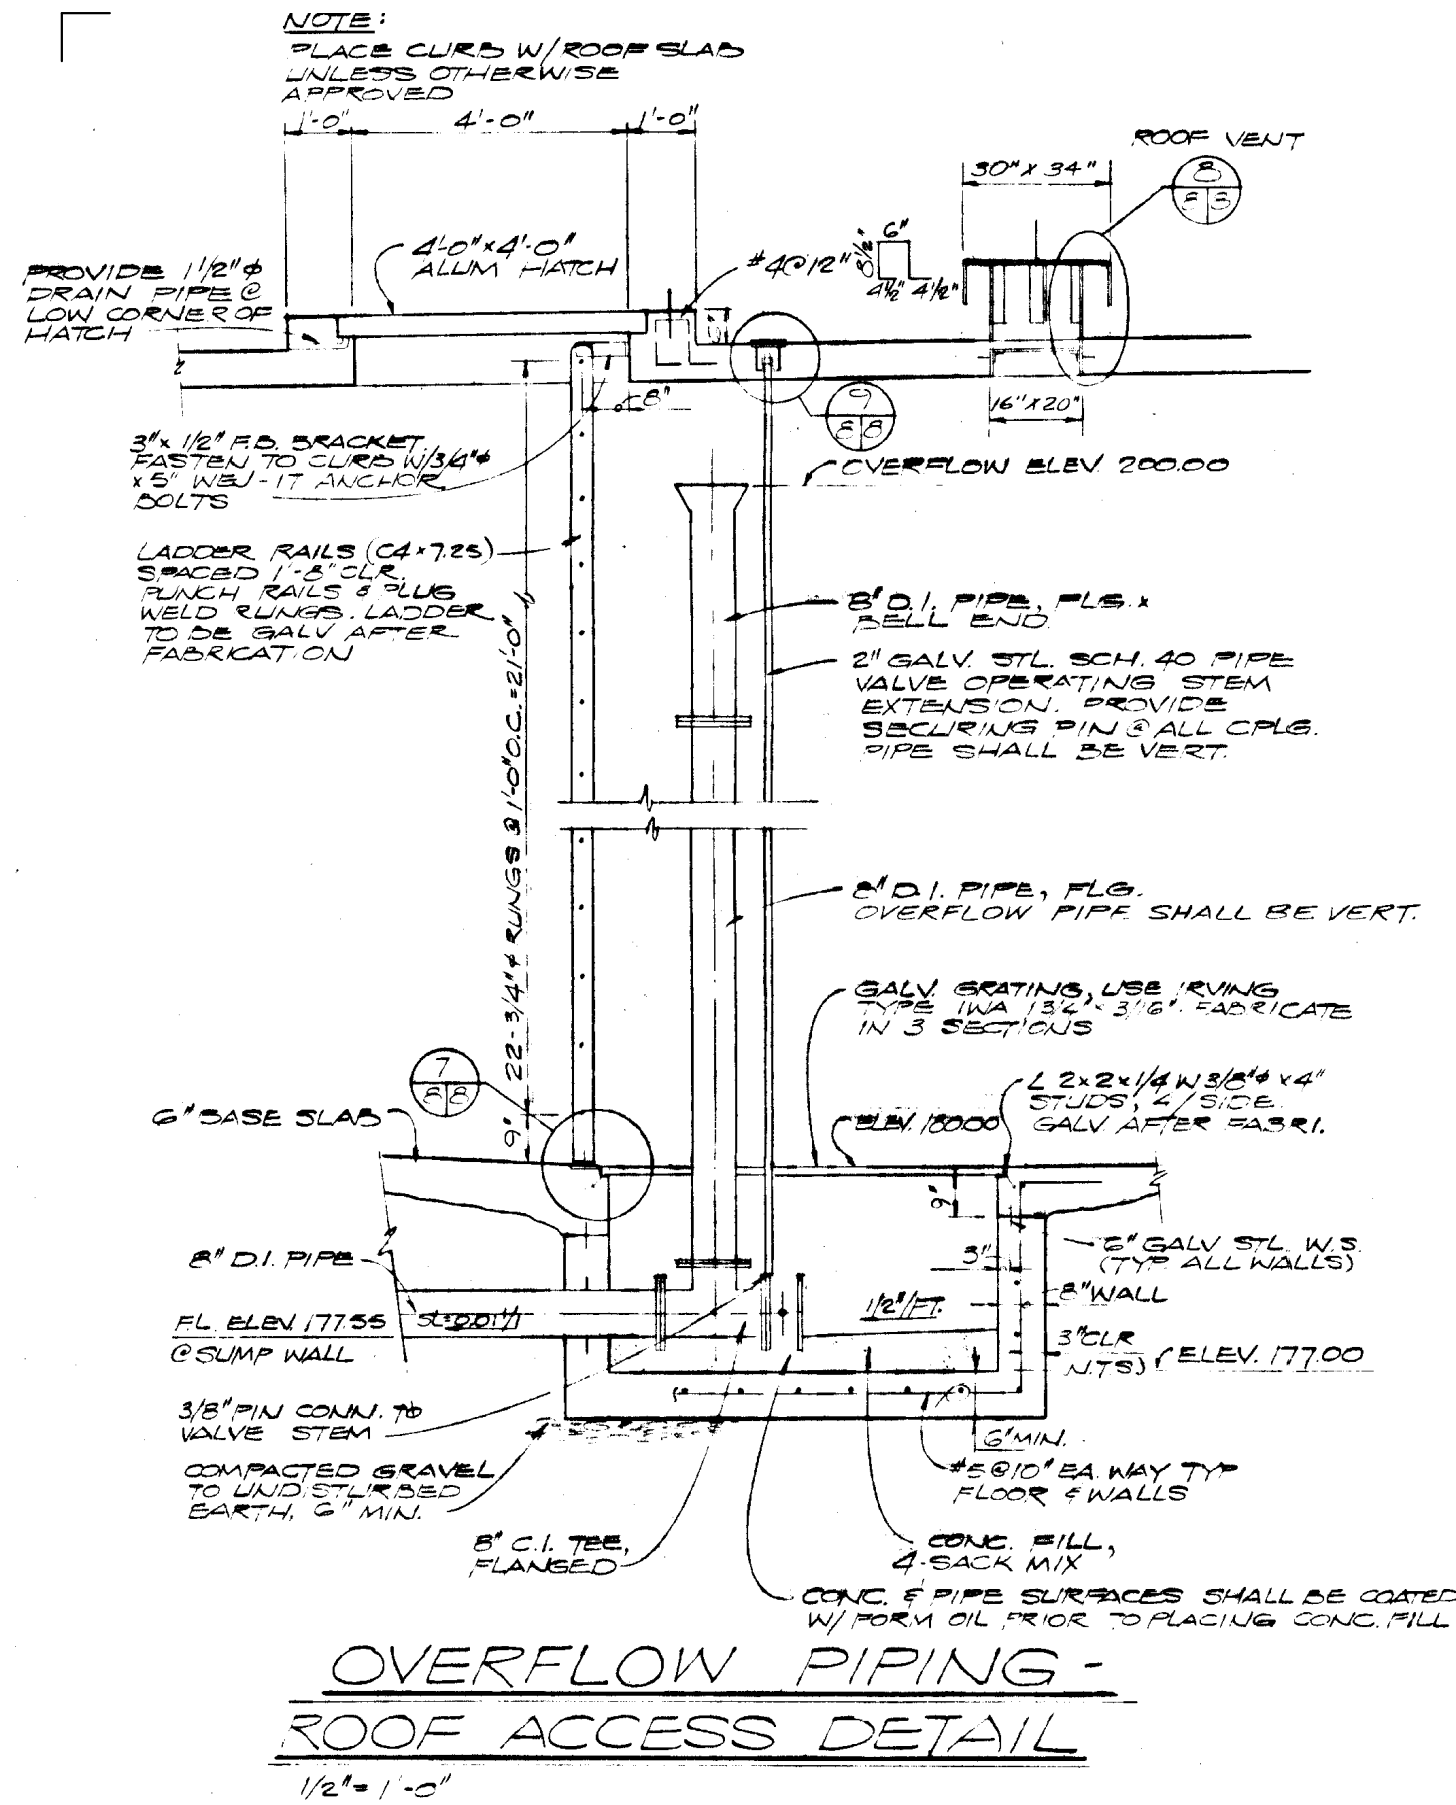

- LEGEND**
- 4" G.I. PIPE
 - 4"x3" G.I. REDUCER
 - GATE VALVE
 - 3" PRESSURE RELIEF VALVE
 - FLOOD DRAIN
 - CHLORINE INJECTOR
 - A.C. HUBXFLG. ADAPTER
 - FLG.XFLG. D.I. PIPE
 - 90° FLG. ELL.
 - 8"x4" FLG. TEE
 - 8"x6" FLG. REDUCER
 - FLG. B.V. W/HAND WHEEL
 - CHECK VALVE
 - FLG.XP.E. D.I. PIPE
 - FLG. COUPLING ADAPTER
 - 6"x4" FLG. TEE W/1/2" TAP
 - 6" TURBO-METER
 - 1/2" AIR RELIEF VALVE W/B.V.
 - 6" FLG.XFLG. D.I. PIPE TAPPED FOR CHLORINE DIFFUSER
 - PRESSURE GAUGE W/CORP. STOP (0-100 PSI)



Revisions:

1	8/24/2023	ADDENDUM #1
4	8/28/2023	ADDENDUM #4

WINDSOR ENGINEERS
Ridgefield, WA
Duluth + Minneapolis, MN
www.windsorengineers.com
Project No: 20198.3
Copyright 2023 By Windsor Engineers, LLC
All Rights Reserved.

**WATER RESILIENCY PROJECT
PHASE 1 - SEISMIC IMPROVEMENTS**
CITY OF CANNON BEACH, OR 97110

ENGINEERING PLAN
Issue Date: 8/28/2023

EXISTING DETAILS - MAIN RESERVOIR

C001

Project Manager: TWT
Drawn by: TWT
Checked by: MRL

PLOT DATE: 8/28/2023 4:24 PM - FILE: C:\Users\MARCUSJ\OneDrive - Windsor Engineers\05 Projects\2020\20198-3 Cannon Beach Seismic Valves\02 Drawings\04 Working\04_Final Sheets\20198-3_exc.dwg

NORTH RESERVOIR QUANTITIES		
ITEM	UNITS	QUANTITY
REMOVE PIPE	LF	20
REMOVE PIPE (ASBESTOS CONCRETE)	LF	0
TOPSOIL SALVAGE AND REINSTALL	SY	40
REMOVE VALVES	EA	3
SAWCUT CONCRETE	LF	50
REMOVE CONCRETE SURFACING	SY	400

- 050 DEMOLITION
- 050 REMOVE PIPE AS NEEDED TO INSTALL NEW VAULTS, FITTINGS AND VALVES. SEE SITE PLANS AND DETAILS FOR PROPOSED EQUIPMENT.
- 051 SAWCUT FULL DEPTH AND REMOVE PAVING
- 052 POT HOLE TO LOCATE EXISTING PIPES PRIOR TO BEGINNING CONSTRUCTION- SHOWN LOCATIONS ARE BASED ON RECORD PLANS AND FIELD LOCATES
- 053 REMOVE EXISING VAULT, VALVES, METERS, FITTINGS AND PIPE.
- 054 CEARING AND GRUBBING AS NEEDED FOR NEW POWER

- 100 SITE PLAN NOTES
- 100 EXISTING CHAIN LINK FENCE
- 101 GRAVEL EDGE
- 102 SALVAGE TOPSOIL IN ALL AREAS OF EXCAVATION AND GRADING


- 300 STORMWATER
- 300 EXISTING 6" UNDERDRAIN
- 301 EXISTING STORM STRUCTURE
- 302 EXISTING DAYLIGHT PIPE - INLET = 187.5 OUTLET = 186.5
- 303 EXISTING CONCRETE PIPE
- 304 EXISTING HDPE PIPE

- 500 WATER
- 500 EXISTING WATER TRUNK LINE
- 501 EXISTING ALTITUDE CONTROL VALVE AND VAULT
- 502 EXISTING RESERVOIR TANK
- 503 EXISTING PUMP HOUSE
- 504 EXISTING FIRE HYDRANT
- 505 EXISTING DI OVERFLOW PIPE
- 506 EXISTING DI WATER PIPE
- 507 EXISTING PVC WATER LINE
- 508 EXISTING ASBESTOUS CONCRETE WATER LINE
- 509 EXISTING VAULT
- 510 EXISTING ROOF HATCH
- 511 EXISTING ROOF VENT

- 600 DRY UTILITIES
- 600 EXISTING OVERHEAD POWER POLE
- 601 EXISTING OVERHEAD POWER
- 602 EXISTING CELLULAR CONTROL BOX
- 603 EXISTING UTILITY BOX
- 604 UNDERGROUND POWER AND COMMUNICATIONS TO US101



GENERAL SHEET NOTES:

1. ALL ASBESTOS CONCRETE PIPE REMOVED NEEDS TO BE REMOVED AND DISPOSED OF IN ACCORDANCE WITH OREGON DEQ RULES 340, DIVISION 248. AS WELL AS ANY LOCAL REQUIREMENTS INCLUDING OREGON OSHA AND CONSTRUCTION CONTRACTORS BOARD.

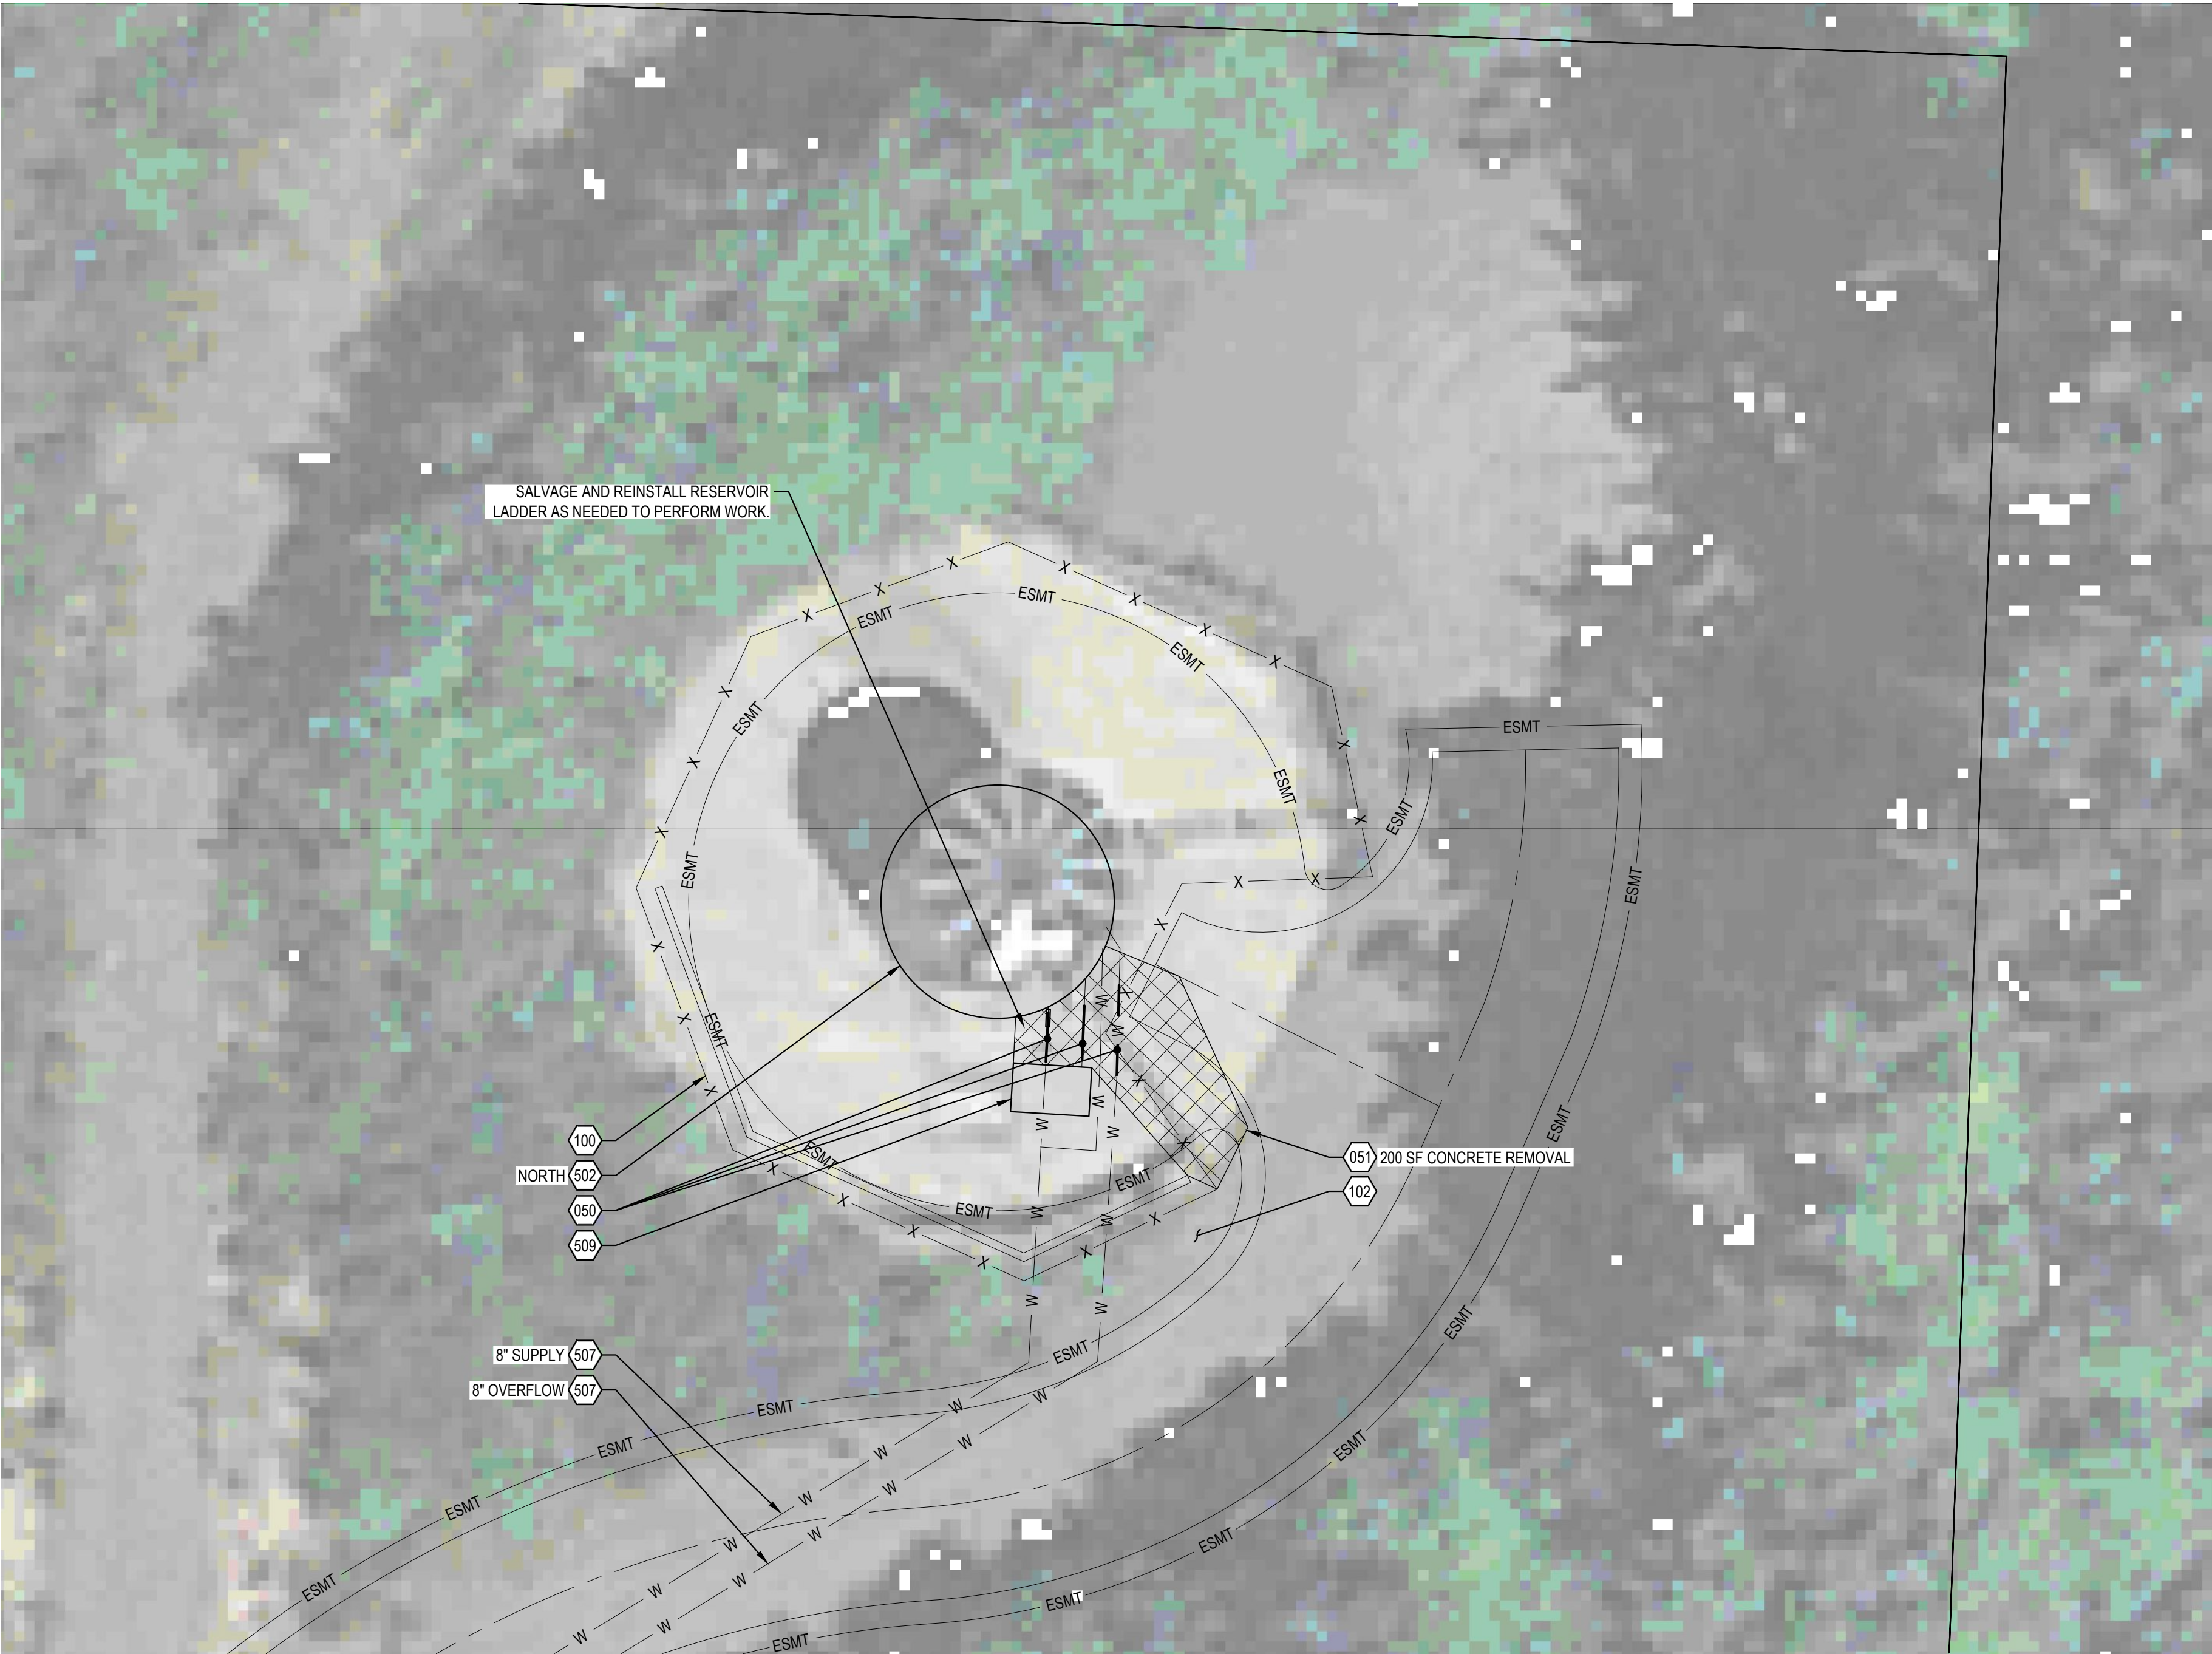


PLAN

SCALE: 1" = 10'

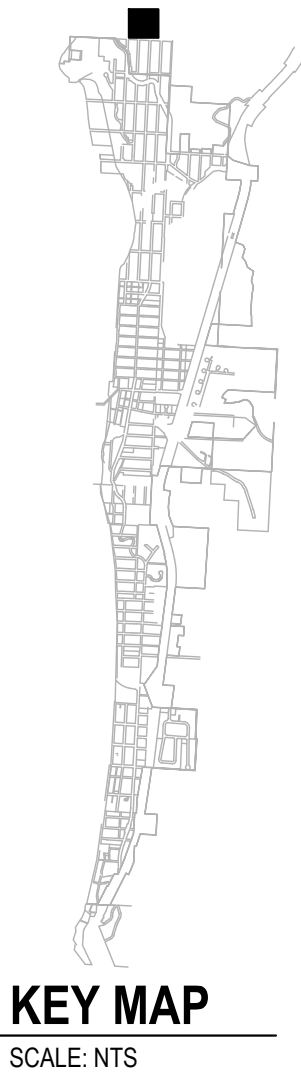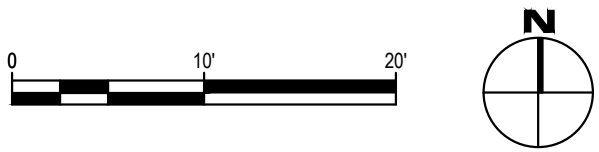


Know what's **below.**
Call before you dig.
CALL 2 BUSINESS DAYS BEFORE YOU DIG.
CAUTION: UTILITY INFORMATION IS APPROXIMATE.
VERIFY ALL UTILITIES PRIOR TO CONSTRUCTION.

Revisions:

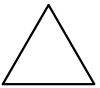


1	8/24/2023	ADDENDUM #1
4	8/28/2023	ADDENDUM #4

LINE IS 1" ON FULL
SCALE DRAWING

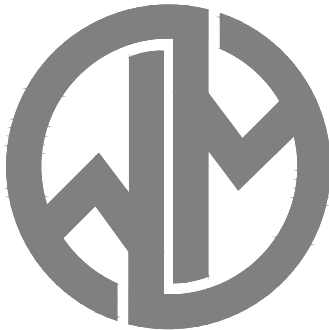

WINDSOR ENGINEERS
Ridgefield, WA
Duluth + Minneapolis, MN
www.windsorengineers.com
Project No: 20198.3
Copyright 2023 By Windsor Engineers, LLC
All Rights Reserved.

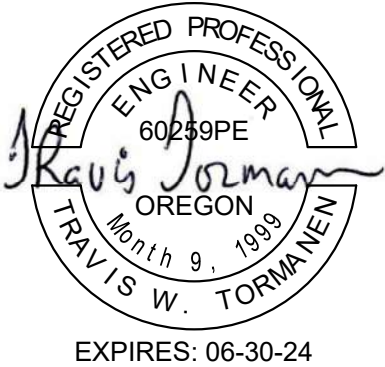


**WATER RESILIENCY PROJECT
PHASE 1 - SEISMIC IMPROVEMENTS**
CITY OF CANNON BEACH, OR 97110

ENGINEERING PLAN
Issue Date: 8/28/2023

Project Manager TWT
Drawn by TJM
Checked by MRL


**EXISTING CONDNTIONS AND DEMOLITION PLAN
- NORTH RESERVOIR**

C002

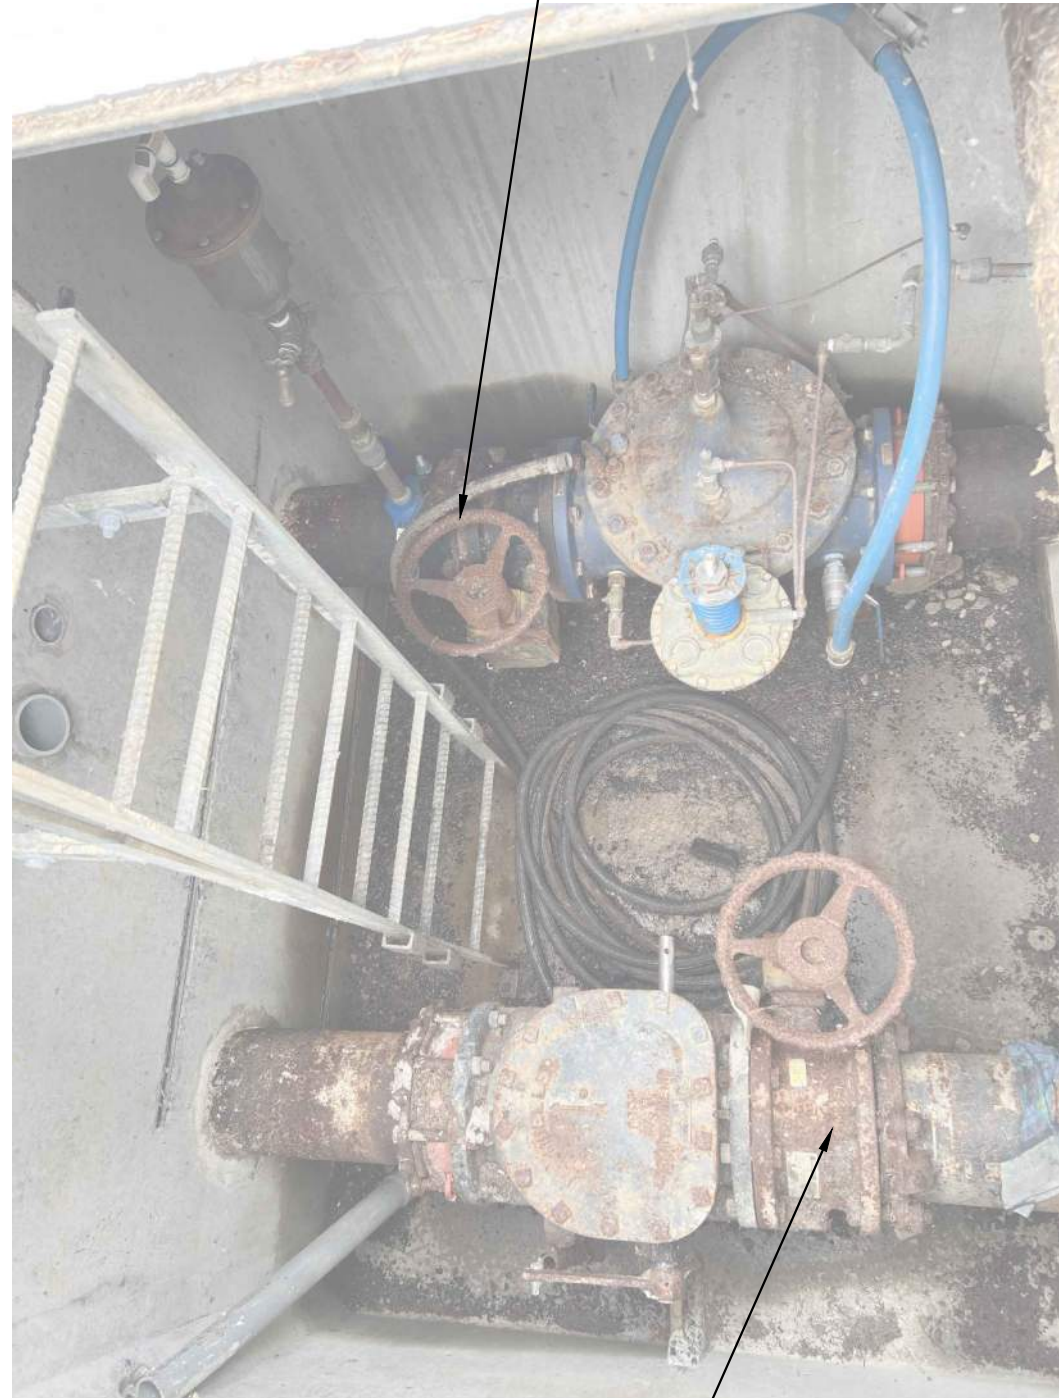


INLET VALVE LABEL IS MISSING; LOOKS LIKE PRATT GROUNDHOG (SAME AS OUTLET) MANUFACTURE DATE - 1998, NUMBER ON GEAR DRIVE IS MDT-25, NUMBER ON VALVE BODY IS 1230733. DIMENSION FLANGE TO FLANGE IS 7 1/2". OVERALL INCLUDING ALTITUDE VALVE IS 32"

OUTLET VALVE - PRATT GROUNDHOG, 8" RUBBER SEAT BUTTERFLY MANUFACTURE DATE - 1995, SERIAL NUMBER - 1 7588-2 DIMENSION FLANGE TO FLANGE IS 7 1/2". OVERALL INCLUDING CHECK VALVE IS 33"

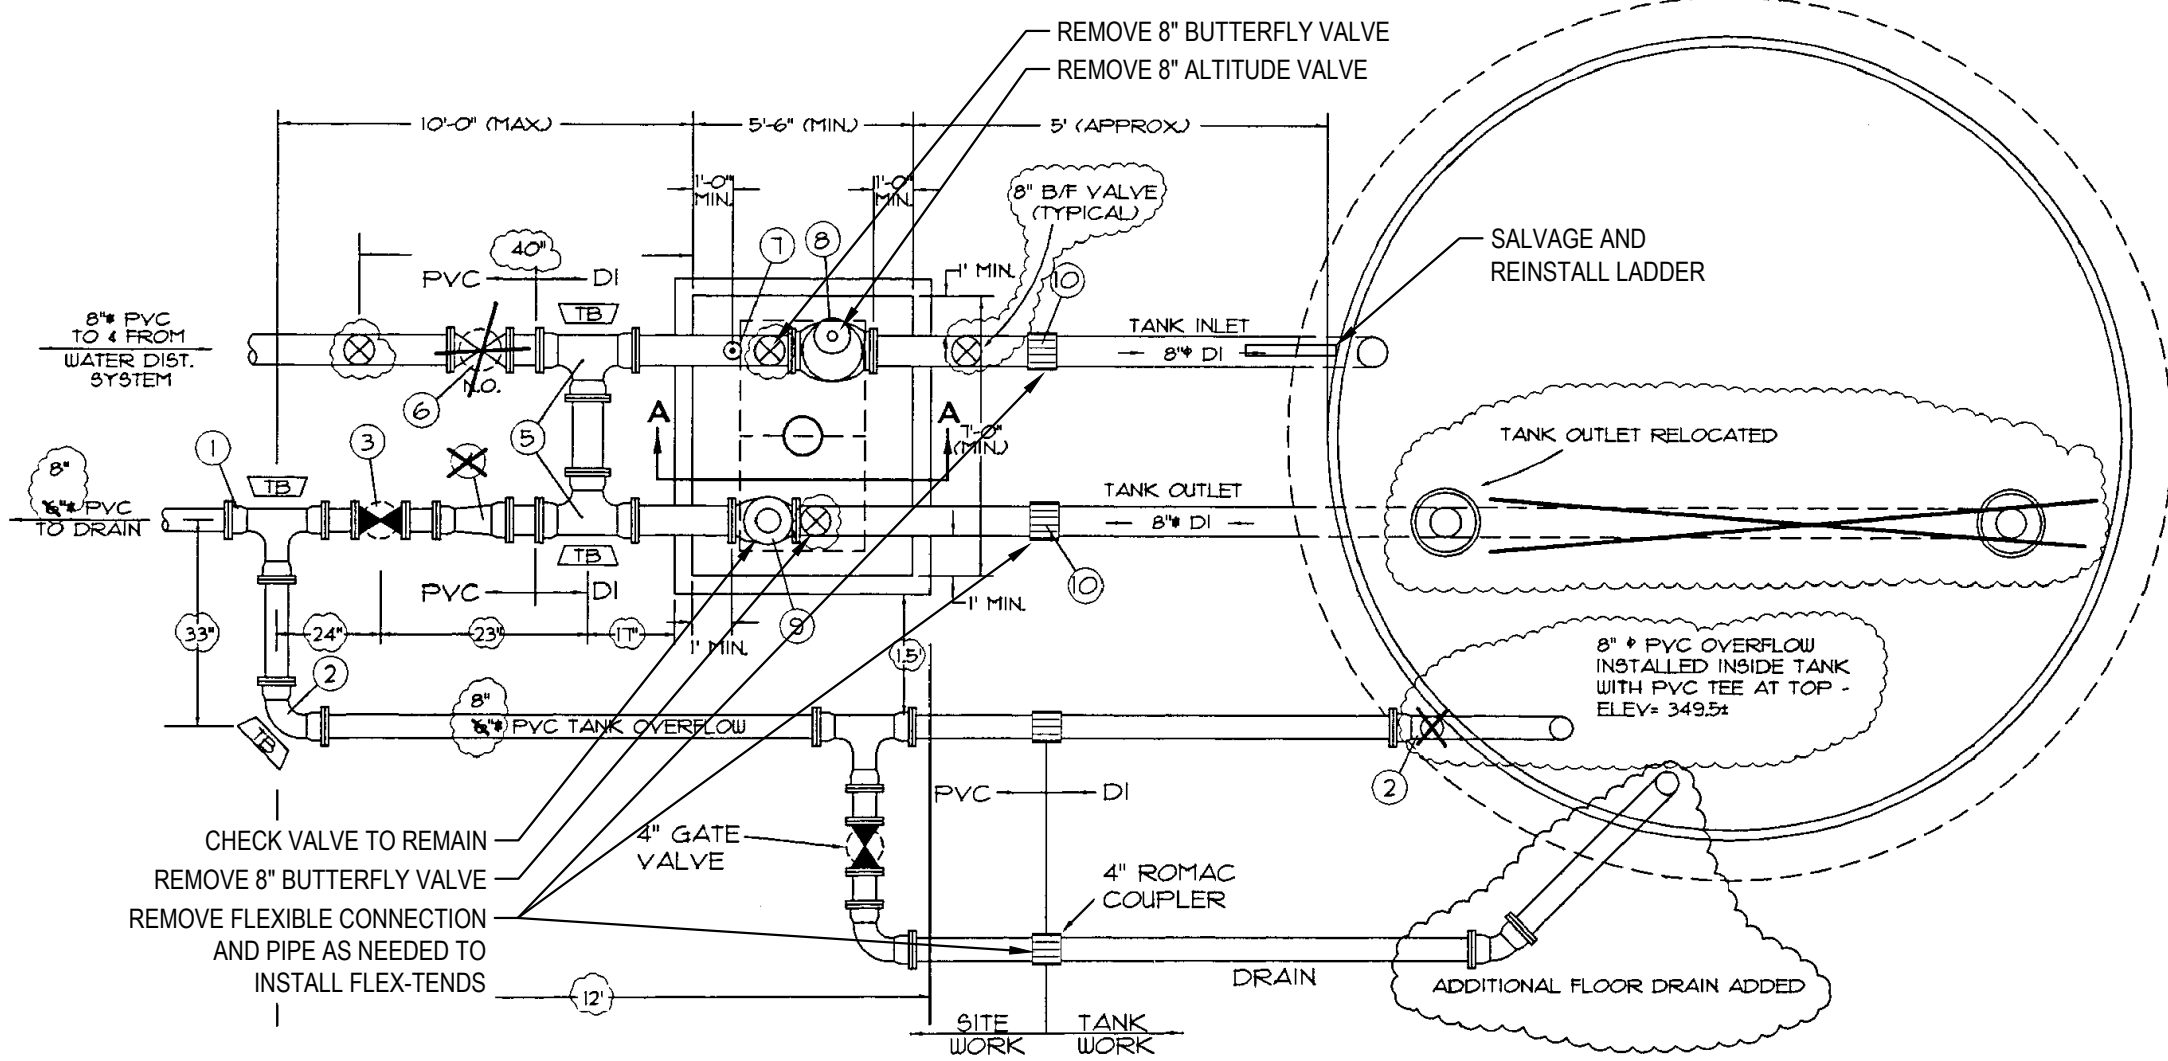

NOTE: "TB" = THRUST BLOCK, SEE DETAIL 2, SHEET 4 FOR THRUST BLOCK DIMENSIONS.

TANK PIPING LAYOUT - PLAN VIEW
SCALE: 1/4" = 1'

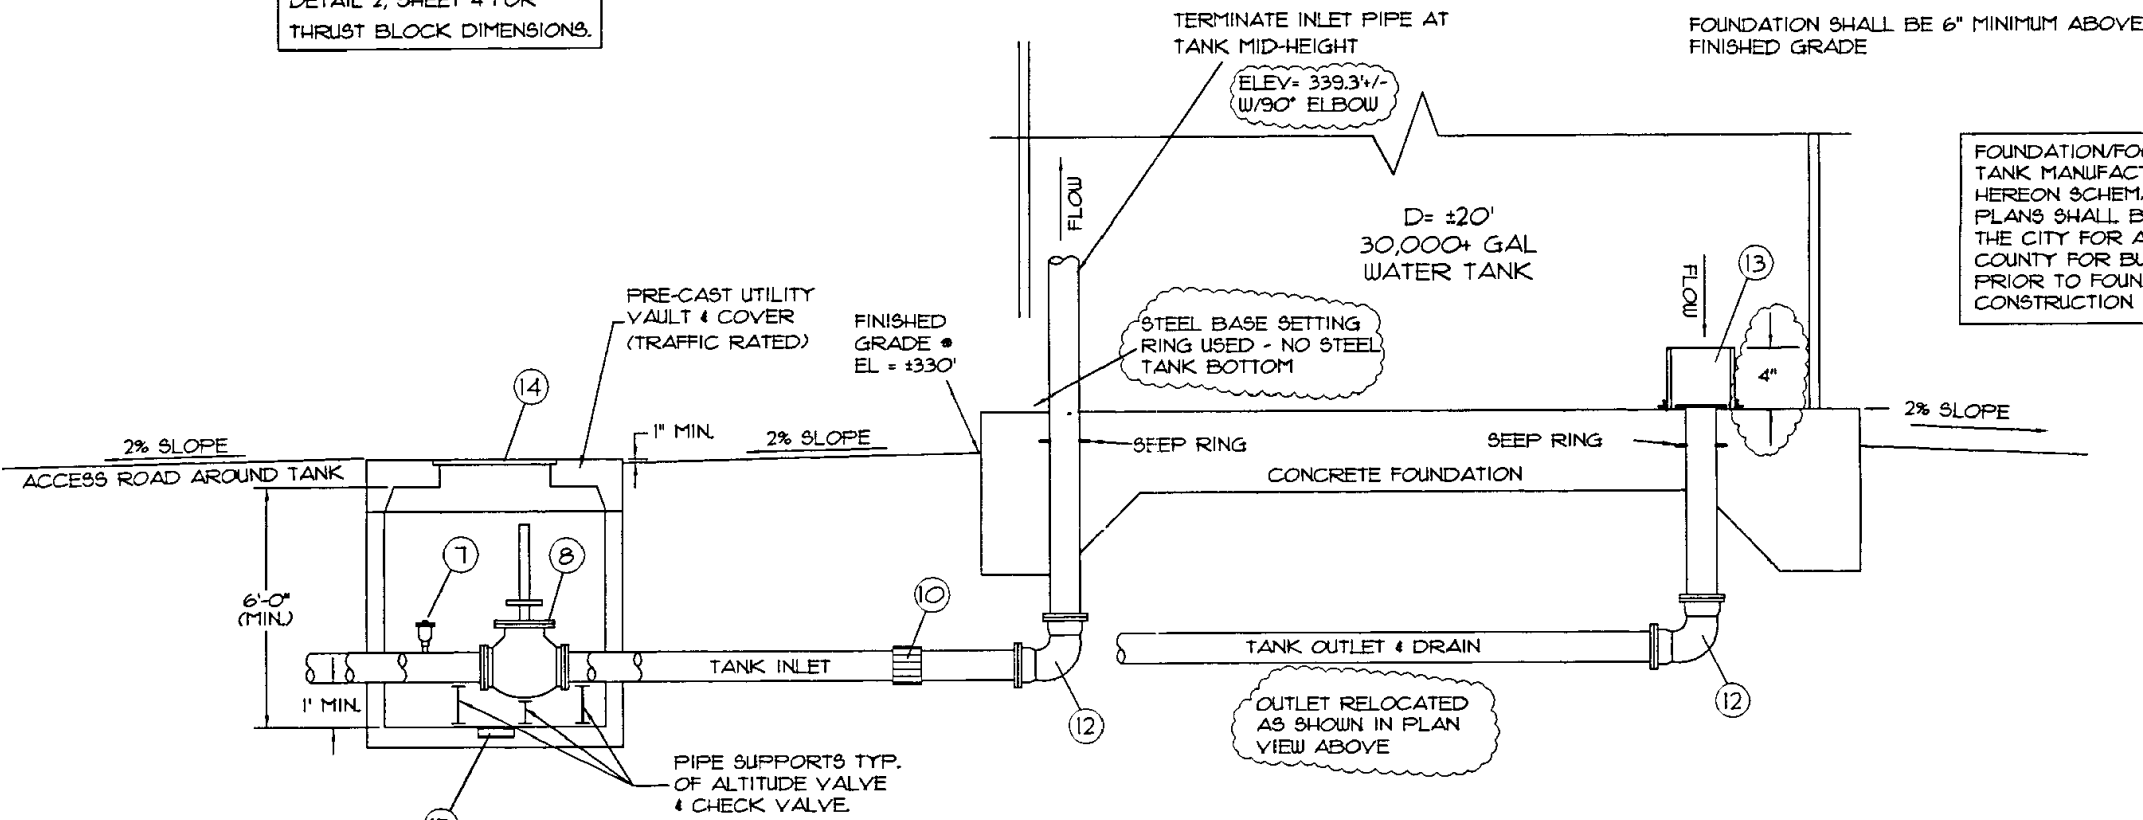

TANK PIPING LAYOUT - SECTION A-A
SCALE: 1/4" = 1'


PIPING COMPONENT TABLE

COMPONENT NUMBER	DESCRIPTION
1	6"x6"x6" MUXMUM DI TEE
2	6" MUXMUM DI 90° STD. ELBOW
3	6" GATE VALVE (NORMALLY CLOSED), WITH VALVE BOX
4	8"x6" MUXMUM DI REDUCER
5	8"x8"x8" MUXMUMUM DI TEE
6	8" GATE VALVE (NORMALLY OPEN), WITH VALVE BOX
7	AIR RELEASE VALVE
8	8" ALTITUDE VALVE
9	8" SPRING-ACTUATED CHECK VALVE
10	8" FLEXIBLE CONNECTION
11	6" FLEXIBLE CONNECTION
12	6" MUXMUM DI 90° STD. ELBOW
13	REMOVABLE SILT STOP (NOT USED - ADDITIONAL DEPRESSED DRAIN INSTALLED IN FLOOR)
14	2 DOOR GALV. STEEL ACCESS HATCH (TRAFFIC RATED)
15	VAULT SUMP (WITH 2" DRAIN PIPE WITH SCREENED END TO DAYLIGHT ON SLOPE - STATION 3+25.47 LT)


TANK DATA

TYPE: GLASS-FUSED-TO-STEEL
MANUFACTURER: FUSION TANKS & SILOS, ENGLAND
CONSTRUCTED BY: DUNNIRE ASSOCIATES, INC. 1007 PIONEER RD, DALLAS, OR 97338
FLOOR: CONCRETE SLAB WITH STEEL BASE-SETTING RING
TANK BASE ELEVATION: 330' (NGVD '29' DATUM)
HEIGHT: 21.7' (INCLUDING ROOF) 20.3' TO BRIM
DIAMETER: 16.8' NOMINAL
CAPACITY: 30,211 US GALLONS-BRIMFULL
SIDE ACCESS HATCH: DIAMETER = 31" (GALVANIZED)
ROOF INSPECTION HATCH: DIAMETER = 24"
ROOF: 17' LIGHT DUTY ROOF ASSEMBLY (TAPERED BEAM ROOF TYPE) (WEIGHT = 1900LB.)
TANK COLOR: FOREST GREEN
SNOW LOAD: 25 PSF, WIND LOAD: 100 MPH, SEISMIC LOADING: ZONE 4
CATHODIC TANK PROTECTION: NOT REQUIRED

OVERFLOW ELEVATION?

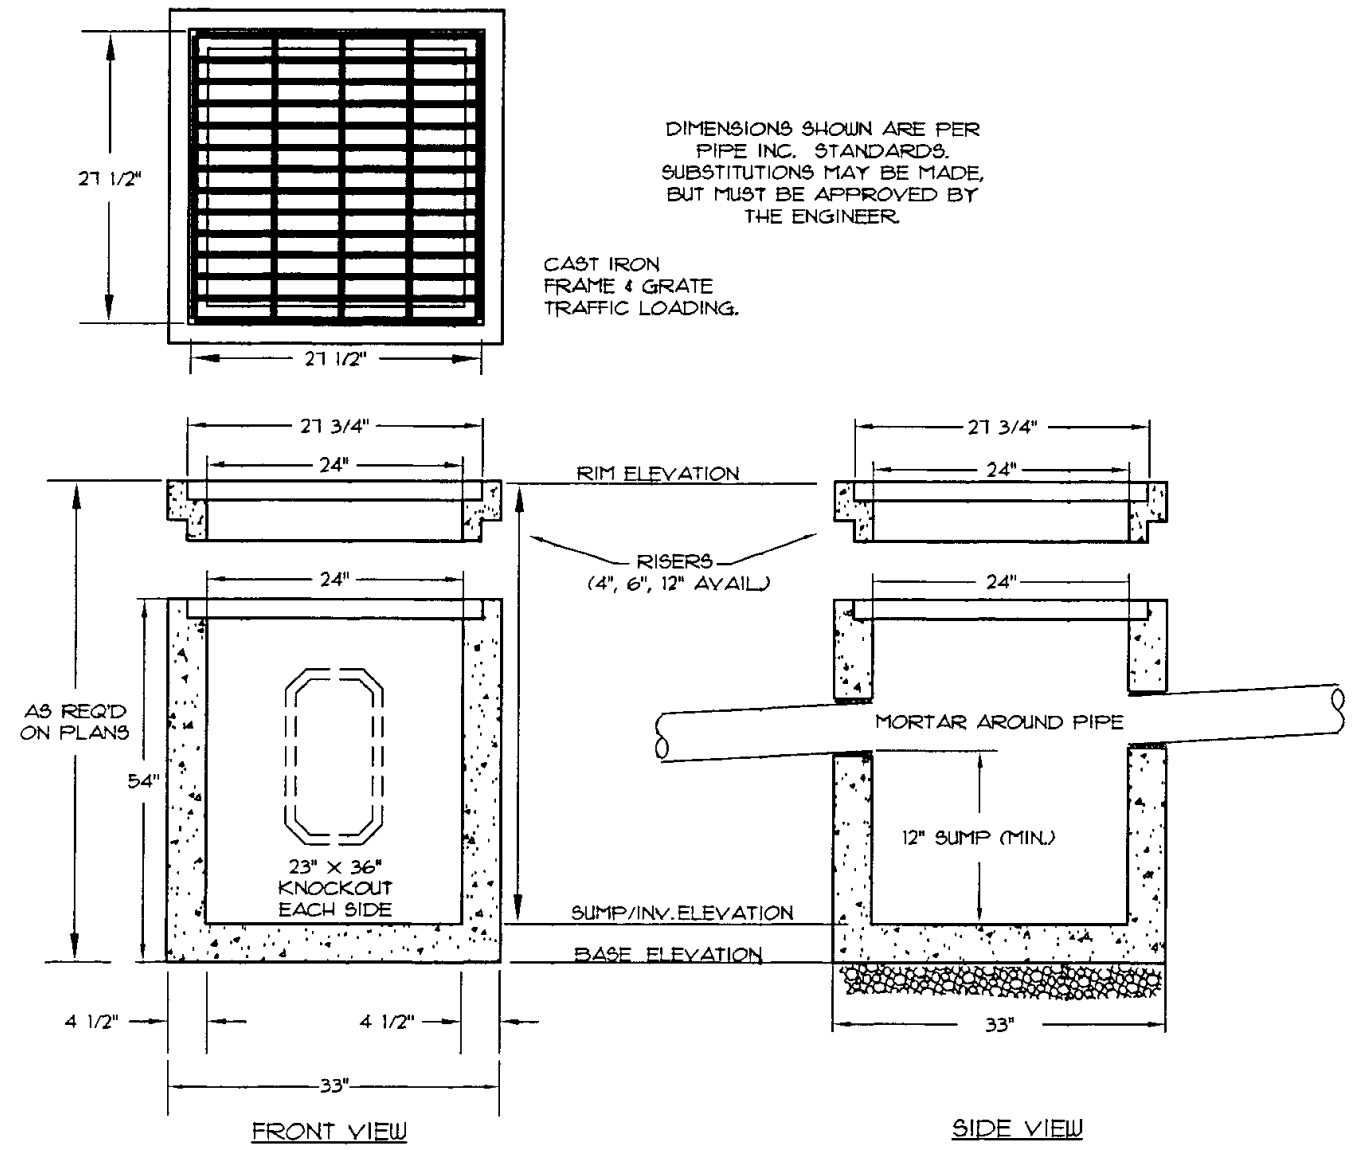

TYPE 24-A CATCH BASIN
NOT TO SCALE

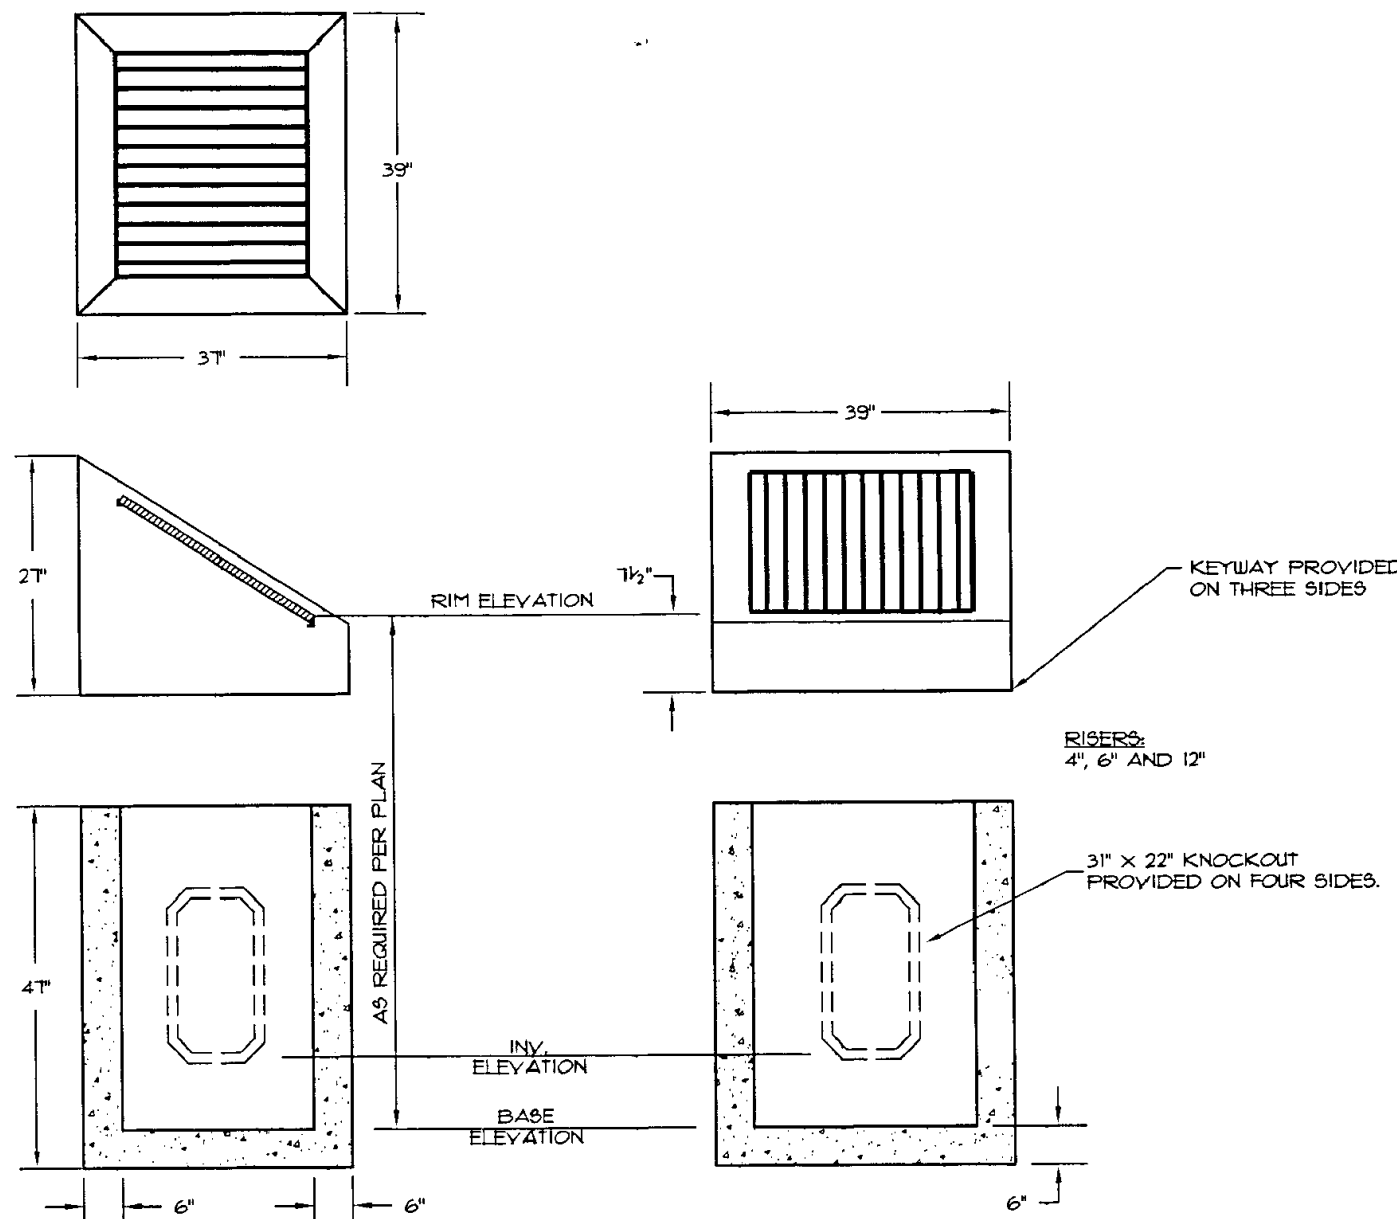

TYPE G-2 DITCH INLET
NOT TO SCALE

EROSION PREVENTION MATTING DETAIL
NOT TO SCALE

NOTES:

- ASBUILT DRAWINGS OBTAINED FROM CITY OF CANNON BEACH 2002 HLB RECORD PLAN SET.
- THE ENGINEER DOES NOT GUARANTEE THE ACCURACY OF THIS INFORMATION.



CALL 2 BUSINESS DAYS BEFORE YOU DIG.
CAUTION: UTILITY INFORMATION IS APPROXIMATE.
VERIFY ALL UTILITIES PRIOR TO CONSTRUCTION.

Revisions:

1	8/24/2023	ADDENDUM #1
4	8/28/2023	ADDENDUM #4

LINE IS 1" ON FULL SCALE DRAWING

WINDSOR ENGINEERS



Ridgefield, WA
Duluth + Minneapolis, MN
www.windsorengineers.com
Project No: 20198.3

Copyright 2023 By Windsor Engineers, LLC
All Rights Reserved.



EXPIRES: 06-30-24

WATER RESILIENCY PROJECT
PHASE 1 - SEISMIC IMPROVEMENTS
CITY OF CANNON BEACH, OR 97110

ENGINEERING PLAN
Issue Date: 8/28/2023

Project Manager: TWT
Drawn by: TJM
Checked by: MRL

EXISTING DETAILS - NORTH RESERVOIR

C003


PLOT DATE: 8/28/2023 4:24 PM - FILE: C:\Users\MARCUSJ\OneDrive - Windsor Engineers\05 Projects\2020\20198-3 Cannon Beach Seismic Valves\02 Drawings\01 Working\04_Final Sheets\20198-3_exc.dwg

SOUTH RESERVOIR QUANTITIES		
ITEM	UNITS	QUANTITY
REMOVE PIPE	LF	80
REMOVE PIPE (ASBESTOS CONCRETE)	LF	0
GRAVEL SALVAGE AND REINSTALL	SY	30
TOPSOIL SALVAGE AND REINSTALL	SY	35
REMOVE VALVES	EA	5
SAWCUT CONCRETE	LF	10
SAWCUT ASPHALT PAVEMENT	LF	50
REMOVE CONCRETE SURFACING	SY	55
REMOVE ASPHALT PAVEMENT	SY	15
REMOVAL OF STRUCTURES AND OBSTRUCTIONS	EA	1
CLEARING AND GRUBBING (AS NEEDED)	SY	30



PLAN

SCALE: 1" = 20'

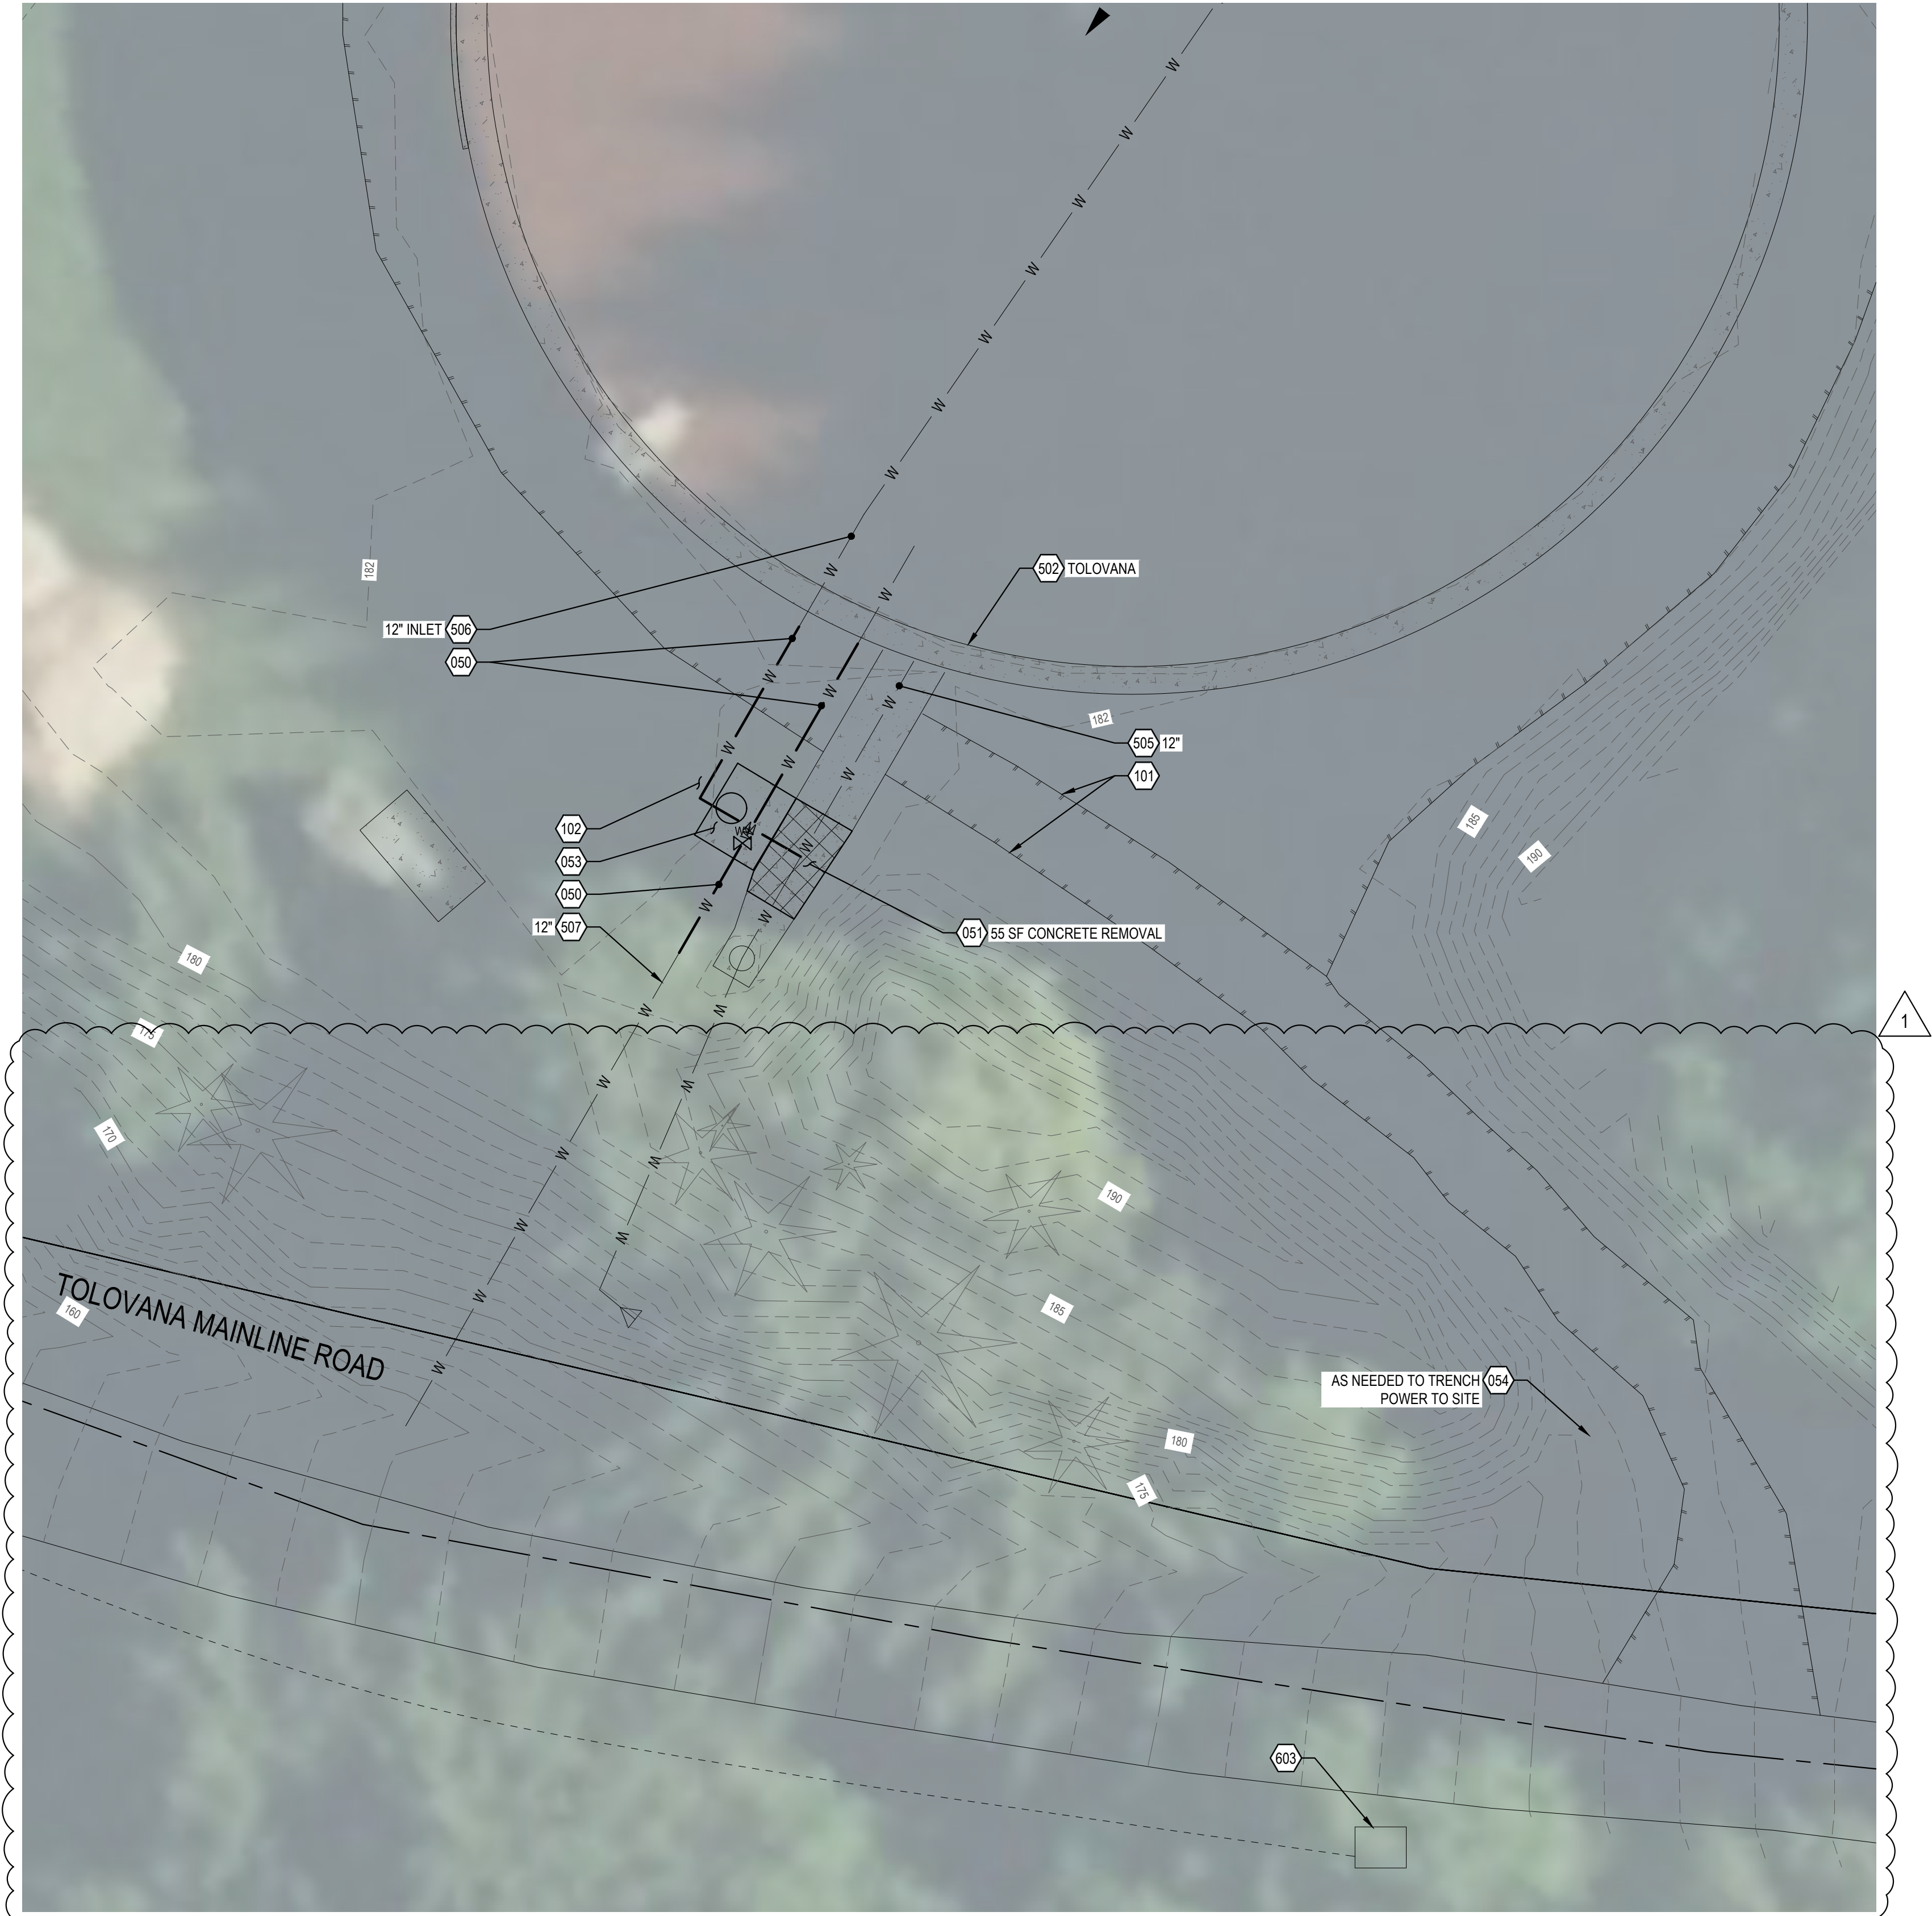

PLAN

SCALE: 1" = 20'

050 DEMOLITION

- 050 REMOVE PIPE AS NEEDED TO INSTALL NEW VAULTS, FITTINGS AND VALVES. SEE SITE PLANS AND DETAILS FOR PROPOSED EQUIPMENT.
- 051 SAWCUT FULL DEPTH AND REMOVE PAVING
- 052 POT HOLE TO LOCATE EXISTING PIPES PRIOR TO BEGINNING CONSTRUCTION- SHOWN LOCATIONS ARE BASED ON RECORD PLANS AND FIELD LOCATES
- 053 REMOVE EXISTING VAULT, VALVES, METERS, FITTINGS AND PIPE.
- 054 CLEARING AND GRUBBING AS NEEDED FOR NEW POWER

100 SITE PLAN NOTES

- 100 EXISTING CHAIN LINK FENCE
- 101 GRAVEL EDGE
- 102 SALVAGE TOPSOIL IN ALL AREAS OF EXCAVATION AND GRADING

300 STORMWATER

- 300 EXISTING 6" UNDERDRAIN
- 301 EXISTING STORM STRUCTURE
- 302 EXISTING DAYLIGHT PIPE - INLET = 187.5 OUTLET = 186.5
- 303 EXISTING CONCRETE PIPE
- 304 EXISTING HDPE PIPE

500 WATER


- 500 EXISTING WATER TRUNK LINE
- 501 EXISTING ALTITUDE CONTROL VALVE AND VAULT
- 502 EXISTING RESERVOIR TANK
- 503 EXISTING PUMP HOUSE
- 504 EXISTING FIRE HYDRANT
- 505 EXISTING DI OVERFLOW PIPE
- 506 EXISTING DI WATER PIPE
- 507 EXISTING PVC WATER LINE
- 508 EXISTING ASBESTOS CONCRETE WATER LINE
- 509 EXISTING VAULT
- 510 EXISTING ROOF HATCH
- 511 EXISTING ROOF VENT

600 DRY UTILITIES

- 600 EXISTING OVERHEAD POWER POLE
- 601 EXISTING OVERHEAD POWER
- 602 EXISTING CELLULAR CONTROL BOX
- 603 EXISTING UTILITY BOX
- 604 UNDERGROUND POWER AND COMMUNICATIONS TO US101

GENERAL SHEET NOTES:

1. ALL ASBESTOS CONCRETE PIPE REMOVED NEEDS TO BE REMOVED AND DISPOSED OF IN ACCORDANCE WITH OREGON DEQ RULES 340, DIVISION 248. AS WELL AS ANY LOCAL REQUIREMENTS INCLUDING OREGON OSHA AND CONSTRUCTION CONTRACTORS BOARD.

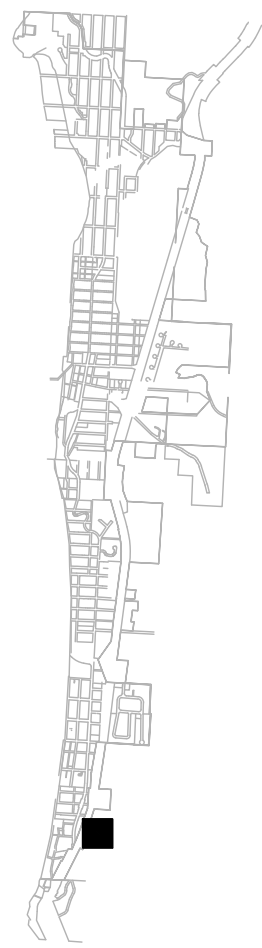

KEY MAP

SCALE: NTS



Know what's below.
Call before you dig.

CALL 2 BUSINESS DAYS BEFORE YOU DIG.
CAUTION UTILITY INFORMATION IS APPROXIMATE.
VERIFY ALL UTILITIES PRIOR TO CONSTRUCTION.

Revisions:

1	8/24/2023	ADDENDUM #1
4	8/28/2023	ADDENDUM #4


LINE IS 1" ON FULL
SCALE DRAWING



WINDSOR ENGINEERS

Ridgefield, WA
Duluth + Minneapolis, MN
www.windsorengineers.com
Project No: 20198.3

Copyright 2023 By Windsor Engineers, LLC
All Rights Reserved.

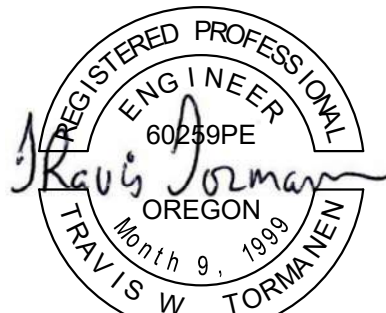

EXPIRES: 06-30-24

WATER RESILIENCY PROJECT
PHASE 1 - SEISMIC IMPROVEMENTS
CITY OF CANNON BEACH, OR 97110

ENGINEERING PLAN



Issue Date: 8/28/2023

Project Manager TWT
Drawn by TJM
Checked by MRL

EXISTING CONDITIONS AND DEMOLITION
PLAN- TOLOVANA RESERVOIR

C004

Plot Date: 02/28/2023 4:24 PM - File: C:\Users\MARCUSJ\OneDrive - Windsor Engineers\05 Projects\2020\20198 - Cannon Beach Seismic Values\02 Drawings\01 Working\04 Final Sheets\20198.3_002.dwg

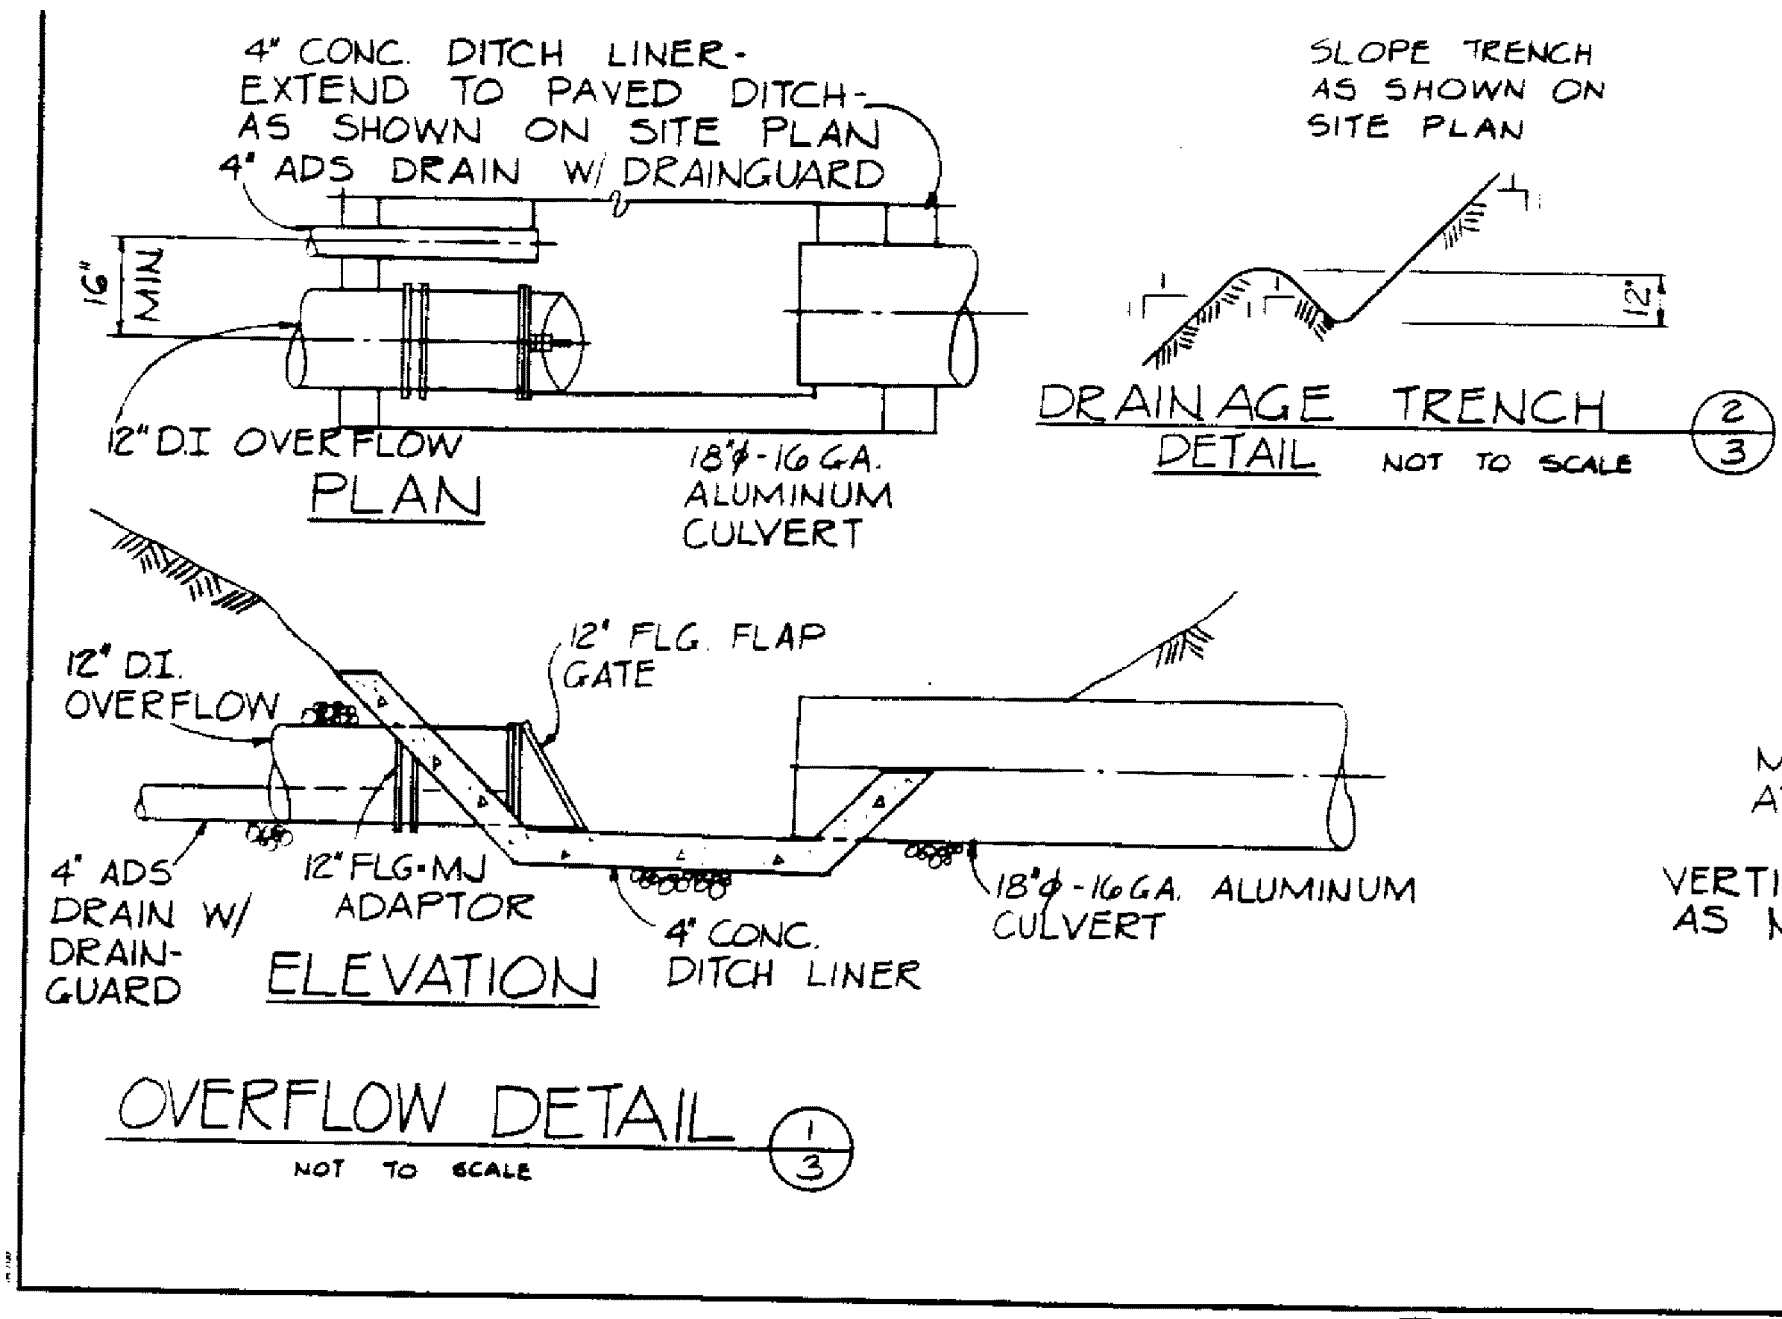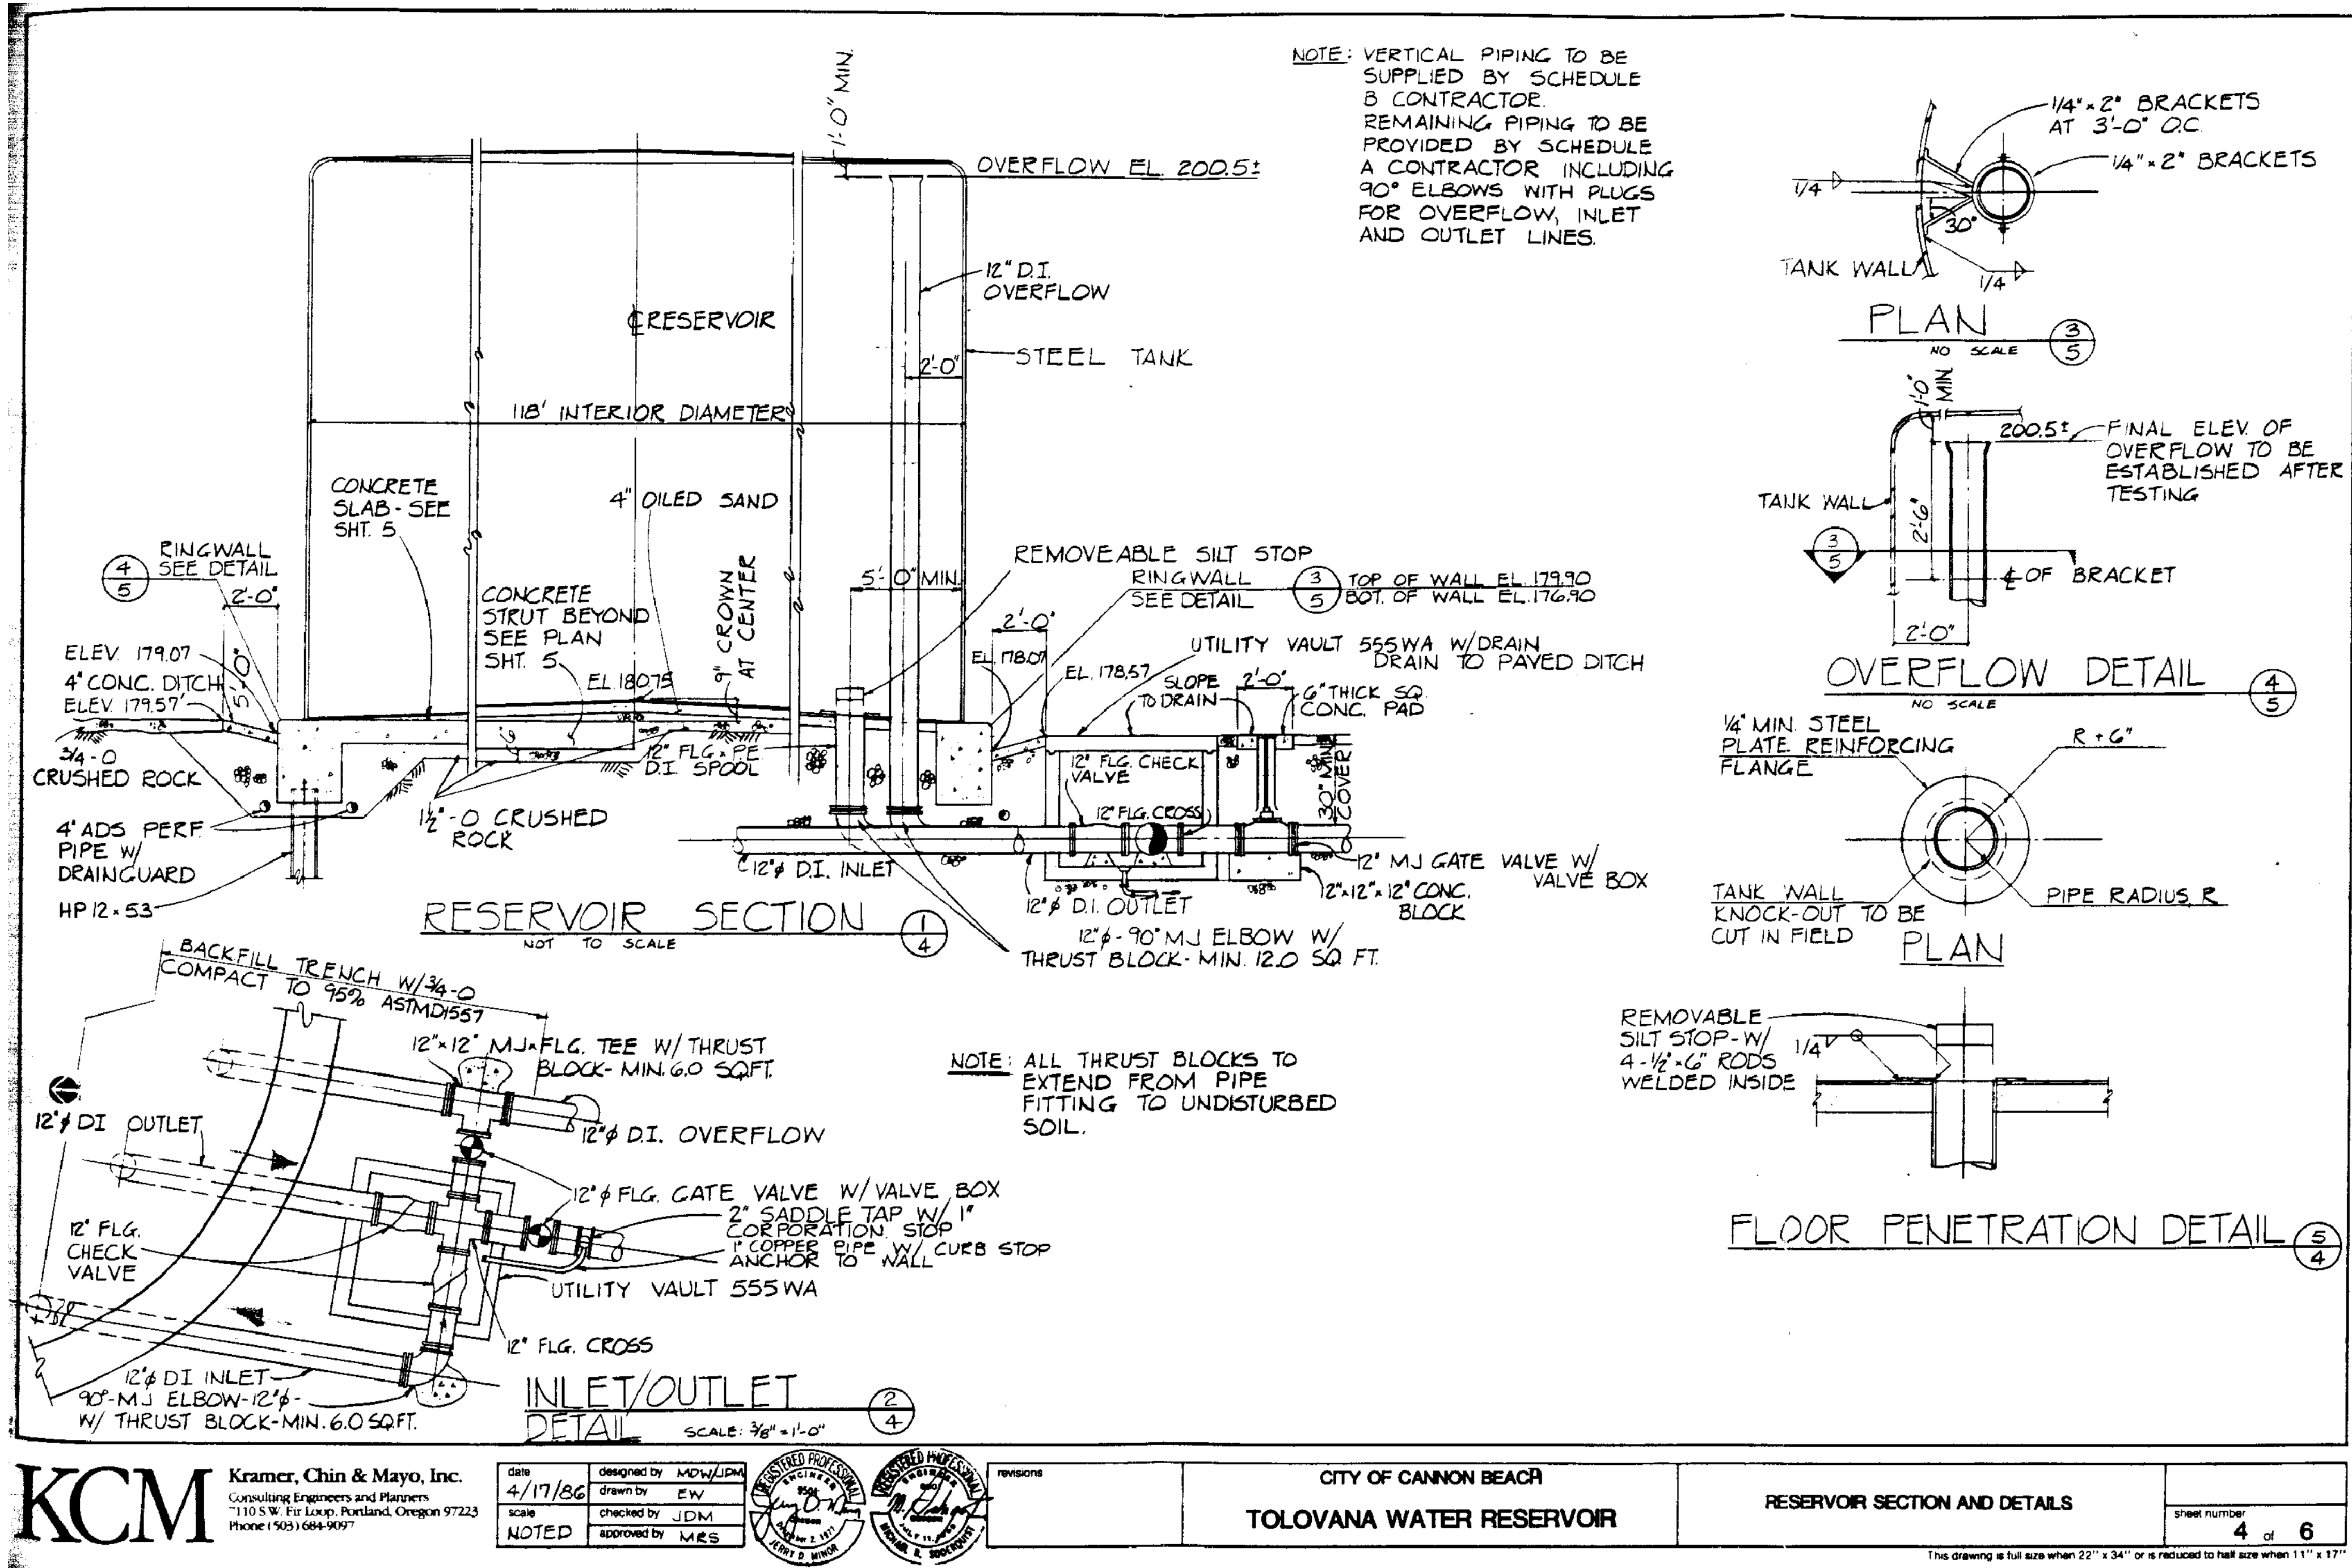

- NOTES:
1. ASBUILT DRAWINGS OBTAINED FROM CITY OF CANNON BEACH 1986 KCM PLAN SET.
 2. THE ENGINEER DOES NOT GUARANTEE THE ACCURACY OF THIS INFORMATION.

KCM

Kramer, Chin & Mayo, Inc.
Consulting Engineers and Planners
110 S.W. 1st Loop, Portland, Oregon 97223
Phone (503) 684-9097

date 4/17/86 designed by MDW/JDM
drawn by EW
scale checked by JDM
approved by MRS



revisions

CITY OF CANNON BEACH
TOLOVANA WATER RESERVOIR

RESERVOIR SECTION AND DETAILS

Sheet number
4 of 6

This drawing is full size when 22" x 34" or is reduced to half size when 11" x 17"



Know what's below.
Call before you dig.

CALL 2 BUSINESS DAYS BEFORE YOU DIG.
CAUTION: UTILITY INFORMATION IS APPROXIMATE.
VERIFY ALL UTILITIES PRIOR TO CONSTRUCTION.

Revisions:

1	8/24/2023	ADDENDUM #1
4	8/28/2023	ADDENDUM #4

LINE IS 1" ON FULL
SCALE DRAWING



WINDSOR ENGINEERS

Ridgefield, WA
Duluth + Minneapolis, MN
www.windsorengineers.com
Project No: 20198.3

Copyright 2023 By Windsor Engineers, LLC
All Rights Reserved.

**WATER RESILIENCY PROJECT
PHASE 1 - SEISMIC IMPROVEMENTS**
CITY OF CANNON BEACH, OR 97110

ENGINEERING PLAN
Issue Date: 8/28/2023

Project Manager TWT
Drawn by TJM
Checked by MRL

**EXISTING DETAILS -
SOUTH-TOLOVANA RESERVOIR**

C005


PLOT DATE: 8/28/2023 4:24 PM - FILE: C:\Users\MARCUSJ\OneDrive - Windsor Engineers\05 Projects\2020\20198.3 Cannon Beach Seismic Valves\02 Drawings\01 Working\04_Final Sheets\20198.3_exc.dwg

811

Know what's below.
Call before you dig.

CALL 2 BUSINESS DAYS BEFORE YOU DIG.
CAUTION UTILITY INFORMATION IS APPROXIMATE.
VERIFY ALL UTILITIES PRIOR TO CONSTRUCTION.

Revisions:




LINE IS 1" ON FULL SCALE DRAWING

1	8/24/2023	ADDENDUM #1
4	8/28/2023	ADDENDUM #4

WINDSOR ENGINEERS

Ridgefield, WA
Duluth + Minneapolis, MN
www.windsorengineers.com
Project No: 20198.3

Copyright 2023 By Windsor Engineers, LLC
All Rights Reserved.



REGISTERED PROFESSIONAL
ENGINEER
60239PE
OREGON
March 9, 1993
TRAVIS W. TORMANEN

EXPIRES: 06-30-24

WATER RESILIENCY PROJECT
PHASE 1 - SEISMIC IMPROVEMENTS
CITY OF CANNON BEACH, OR 97110

ENGINEERING PLAN
Issue Date: 8/28/2023

Project Manager TWT
Drawn by TJM
Checked by MRL

EXISTING CONDITIONS - ISOLATION VALVE 4

C006



ISOLATION VALVE 4 QUANTITIES		
ITEM	UNITS	QUANTITY
REMOVE PIPE	LF	0
REMOVE PIPE (ASBESTOS CONCRETE)	LF	40
GRAVEL SALVAGE AND REINSTALL	SY	35
TOPSOIL SALVAGE AND REINSTALL	SY	75
CLEARING AND GRUBBING (AS NEEDED)	SY	10

- 050 DEMOLITION
- 050

REMOVE PIPE AS NEEDED TO INSTALL NEW VAULTS, FITTINGS AND VALVES. SEE SITE PLANS AND DETAILS FOR PROPOSED EQUIPMENT.
- 051

SAWCUT FULL DEPTH AND REMOVE PAVING
- 052

POTHOLE TO LOCATE EXISTING PIPES PRIOR TO BEGINNING CONSTRUCTION- SHOWN LOCATIONS ARE BASED ON RECORD PLANS AND FIELD LOCATES
- 053

REMOVE EXISTING VAULT, VALVES, METERS, FITTINGS AND PIPE.
- 054

CLEARING AND GRUBBING AS NEEDED FOR NEW POWER
- 100 SITE PLAN NOTES
- 100

EXISTING CHAIN LINK FENCE
- 101

GRAVEL EDGE
- 102

SALVAGE TOPSOIL IN ALL AREAS OF EXCAVATION AND GRADING

- 300 STORMWATER
- 300

EXISTING 6" UNDERDRAIN
- 301

EXISTING STORM STRUCTURE
- 302

EXISTING DAYLIGHT PIPE - INLET = 187.5 OUTLET = 186.5
- 303

EXISTING CONCRETE PIPE
- 304

EXISTING HDPE PIPE

- 500 WATER
- 500

EXISTING WATER TRUNK LINE
- 501

EXISTING ALTITUDE CONTROL VALVE AND VAULT
- 502

EXISTING RESERVOIR TANK
- 503

EXISTING PUMP HOUSE
- 504

EXISTING FIRE HYDRANT
- 505

EXISTING DI OVERFLOW PIPE
- 506

EXISTING DI WATER PIPE
- 507

EXISTING PVC WATER LINE
- 508

EXISTING ASBESTOS CONCRETE WATER LINE
- 509

EXISTING VAULT
- 510

EXISTING ROOF HATCH
- 511

EXISTING ROOF VENT

- 600 DRY UTILITIES
- 600

EXISTING OVERHEAD POWER POLE
- 601

EXISTING OVERHEAD POWER
- 602

EXISTING CELLULAR CONTROL BOX
- 603

EXISTING UTILITY BOX
- 604

UNDERGROUND POWER AND COMMUNICATIONS TO US101

GENERAL SHEET NOTES:

1. ALL ASBESTOS CONCRETE PIPE REMOVED NEEDS TO BE REMOVED AND DISPOSED OF IN ACCORDANCE WITH OREGON DEQ RULES 340, DIVISION 248, AS WELL AS ANY LOCAL REQUIREMENTS INCLUDING OREGON OSHA AND CONSTRUCTION CONTRACTORS BOARD.

2. PLACE ISOLATION VALVE TO REDUCE IMPACT TO NEARBY TREES. PROTECT TREES TO THE MAXIMUM EXTENT POSSIBLE.

PLOT DATE: 8/28/2023 4:25 PM - FILE: C:\Users\MARCUSJ\OneDrive - Windsor Engineers\05 Projects\2020\20198.3 Cannon Beach Seismic Valves\02 Drawings\01 Working\04 Final Sheets\20198.3_site.dwg



Know what's **below.**
Call before you dig.

CALL 2 BUSINESS DAYS BEFORE YOU DIG.
CAUTION: UTILITY INFORMATION IS APPROXIMATE.
VERIFY ALL UTILITIES PRIOR TO CONSTRUCTION.

Revisions:



NO.	DATE	DESCRIPTION
1	8/24/2023	ADDENDUM #1
4	8/28/2023	ADDENDUM #4

LINE IS 1" ON FULL
SCALE DRAWING



WINDSOR ENGINEERS

Ridgefield, WA
Duluth + Minneapolis, MN
www.windsorengineers.com
Project No: 20198.3

Copyright 2023 By Windsor Engineers, LLC
All Rights Reserved.



WATER RESILIENCY PROJECT
PHASE 1 - SEISMIC IMPROVEMENTS
CITY OF CANNON BEACH, OR 97110


ENGINEERING PLAN

Issue Date: 8/28/2023

Project Manager: TWT
Drawn by: TJM
Checked by: MRL

SITE & EROSION CONTROL PLAN -
MAIN RESERVOIR

C100

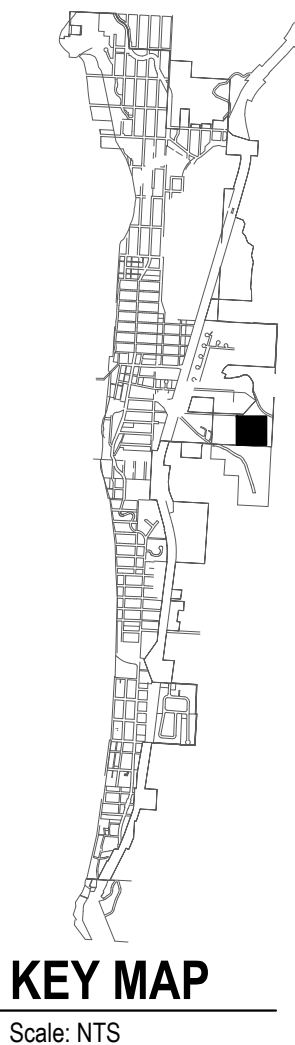

RESERVOIR IMPROVEMENTS:

- LOWER OPERATING LEVEL OF THE TANK
- REINFORCE WALLS BY ADDING FILL AROUND THE EAST AND SOUTH SIDES.

MAIN RESERVOIR QUANTITIES		
ITEM	UNITS	QUANTITY
TEMPORARY SIGNS	EA	1
GENERAL EXCAVATION	CY	120
EXTRA FOR SELECTED TOPSOIL MATERIAL	CY	10
SEDIMENT FENCE	LF	400
SEDIMENT BARRIER, TYPE 3	LF	50
SEEDING MOBILIZATION	LS	1
TEMPORARY SEEDING	AC	0.05
PERMANENT SEEDING	AC	0.05
MATting, TYPE A	SY	50
MULCHING, STRAW	AC	0.05
MULCHING, HYDROMULCH	SY	1000
CONNECTION TO EXISTING MAIN	EA	3
6" GATE VALVE	EA	1
8" GATE VALVE WITH ACTUATOR	EA	1
12" GATE VALVE WITH ACTUATOR	EA	1
HYDRANT ASSEMBLIES	EA	1
INSTALL CITY SUPPLIED VAULT	EA	1
VAULT FLOOR	EA	1
8 INCH HDPE PIPE	LF	20
12 INCH HDPE PIPE	LF	10
6 INCH DUCTILE IRON PIPE	LF	10
DI PIPE TEES, 8"x6"	EA	11
DI PIPE 45° BEND, 6"	EA	1
DI PIPE SLIP JOINT, 8"	EA	1
DI PIPE SLIP JOINT, 12"	EA	1
SPECIALS, UTILITIES ADJUSTMENT, LOWER OVERFLOW PIPE	EA	1

100 SITE PLAN NOTES

- 100 EXISTING CHAIN LINK FENCE
- 101 GRAVEL EDGE
- 102 SALVAGE TOPSOIL IN ALL AREAS OF EXCAVATION AND GRADING
- 103 SIDEWALK / SHOULDER CLOSED SIGNAGE
- 104 CONSTRUCTION FENCE
- 105 BARRELS
- 106 REPAIR TO MATCH ORIGINAL MATERIALS
- 107 SEED AND BLANKET SWALE BOTTOM AND SEED AND MULCH REMAINDER OF DISTURBED AREAS. USE OREGON COAST RANGE ECO-REGION SEED MIX
- 108 SALVAGE AND REINSTALL SIGN IF NEEDED
- 109 BUSINESS OREGON AND OTHER CONSTRUCTION RELATED SIGNS.

110 EROSION CONTROL / OVERALL GRADING

- 110 INSTALL SILT FENCE
- 111 INSTALL SEDIMENT BARRIER

300 STORMWATER


- 300 EXISTING 6" UNDERDRAIN
- 301 EXISTING STORM STRUCTURE
- 302 EXISTING DAYLIGHT PIPE - INLET = 187.5 OUTLET = 186.5
- 303 EXISTING CONCRETE PIPE
- 304 EXISTING HDPE PIPE

500 WATER

- 500 EXISTING WATER TRUNK LINE
- 501 EXISTING ALTITUDE CONTROL VALVE AND VAULT
- 502 EXISTING RESERVOIR TANK
- 503 EXISTING PUMP HOUSE
- 504 EXISTING FIRE HYDRANT
- 505 EXISTING DI OVERFLOW PIPE
- 506 EXISTING DI WATER PIPE
- 507 EXISTING PVC WATER LINE
- 508 EXISTING ASBESTOUS CONCRETE WATER LINE
- 509 EXISTING VAULT
- 510 EXISTING ROOF HATCH
- 511 EXISTING ROOF VENT
- 512 SEISMIC VALVE VAULT
- 513 SEISMIC VALVE CONTROL PANEL
- 514 FLEX-TEND WITH 12" EXTEND ABILITY
- 515 FLEX-TEND WITH 4" EXTEND ABILITY
- 516 WATER SERVICE AND GATE VALVE
- 517 MANHOLE, ISOLATION VALVE AND VALVE CONTROLS PLACE MANHOLE CASTING OUTSIDE OF TRAVEL LANES
- 518 WATERLINE. CONNECT TO EXISTING
- 519 FUTURE RESERVOIR
- 520 WATER PIPE
- 521 BLOW OFF HYDRANT
- 522 FIRE HYDRANT - WATER FILL STATION

600 DRY UTILITIES


- 600 EXISTING OVERHEAD POWER POLE
- 601 EXISTING OVERHEAD POWER
- 602 EXISTING CELLULAR CONTROL BOX
- 603 EXISTING UTILITY BOX
- 604 UNDERGROUND POWER AND COMMUNICATIONS TO US101

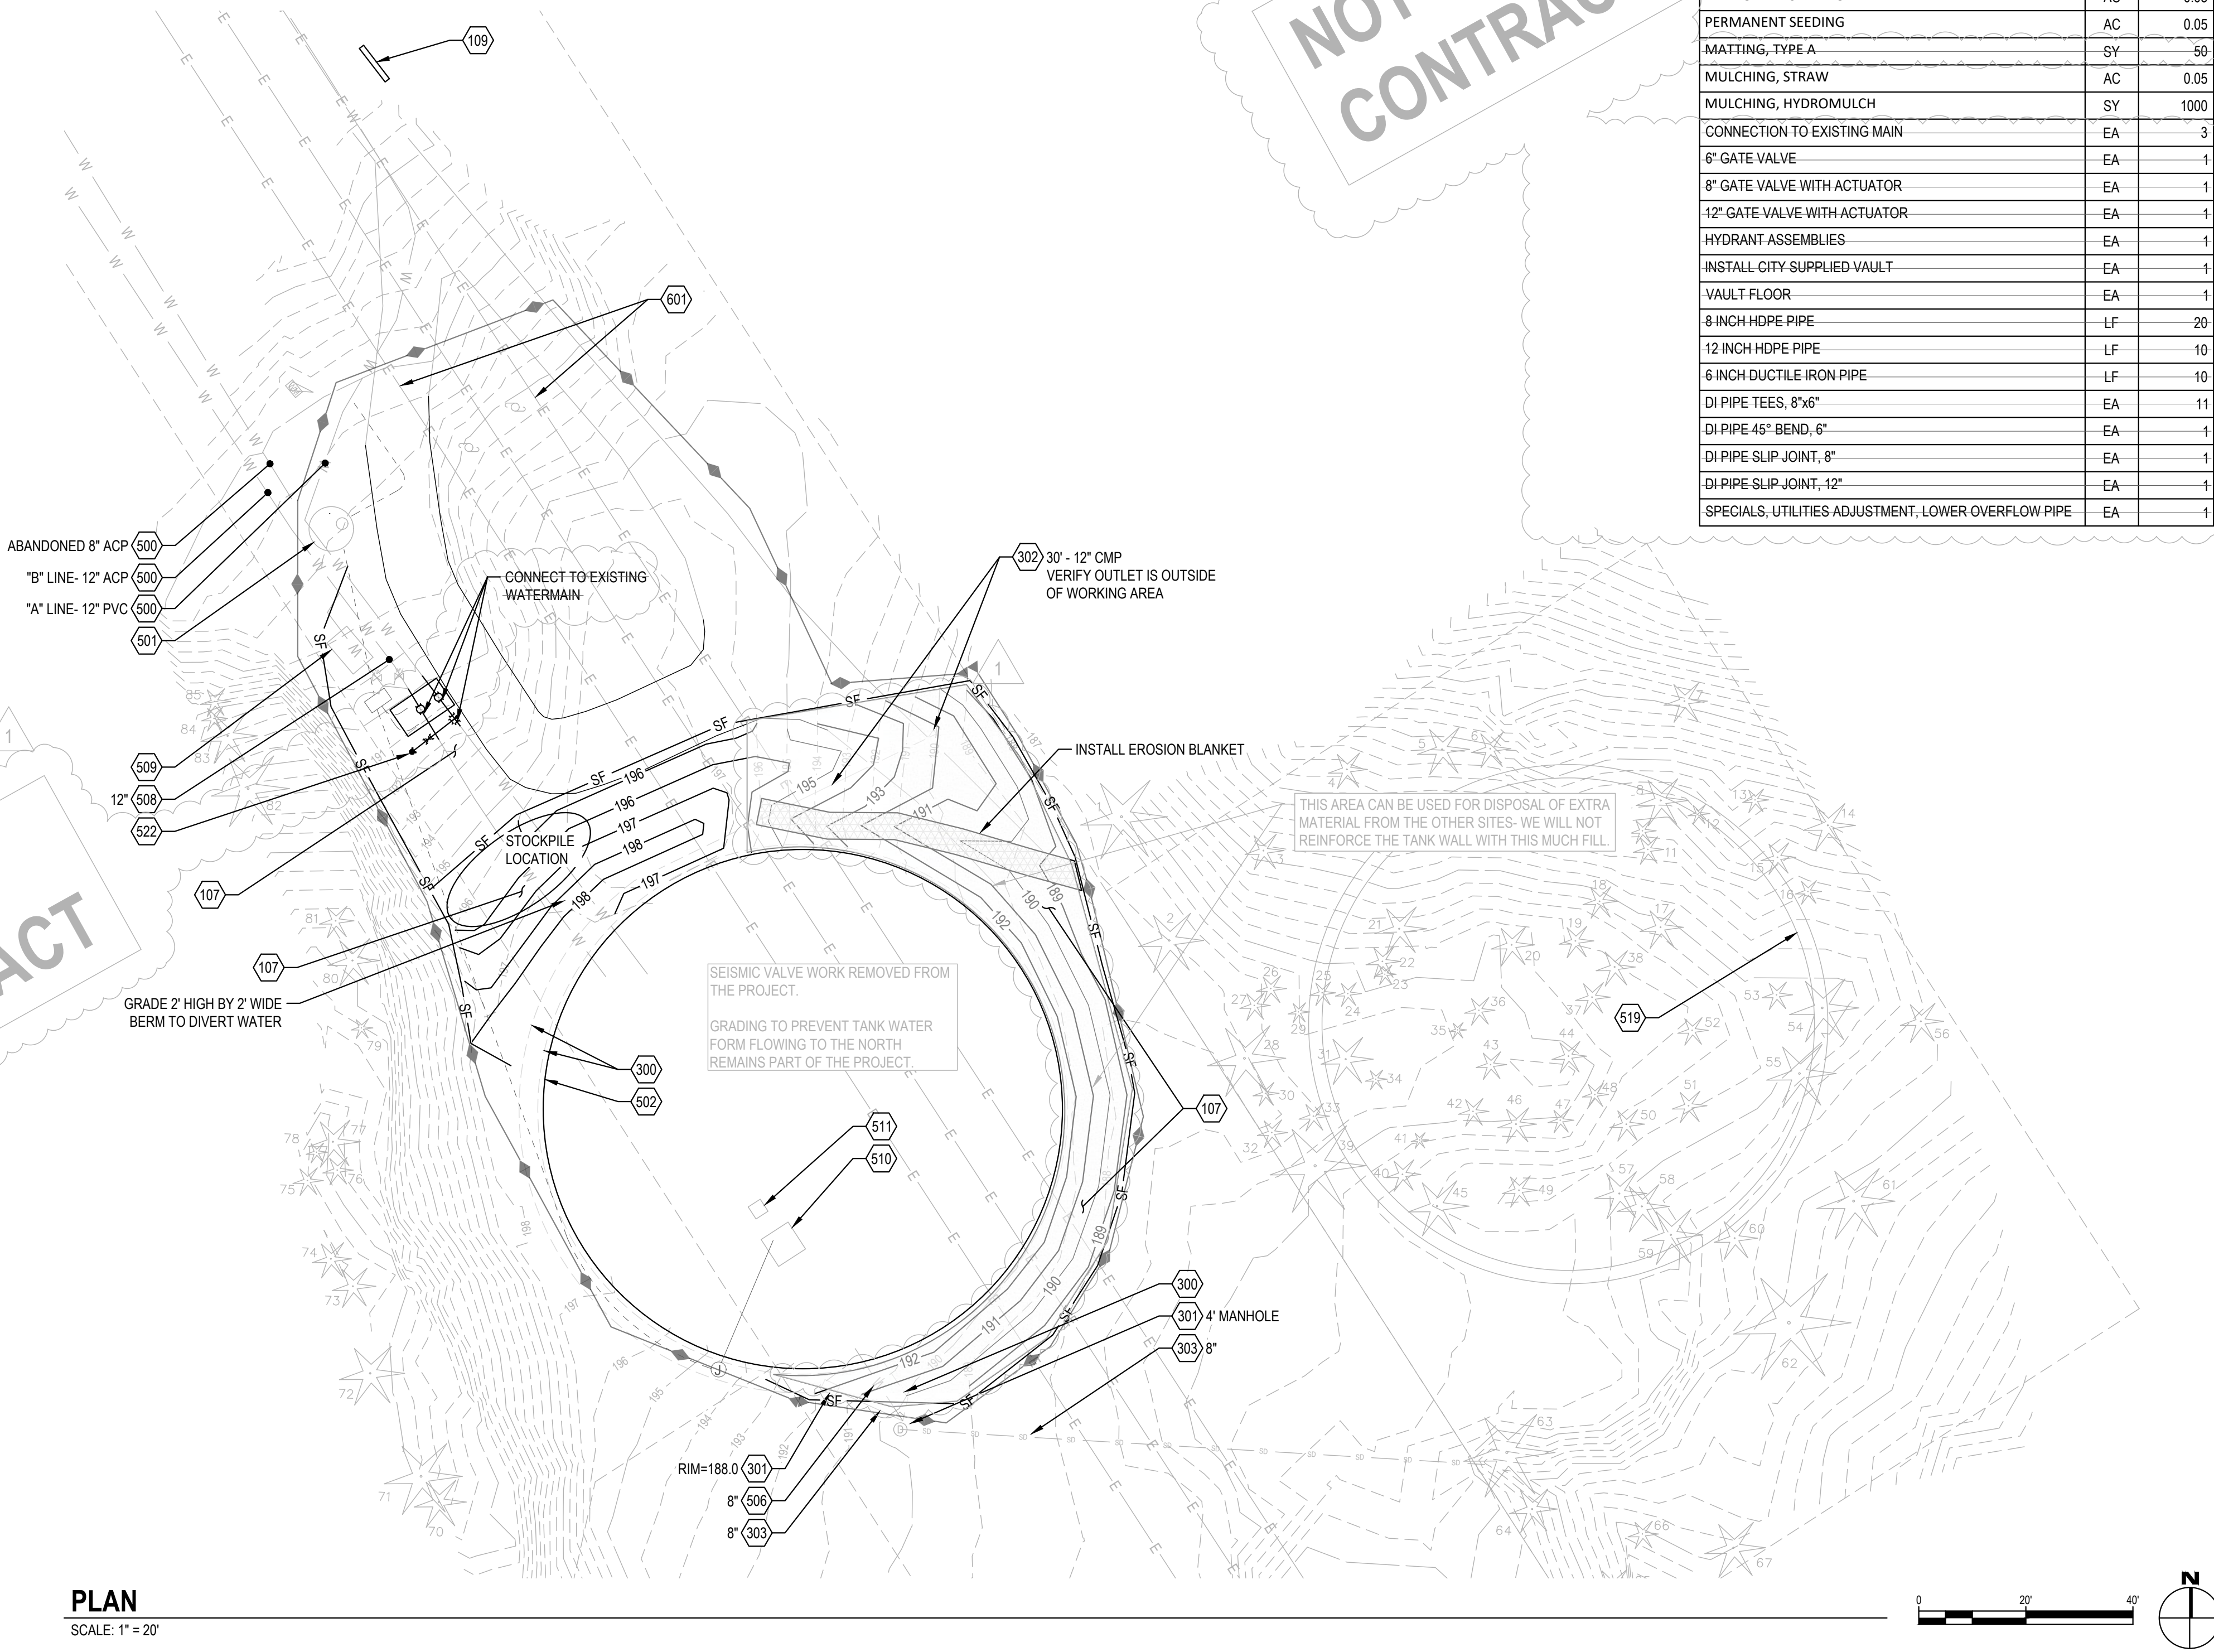


PLAN

SCALE: 1" = 20'




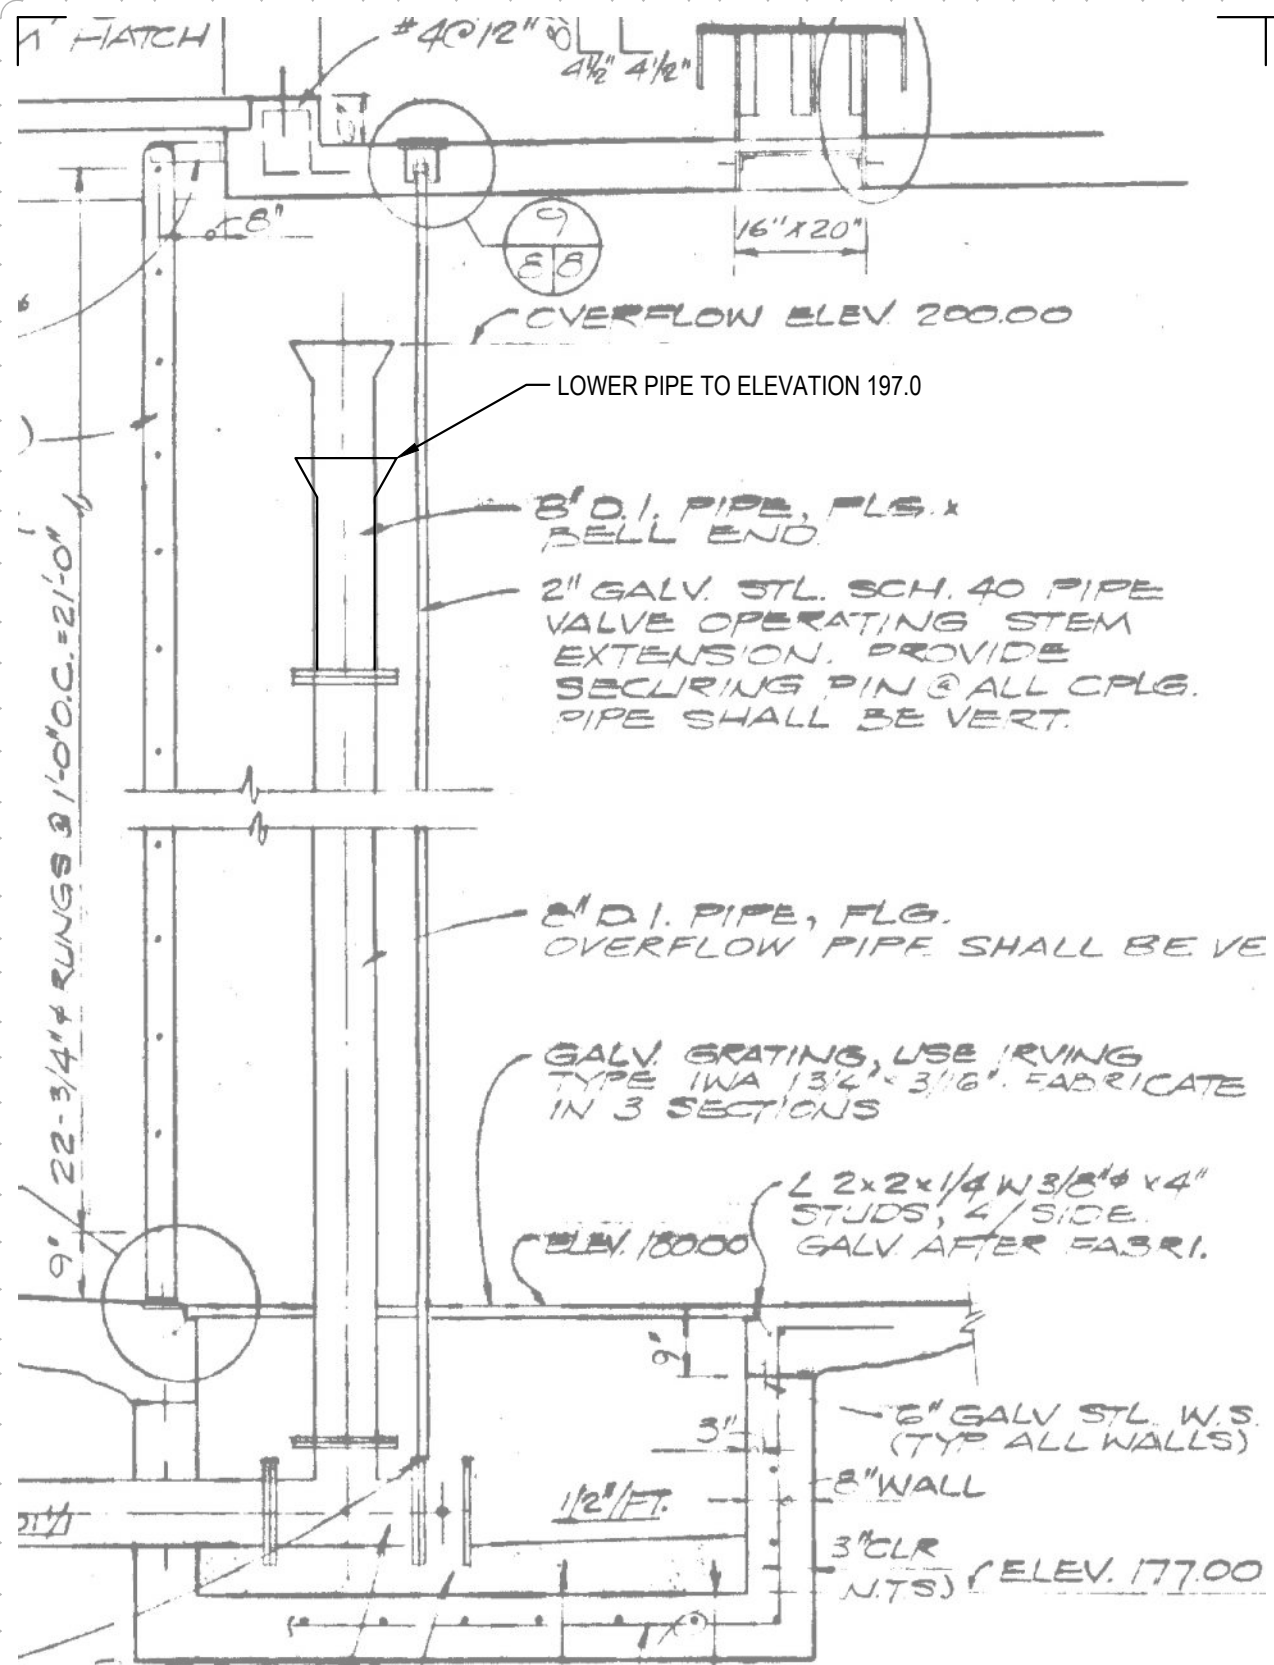

1 LOWERING RISER PIPE DETAIL
SCALE: 1/2" = 1'

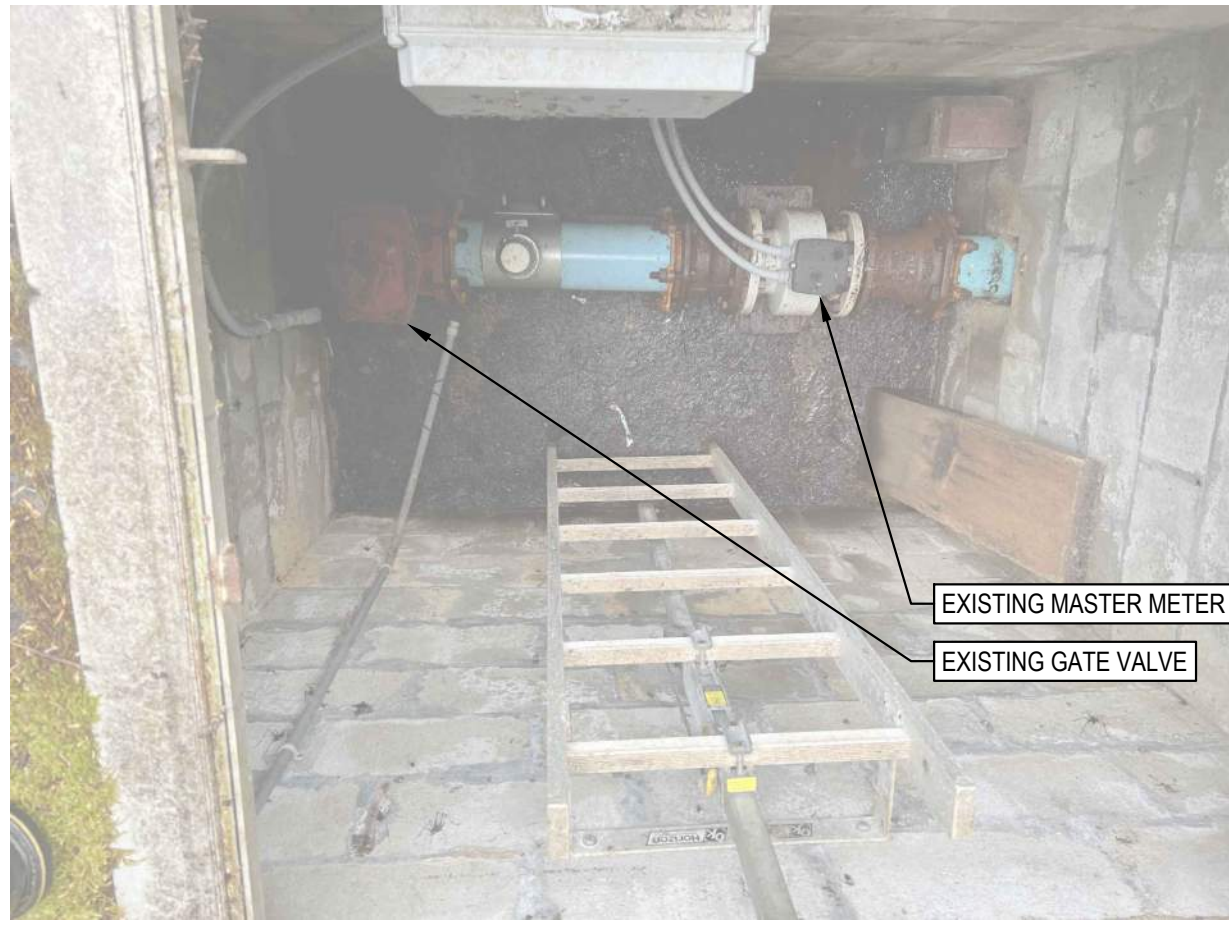

2 PHOTO - EXISTING
SCALE: NTS

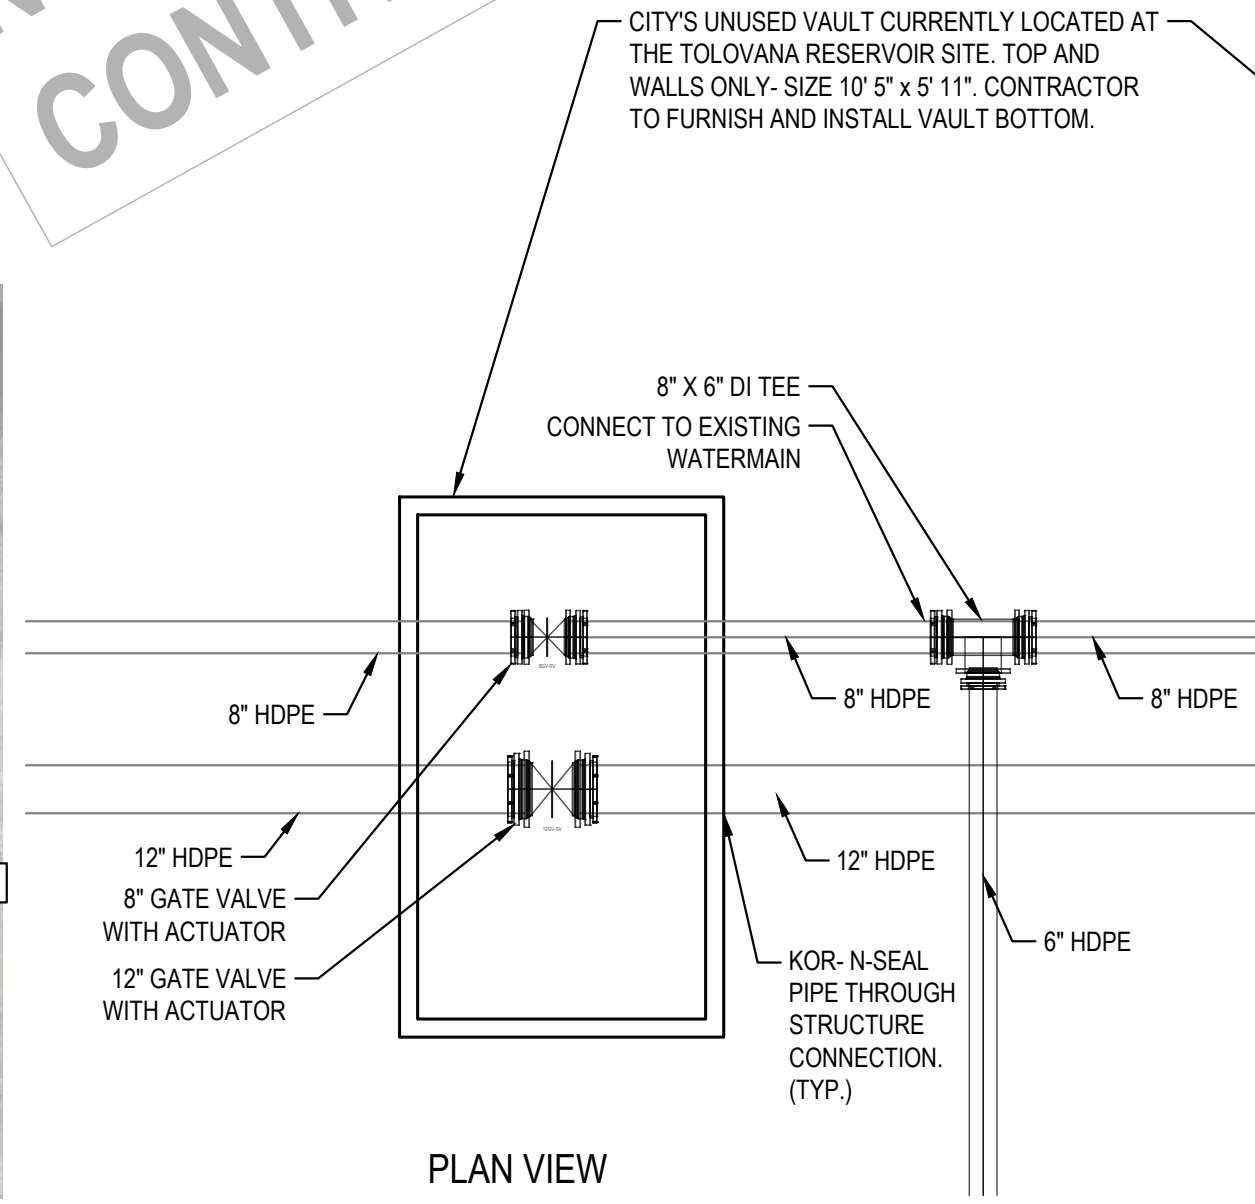

3 VAULT DETAIL
SCALE: NTS




4 EXISTING VAULT PHOTO
SCALE: NTS



Know what's below.
Call before you dig.

CALL 2 BUSINESS DAYS BEFORE YOU DIG.
CAUTION UTILITY INFORMATION IS APPROXIMATE.
VERIFY ALL UTILITIES PRIOR TO CONSTRUCTION.

Revisions:

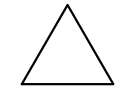

1	8/24/2023	ADDENDUM #1
4	8/28/2023	ADDENDUM #4


LINE IS 1" ON FULL
SCALE DRAWING



WINDSOR ENGINEERS

Ridgefield, WA
Duluth + Minneapolis, MN
www.windsorengineers.com
Project No: 20198.3

Copyright 2023 By Windsor Engineers, LLC
All Rights Reserved.

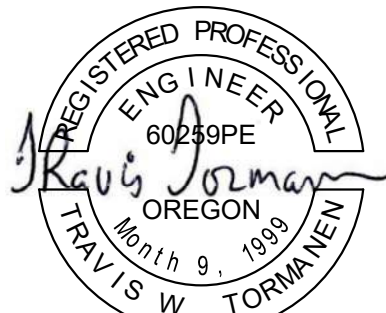

EXPIRES: 06-30-24

WATER RESILIENCY PROJECT
PHASE 1 - SEISMIC IMPROVEMENTS
CITY OF CANNON BEACH, OR 97110

ENGINEERING PLAN

Issue Date: 8/28/2023

Project Manager TWT
Drawn by TJM
Checked by MRL

VAULT AND VALVE DETAILS -
MAIN RESERVOIR

C101

PLOT DATE: 02/20/2023 5:30 PM - FILE: C:\Users\MARCUSJ\OneDrive - Windsor Engineers\05 Projects\2020\20198.3 Cannon Beach Seismic Valves\02 Drawings\04 Working\04_Final Sheets\20198.3_site.dwg



Know what's **below.**
Call before you dig.

CALL 2 BUSINESS DAYS BEFORE YOU DIG.
CAUTION: UTILITY INFORMATION IS APPROXIMATE.
VERIFY ALL UTILITIES PRIOR TO CONSTRUCTION.

Revisions:



1	8/24/2023	ADDENDUM #1
4	8/28/2023	ADDENDUM #4


LINE IS 1" ON FULL
SCALE DRAWING



WINDSOR ENGINEERS

Ridgefield, WA
Duluth + Minneapolis, MN
www.windsorengineers.com
Project No: 20198.3

Copyright 2023 By Windsor Engineers, LLC
All Rights Reserved.

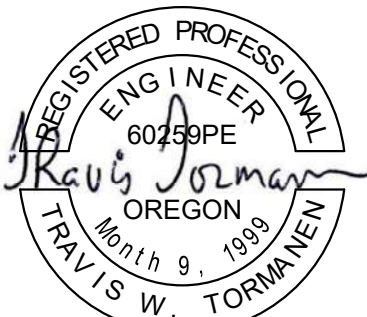

EXPIRES: 06-30-24

WATER RESILIENCY PROJECT
PHASE 1 - SEISMIC IMPROVEMENTS
CITY OF CANNON BEACH, OR 97110


ENGINEERING PLAN

Issue Date: 8/28/2023

Project Manager: TWT
Drawn by: TJM
Checked by: MRL

SITE & EROSION CONTROL PLAN -
NORTH RESERVOIR

C102

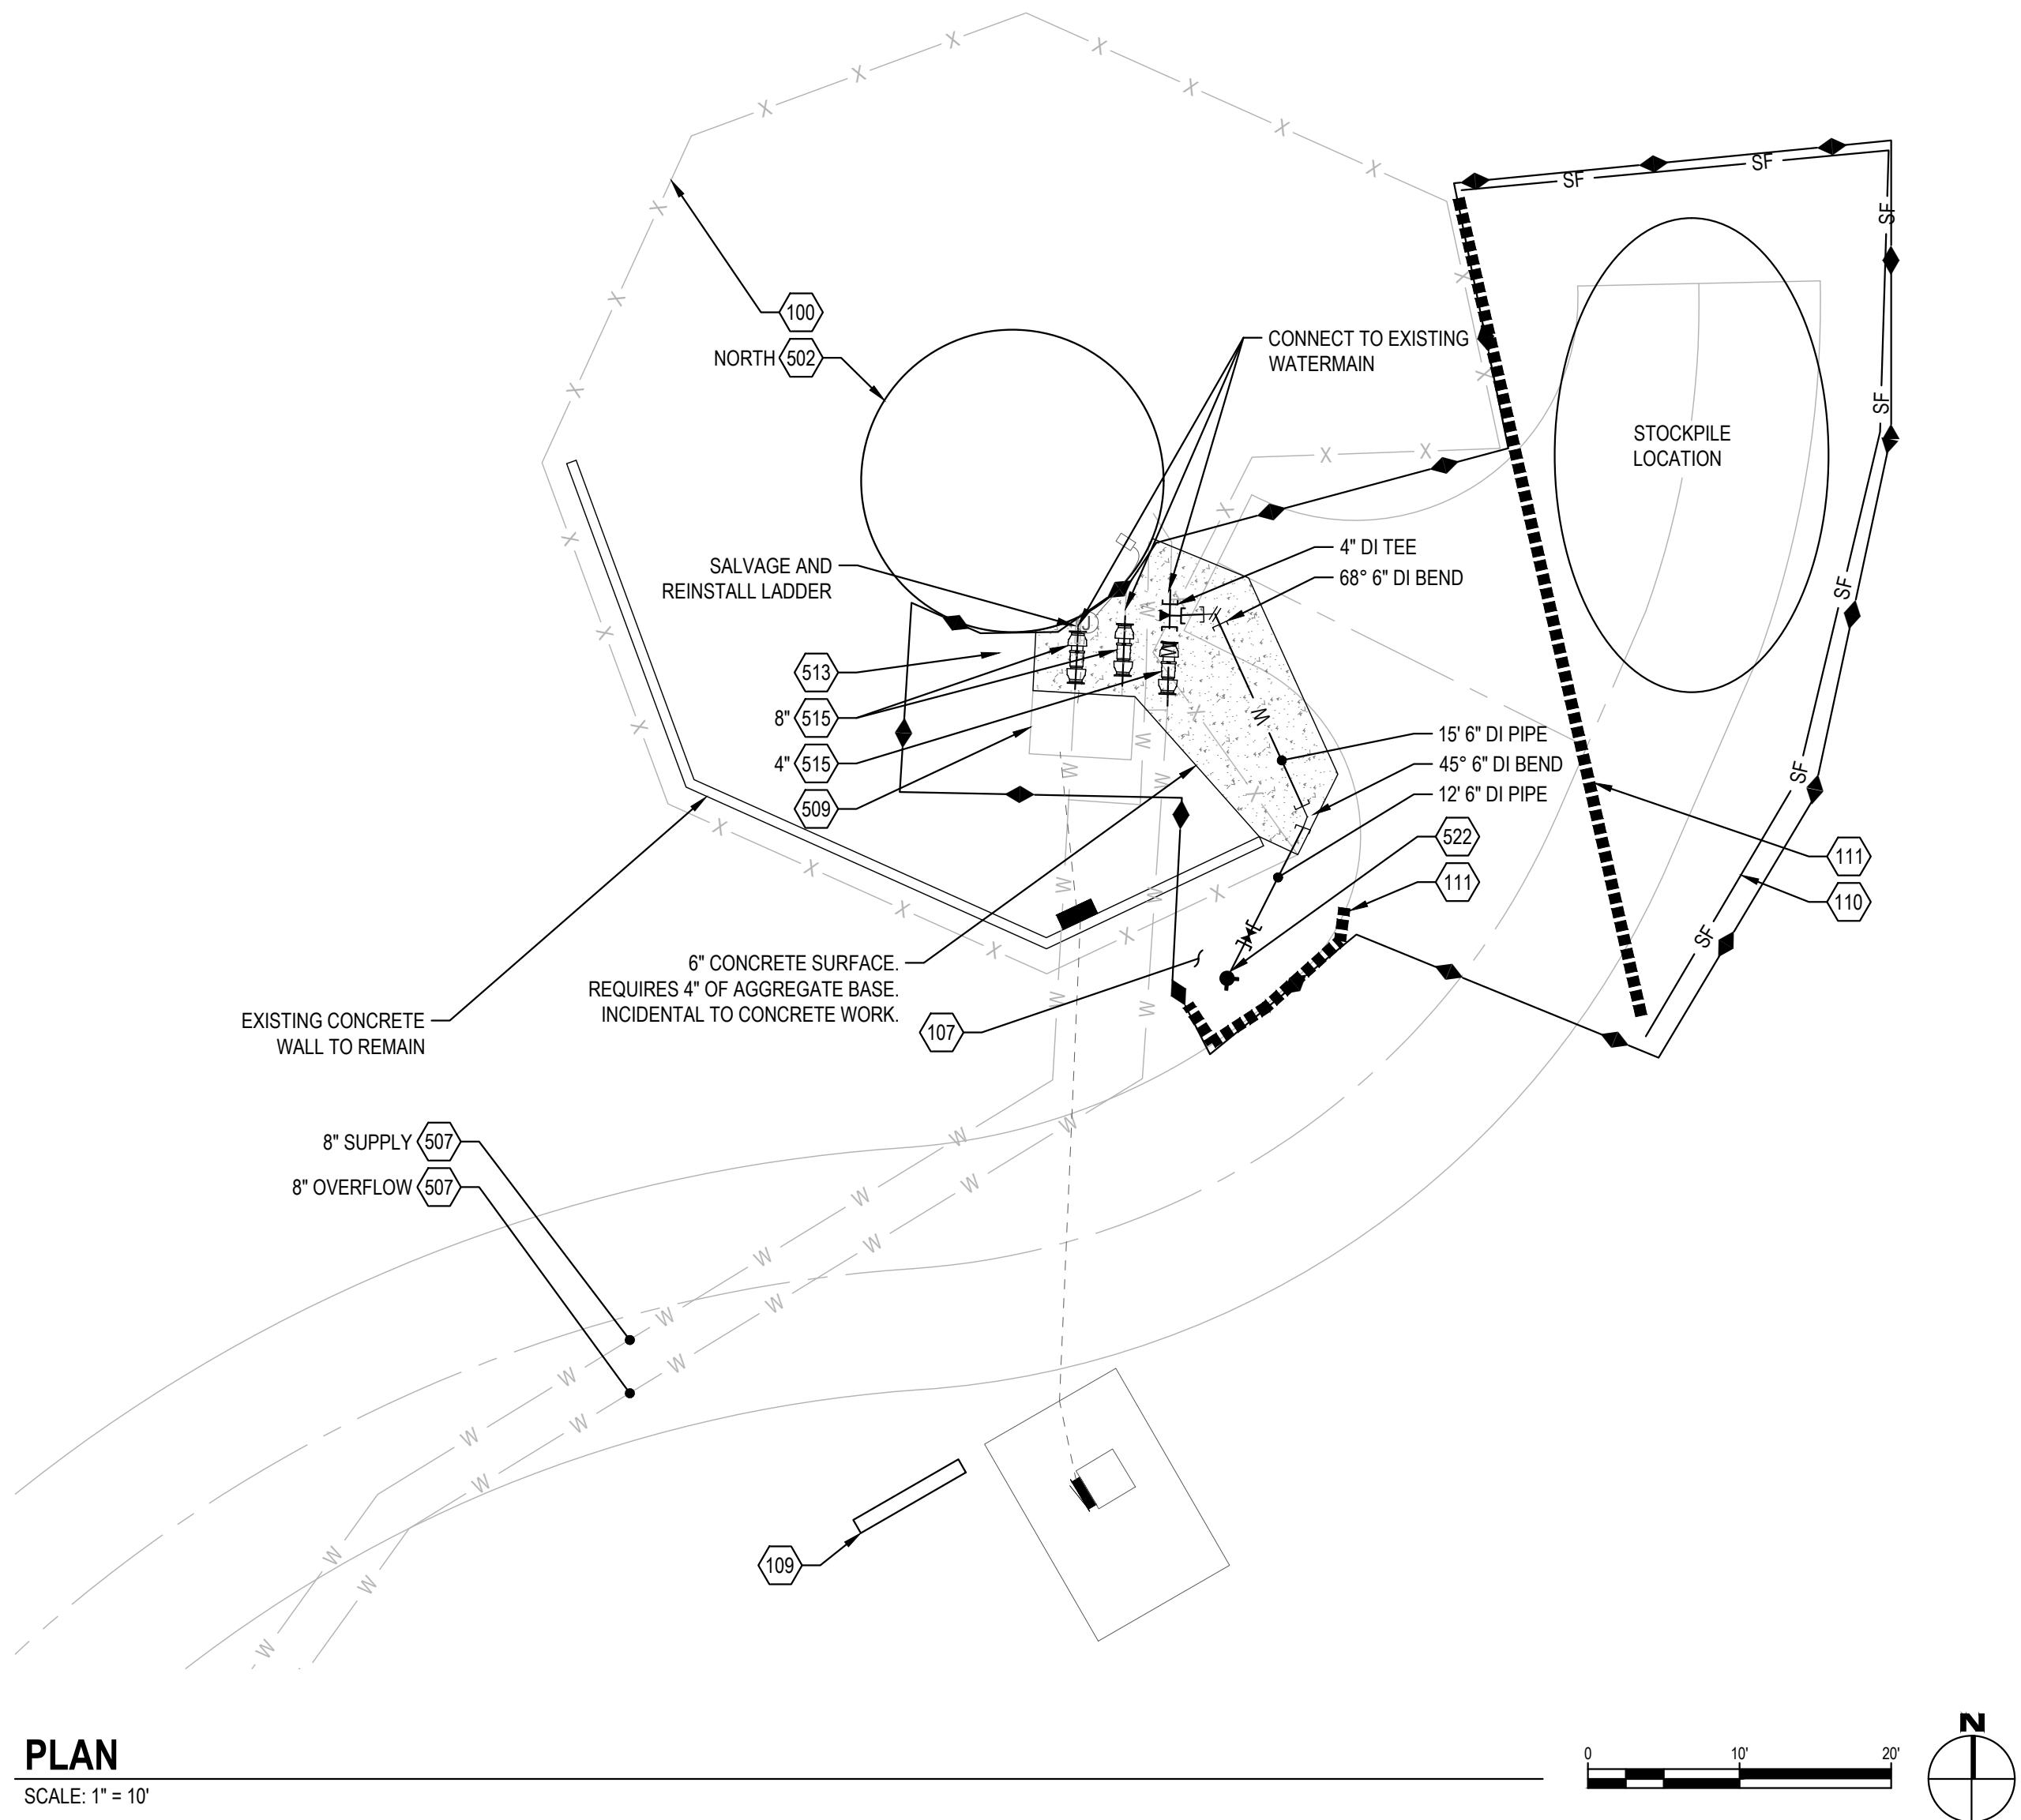

GENERAL SHEET NOTES:

1. CITY, CONTRACTOR, AND ENGINEER TO HAVE A MEETING TO DISCUSS COORDINATION, RESPONSIBILITIES, AND LIMITATIONS RELATED TO WATER SHUTDOWNS.

4

NORTH RESERVOIR SHUT DOWN NOTES:

1. PROVIDE THE CITY ONE WEEK NOTICE BEFORE REQUIRING WATER SHUT DOWN TO PERFORM WORK.
2. CITY WILL BE ABLE TO DRAIN THE NORTH RESERVOIR PRIOR TO CONNECTION WORK.
3. CONTRACTOR SHALL MINIMIZE THE SHUTDOWN TO NO MORE THEN 8-HOUR WINDOW. THE SHUTDOWN WINDOW WILL NEED TO BE OVERNIGHT DURING A WEEKDAY.
4. THE CITY WILL REFILL THE TANK UPON COMPLETION OF THE WORK PERFORMED DURING THE SHUTDOWN PERIOD.

NORTH RESERVOIR QUANTITIES

ITEM	UNITS	QUANTITY
TEMPORARY SINGS	EA	1
EXTRA FOR SELECTED TOPSOIL MATERIAL (IF NEEDED)	CY	5
SEDIMENT FENCE	LA	100
SEDIMENT BARRIER, TYPE 3	LA	100
SEEDING MOBILIZATION	LS	1
TEMPORARY SEEDING	AC	0.01
PERMANENT SEEDING	AC	0.01
MULCHING, STRAW	AC	0.01
MULCHING, HYDROMULCH	SY	40
SALVAGE & REINSTALL LADDER	EA	1
AGGREGATE BASE	TN	10
6 INCH CONCRETE SURFACING	SY	400
CONNECTION TO EXISTING MAIN	EA	3
6" GATE VALVE	EA	1
4" GATE VALVE WITH ACTUATOR	EA	1
8" GATE VALVE WITH ACTUATOR	EA	2
4" FLEXTEND	EA	1
8" FLEXTEND	EA	2
HYDRANT ASSEMBLIES	EA	1
6 INCH DUCTILE IRON PIPE	LF	30
8 INCH DUCTILE IRON PIPE	LF	10
DI PIPE TEES, 4"x4"	EA	1
DI PIPE REDUCER, 6" TO 4"	EA	1

100 SITE PLAN NOTES

- 100 EXISTING CHAIN LINK FENCE
- 101 GRAVEL EDGE
- 102 SALVAGE TOPSOIL IN ALL AREAS OF EXCAVATION AND GRADING
- 103 SIDEWALK / SHOULDER CLOSED SIGNAGE
- 104 CONSTRUCTION FENCE
- 105 BARRELS
- 106 REPAIR TO MATCH ORIGINAL MATERIALS
- 107 SEED AND BLANKET SWALE BOTTOM AND SEED AND MULCH REMAINDER OF DISTURBED AREAS.
USE OREGON COAST RANGE ECO-REGION SEED MIX
- 108 SALVAGE AND REINSTALL SIGN IF NEEDED
- 109 BUSINESS OREGON AND OTHER CONSTRUCTION RELATED SIGNS.

110 EROSION CONTROL / OVERALL GRADING

- 110 INSTALL SILT FENCE
- 111 INSTALL SEDIMENT BARRIER

300 STORMWATER


- 300 EXISTING 6" UNDERDRAIN
- 301 EXISTING STORM STRUCTURE
- 302 EXISTING DAYLIGHT PIPE - INLET = 187.5 OUTLET = 186.5
- 303 EXISTING CONCRETE PIPE
- 304 EXISTING HDPE PIPE

500 WATER

- 500 EXISTING WATER TRUNK LINE
- 501 EXISTING ALTITUDE CONTROL VALVE AND VAULT
- 502 EXISTING RESERVOIR TANK
- 503 EXISTING PUMP HOUSE
- 504 EXISTING FIRE HYDRANT
- 505 EXISTING DI OVERFLOW PIPE
- 506 EXISTING DI WATER PIPE
- 507 EXISTING PVC WATER LINE
- 508 EXISTING ASBESTOUS CONCRETE WATER LINE
- 509 EXISTING VAULT
- 510 EXISTING ROOF HATCH
- 511 EXISTING ROOF VENT
- 512 SEISMIC VALVE VAULT
- 513 SEISMIC VALVE CONTROL PANEL
- 514 FLEX-TEND WITH 12" EXTEND ABILITY
- 515 FLEX-TEND WITH 4" EXTEND ABILITY
- 516 WATER SERVICE AND GATE VALVE
- 517 MANHOLE, ISOLATION VALVE AND VALVE CONTROLS
PLACE MANHOLE CASTING OUTSIDE OF TRAVEL LANES
- 518 WATERLINE. CONNECT TO EXISTING
- 519 FUTURE RESERVOIR
- 520 WATER PIPE
- 521 BLOW OFF HYDRANT
- 522 FIRE HYDRANT - WATER FILL STATION

600 DRY UTILITIES

- 600 EXISTING OVERHEAD POWER POLE
- 601 EXISTING OVERHEAD POWER
- 602 EXISTING CELLULAR CONTROL BOX
- 603 EXISTING UTILITY BOX
- 604 UNDERGROUND POWER AND COMMUNICATIONS TO US101

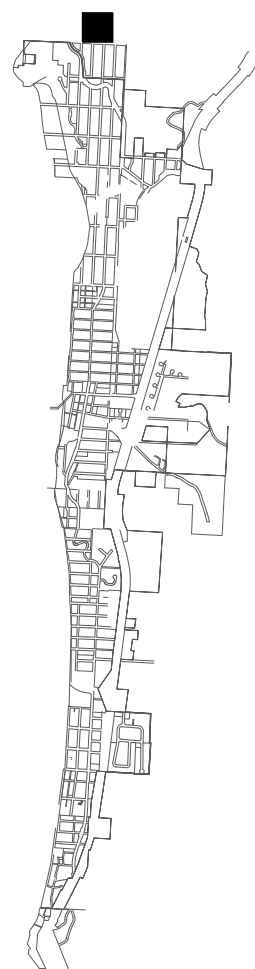

KEY MAP

Scale: NTS





FLEX-TEND Double Ball Submittal Reference Drawing - M.J. by M.J.

<div><div><div>Total Length</div><div>Laying Length</div><div>A</div><div>Deflection in degrees per ball</div><div>The expansion values listed represent the total movement for the particular size and configuration. Unless otherwise specified, FLEX-TEND assemblies are pre-set at factory to reserve 50% of total movement for expansion and 50% for contraction. FLEX-TEND and CL lengths reflect the standard 50% / 50% pre-set condition. Modifying the pre-set ratio requires a corresponding modification of these lengths.</div></div><div><div>Ball Joint</div><div>Expansion Contraction Joint</div><div>Ball Joint</div><div>CL</div><div>S</div><div>Weight</div><div>Assembly</div></div></div>											
Nominal Pipe Size	OD	Deflection† (Degrees)	A	Expansion†	Total Length	Laying Length	CL	S (Offset)	Weight (lbs)	Assembly	Number
3	9.20	20	3.88	4	35.80 (±2.0)	30.80 (±2.0)	21.30 (±2.0)	7.75	176	403M20	
				8	51.00 (±4.0)	46.00 (±4.0)	36.50 (±4.0)	13.28	221	403M21	
				12	66.30 (±6.0)	61.30 (±6.0)	51.75 (±6.0)	18.84	265	403M22	
4	10.85	20	3.99	4	34.99 (±2.0)	29.99 (±2.0)	22.81 (±2.0)	8.49	152	404M20	
				8	50.24 (±4.0)	45.24 (±4.0)	38.06 (±4.0)	14.39	203	404M21	
				12	65.49 (±6.0)	60.49 (±6.0)	53.31 (±6.0)	20.29	248	404M22	
6	12.28	20	4.20	4	37.11 (±2.0)	32.11 (±2.0)	23.70 (±2.0)	8.79	213	406M20	
				8	51.39 (±4.0)	46.39 (±4.0)	37.98 (±4.0)	14.36	274	406M21	
				12	65.67 (±6.0)	60.67 (±6.0)	52.26 (±6.0)	19.93	335	406M22	
8	14.82	20	4.91	4	41.41 (±2.0)	36.41 (±2.0)	26.59 (±2.0)	9.78	311	408M20	
				8	58.51 (±4.0)	53.51 (±4.0)	43.69 (±4.0)	16.31	404	408M21	
				12	75.61 (±6.0)	70.61 (±6.0)	60.79 (±6.0)	22.84	497	408M22	
10	18.03	20	6.18	4	45.74 (±2.0)	40.74 (±2.0)	28.58 (±2.0)	10.39	475	410M20	
				8	61.54 (±4.0)	56.54 (±4.0)	44.18 (±4.0)	16.48	612	410M21	
				12	77.34 (±6.0)	72.34 (±6.0)	59.98 (±6.0)	22.57	750	410M22	
12	20.69	20	6.84	4	48.91 (±2.0)	43.91 (±2.0)	30.24 (±2.0)	11.03	587	412M20	
				8	64.86 (±4.0)	59.86 (±4.0)	46.19 (±4.0)	17.17	735	412M21	
				12	80.81 (±6.0)	75.81 (±6.0)	62.14 (±6.0)	23.31	882	412M22	
14	25.00	15	7.00	8	65.10 (±4.0)	58.10 (±4.0)	44.00 (±4.0)	11.79	1222	414M20	
				16	91.50 (±8.0)	84.50 (±8.0)	70.50 (±8.0)	18.89	1510	414M21	
				24	117.90 (±12)	110.90 (±12)	96.90 (±12)	25.96	1798	414M22	
16	25.00	15	10.30	8	74.00 (±4.0)	67.00 (±4.0)	46.30 (±4.0)	12.41	1133	416M20	
				16	101.50 (±8.0)	94.50 (±8.0)	74.20 (±8.0)	19.88	1465	416M21	
				24	129.50 (±12)	122.50 (±12)	102.10 (±12)	27.36	1797	416M22	
18	30.50	15	12.60	8	71.90 (±4.0)	65.30 (±4.0)	47.10 (±4.0)	12.62	1760	418M20	
				16	99.20 (±8.0)	92.10 (±8.0)	74.10 (±8.0)	19.86	2153	418M21	
				24	126.20 (±12)	119.20 (±12)	101.10 (±12)	27.09	2546	418M22	
20	30.50	15	10.40	8	73.50 (±4.0)	66.50 (±4.0)	45.90 (±4.0)	12.30	1874	420M20	
				16	101.00 (±8.0)	94.00 (±8.0)	73.20 (±8.0)	19.61	2298	420M21	
				24	128.00 (±12)	121.00 (±12)	100.40 (±12)	26.90	2721	420M22	
24	37.30	15	13.80	8	87.00 (±4.0)	80.00 (±4.0)	52.20 (±4.0)	13.99	3183	424M20	
				16	114.00 (±8.0)	107.00 (±8.0)	79.50 (±8.0)	21.30	3902	424M21	
				24	141.50 (±12)	134.00 (±12)	106.80 (±12)	28.62	4555	424M22	
30	44.00	15	12.03	8	98.20 (±5)	90.20 (±5)	65.30 (±5)	17.50	4985	430M20	
				16	132.50 (±10)	124.50 (±10)	99.00 (±10)	26.53	5976	430M21	
				24	166.80 (±15)	158.80 (±15)	132.00 (±15)	35.37	6856	430M22	

All dimensions are ± 1%
NOTE: All dimensions listed in brochure and in inches and subject to change without notice.

THE 8-INCH GATE VALVES (SERIES 2500 NRS RESILIENT WEDGE GATE VALVE BY AMERICAN FLOW CONTROL OR APPROVED EQUAL) WOULD BE SIZED WITH ROTORK IQD10 MK3 INTELLIGENT ACTUATORS, 48 RPM OUTPUT SPEED WITH IB4 GEARBOX, 4:1 RATIO, 3.4 MA, 160 SECOND STROKE TIME. SEE ATTACHED DATA SHEET. THIS SIZING IS BASED AROUND AN 8-IN. MUELLER CLASS 150# GATE VALVE.

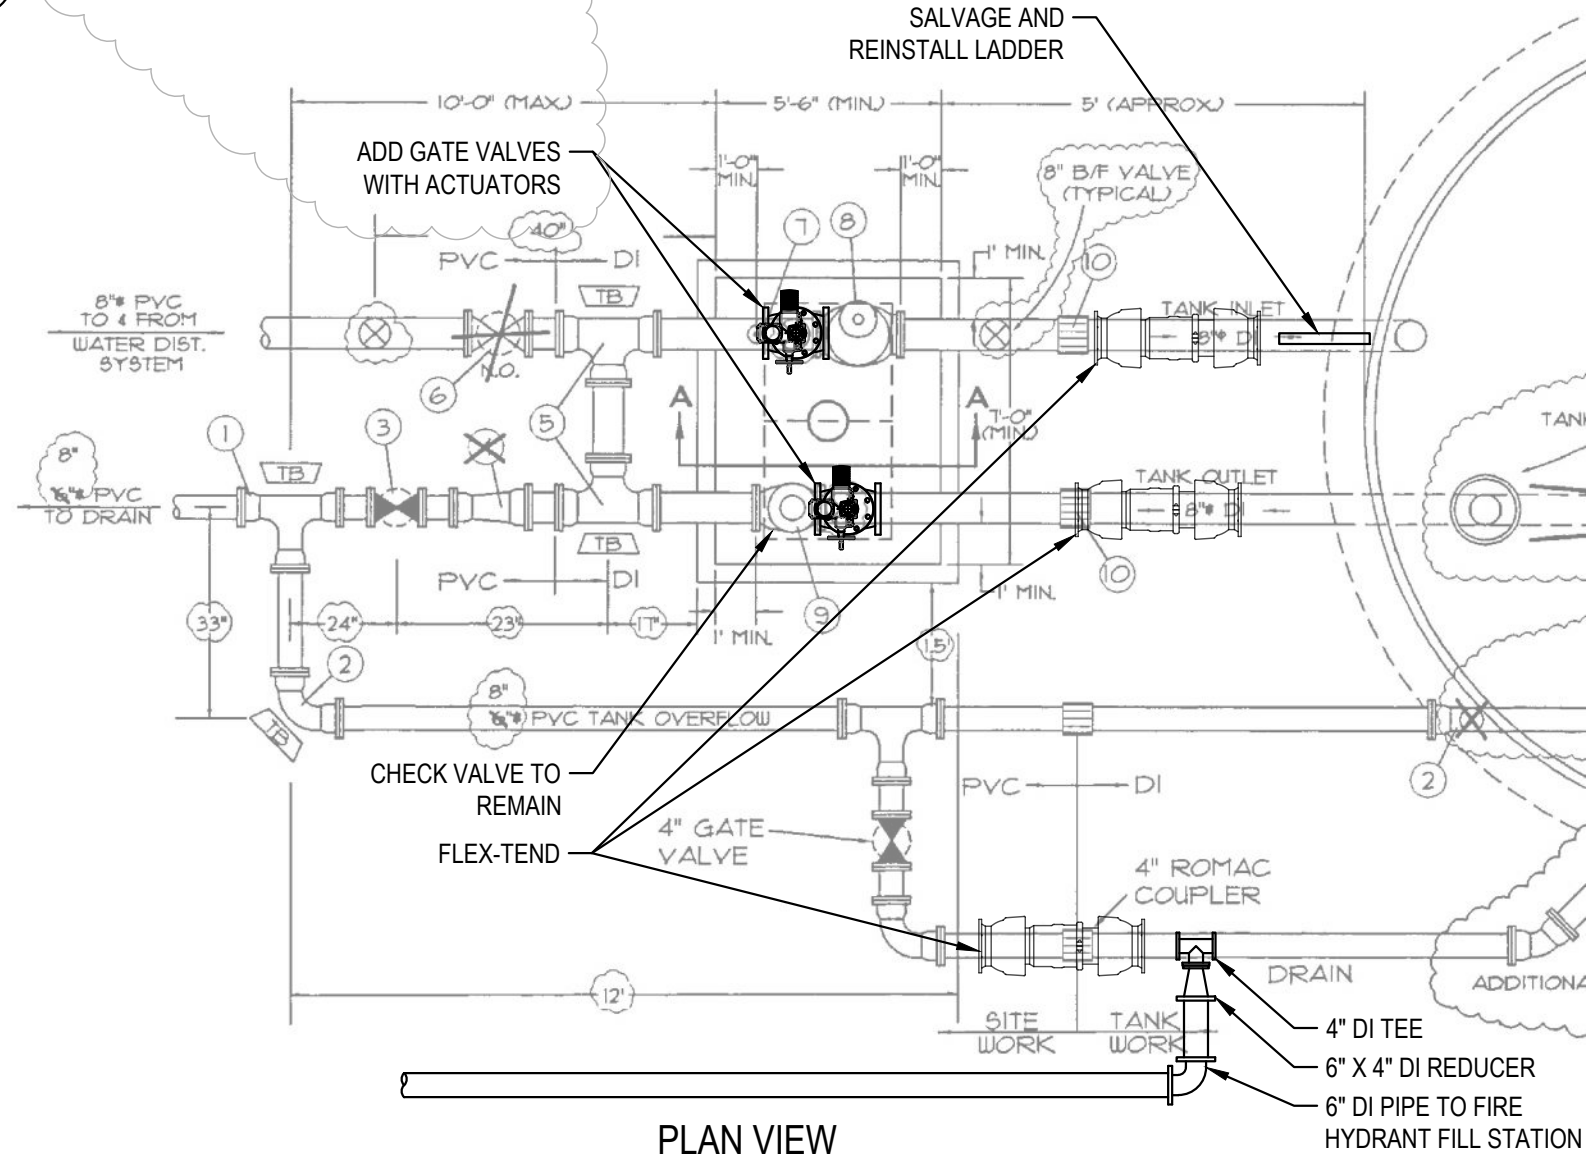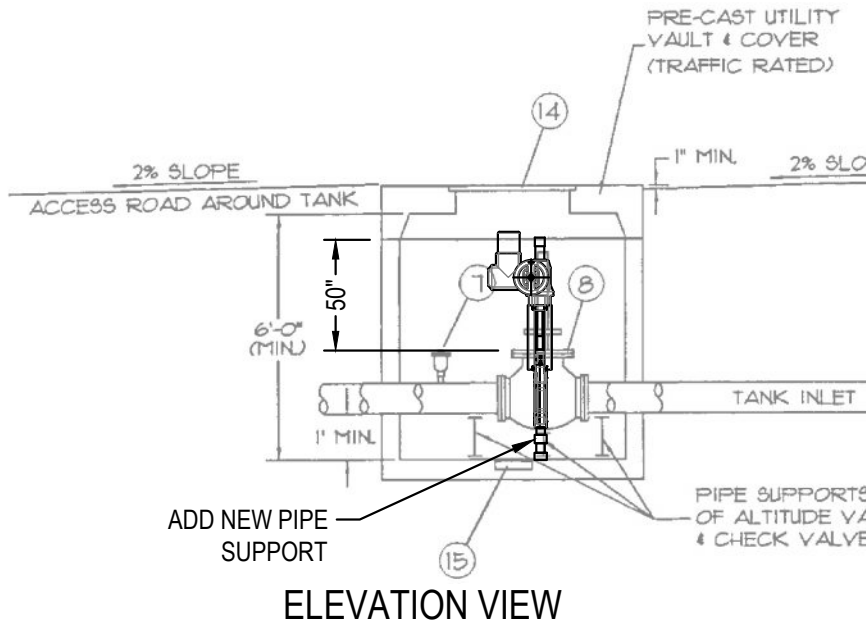

1 PHOTO- EXISTING

SCALE: NTS

2 FLEX-TEND DETAIL

SCALE: NTS

4 OR APPROVED EQUAL

3 VAULT DETAIL

SCALE: NTS

rotork®

Rotork.com | My Account | Logout |

Sizing Guide Search

Seating Torque

62.37 Nm 46 lbf-ft

Seating Thrust

6 kN 136 lbf

Coupling Type

Standard

Coupling Dimension

mm

Number of Turns

32 Turns

Stroke Time

0 Secs

Stroke Time Tolerance

50 % ± 50 %

Power Supply

DC 24V

Options

☐ Hazardous Area

☒ Watertight

☐ Fail-safe

☐ Low Cycle

Output Flange

Any

Range

☒ DEFAULT ☒ IQD3

☒ IQ3 ☒ IQS3

Reset

Search

Output Performance

Combination	Rated Torque Nm lbf-ft	Rated Thrust kN lbf	Resultant Thrust kN lbf	Stroke Time Secs (60 Hz)
IQD10/IB4	52 88	53.00 12000	0.00 0	160.0
Available Output Flanges (800±10" & 1500±10" (4" & 6"))				
F10FA10		Hazardous Yes	Watertight Yes	Fail Safe No

Couplings

Coupling name	Coupling Type	Standard Dimension mm in	Max Dimension mm in	Min Dimension mm in
IB IS HOB	Thrust Base - Threaded	45 1.75	45 1.75	0 0.00

Actuator Performance

Size	Rated Torque Nm lbf-ft	Output RPM RPM (60 Hz)	Rating Starts / Hour	Weight Kg Lbs
IQD10	27 20	48.00	60	80
1-Phase AC 3-Phase AC				
No	No	DC DC 24V DC 48V DC 110V	Hazardous Yes	Watertight Yes

Handwheel	Type	Ratio (1:1)	Turns (per stroke)	Reinforced N Lbs
Standard	Direct	1.0	128	122 28
Option 1	Geared	5.0	640	87 20


Gearbox Performance					
Size	Rated Torque Nm lbf-ft	Ratio (1:1)	MA	Weight Kg Lbs	
IB4	678 500	4	3.4	15.89 35	

Enter your specific requirements and click 'Add to enquiry'

* Fields marked with an * are required.

Go Back

SERIES 2500 - OS & Y DIMENSIONS, 2"-24" SIZES

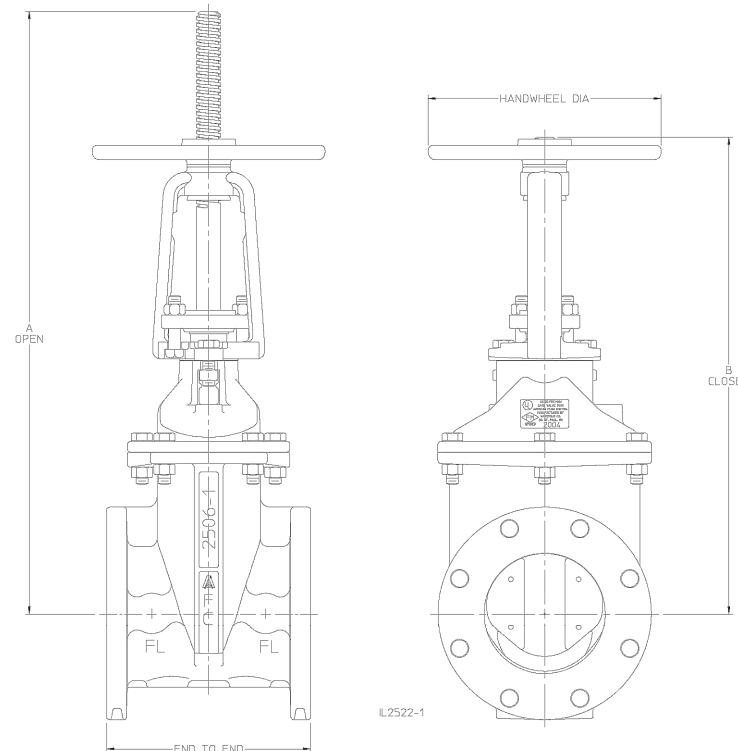

Dimensions	Valve Size											
	2"	2-1/2"	3"	4"	6"	8"	10"	12"	14"	16"	18"	20"
A (Valve Open) +/- 1/4	13.28	16.78	18.46	23.47	30.87	38.16	48.41	53.66	66.13	72.00	81.25	87.50
B (Valve Closed) +/- 1/4	11.08	14.12	15.07	19.12	24.59	29.91	38.16	41.78	51.75	55.25	62.63	66.81
Handwheel Diameter	7.00	8.00	8.00	10.00	12.00	14.00	16.00	16.00	20.00	20.00	20.00	28.00
End to End - FL/FL (Class 125)	7.00	7.50	8.00	9.00	10.50	11.50	13.00	14.00	15.00	16.00	17.00	18.00
No. of Turns to Open	9	11	13	14	20	25	31	38	44	50	56	62
End to End - FL/FL (Class 250)	N/A	N/A	N/A	12.00	15.88	16.50	18.00	19.75	18.50	21.00	22.00	24.00

NOTES:

- Valves meet or exceed requirements of ANSI/AWWA C515 in applicable sizes and rated to 250 psig working pressure.
- UL rated to 250 psig working pressure in applicable configurations 2 in. - 16 in., 20 in. sizes. UL rated to 200 psig working pressure in applicable configurations 18 in. and 24 in. sizes.
- FM rated to 250 psig working pressure in applicable configurations 2 in. - 24 in.
- Fusion bonded epoxy coating meets or exceeds requirements of ANSI/AWWA C550.
- Bolt patterns of Class 125 flanged ends are in accordance with ANSI/AWWA C110/A21.10 (ASME B16.1 Class 125).
- Class 250 flanged ends are in accordance with ASME B16.1, Class 250 for cast iron flanges.
- 2 in. - 24 in. valves are Certified to NSF/ANSI/CAN 61 and NSF/ANSI/CAN 372.

AMERICAN Flow Control
Page 3A-7
Series 2500 Resilient Wedge Gate Valve



Know what's below.
Call before you dig.

CALL 2 BUSINESS DAYS BEFORE YOU DIG.
CAUTION: UTILITY INFORMATION IS APPROXIMATE.
VERIFY ALL UTILITIES PRIOR TO CONSTRUCTION.

Revisions:

1	8/24/2023	ADDENDUM #1
4	8/28/2023	ADDENDUM #4

LINE IS 1" ON FULL
SCALE DRAWING

WINDSOR ENGINEERS



Ridgefield, WA
Duluth + Minneapolis, MN
www.windsorengineers.com
Project No: 20198.3

Copyright 2023 By Windsor Engineers, LLC
All Rights Reserved.



WATER RESILIENCY PROJECT
PHASE 1 - SEISMIC IMPROVEMENTS
CITY OF CANNON BEACH, OR 97110



ENGINEERING PLAN
Issue Date: 8/28/2023

Project Manager: TWT
Drawn by: TJM
Checked by: MRL

VAULT AND VALVE DETAILS - NORTH
RESERVOIR

C103

PLOT DATE: 8/28/2023 3:53 PM - FILE: C:\Users\MARCUSJ\OneDrive - Windsor Engineers\05 Projects\2020\20198-3 Cannon Beach Seismic Valves\02 Drawings\04 Working\04_Final Sheets\20198-3_site.dwg

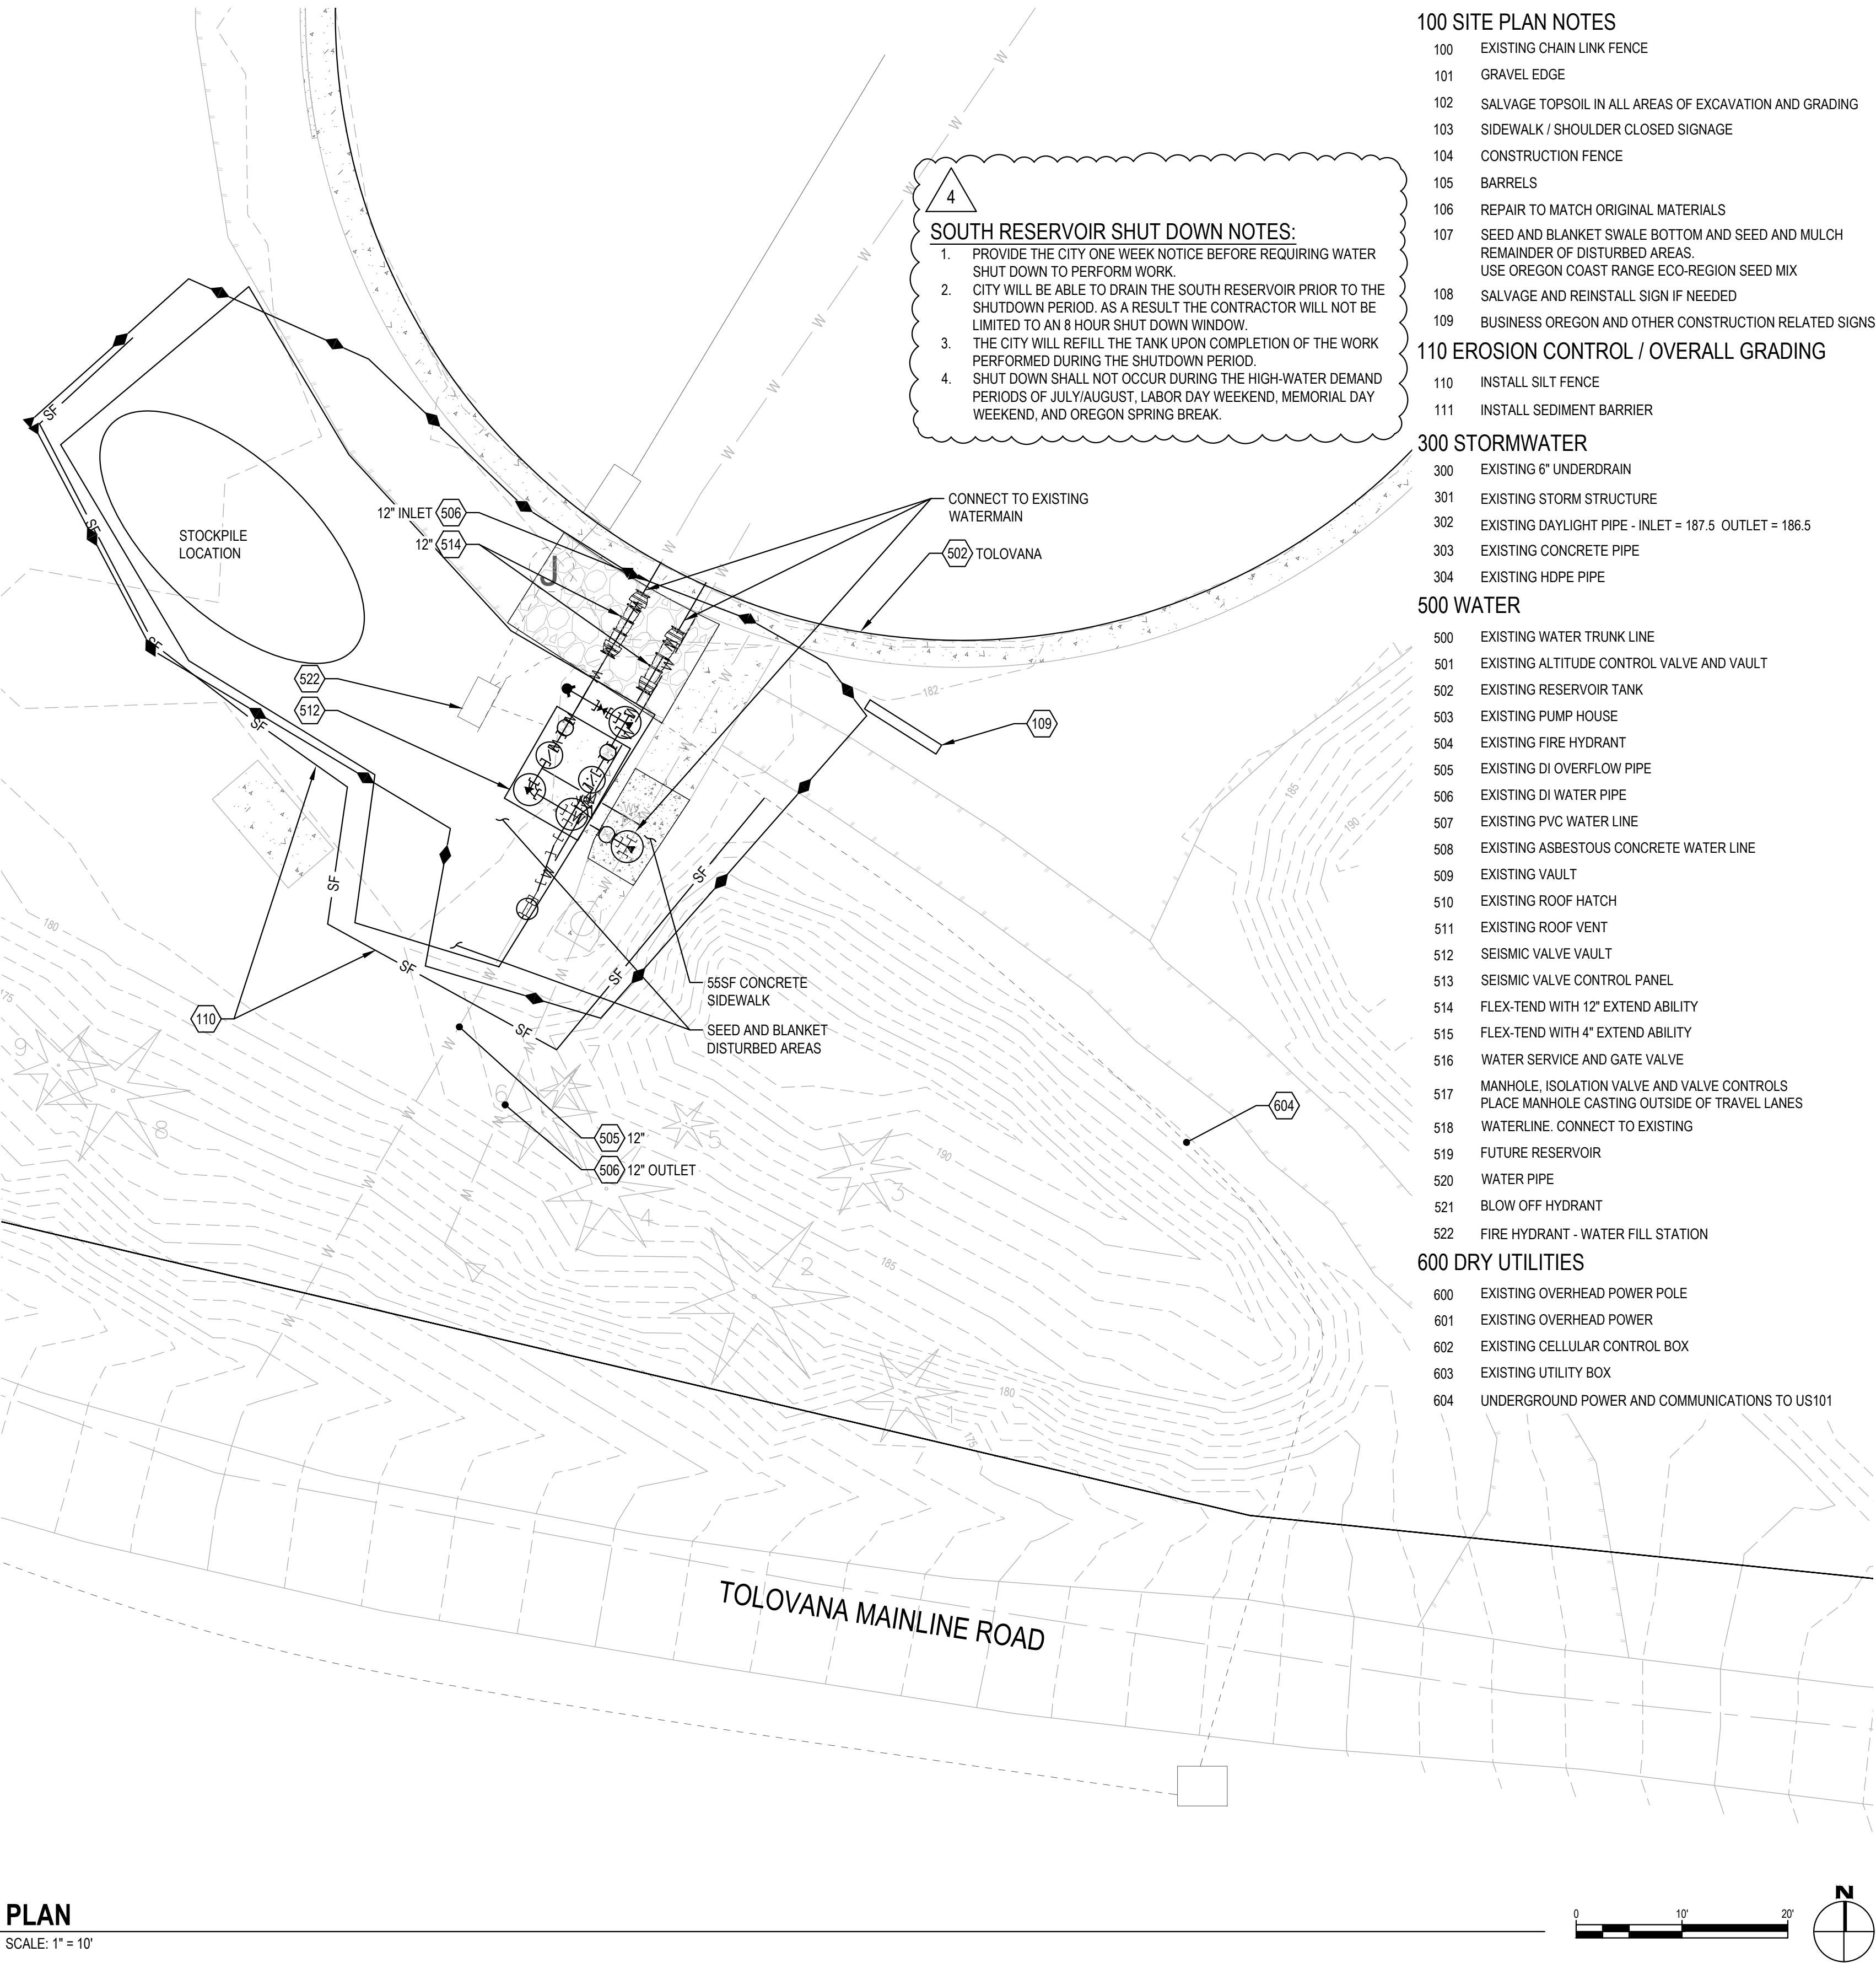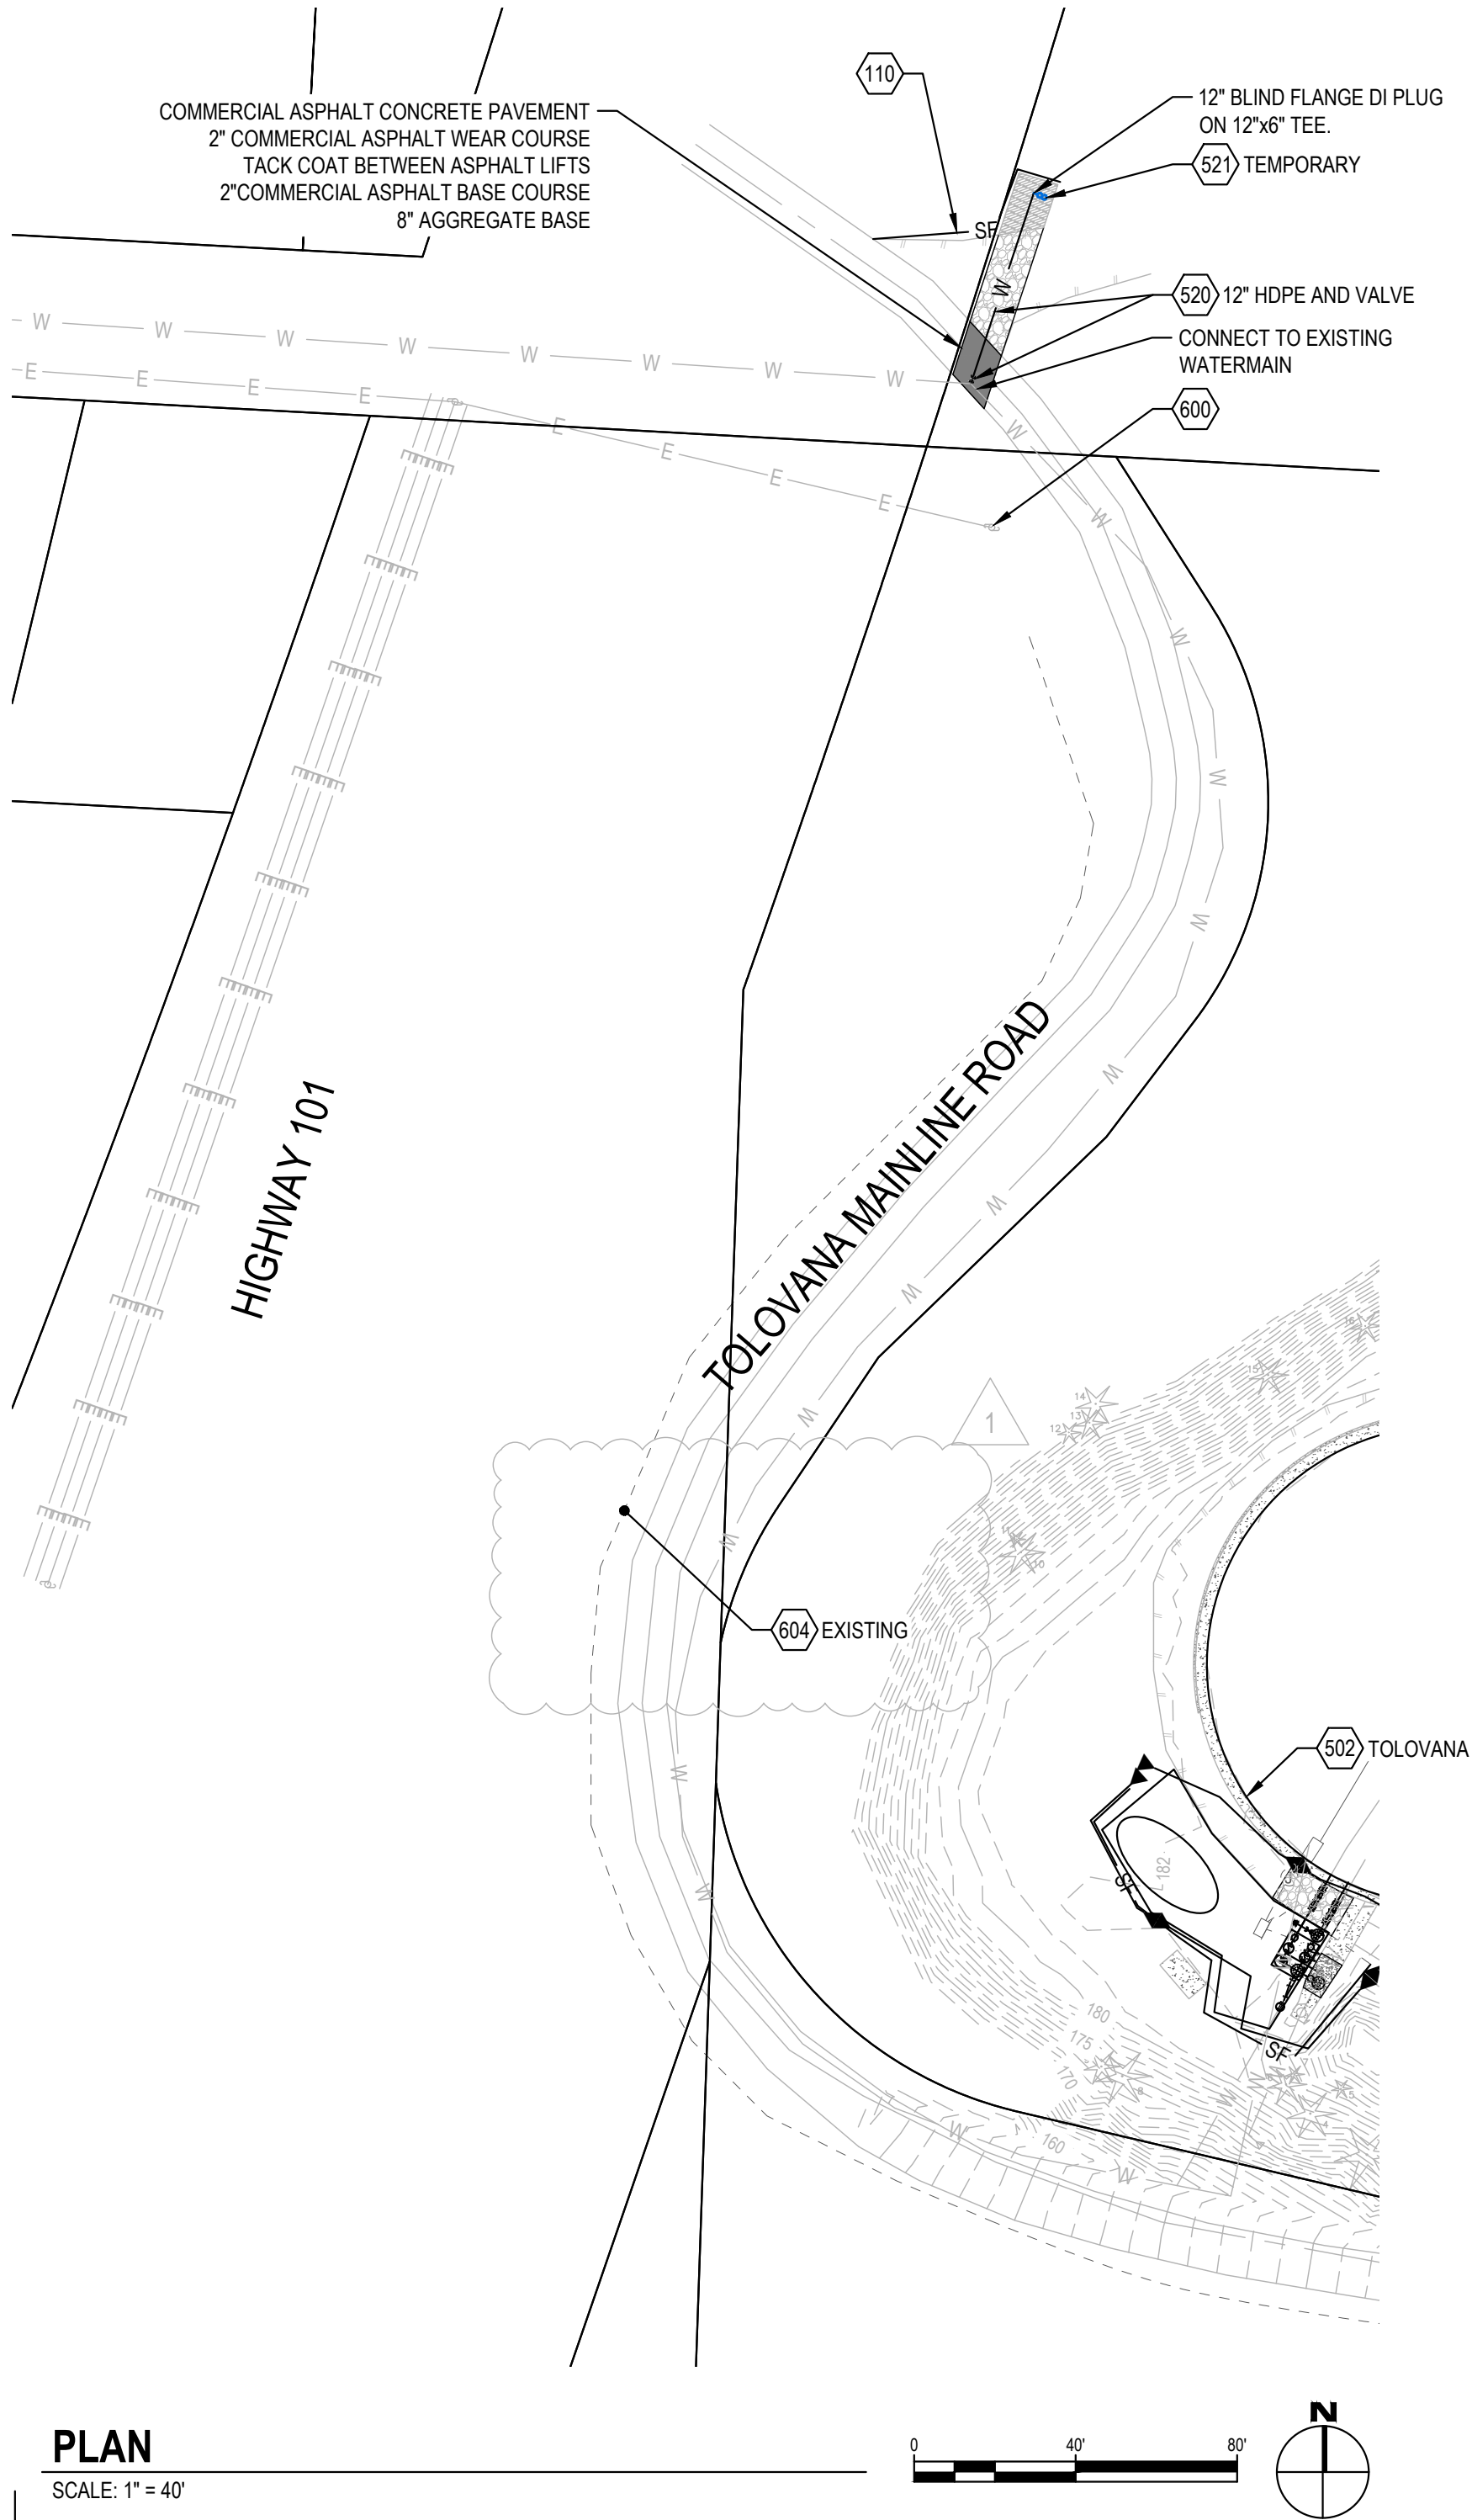

4

SOUTH RESERVOIR SHUT DOWN NOTES:

1. PROVIDE THE CITY ONE WEEK NOTICE BEFORE REQUIRING WATER SHUT DOWN TO PERFORM WORK.
2. CITY WILL BE ABLE TO DRAIN THE SOUTH RESERVOIR PRIOR TO THE SHUTDOWN PERIOD. AS A RESULT THE CONTRACTOR WILL NOT BE LIMITED TO AN 8 HOUR SHUT DOWN WINDOW.
3. THE CITY WILL REFILL THE TANK UPON COMPLETION OF THE WORK PERFORMED DURING THE SHUTDOWN PERIOD.
4. SHUT DOWN SHALL NOT OCCUR DURING THE HIGH-WATER DEMAND PERIODS OF JULY/AUGUST, LABOR DAY WEEKEND, MEMORIAL DAY WEEKEND, AND OREGON SPRING BREAK.

- 100 SITE PLAN NOTES**
- 100 EXISTING CHAIN LINK FENCE
 - 101 GRAVEL EDGE
 - 102 SALVAGE TOPSOIL IN ALL AREAS OF EXCAVATION AND GRADING
 - 103 SIDEWALK / SHOULDER CLOSED SIGNAGE
 - 104 CONSTRUCTION FENCE
 - 105 BARRELS
 - 106 REPAIR TO MATCH ORIGINAL MATERIALS
 - 107 SEED AND BLANKET SWALE BOTTOM AND SEED AND MULCH REMAINDER OF DISTURBED AREAS. USE OREGON COAST RANGE ECO-REGION SEED MIX
 - 108 SALVAGE AND REINSTALL SIGN IF NEEDED
 - 109 BUSINESS OREGON AND OTHER CONSTRUCTION RELATED SIGNS.

- 110 EROSION CONTROL / OVERALL GRADING**
- 110 INSTALL SILT FENCE
 - 111 INSTALL SEDIMENT BARRIER

- 300 STORMWATER**
- 300 EXISTING 6" UNDERDRAIN
 - 301 EXISTING STORM STRUCTURE
 - 302 EXISTING DAYLIGHT PIPE - INLET = 187.5 OUTLET = 186.5
 - 303 EXISTING CONCRETE PIPE
 - 304 EXISTING HDPE PIPE


- 500 WATER**
- 500 EXISTING WATER TRUNK LINE
 - 501 EXISTING ALTITUDE CONTROL VALVE AND VAULT
 - 502 EXISTING RESERVOIR TANK
 - 503 EXISTING PUMP HOUSE
 - 504 EXISTING FIRE HYDRANT
 - 505 EXISTING DI OVERFLOW PIPE
 - 506 EXISTING DI WATER PIPE
 - 507 EXISTING PVC WATER LINE
 - 508 EXISTING ASBESTOUS CONCRETE WATER LINE
 - 509 EXISTING VAULT
 - 510 EXISTING ROOF HATCH
 - 511 EXISTING ROOF VENT
 - 512 SEISMIC VALVE VAULT
 - 513 SEISMIC VALVE CONTROL PANEL
 - 514 FLEX-TEND WITH 12" EXTEND ABILITY
 - 515 FLEX-TEND WITH 4" EXTEND ABILITY
 - 516 WATER SERVICE AND GATE VALVE
 - 517 MANHOLE, ISOLATION VALVE AND VALVE CONTROLS PLACE MANHOLE CASTING OUTSIDE OF TRAVEL LANES
 - 518 WATERLINE: CONNECT TO EXISTING
 - 519 FUTURE RESERVOIR
 - 520 WATER PIPE
 - 521 BLOW OFF HYDRANT
 - 522 FIRE HYDRANT - WATER FILL STATION

- 600 DRY UTILITIES**
- 600 EXISTING OVERHEAD POWER POLE
 - 601 EXISTING OVERHEAD POWER
 - 602 EXISTING CELLULAR CONTROL BOX
 - 603 EXISTING UTILITY BOX
 - 604 UNDERGROUND POWER AND COMMUNICATIONS TO US101

GENERAL SHEET NOTES:

1. EXISTING VAULT TO BE REPLACED WITH NEW GATE VALVES AND ACTUATOR
2. FLEX-TENDS TO BE INSTALLED BETWEEN RESERVOIR AND VAULT
3. 6" DI HYDRANT ASSEMBLY TO BE INSTALLED BETWEEN FLEX-TENDS AND GATE VALVE VAULT
4. ELECTRIC CONTROL PANEL AND POWER TO BE INSTALLED
5. CITY, CONTRACTOR, AND ENGINEER TO HAVE A MEETING TO DISCUSS COORDINATION, RESPONSIBILITIES, AND LIMITATIONS RELATED TO WATER SHUTDOWNS.

SOUTH RESERVOIR QUANTITIES		
ITEM	UNITS	QUANTITY
TRAFFIC CONTROL	LS	1
TEMPORARY SIGNS	EA	1
EXTRA FOR SELECTED TOPSOIL MATERIAL (IF NEEDED)	CY	180
SEDIMENT FENCE	LF	100
SEDIMENT BARRIER, TYPE 3	LF	1
SEEDING MOBILIZATION	LS	1
TEMPORARY SEEDING	AC	0
PERMANENT SEEDING	AC	0
MATTING, TYPE A	SY	10
MULCHING, STRAW	AC	0
MULCHING, HYDROMULCH	SY	1000
AGGREGATE BASE	TN	15
COMMERCIAL ASPHALT CONCRETE PAVEMENT	TN	5
6 INCH CONCRETE SURFACING	SY	10
CONNECTION TO EXISTING MAIN	EA	4
6" GATE VALVE	EA	11
12" GATE VALVE	EA	2
12" CHECK VALVE	EA	2
12" GATE VALVE WITH ACTUATOR	EA	2
12" FLEXTEND	EA	2
HYDRANT ASSEMBLIES	EA	1
10' x 8' VAULT	EA	1
12 INCH HDPE PIPE	LF	40
6 INCH DUCTILE IRON PIPE	LF	10
12 INCH DUCTILE IRON PIPE	LF	80
DI PIPE TEES, 12"x6"	EA	2
DI PIPE TEES, 12"x12"	EA	1
DI PIPE CROSS, 12"	EA	1
DI PIPE 45° BEND, 12"	EA	2
DI PIPE 90° BEND, 12"	EA	1
DI PIPE SLIP JOINT, 12"	EA	2
12" PLUG	EA	1
BLOWOFF ASSEMBLY, 2"	EA	1

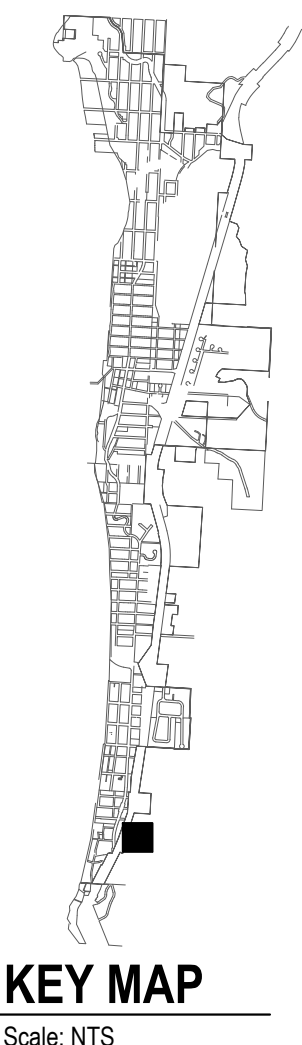

Know what's below.
Call before you dig.
CALL 2 BUSINESS DAYS BEFORE YOU DIG.
CAUTION UTILITY INFORMATION IS APPROXIMATE.
VERIFY ALL UTILITIES PRIOR TO CONSTRUCTION.

Revisions:

1	8/24/2023	ADDENDUM #1
4	8/28/2023	ADDENDUM #4

LINE IS 1" ON FULL SCALE DRAWING



WINDSOR ENGINEERS
Ridgefield, WA
Duluth + Minneapolis, MN
www.windsorengineers.com
Project No: 20198.3
Copyright 2023 By Windsor Engineers, LLC
All Rights Reserved.




**WATER RESILIENCY PROJECT
PHASE 1 - SEISMIC IMPROVEMENTS
CITY OF CANNON BEACH, OR 97110**

ENGINEERING PLAN
Issue Date: 8/28/2023

Project Manager TWT
Drawn by TJM
Checked by MRL

**SITE & EROSION CONTROL PLAN -
TOLOVANA RESERVOIR**

C104

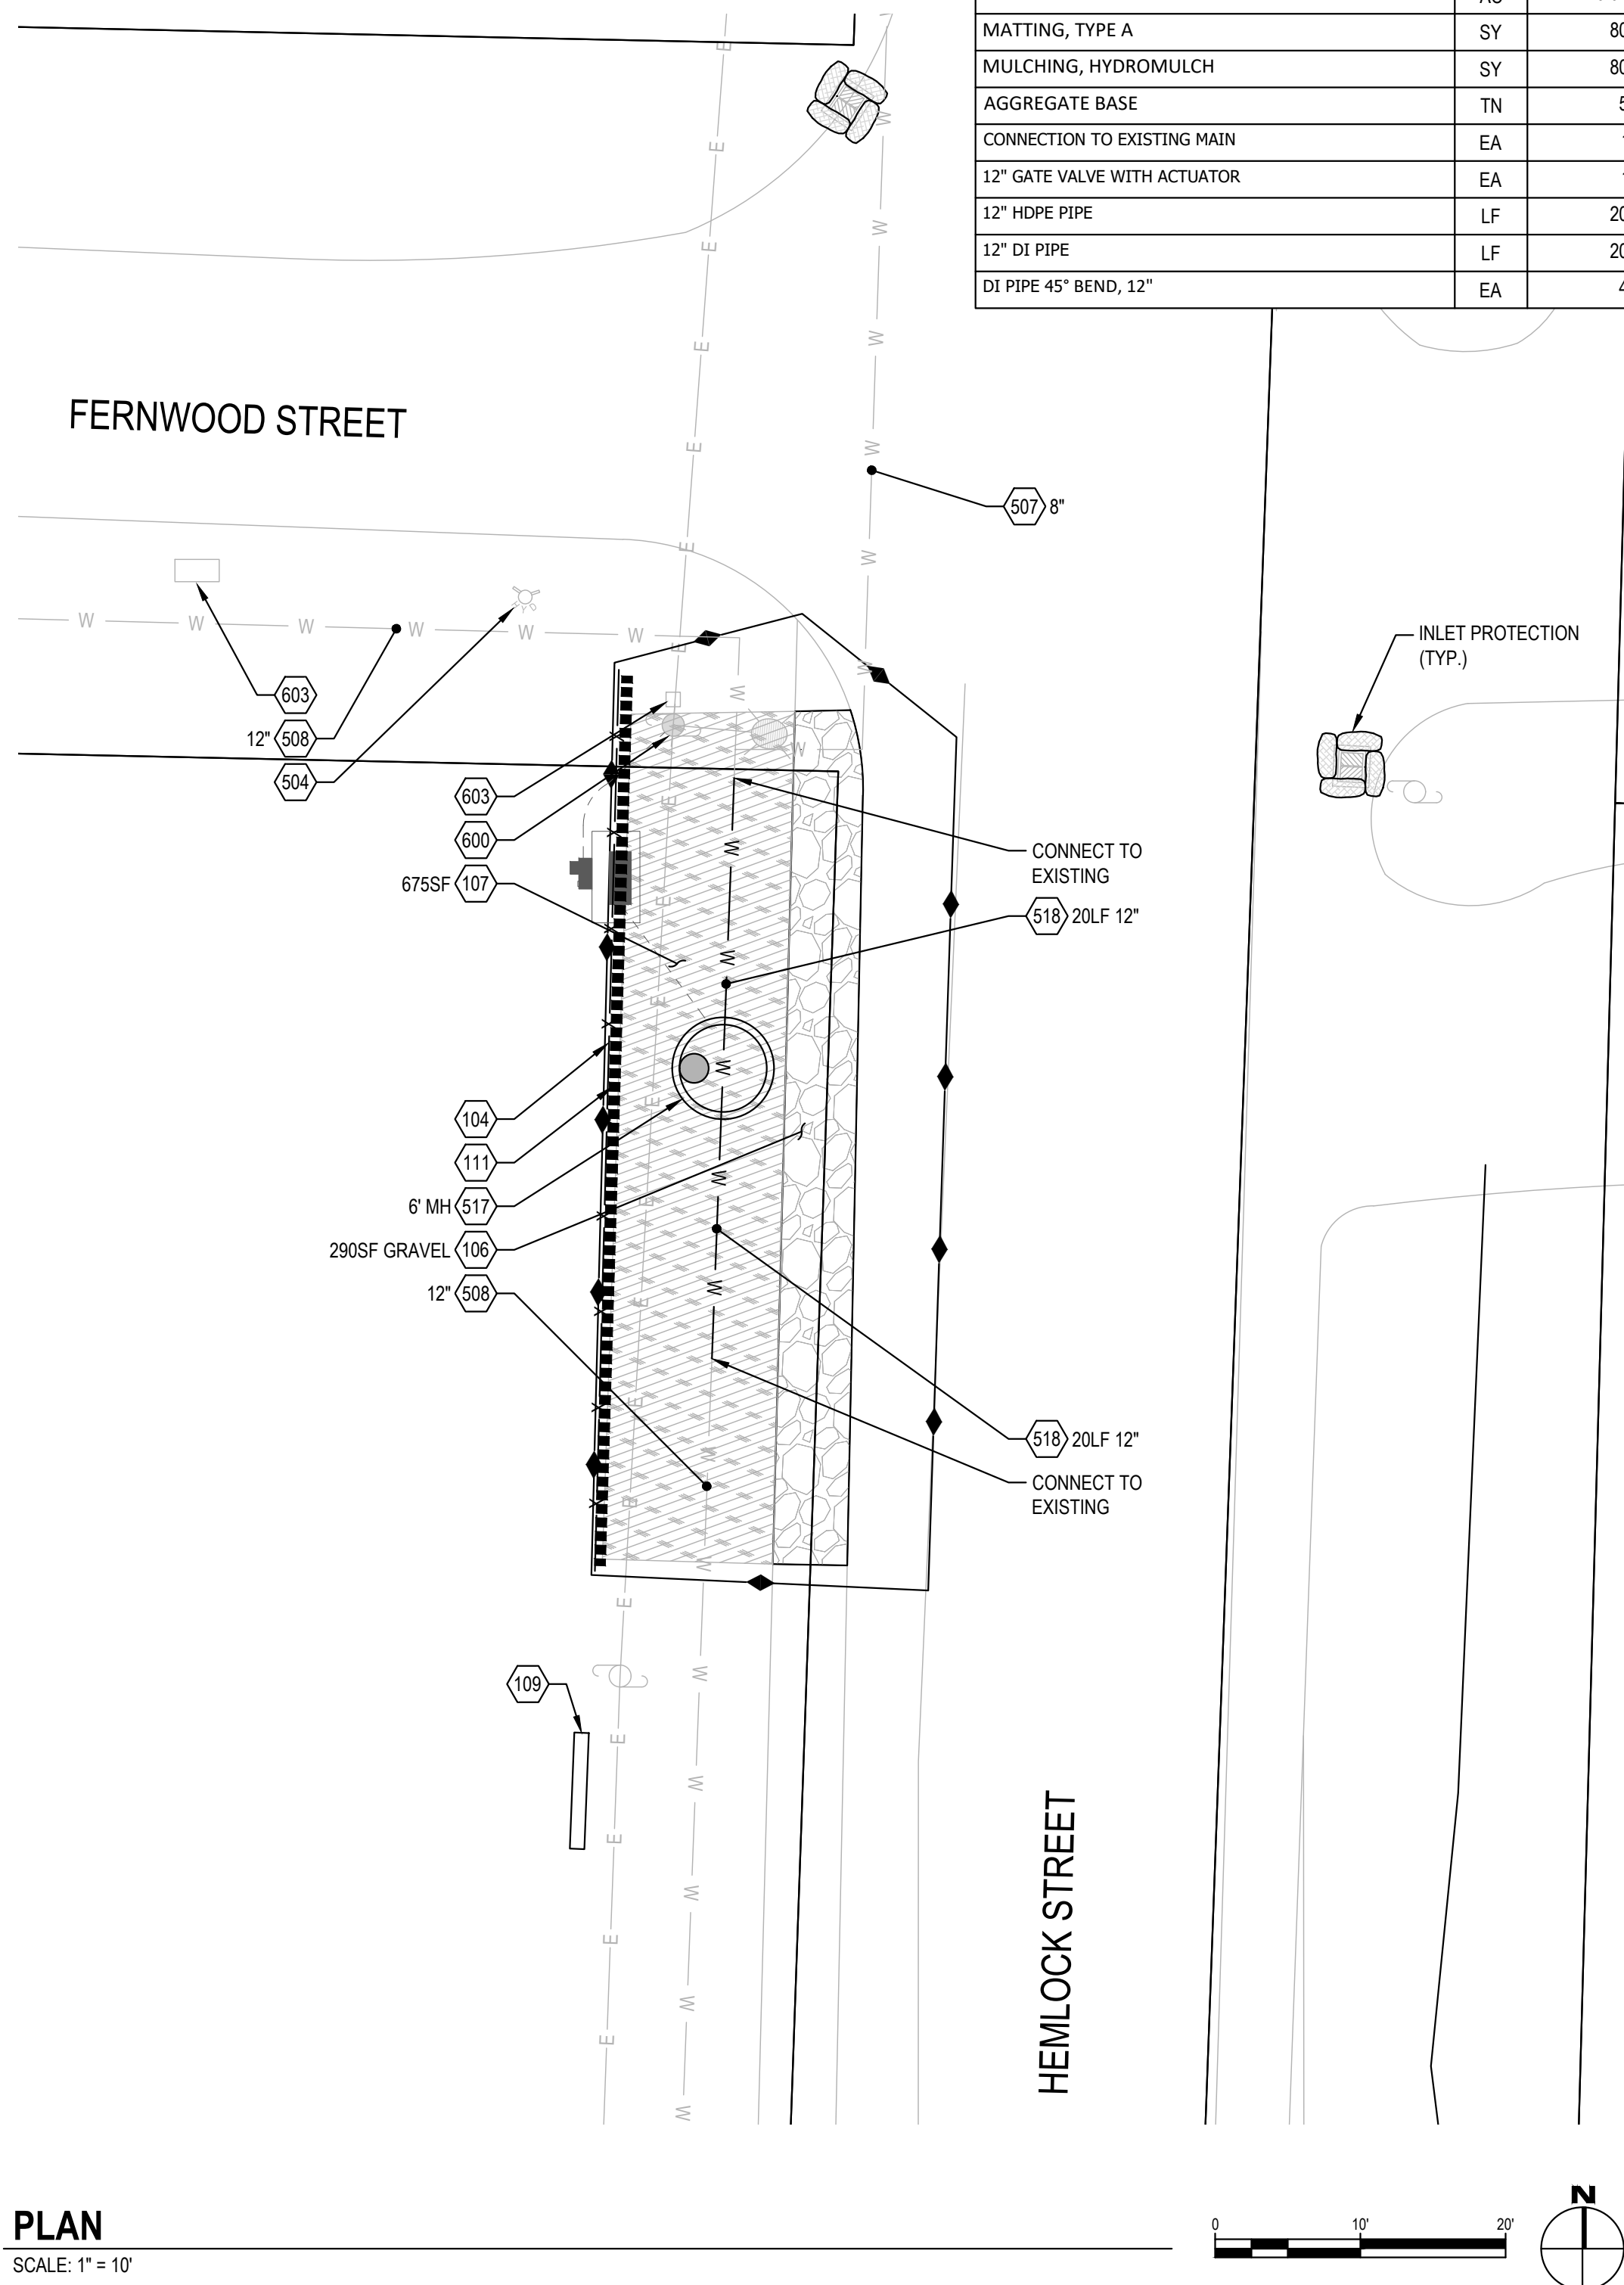

ISOLATION VALVE 4 QUANTITIES		
ITEM	UNITS	QUANTITY
TRAFFIC CONTROL	LS	1
TEMPORARY SIGNS	EA	1
EXTRA FOR SELECTED TOPSOIL MATERIAL (IF NEEDED)	CY	5
SEDIMENT FENCE	LF	60
SEDIMENT BARRIER, TYPE 3	LF	60
INLET PROTECTION, TYPE 3	EA	4
SEEDING MOBILIZATION	LS	1
TEMPORARY SEEDING	AC	0.02
PERMANENT SEEDING	AC	0.02
MATTING, TYPE A	SY	80
MULCHING, HYDROMULCH	SY	80
AGGREGATE BASE	TN	5
CONNECTION TO EXISTING MAIN	EA	1
12" GATE VALVE WITH ACTUATOR	EA	1
12" HDPE PIPE	LF	20
12" DI PIPE	LF	20
DI PIPE 45° BEND, 12"	EA	4

100 EXISTING CHAIN LINK FENCE
101 GRAVEL EDGE
102 SALVAGE TOPSOIL IN ALL AREAS OF EXCAVATION AND GRADING
103 SIDEWALK / SHOULDER CLOSED SIGNAGE
104 CONSTRUCTION FENCE
105 BARRELS
106 REPAIR TO MATCH ORIGINAL MATERIALS
107 SEED AND BLANKET SWALE BOTTOM AND SEED AND MULCH
REMAINDER OF DISTURBED AREAS.
USE OREGON COAST RANGE ECO-REGION SEED MIX
108 SALVAGE AND REINSTALL SIGN IF NEEDED
109 BUSINESS OREGON AND OTHER CONSTRUCTION RELATED SIGNS.


110 INSTALL SILT FENCE

111 INSTALL SEDIMENT BARRIER

300 EXISTING 6" UNDERDRAIN
301 EXISTING STORM STRUCTURE
302 EXISTING DAYLIGHT PIPE - INLET = 187.5 OUTLET = 186.5
303 EXISTING CONCRETE PIPE
304 EXISTING HDPE PIPE


500	EXISTING WATER TRUNK LINE
501	EXISTING ALTITUDE CONTROL VALVE AND VAULT
502	EXISTING RESERVOIR TANK
503	EXISTING PUMP HOUSE
504	EXISTING FIRE HYDRANT
505	EXISTING DI OVERFLOW PIPE
506	EXISTING DI WATER PIPE
507	EXISTING PVC WATER LINE
508	EXISTING ASBESTOUS CONCRETE WATER LINE
509	EXISTING VAULT
510	EXISTING ROOF HATCH
511	EXISTING ROOF VENT
512	SEISMIC VALVE VAULT
513	SEISMIC VALVE CONTROL PANEL
514	FLEX-TEND WITH 12" EXTEND ABILITY
515	FLEX-TEND WITH 4" EXTEND ABILITY
516	WATER SERVICE AND GATE VALVE
517	MANHOLE, ISOLATION VALVE AND VALVE CONTROLS PLACE MANHOLE CASTING OUTSIDE OF TRAVEL LANES
518	WATERLINE, CONNECT TO EXISTING
519	FUTURE RESERVOIR
520	WATER PIPE
521	BLOW OFF HYDRANT
522	FIRE HYDRANT - WATER FILL STATION

600 EXISTING OVERHEAD POWER POLE
601 EXISTING OVERHEAD POWER
602 EXISTING CELLULAR CONTROL BOX
603 EXISTING UTILITY BOX

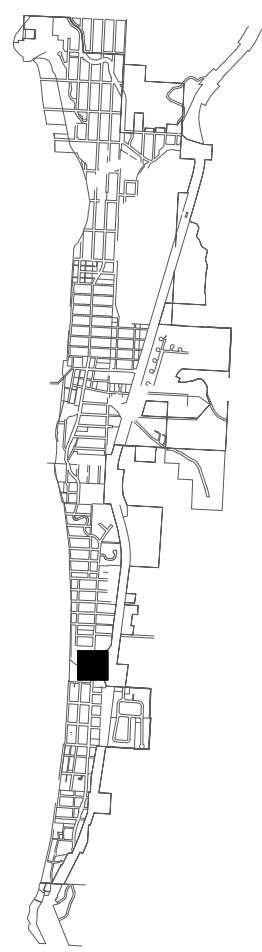

KEY MAP

Scale: NTS

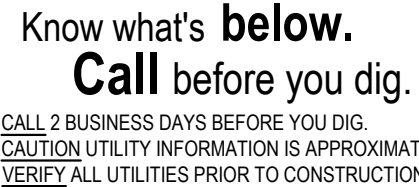

Revisions:

#	DATE	DESCRIPTION
1	8/24/2023	ADDENDUM #1
4	8/28/2023	ADDENDUM #4


LINE IS 1" ON FULL
SCALE DRAWING

LINE IS 1" ON FULL
SCALE DRAWING



Ridgefield, WA
Duluth + Minneapolis, MN
www.windsorengineers.com
Project No: 20198.3

Copyright 2023 By Windsor Engineers, LLC
All Rights Reserved.

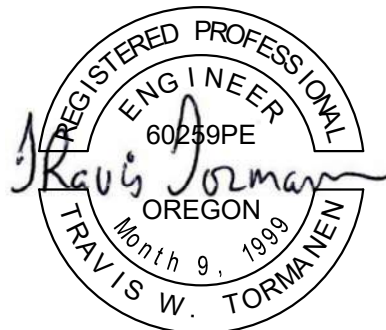

EXPIRES: 06-30-24

**WATER RESILIENCY PROJECT
PHASE 1 - SEISMIC IMPROVEMENTS
CITY OF CANNON BEACH, OR 97110**

ENGINEERING PLAN

Issue Date: 8/28/2023

Project Manager	TWT
Drawn by	TJM
Checked by	MRL

SITE & EROSION CONTROL PLAN - ISOLATION VALVE 4

C106

PLOT DATE: 02/22/2023 4:35 PM - FILE: C:\Users\Thad\OneDrive - Windsor Engineers\OneDrive\Projects\2020\20198-3 Cannon Beach Seismic\Values\02_Drawings\01_Working\04_Final Sheets\20198-3_DET.dwg




Know what's below.
Call before you dig.
CALL 2 BUSINESS DAYS BEFORE YOU DIG.
CAUTION UTILITY INFORMATION IS APPROXIMATE.
VERIFY ALL UTILITIES PRIOR TO CONSTRUCTION.

Revisions:



NO.	DATE	DESCRIPTION
1	8/24/2023	ADDENDUM #1
4	8/28/2023	ADDENDUM #4

LINE IS 1" ON FULL
SCALE DRAWING

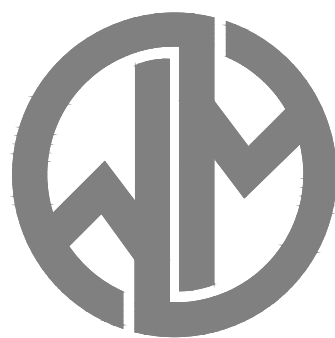

WINDSOR ENGINEERS

Ridgefield, WA
Duluth + Minneapolis, MN
www.windsorengineers.com
Project No: 20198.3

Copyright 2023 By Windsor Engineers, LLC
All Rights Reserved.


WATER RESILIENCY PROJECT
PHASE 1 - SEISMIC IMPROVEMENTS
CITY OF CANNON BEACH, OR 97110

ENGINEERING PLAN
Issue Date: 8/22/2023

Project Manager: TWT
Drawn by: TJM
Checked by: MRL


SITE DETAILS

C190

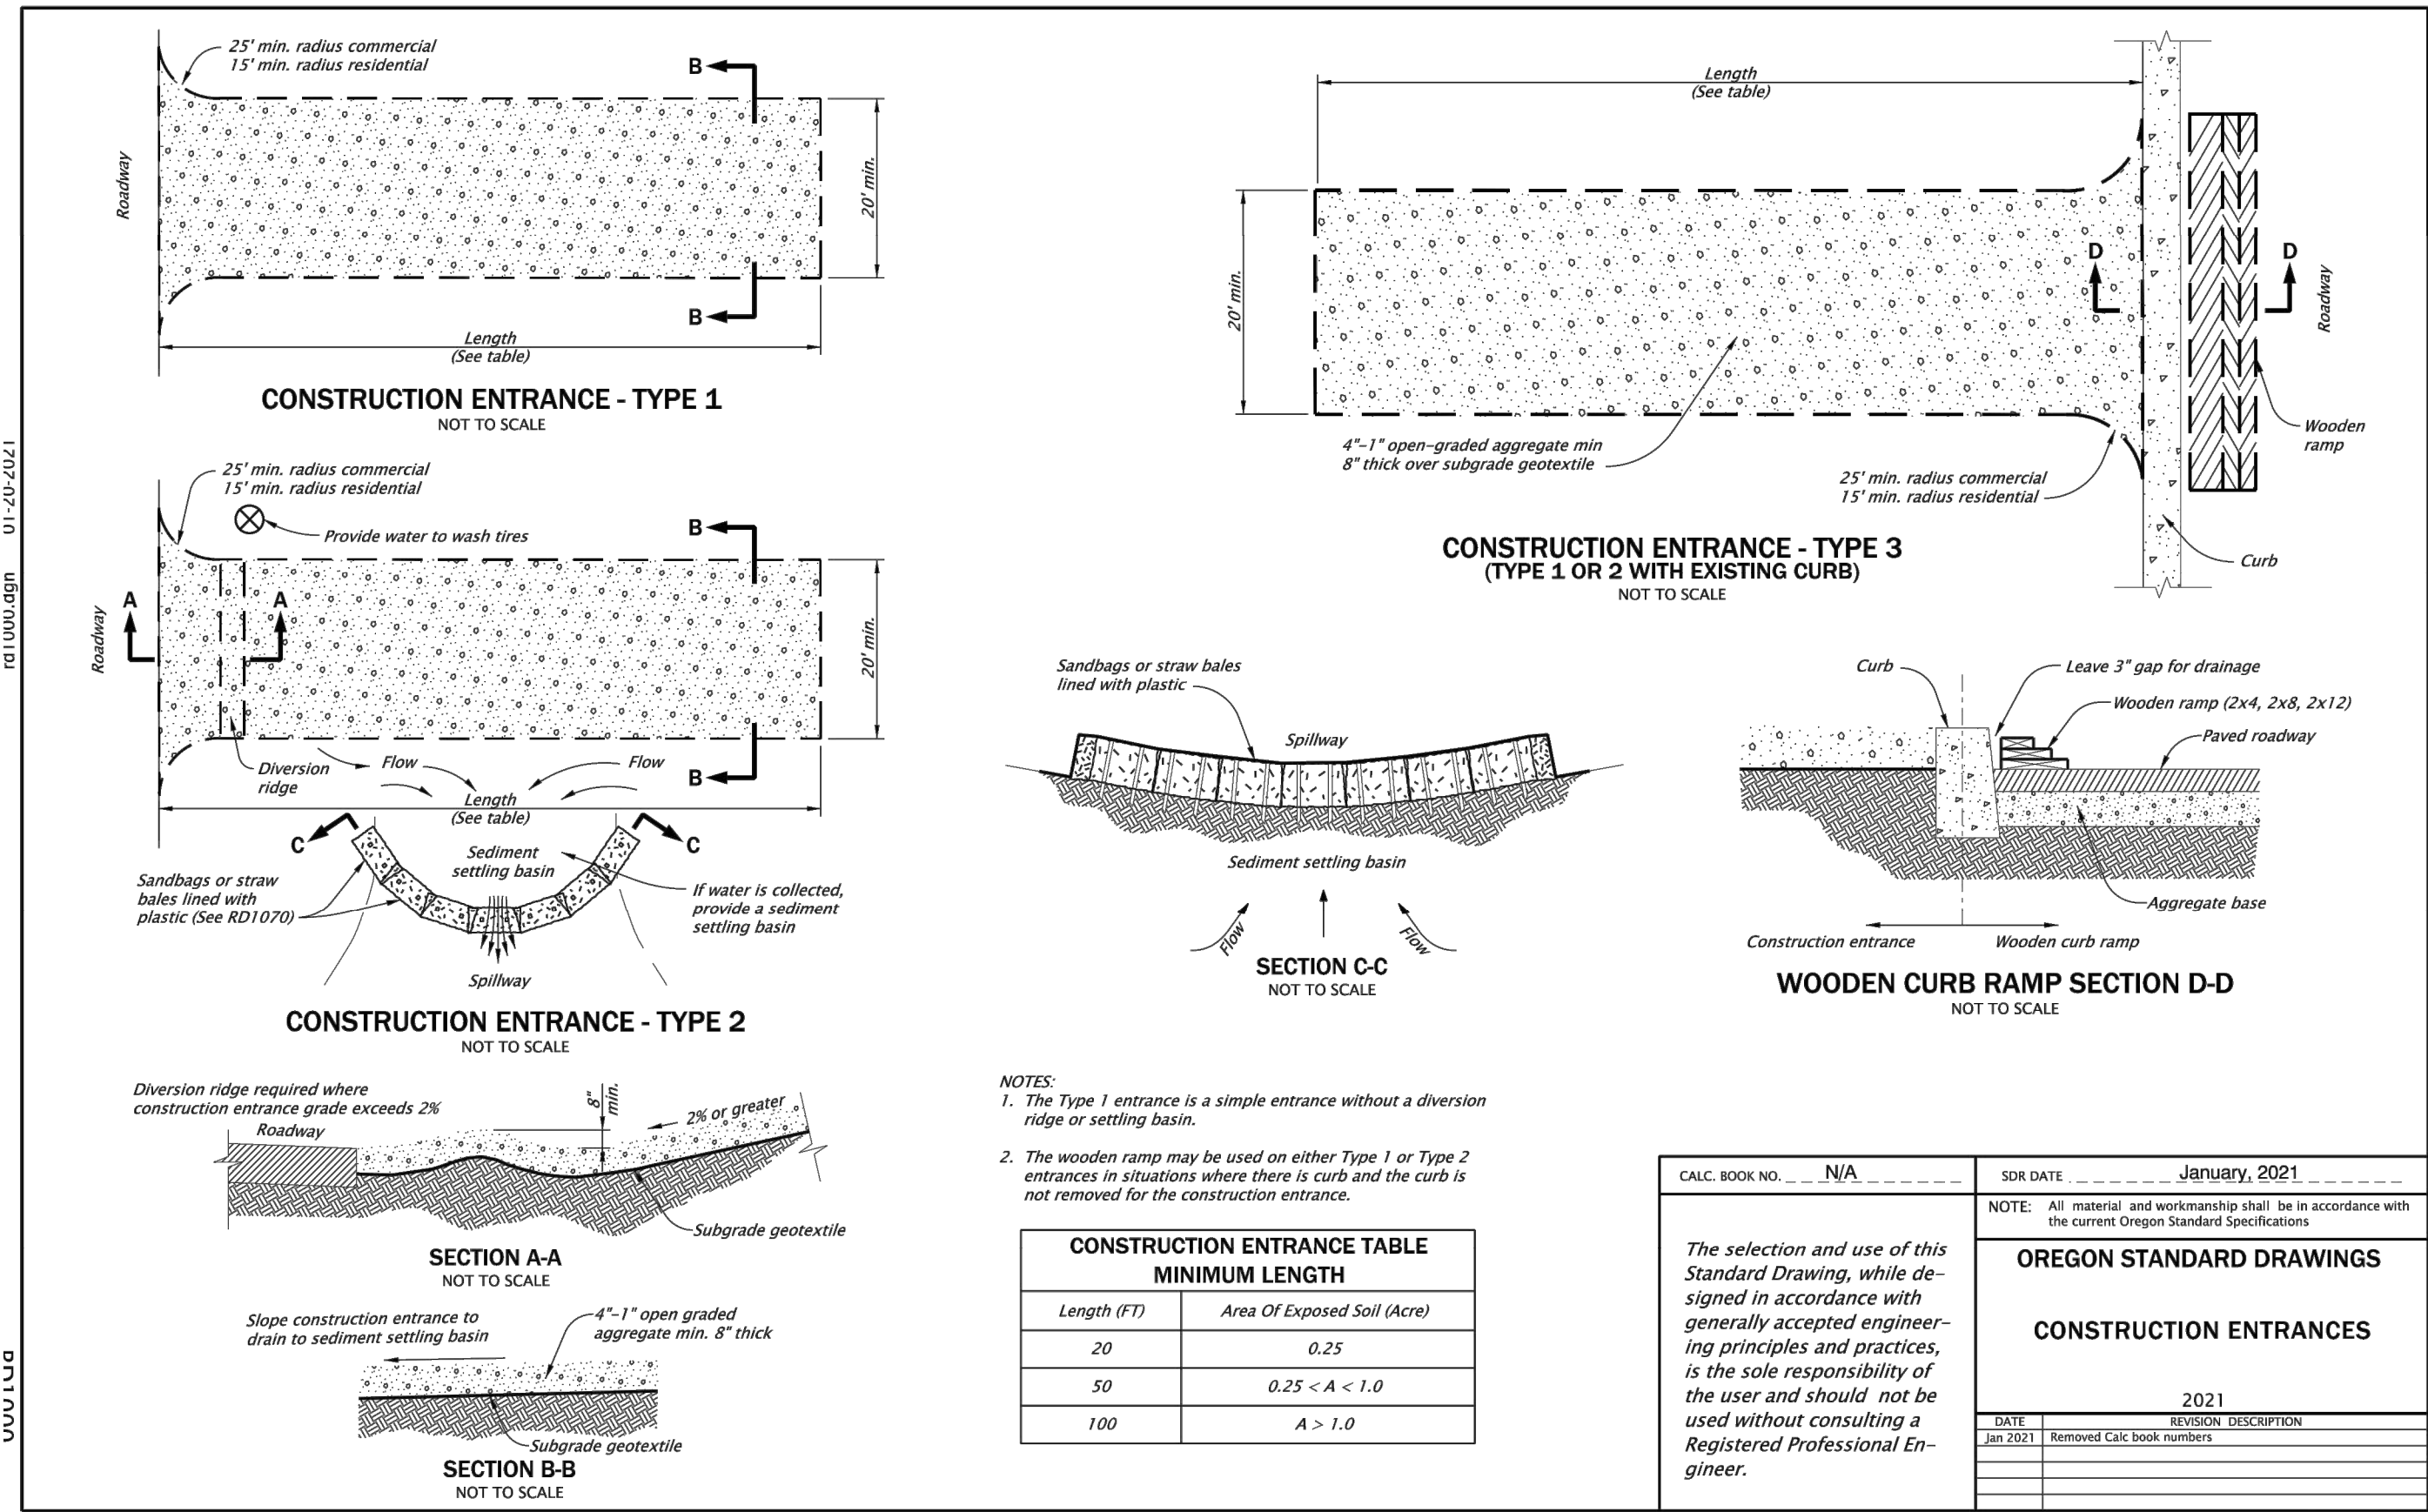


Effective Date: June 1, 2021 - November 30, 2021

RD1000

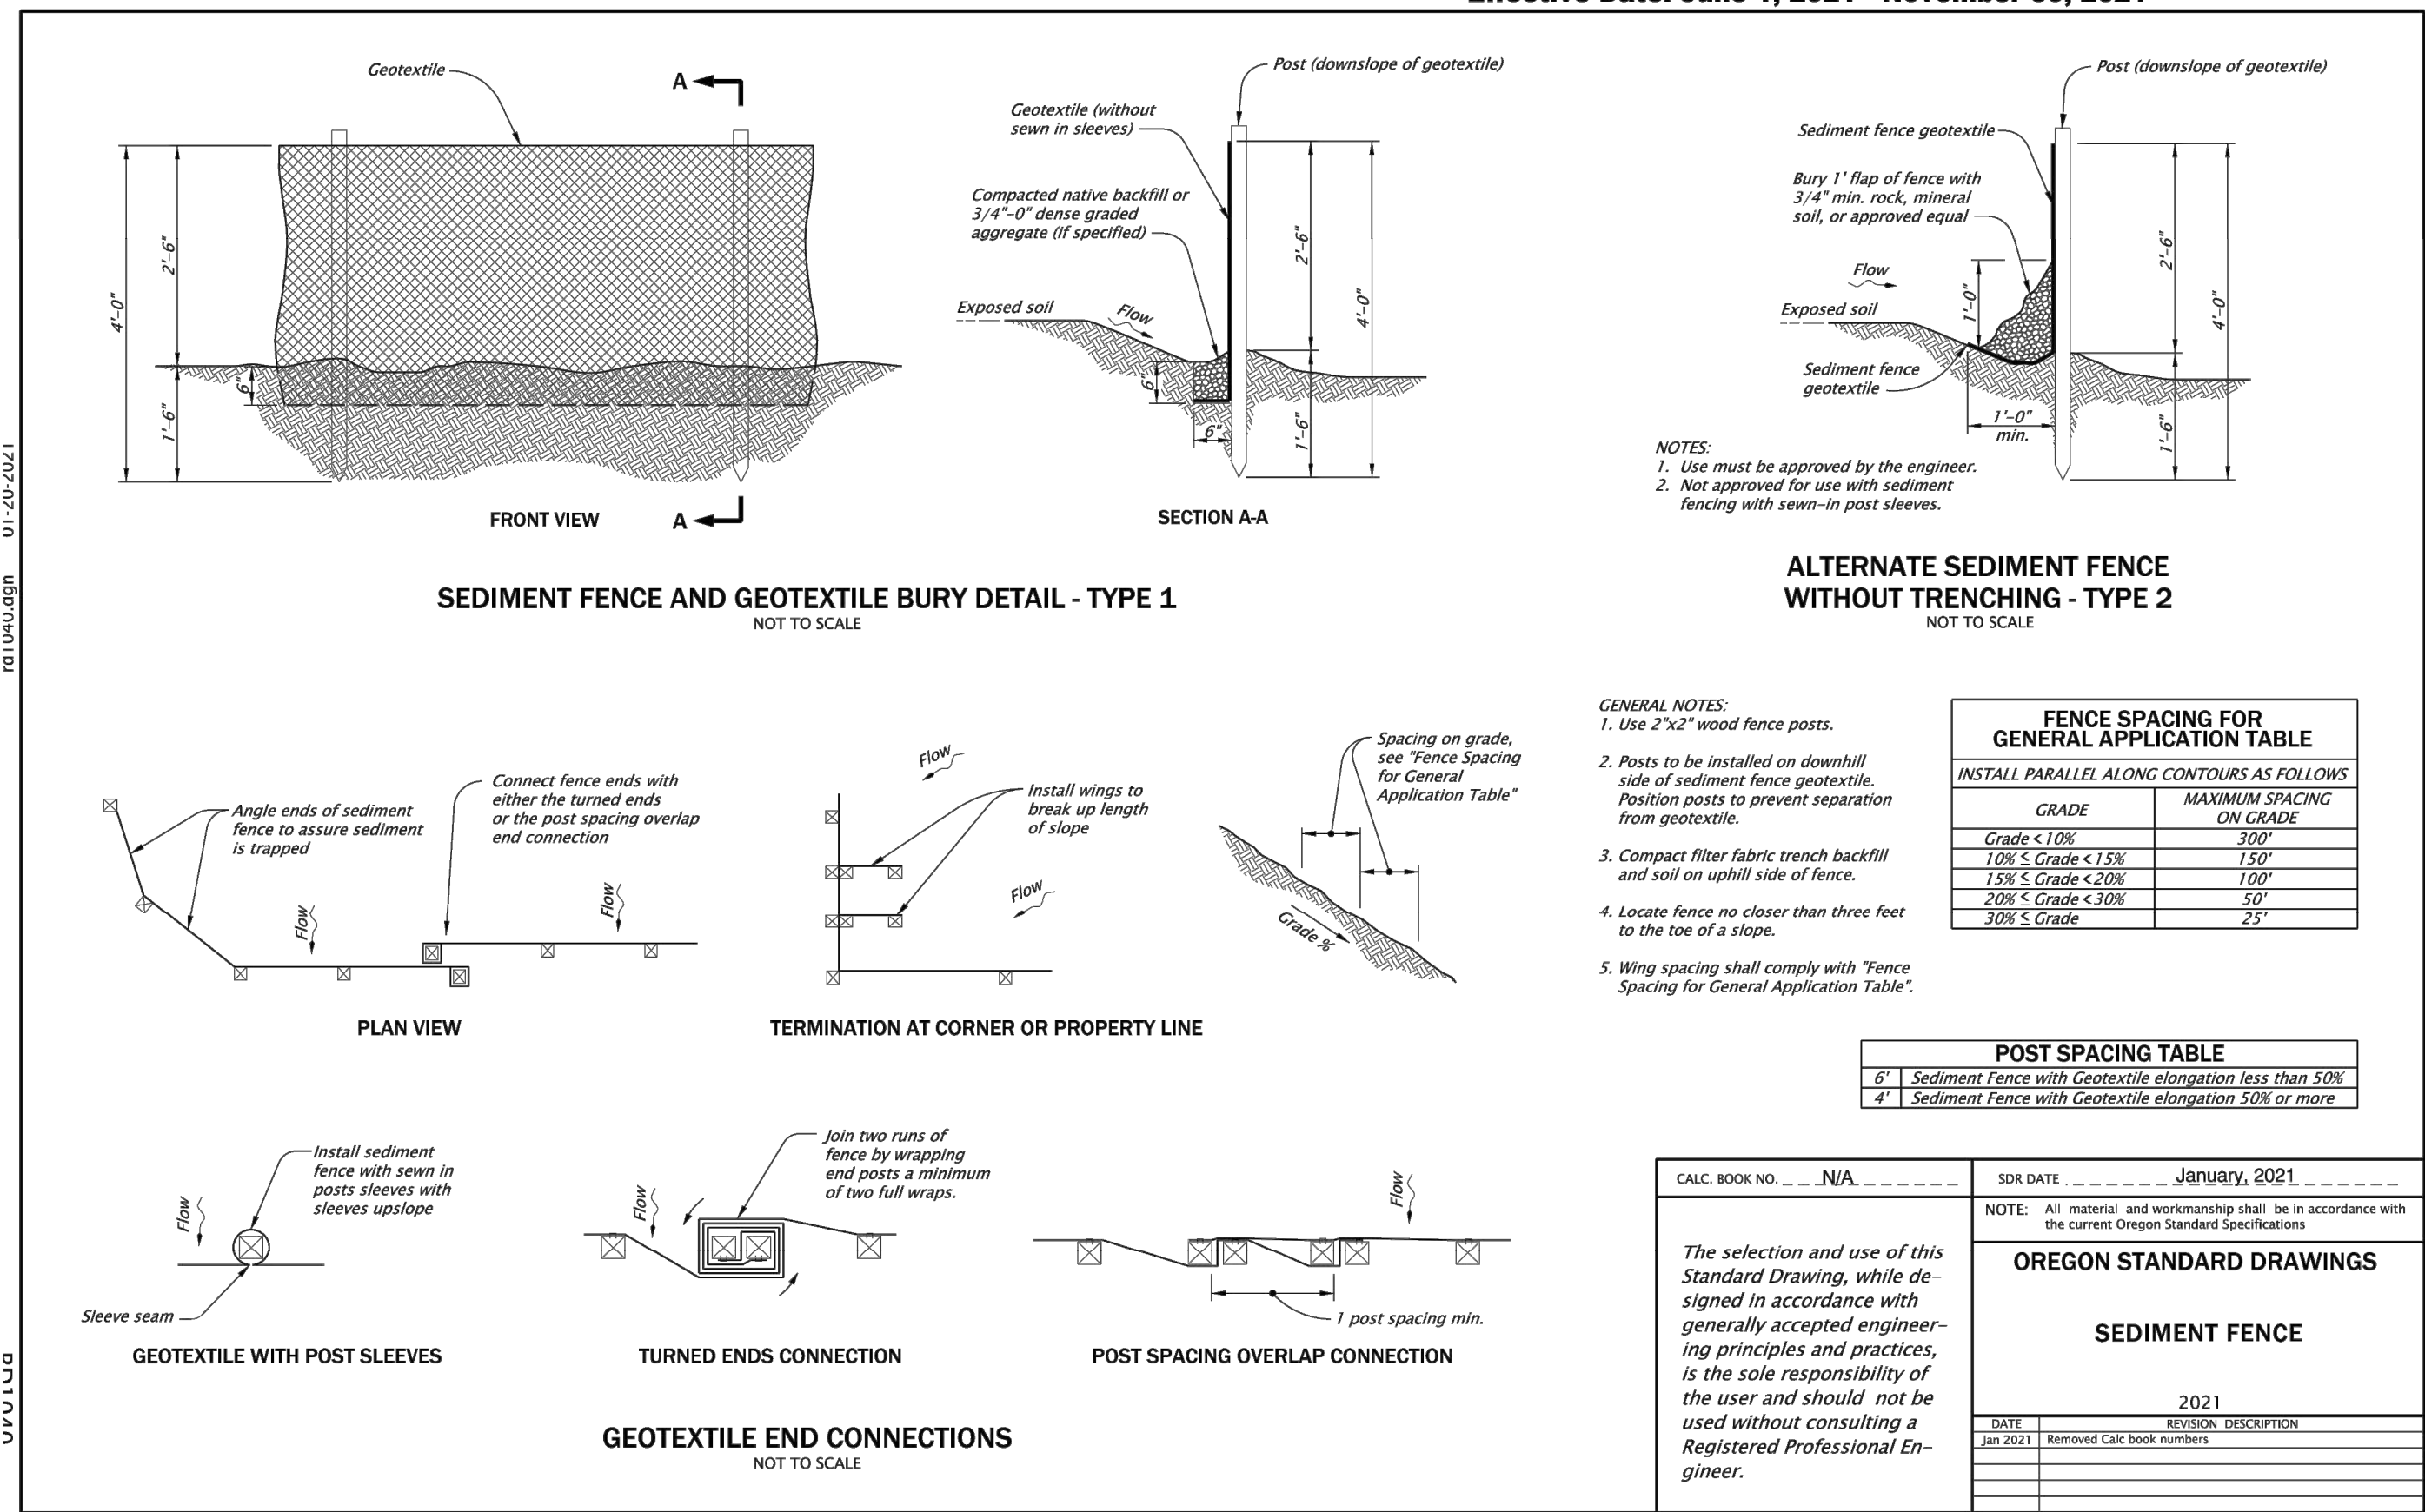


Effective Date: June 1, 2021 - November 30, 2021

RD1040

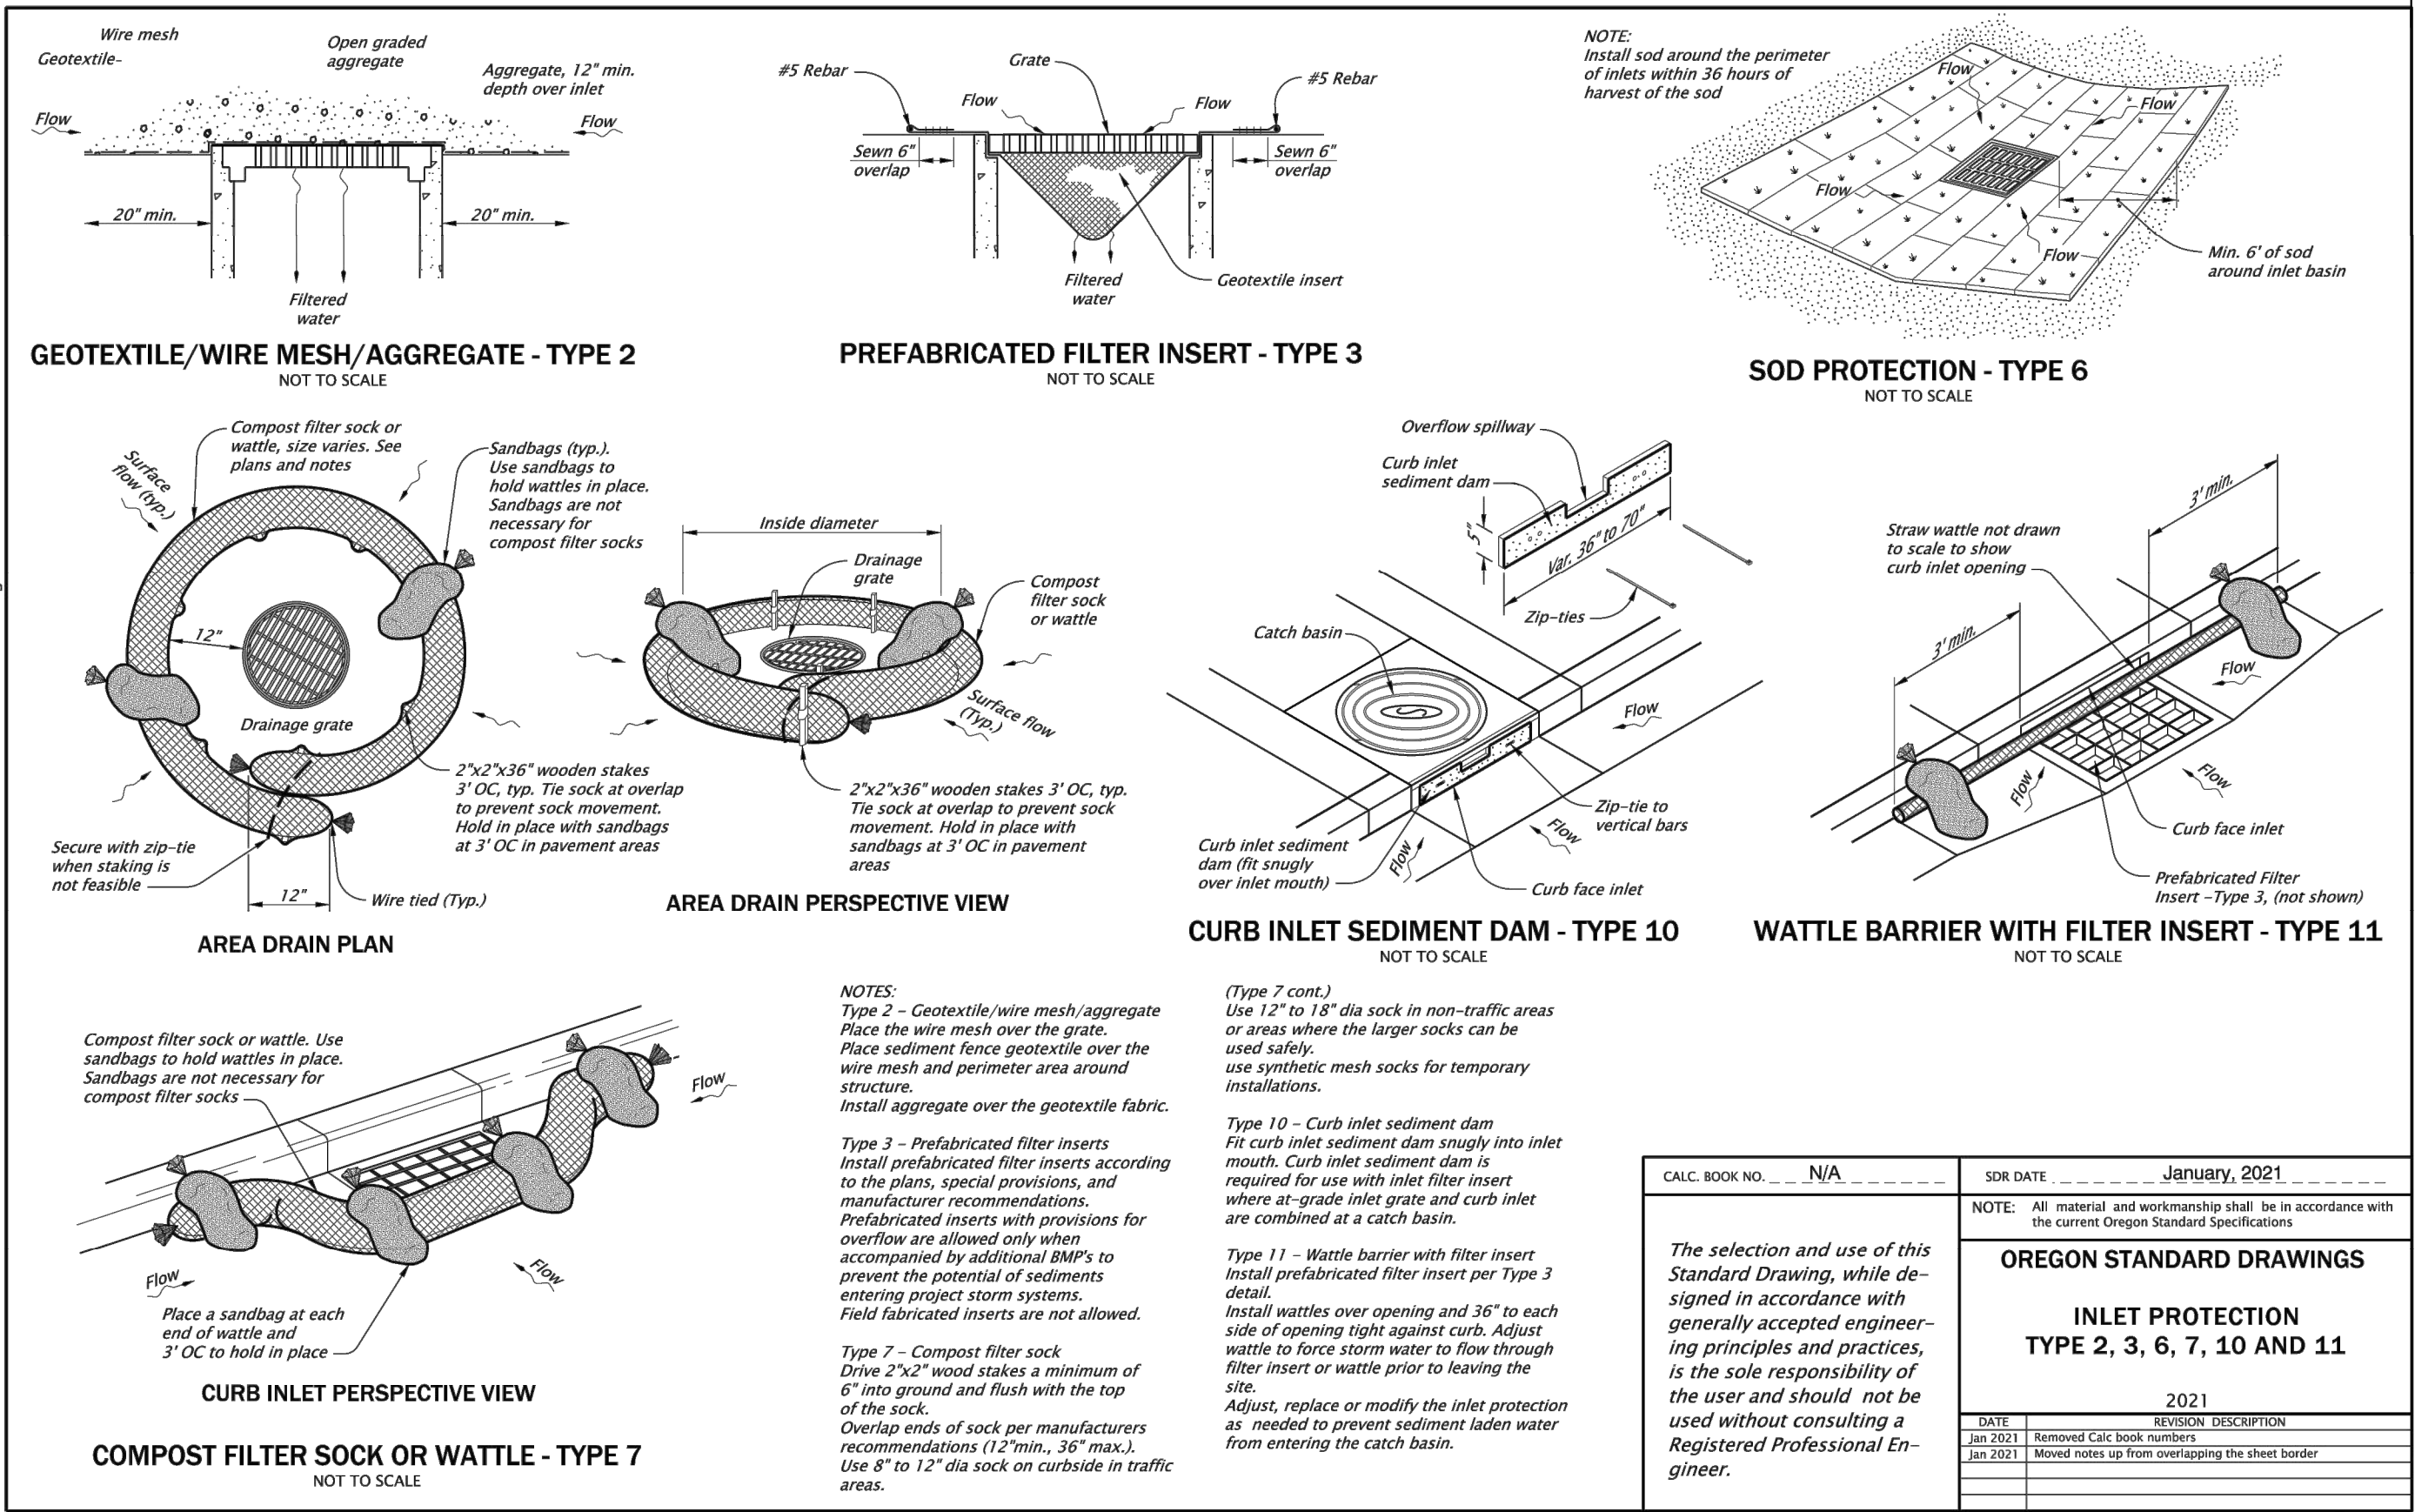

Effective Date: June 1, 2021 - November 30, 2021

RD1010

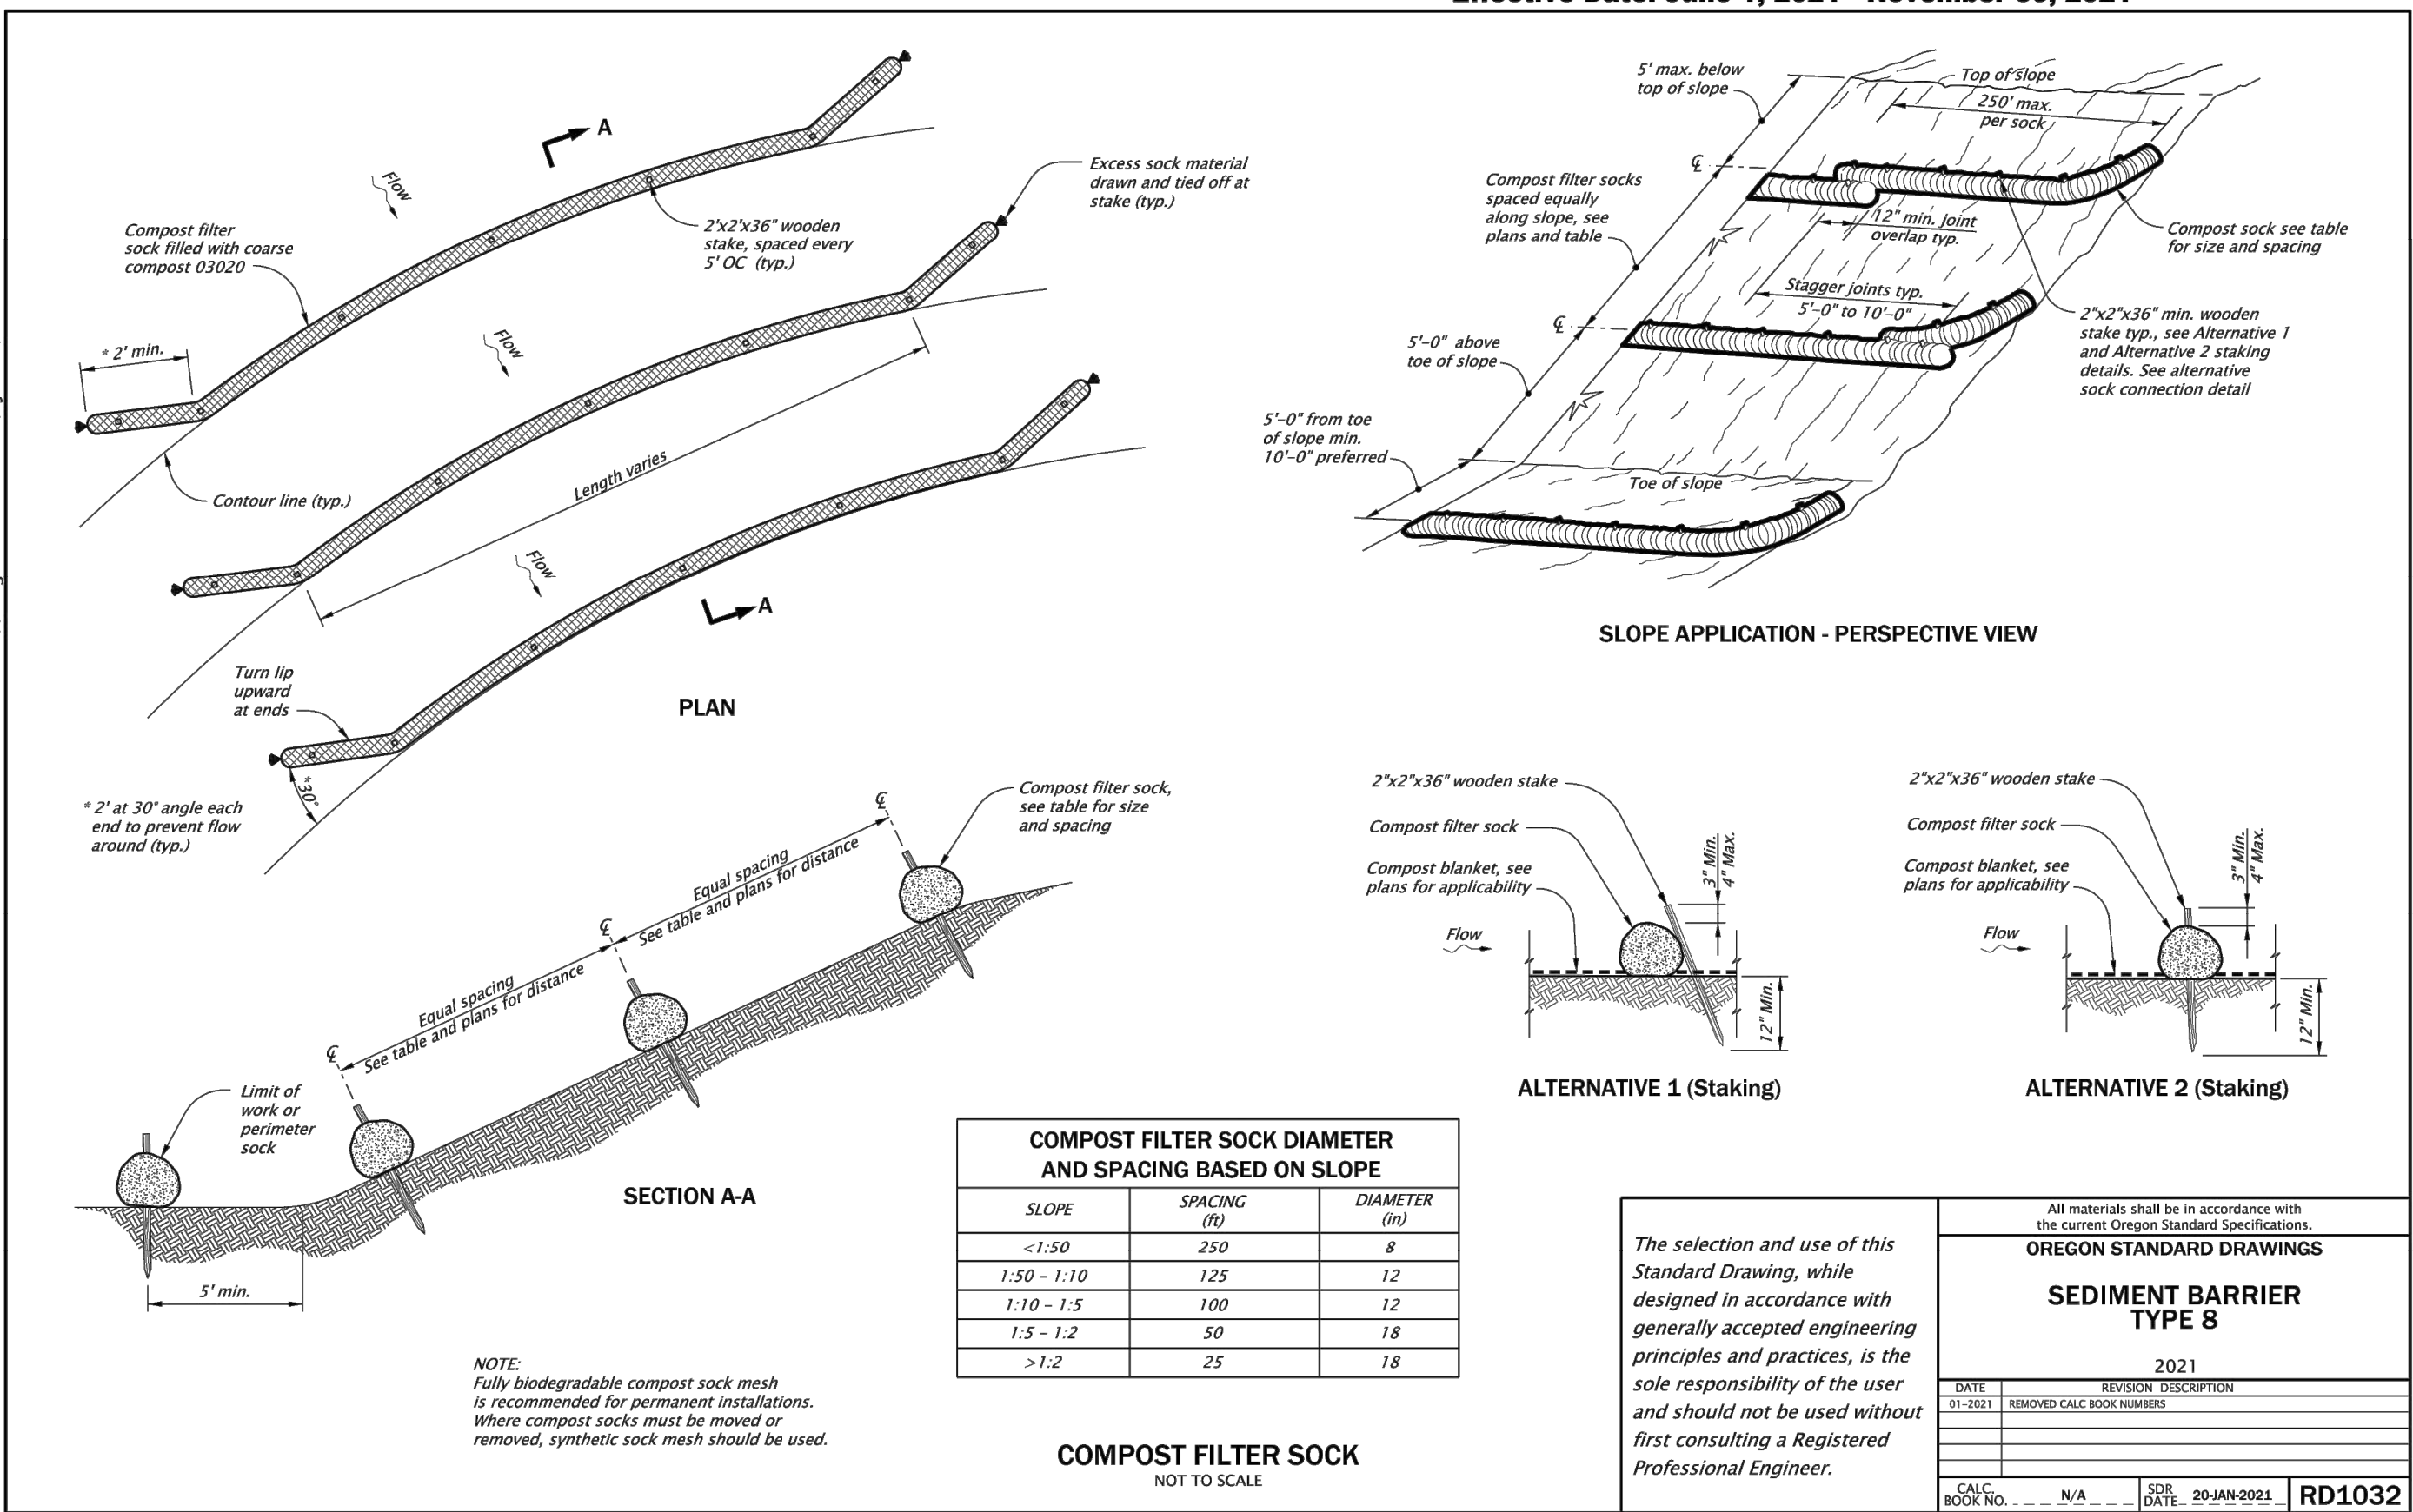


Effective Date: June 1, 2023 - November 30, 2023



RD1032

BID PLAN SET - ADDENDUM #4

PLOT DATE: 8/22/2023 4:37 PM - FILE: C:\Users\Thad\OneDrive - Windsor Engineers\Documents\Projects\2020\20198.3 Cannon Beach Seismic Valves\02_Drawings\01_Working\04_Final Sheets\20198.3 Traffic.cwg

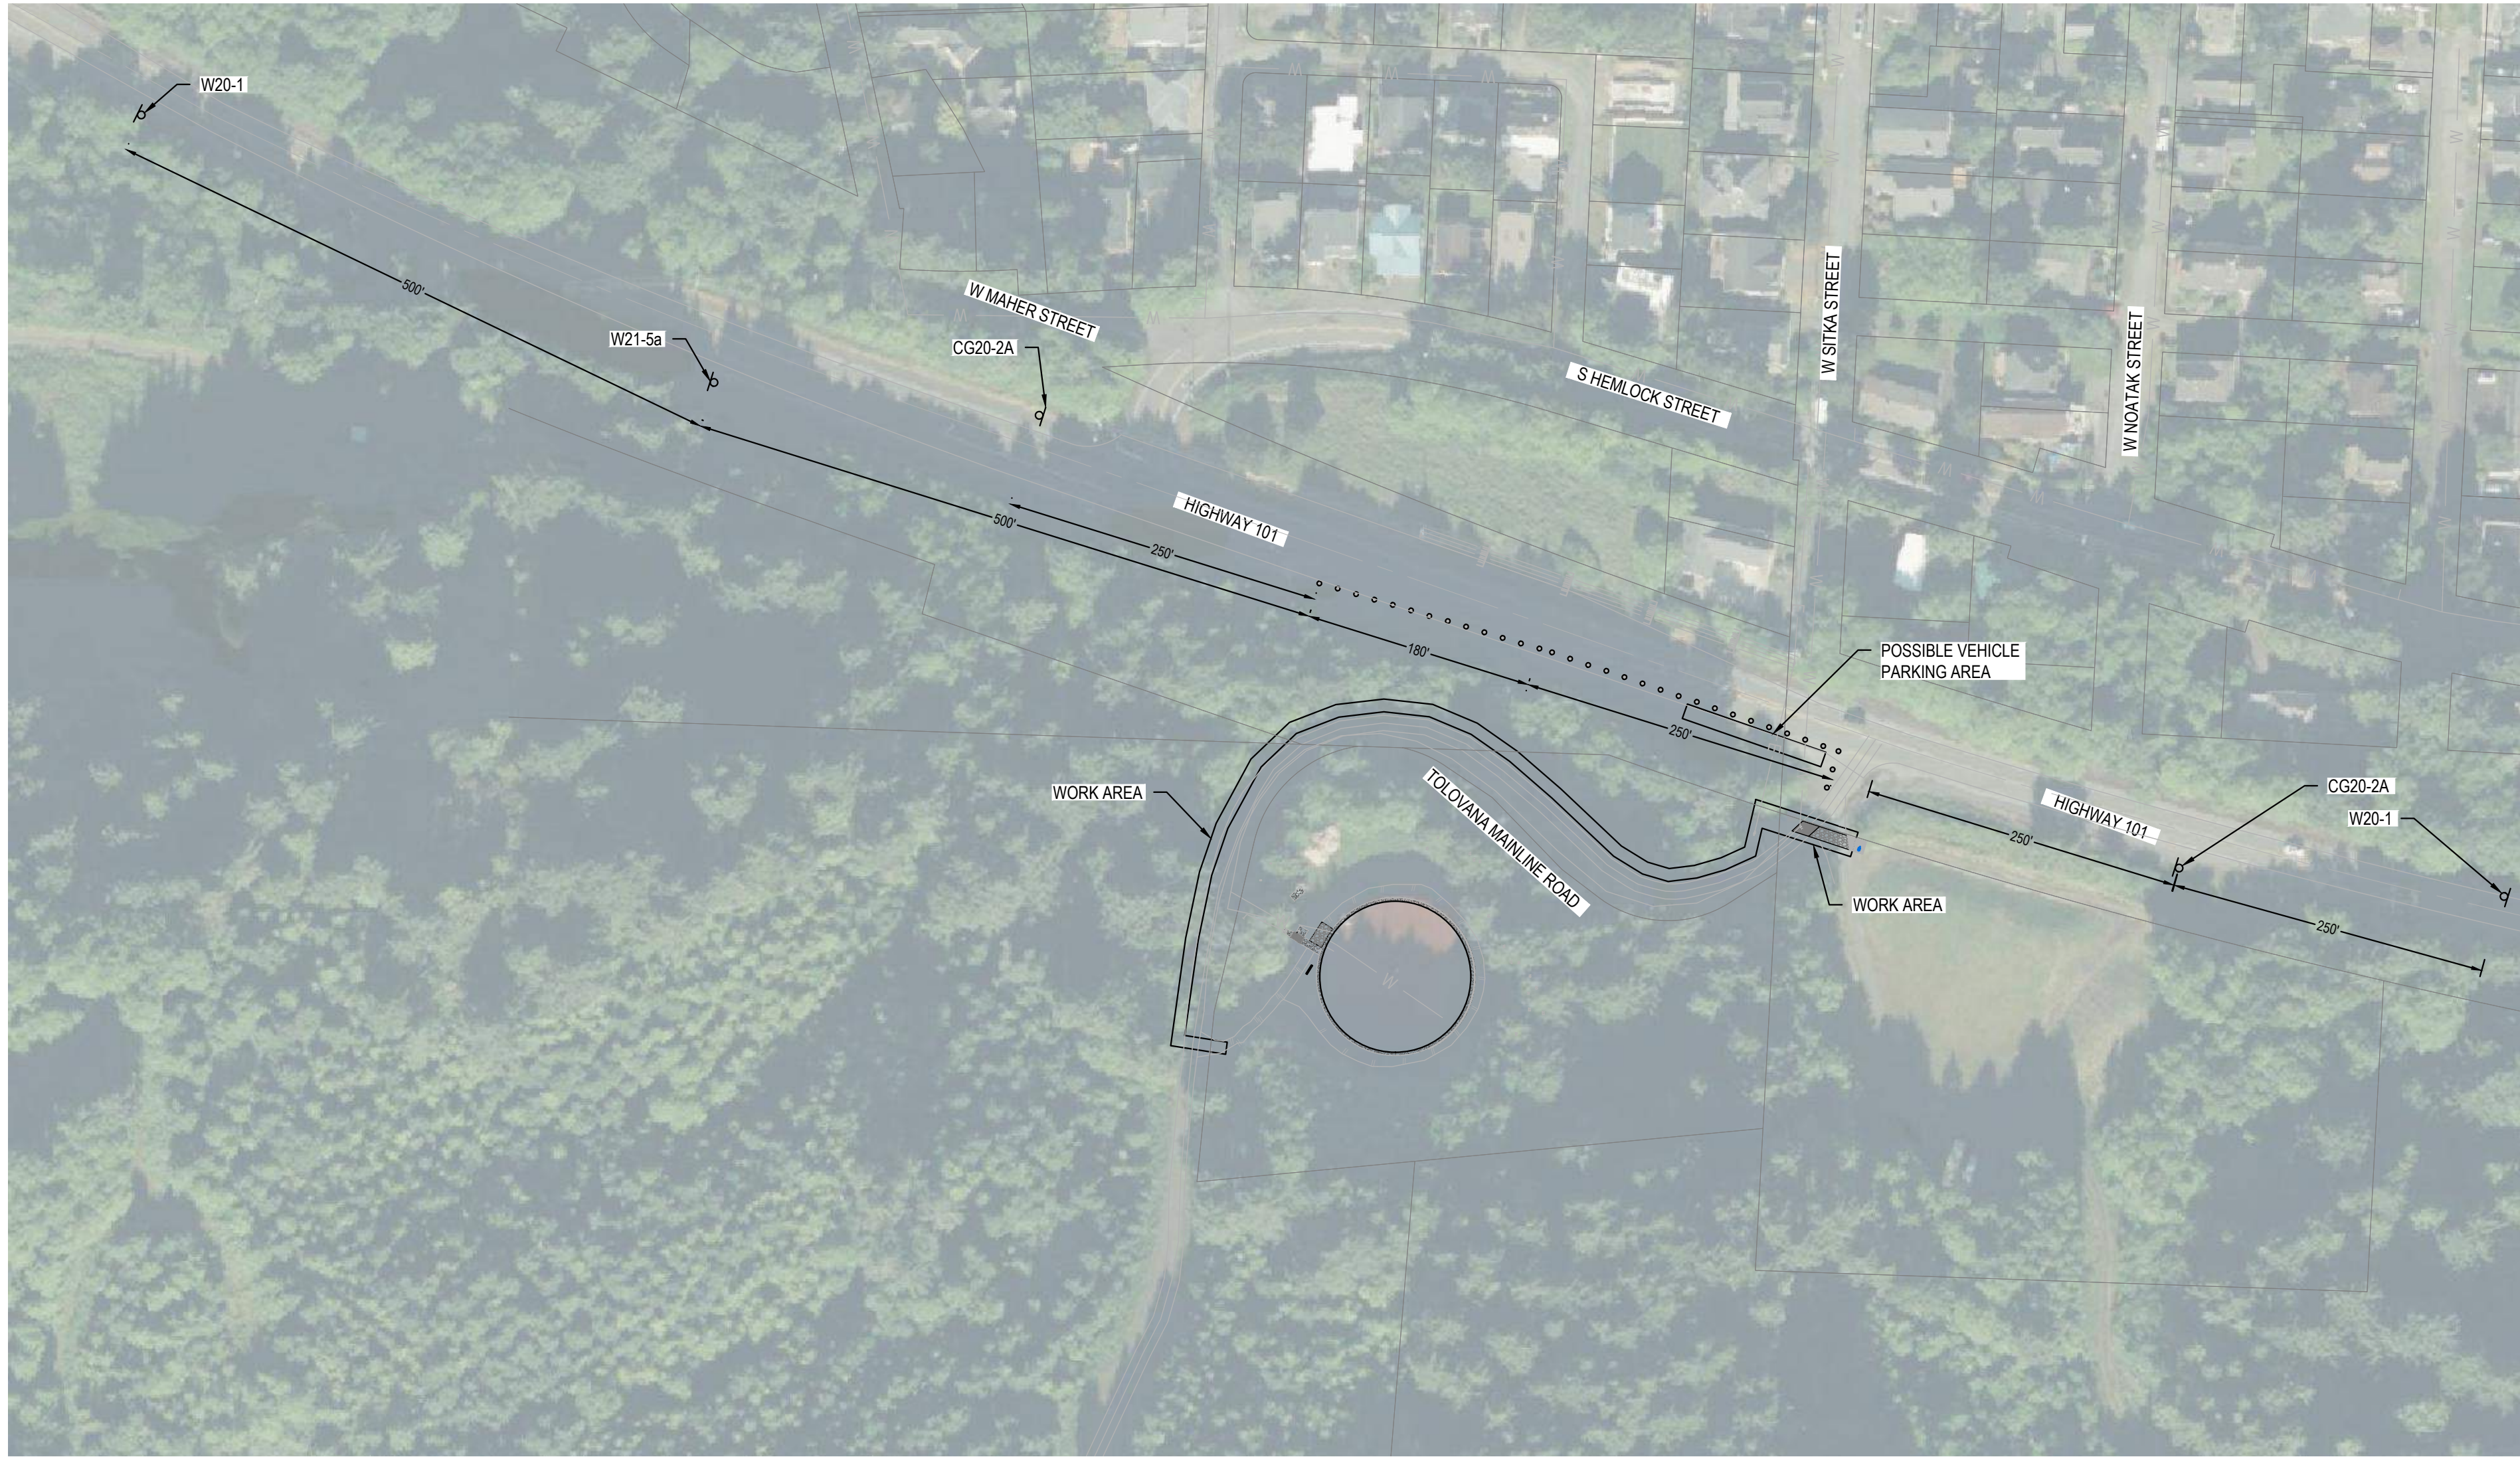

PLAN
SCALE: 1" = 100'

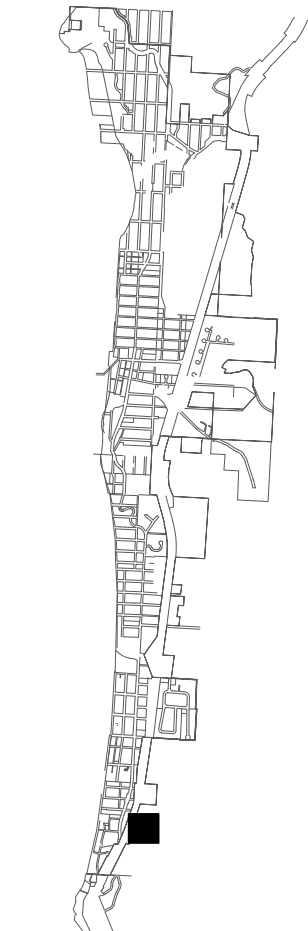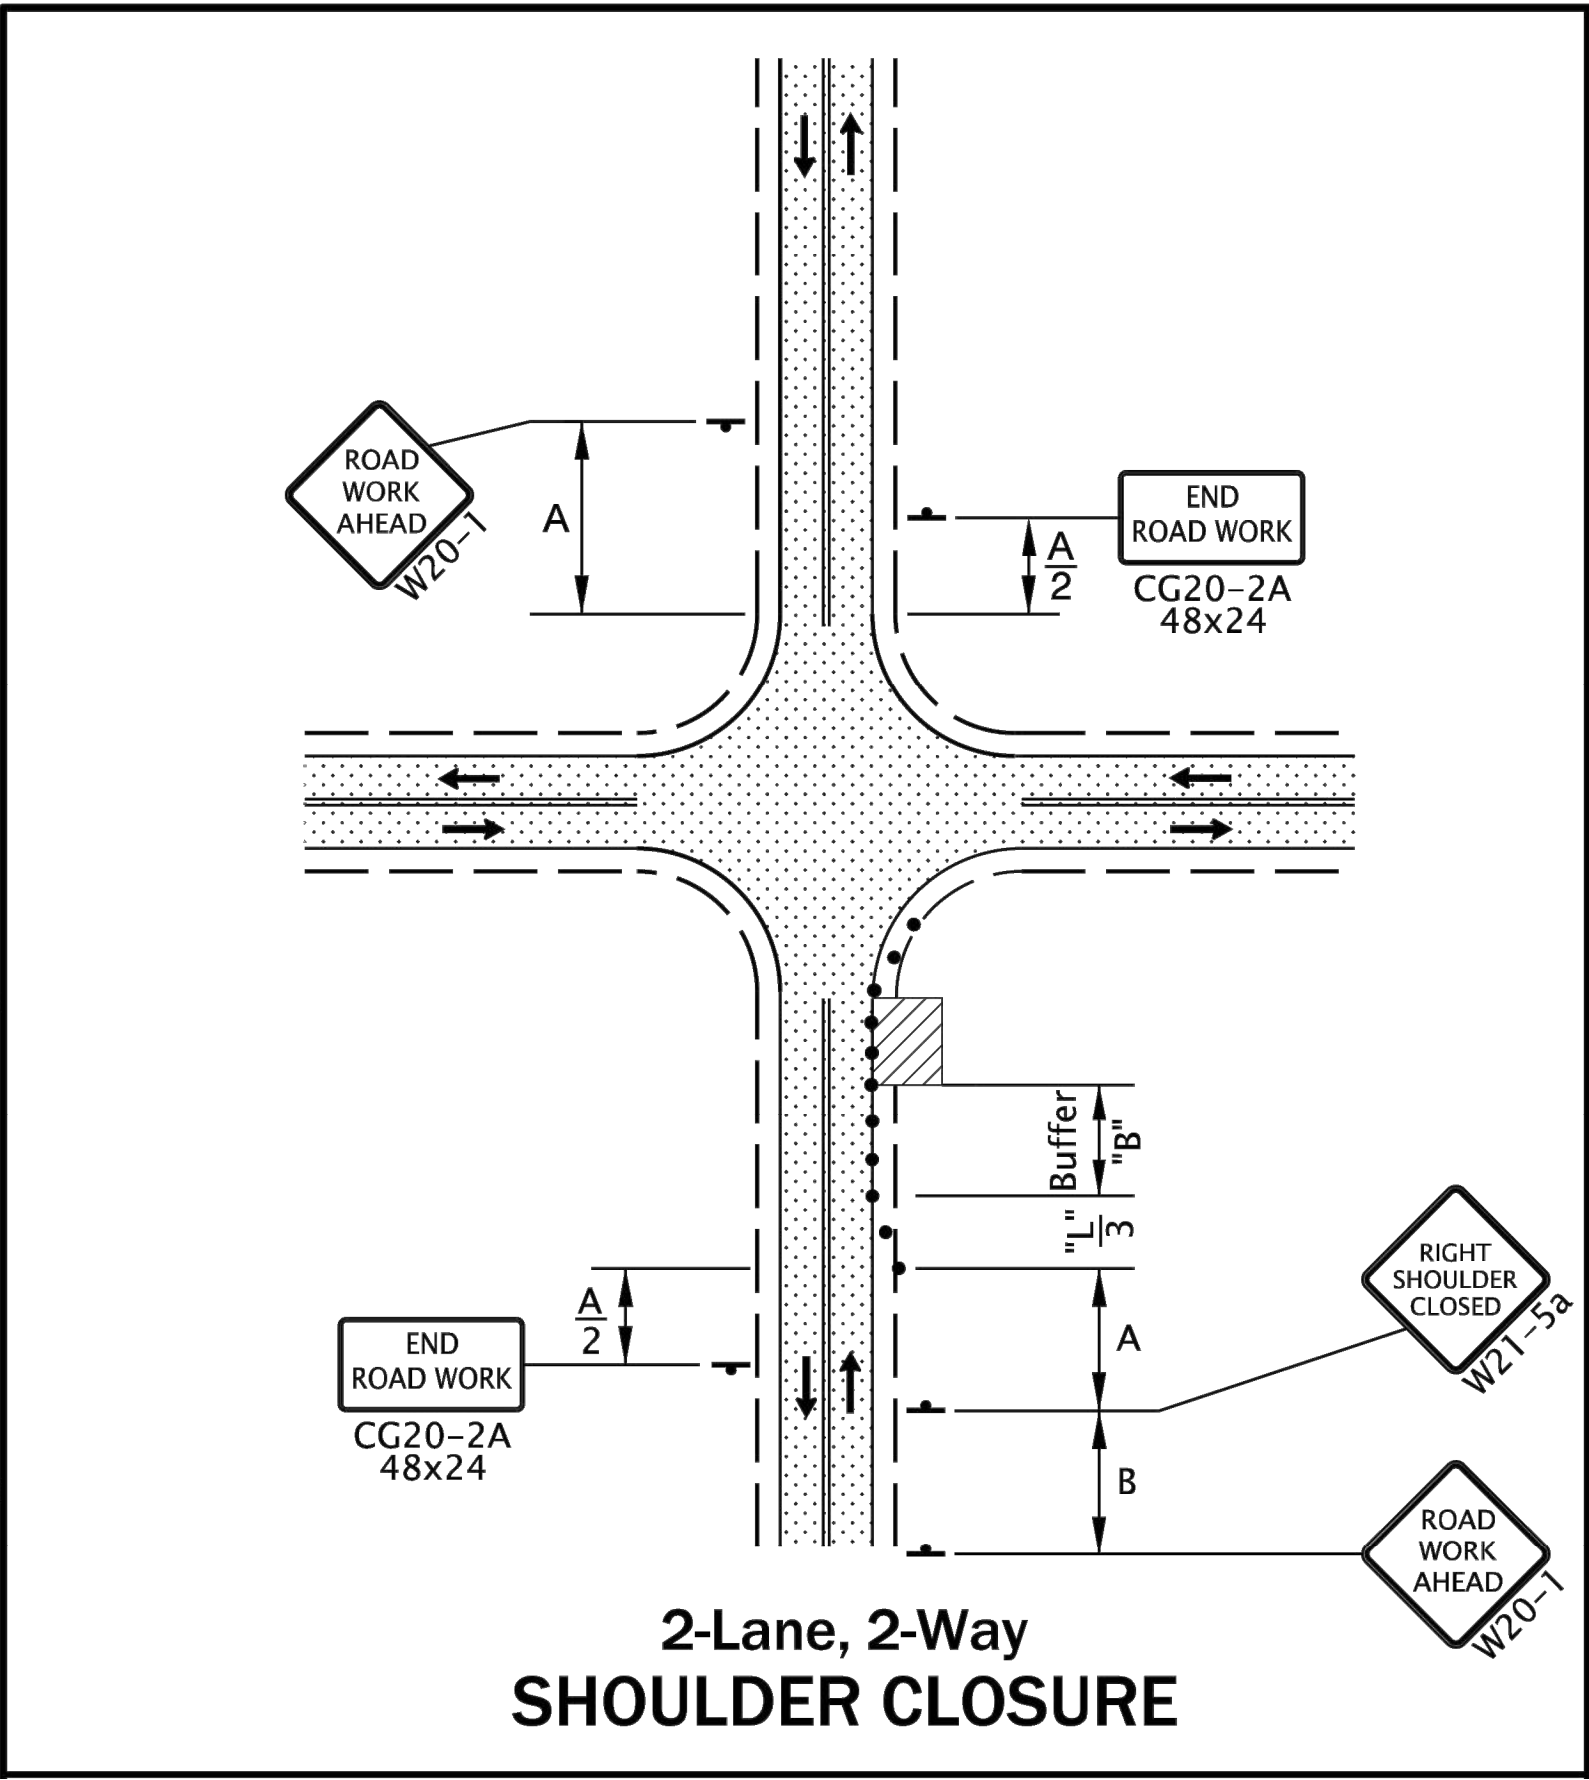


KEY MAP
Scale: NTS

- GENERAL NOTE:
- 1) CONTRACTOR TO FOLLOW ALL REQUIREMENTS IN THE ODOT WORK ZONE TRAFFIC CONTROL GUIDELINES FOR MAINTENANCE OPERATIONS IN THE ODOT TRAFFIC CONTROL PLANS DESIGN MANUAL.
 - 2) USE 3.5.1 20-MINUTE STOP OR HOLD ONLY WHEN CONSTRUCTION EQUIPMENT NEEDS TO BLOCK TRAFFIC TO TIE ROAD MATERIAL INTO EXISTING STREETS. THIS WILL BE CONSIDERED A TRAFFIC HOLD AND SHALL NOT LAST LONGER THEN 20 MINUTES.
 - 3) ROADWAY DROP OFF GREATER THEN 2" ONLY ALLOWED FOR SHORT DURATION AND SHALL BE FILLED TO MEET TM800 AS SOON AS POSSIBLE FOR PUBLIC SAFETY.
 - 4) CHANNELIZING DEVICES AND FLAGGING STATION TO BE REMOVED FROM DRIVE LANES DURING WEEKENDS, AFTER WEEK DAY WORKING HOURS, AND ANY PERIODS OF CONSTRUCTION WHERE NO WORK IS BEING DONE IN CITY, COUNTY, AND STATE.
 - 5) SEE SHEETS C292 -C294 FOR TRAFFIC DETAILS.
 - 6) HIGHWAY 101 SPEED LIMIT = 55 MPH.



CALL 2 BUSINESS DAYS BEFORE YOU DIG.
CAUTION UTILITY INFORMATION IS APPROXIMATE.
VERIFY ALL UTILITIES PRIOR TO CONSTRUCTION.

Revisions:

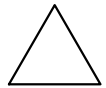

1	8/24/2023	ADDENDUM #1
4	8/28/2023	ADDENDUM #4

LINE IS 1" ON FULL
SCALE DRAWING



WINDSOR ENGINEERS

Ridgefield, WA
Duluth + Minneapolis, MN
www.windsorengineers.com
Project No: 20198.3

Copyright 2023 By Windsor Engineers, LLC
All Rights Reserved.



EXPIRES: 06-30-24

WATER RESILIENCY PROJECT
PHASE 1 - SEISMIC IMPROVEMENTS
CITY OF CANNON BEACH, OR 97110

ENGINEERING PLAN
Issue Date: 8/22/2023

Project Manager TWT
Drawn by TJM
Checked by MRL

TRAFFIC CONTROL - TOLOVANA RESERVOIR

C290

PLOT DATE: 8/22/2023 4:37 PM - FILE: C:\Users\TJML\OneDrive - Windsor Engineers\G:\Projects\2020\20198-3 Cannon Beach Seismic Valves\02 Drawings\01 Working\04_Final Streets\20198-3_traffic.dwg



Know what's below.
Call before you dig.
CALL 2 BUSINESS DAYS BEFORE YOU DIG.
CAUTION: UTILITY INFORMATION IS APPROXIMATE.
VERIFY ALL UTILITIES PRIOR TO CONSTRUCTION.

Revisions:

NO.	DATE	DESCRIPTION
1	8/24/2023	ADDENDUM #1
4	8/28/2023	ADDENDUM #4

LINE IS 1" ON FULL
SCALE DRAWING



WINDSOR ENGINEERS

Ridgefield, WA
Duluth + Minneapolis, MN
www.windsorengineers.com
Project No: 20198.3

Copyright 2023 By Windsor Engineers, LLC
All Rights Reserved.



EXPIRES: 06-30-24

WATER RESILIENCY PROJECT
PHASE 1 - SEISMIC IMPROVEMENTS
CITY OF CANNON BEACH, OR 97110

ENGINEERING PLAN

Issue Date: 8/22/2023

Project Manager: TWT
Drawn by: TJML
Checked by: MRL



TRAFFIC CONTROL - ISOLATION VALVE 4

C291



KEY MAP

Scale: NTS

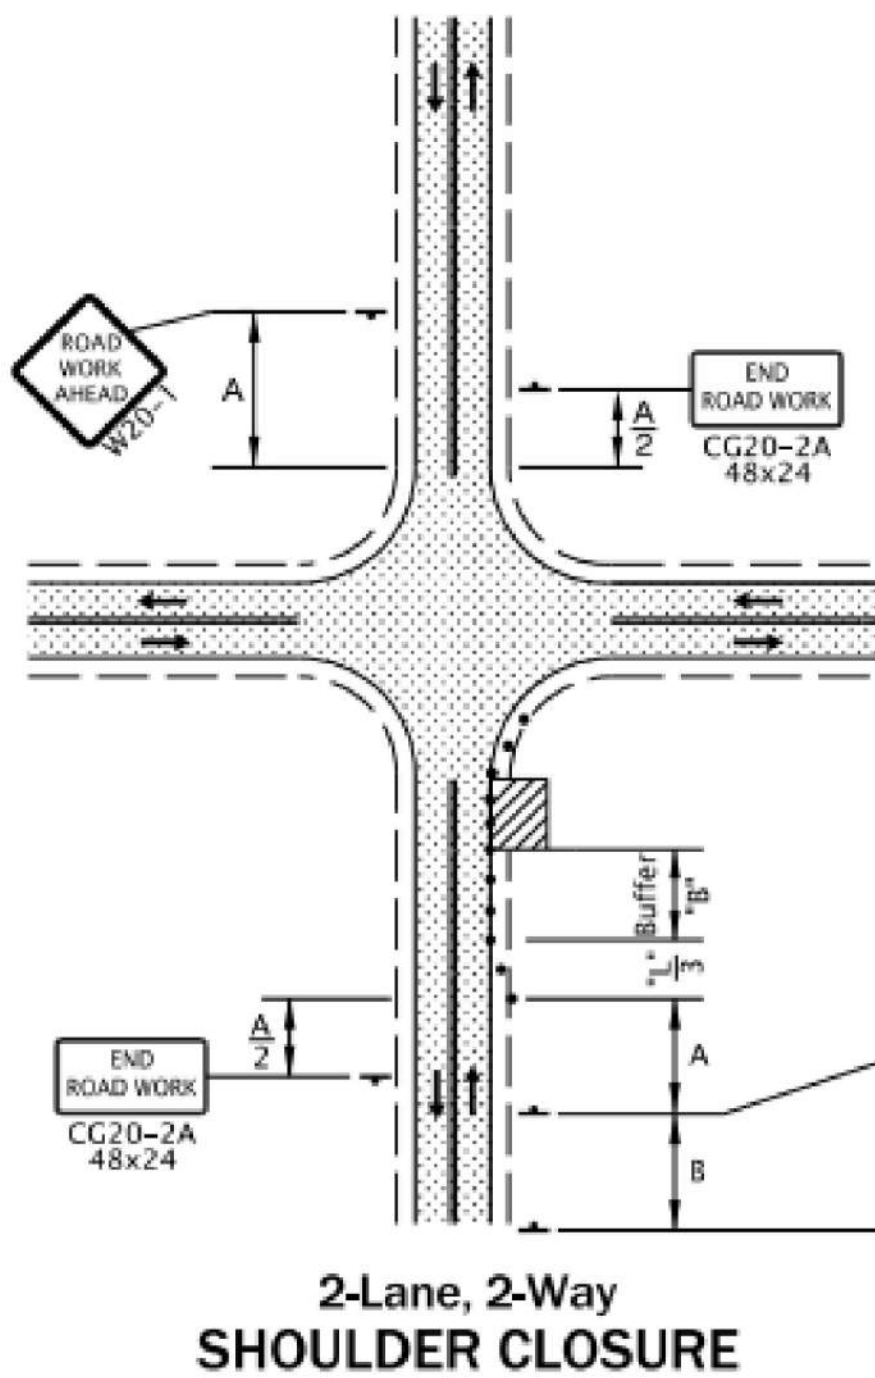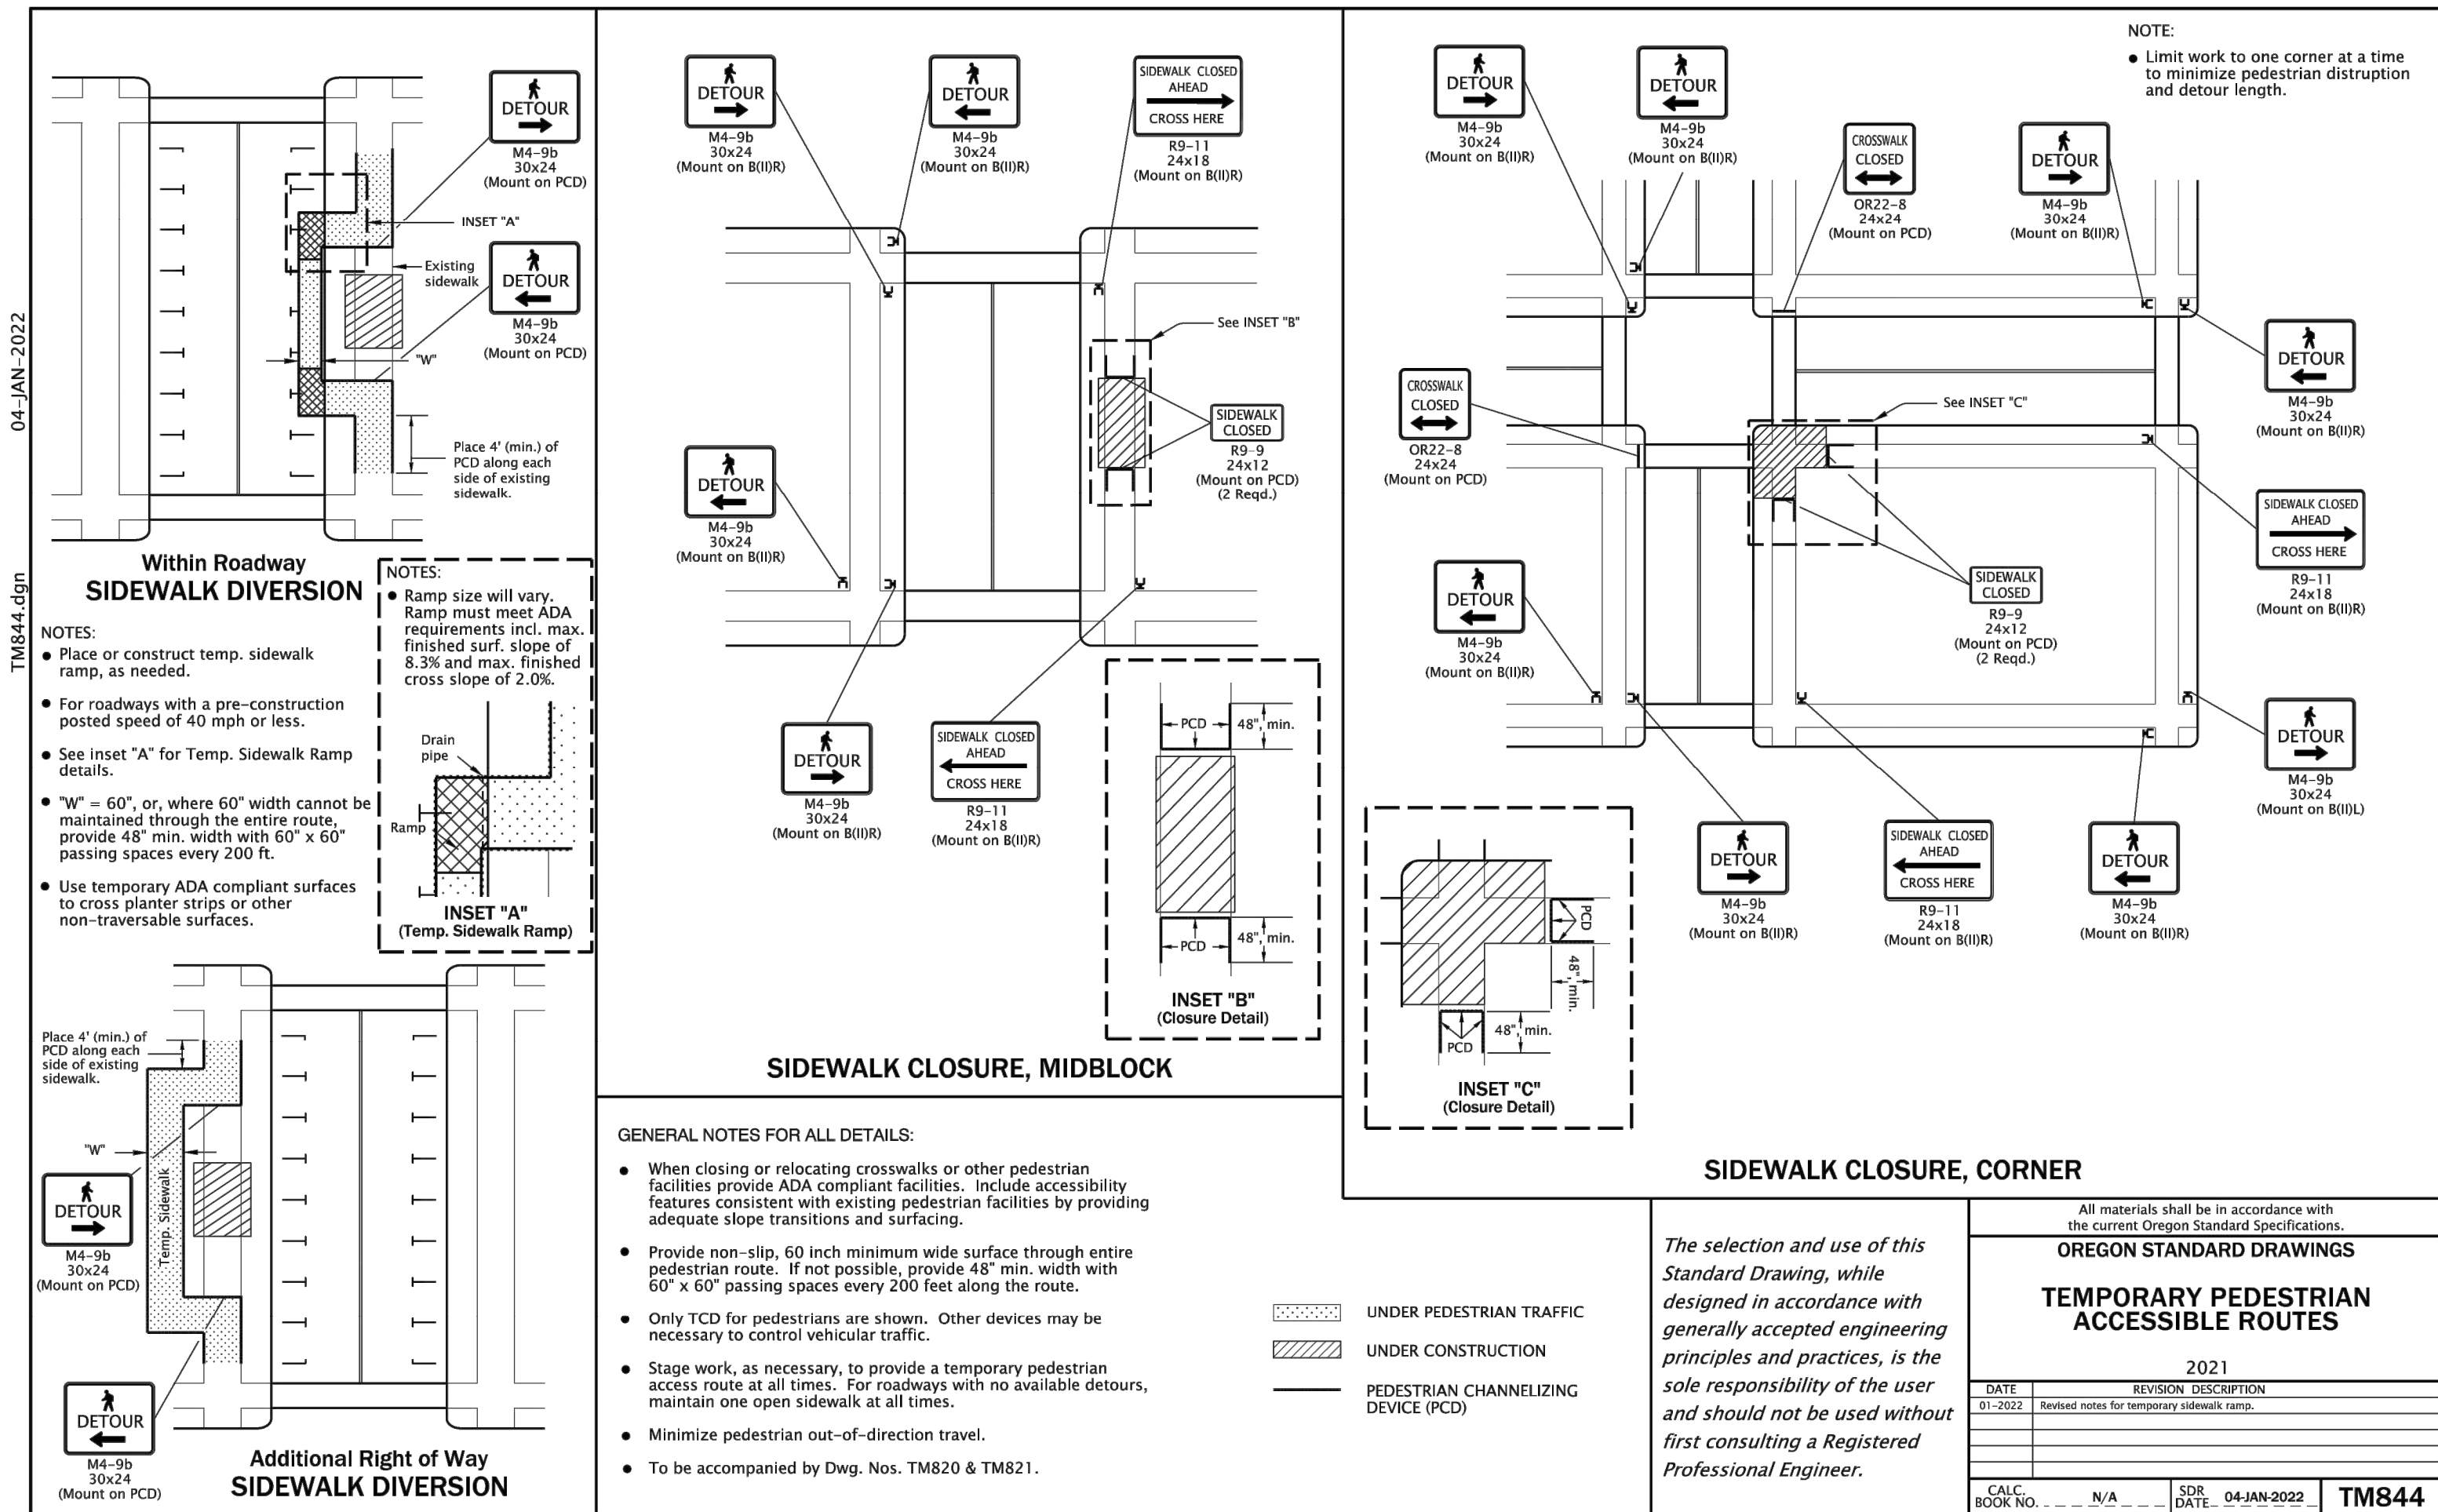

2-Lane, 2-Way
SHOULDER CLOSURE

GENERAL NOTE:

- CONTRACTOR TO FOLLOW ALL REQUIREMENTS IN THE ODOT WORK ZONE TRAFFIC CONTROL GUIDELINES FOR MAINTENANCE OPERATIONS IN THE ODOT TRAFFIC CONTROL PLANS DESIGN MANUAL.
- USE 3.5.1 20-MINUTE STOP OR HOLD ONLY WHEN CONSTRUCTION EQUIPMENT NEEDS TO BLOCK TRAFFIC TO TIE ROAD MATERIAL INTO EXISTING STREETS. THIS WILL BE CONSIDERED A TRAFFIC HOLD AND SHALL NOT LAST LONGER THEN 20 MINUTES.
- ROADWAY DROP OFF GREATER THEN 2" ONLY ALLOWED FOR SHORT DURATION AND SHALL BE FILLED TO MEET TM800 AS SOON AS POSSIBLE FOR PUBLIC SAFETY.
- CHANNELIZING DEVICES AND FLAGGING STATION TO BE REMOVED FROM DRIVE LANES DURING WEEKENDS, AFTER WEEK DAY WORKING HOURS, AND ANY PERIODS OF CONSTRUCTION WHERE NO WORK IS BEING DONE IN CITY, COUNTY, AND STATE.
- SEE SHEETS C292 -C294 FOR TRAFFIC DETAILS.
- STREET SPEED LIMIT = 30 MPH.

811

Know what's below.
Call before you dig.

CALL 2 BUSINESS DAYS BEFORE YOU DIG.

CAUTION! UTILITY INFORMATION IS APPROXIMATE.

VERIFY ALL UTILITIES PRIOR TO CONSTRUCTION.

Revisions:

1	8/24/2023	ADDENDUM #1
4	8/28/2023	ADDENDUM #4

LINE IS 1" ON FULL
SCALE DRAWING

WINDSOR ENGINEERS

Ridgefield, WA

Duluth + Minneapolis, MN

www.windsorengineers.com

Project No: 20198.3

Copyright 2023 By Windsor Engineers, LLC

All Rights Reserved.

WATER RESILIENCY PROJECT
PHASE 1 - SEISMIC IMPROVEMENTS
CITY OF CANNON BEACH, OR 97110

ENGINEERING PLAN
Issue Date: 8/22/2023

TRAFFIC CONTROL DETAILS

Project Manager: TWT
Drawn by: TJM
Checked by: MRL

C292

TAPER TYPES & FORMULAS

TAPER	FORMULA
Merging (Lane Closure)	"L"
Shifting	"L"/2 or 1/2"L"
Shoulder Closure	"L"/3 or 1/3"L"
Flagging (See Drg. TM850)	50' - 100'
Downstream (Termination)	Varies (See Drawings)

★ Use Pre-Construction Posted Speed to select the Speed from the Tables below:

TEMPORARY BARRIER FLARE RATE TABLE

★ SPEED (mph)	MINIMUM FLARE RATE
≤ 30	8:1
35	9:1
40	10:1
45	12:1
50	14:1
55	16:1
60	18:1
65	19:1
70	20:1

MINIMUM LENGTHS TABLE

"L" VALUE FOR TAPERS (ft)					BUFFER "B" (ft)
★ SPEED (mph)	W ≤ 10	W = 12	W = 14	W = 16	
25	105	125	145	165	75
30	150	180	210	240	100
35	205	245	285	325	125
40	265	320	375	430	150
45	450	540	630	720	180
50	500	600	700	800	210
55	550	660	770	880	250
60	600	720	840	960	285
65	650	780	910	1000	325
70	700	840	980	1000	365

TRAFFIC CONTROL DEVICES (TCD) SPACING TABLE

★ SPEED (mph)	Sign Spacing (ft)			Max. Channelizing Device Spacing (ft)
	A	B	C	
20 - 30	100	100	100	20
35 - 40	350	350	350	20
45 - 55	500	500	500	40
60 - 70	700	700	700	40
Freeway	1000	1500	2640	40

NOTES:

- For Lane closures where W < 10', use "L" value for W = 10'.
- For Shoulder closures where W < 10', use "L" value for W = 10' or calculate "L" using formula, for Speeds > 45: L = WS, Speeds < 45: L = S^2/W(60), S = Speed, W=Width

EXCAVATION ABRUPT EDGE

Extg. pavement

Shoulder or aggregate base rock

PORTABLE CHANGEABLE MESSAGE SIGN (PCMS) INSTALLATION

Portable changeable message sign (PCMS)

4' B(I)LR

Temp. Plastic Drums

28" Tubular Markers

FLAGGER STATION LIGHTING DELINEATION

Flagger Station Lighting

24" min.

28" Tubular Markers

GENERAL NOTES FOR ALL TCP DRAWINGS:

- Signs and other Traffic Control Devices (TCD) shown are the minimum required.
- Place a barricade approx. 20' ahead of all sequential arrow boards.
- Arrows shown in roadway are directional arrows to indicate traffic movements.
- All signs are 48" x 48" unless otherwise shown. Use fluorescent orange sheeting for the background of all temporary warning signs.
- All diamond shaped warning signs mounted on barrier sign supports shall be 36" by 36". All other signs mounted on barrier sign supports shall not exceed 12 sq. ft. in total sign area.
- Low speed highways have a pre-construction posted speed of 40 mph or less. High speed highways have a pre-construction posted speed of 45 mph or higher.
- Do not locate sign supports in locations designated for bicycle or pedestrian traffic.
- Combine drawing details to complete temporary traffic control for each work activity.
- Coordinate and control pedestrian movements through a Temporary Accessible Route using Flaggers, Traffic Control Measures, or as directed.
- To be accompanied by Dwg. Nos. TM820 & TM821.

The selection and use of this Standard Drawing, while designed in accordance with generally accepted engineering principles and practices, is the sole responsibility of the user and should not be used without first consulting a Registered Professional Engineer.

OREGON STANDARD DRAWINGS

TABLES, ABRUPT EDGE AND PCMS DETAILS

2021

DATE: 07-2022 REVISION: Added a note for TSS.

CALC. BOOK NO. N/A SDR DATE: 04-JUL-2020

TM800

BARRICADE RAIL LAYOUT

TYPE I

TYPE II

TYPE III

DIAGRAM FOR BARRICADE PLACEMENT AND SLOPE MARKING

LT, SIDE - L (For approaching traffic)

RT, SIDE - R (For approaching traffic)

CLOSED - C (For approaching traffic)

LT, / RT, - LR (For approaching traffic)

GENERAL NOTES FOR ALL DETAILS:

- Sandbags (approximately 25 lb sack filled with sand) may be placed on lower frame to provide additional ballast.
- Ballast shall not extend above bottom rail or be suspended from barricade.
- For rails less than 36" long, 4" wide stripes shall be used.
- Rails must be 8" min. to 12" max. in height.
- Use barricades from ODOT Qualified Products List (QPL).
- Use 4' Type III barricades where horizontal space is limited.
- Do not block bike lanes or shoulders unless the facility is properly closed and signed.
- Do not place barricades in sidewalks unless sidewalk is closed and a temporary pedestrian accessible route (TPAR) is signed according to the TCP. See Dwg. No. TM844.

BARRICADE NOTATION

All materials shall be in accordance with the current Oregon Standard Specifications.

OREGON STANDARD DRAWINGS

TEMPORARY BARRICADES

2021

DATE: REVISION: DESCRIPTION:

CALC. BOOK NO. N/A SDR DATE: 04-JUL-2020

TM820

DOUBLE POST DETAIL

48" x 48" sign (typ.)

3/4" x 5 1/2" x 37" post

2" x 3" lag screws per support (typ.)

PERFORATED STEEL SQUARE TUBE (PSST) DETAIL

48" x 48" sign (typ.)

2 1/2" x 12 ga. PSST

2" x 4" x 4" PSST stub

SINGLE POST DETAIL

36" x 36" sign (typ.)

2 1/2" x 12 ga. PSST

2" x 4" x 4" PSST stub

TEMPORARY SIGN SUPPORT GENERAL NOTES:

- Do not tip over TSS at any time.
- Do not locate TSS's in locations that block pedestrian or bicycle traffic.
- For wooden TSS's, use either Douglas Fir or Hem Fir, which is surfaced four sides (S4S) and free of heart center (FOHC).
- See "Temporary Sign Placement" detail on TM822 for sign installation heights.
- Do not place or stack ballast more than 24" above the ground.
- When sign is inconsistent with current work zone conditions, cover sign; or turn sign 90 degrees away from approaching traffic. Remove TSS from roadway when signing is not needed for more than 3 days.
- Place a minimum of 50 lbs of sandbags on each of the four TSS supports legs. (25 lb. max per bag) (min. 100 lbs per side of each TSS).
- See Dwg. No. TM204 for flag board mounting detail.

The selection and use of this Standard Drawing, while designed in accordance with generally accepted engineering principles and practices, is the sole responsibility of the user and should not be used without first consulting a Registered Professional Engineer.

OREGON STANDARD DRAWINGS

TEMPORARY SIGN SUPPORTS

2021

DATE: REVISION: DESCRIPTION:

CALC. BOOK NO. N/A SDR DATE: 04-JUL-2020

TM821

TEMPORARY SIGN PLACEMENT

Urban Areas With Curb/Sidewalk

Rural Areas

Divided Highway/Freeway Medians No Curb/Sidewalk

Rural or Urban Areas - Curb or No Curb Bicycles On Shoulder

CONCRETE BARRIER SIGN SUPPORT

36" x 36" sign (typ.)

2" Sch. 40 pipe

2 1/2" Sch. 40 pipe

TEMPORARY SIGN REFLECTIVE SHEETING PLACEMENT

Double Post

Perforated Steel Square Tube (PSST)

Single Post

TEMPORARY SIGN REFLECTIVE SHEETING PLACEMENT

Double Post

Perforated Steel Square Tube (PSST)

Single Post

TEMPORARY SIGN REFLECTIVE SHEETING PL



Know what's below.
Call before you dig.
CALL 2 BUSINESS DAYS BEFORE YOU DIG.
CAUTION UTILITY INFORMATION IS APPROXIMATE.
VERIFY ALL UTILITIES PRIOR TO CONSTRUCTION.

Revisions:		
1	8/24/2023	ADDENDUM #1
4	8/28/2023	ADDENDUM #4

LINE IS 1" ON FULL
SCALE DRAWING



WINDSOR ENGINEERS

Ridgefield, WA
Duluth + Minneapolis, MN
www.windsorengineers.com
Project No: 20198.3

Copyright 2023 By Windsor Engineers, LLC
All Rights Reserved.

WATER RESILIENCY PROJECT PHASE 1 - SEISMIC IMPROVEMENTS CITY OF CANNON BEACH, OR 97110

ENGINEERING PLAN
Issue Date: 8/22/2023

Project Manager: TWT
Drawn by: TJM
Checked by: MRL

C293

TRAFFIC CONTROL DETAILS

NOTES: <ul style="list-style-type: none">DO NOT USE ON BRIDGE DECKS. Restrain barrier on bridge decks according to Bridge Design Manual. See Chapter 1.13.1.10Predrill pin holes for PCC pavement placement.Excavation height greater than 3 feet requires proper backslope based on angle of repose, or shoring as directed.Place temporary barrier on smooth, solid surfacing. Maintain, smooth solid surfacing for clear area behind temporary barrier.		
NOTES: <ul style="list-style-type: none">CPPR and inlay existing rumble strips prior to staging traffic across the area. Common application is staging for freeway crossovers and lane shifts.Remove and replace existing striping as required.		
Effective Date: June 1, 2023 – November 30, 2023		

NOTES: <ul style="list-style-type: none">DO NOT USE ON BRIDGE DECKS. Restrain barrier on bridge decks according to Bridge Design Manual. See Chapter 1.13.1.10Predrill pin holes for PCC pavement placement.Excavation height greater than 3 feet requires proper backslope based on angle of repose, or shoring as directed.Place temporary barrier on smooth, solid surfacing. Maintain, smooth solid surfacing for clear area behind temporary barrier.		
NOTES: <ul style="list-style-type: none">CPPR and inlay existing rumble strips prior to staging traffic across the area. Common application is staging for freeway crossovers and lane shifts.Remove and replace existing striping as required.		
Effective Date: June 1, 2023 – November 30, 2023		

NOTES: <ul style="list-style-type: none">When work is in place for 14 consecutive days or more, place temporary lane direction legends in mandatory turn lanes, as shown or directed.		
NOTES: <ul style="list-style-type: none">When work is in place for 14 consecutive days or more, place temporary lane direction legends in mandatory turn lanes, as shown or directed.		
Effective Date: June 1, 2023 – November 30, 2023		

NOTES: <ul style="list-style-type: none">Place or construct temp. sidewalk ramp, as needed.For roadways with a pre-construction posted speed of 40 mph or less.See inset "A" for Temp. Sidewalk Ramp details."W" - 60", or, where 60" width cannot be maintained through the entire route, provide 48" min. width with 60" x 60" passing spaces every 200 ft.Use temporary ADA compliant surfaces to cross planter strips or other non-traversable surfaces.		
NOTES: <ul style="list-style-type: none">When closing or relocating crosswalks or other pedestrian facilities provide ADA compliant facilities. Include accessibility features consistent with existing pedestrian facilities by providing adequate slope transitions and surfacing.Provide non-slip, 60 inch minimum wide surface through entire pedestrian route. If not possible, provide 48" min. width with 60" x 60" passing spaces every 200 feet along the route.Only TCD for pedestrians are shown. Other devices may be necessary to control vehicular traffic.Stage work, as necessary, to provide a temporary pedestrian access route at all times. For roadways with no available detours, maintain one open sidewalk at all-directions.Minimize pedestrian out-of-direction travel.To be accompanied by Dwg. Nos. TM820 & TM821.		
Effective Date: June 1, 2023 – November 30, 2023		

PLOT DATE: 7/17/2023 5:13 PM - FILE: C:\Users\MARCUSJ\OneDrive - Windsor Engineers\05 Projects\2020\20198-3 Cannon Beach Seismic Valves\02 Drawings\04 Working\04_Final Sheets\20198-3_traffic details.dwg

811

Know what's below.
Call before you dig.

CALL 2 BUSINESS DAYS BEFORE YOU DIG.
CAUTION: UTILITY INFORMATION IS APPROXIMATE.
VERIFY ALL UTILITIES PRIOR TO CONSTRUCTION.

Revisions:

1	8/24/2023	ADDENDUM #1
4	8/28/2023	ADDENDUM #4

LINE IS 1" ON FULL
SCALE DRAWING

WINDSOR ENGINEERS

Ridgefield, WA
Duluth + Minneapolis, MN
www.windsorengineers.com
Project No: 20198.3
Copyright 2023 By Windsor Engineers, LLC
All Rights Reserved.

WATER RESILIENCY PROJECT
PHASE 1 - SEISMIC IMPROVEMENTS
CITY OF CANNON BEACH, OR 97110

ENGINEERING PLAN
Issue Date: 7/14/2023

Project Manager TWT
Drawn by TJM
Checked by MRL


TRAFFIC CONTROL DETAILS

C294

13-JAN-2023
TM855.dgn

NOTES:


- Place Advance Flagger and additional signing when traffic queues extend beyond initial warning signing OR when sight distance is restricted.
- Relocate initial "ROAD WORK AHEAD" (W20-1) sign in advance of additional "BE PREPARED TO STOP" (W3-4) and Flagger Ahead (CW23-2) signs, as shown.
- Place additional Tubular Markers for Flagger and Advance Flagger Stations according to FLAGGER STATION DELINEATION detail.

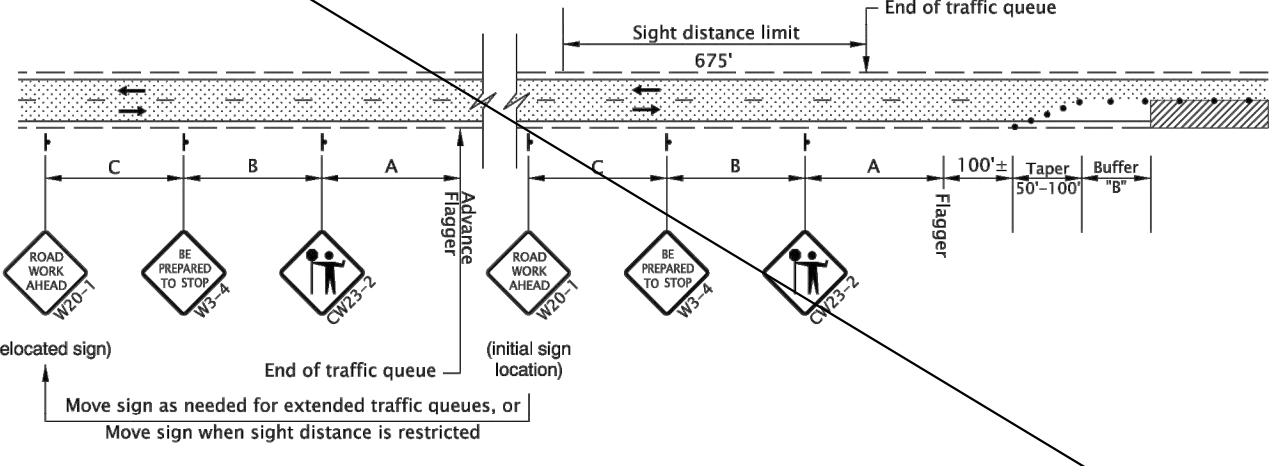

ADVANCE FLAGGER FOR EXTENDED TRAFFIC QUEUES

NOTE:

- When using pilot cars with flaggers to control traffic during paving operations, the Tubular Marker spacing along centerline may be increased to 200' within the Activity Area, as shown or as directed.
- Include "WAIT FOR FLAGGER" (CR4-23) signs mounted on Type II Barricade located approx. 50' before each Flagger.
- Coordinate and control pedestrians movements through the TPAR using Flaggers, other TCM, or as directed. When the existing shoulder is greater than or equal to 4' wide, provide a minimum of 4' of width for the TPAR.

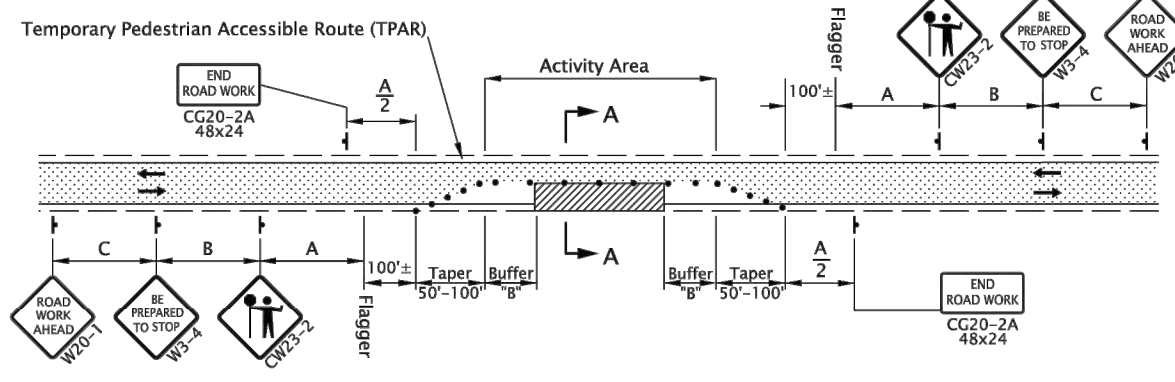

2-Lane, 2-Way Roadway
ONE LANE CLOSURE

GENERAL NOTES FOR ALL DETAILS:

- This drawing is only intended to be used where an Automated Flagger Assistance Device (AFAD) cannot be utilized.
- The "FLAGGER" (CW23-2) symbol sign shall be used only in conjunction with the "BE PREPARED TO STOP" (W3-4) sign.
- Cover existing passing zone signing, as directed.
- Install temporary striping as required.
- To determine Taper Length ("L") and Buffer Length ("B"), use the "MINIMUM LENGTHS TABLE" shown on Dwg. No. TM800.
- To determine sign spacing A, B, and C, use "TRAFFIC CONTROL DEVICES (TCD) SPACING TABLE" on Dwg. No. TM800.
- Install a "BICYCLES ON ROADWAY" (CW11-1) sign in advance of the closure when a bike lane is closed, or when the shoulder is closed and bikes are expected.
- At night, flagger stations shall be illuminated according to the FLAGGER STATION LIGHTING DELINEATION detail on Dwg No. TM800.
- To be accompanied by Dwg. Nos. TM820 & TM821.

***** 28" Tubular Markers on 10' max. spacing around intersection radii.

• • • • • 28" Tubular Markers on 20' max. spacing for flagger tapers and stations


• • • 28" Tubular Markers See TCD Spacing Table on TM800 for max. spacing.

UNDER TRAFFIC

UNDER CONSTRUCTION

NOTE:


- Additional Traffic Control Measures (TCM) may be required for all legs of the intersection

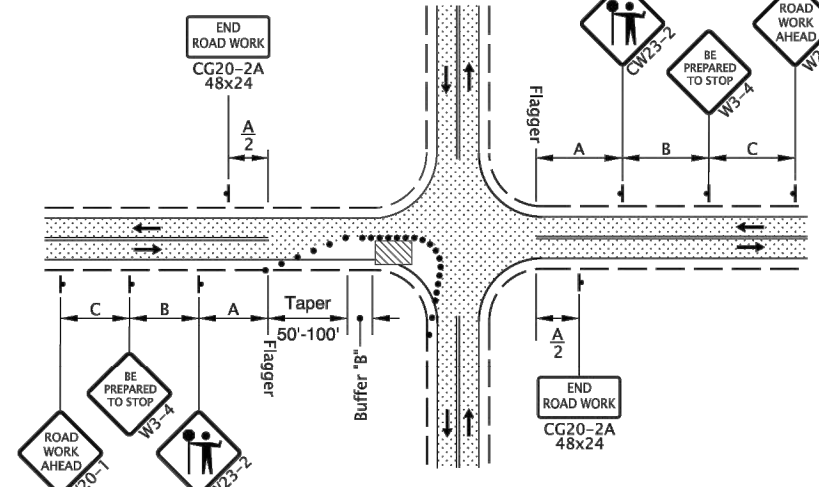

2-Lane, 2-Way Roadway
ONE LANE CLOSURE, INTERSECTION

NOTE:

- Use a minimum of 3 tubular markers in shoulder taper on 10' spacing for flagger station delineation.

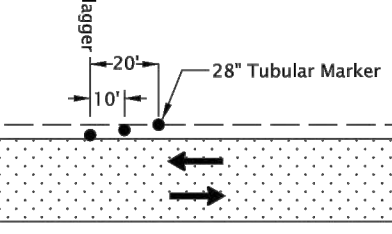

FLAGGER STATION DELINEATION

The selection and use of this Standard Drawing, while designed in accordance with generally accepted engineering principles and practices, is the sole responsibility of the user and should not be used without first consulting a Registered Professional Engineer.

All materials shall be in accordance with the current Oregon Standard Specifications.

OREGON STANDARD DRAWINGS

2-LANE, 2-WAY ROADWAYS

2021

DATE	REVISION DESCRIPTION

CALC. BOOK NO. N/A

SDR DATE 13-JAN-2023

TM855

Effective Date: June 1, 2023 – November 30, 2023

PLOT DATE: 02/28/2023 4:25 PM - FILE: C:\Users\MARCUSJ\OneDrive - Windsor Engineers\05_Projects\2020\20198-3 Cannon Beach Seismic Values\02_Drawings\04_Working\04_Final Sheets\20198-3_DET.dwg

THRUST BLOCKING

CONCRETE THRUST BLOCKING (HORIZONTAL)						
Thrust (T) at fittings in Pounds						
PIPE DIA.	Table Pressure PSI	Tee & Dead Ends	90 deg Bend	45 deg Bend	22.5 deg Bend	11.25 deg Bend
4"	250	3035	4320	2315	1215	610
6"	250	6860	9735	5215	2720	1375
8"	250	12185	17310	9265	4835	2430
10"	250	19045	27045	14480	7560	3800
12"	250	27405	38940	20840	10880	5465
14"	250	37320	53010	28370	14815	7445
16"	250	48740	69245	37050	19360	9735

Soil Type	Soil Bearing Capacity (B) in PSF
Muck, peat, etc.	0
Soft Clay	1000
Sand	2000
Sand and gravel	3000
Sand and gravel cemented with clay	4000
Hard shale	10,000

CONCRETE BLOCKING FOR CONVEX VERTICAL BENDS						
DIMENSION TABLE						
PIPE DIA. in.	Table Pressure PSI	Bend Angle (deg)	Concrete Volume (cy)	Cube Size (ft)	Stirrup Dia. (in)	Stirrup Embmt. (in)
4"	250	11.25	0.21	1.8	⅝	17
		22.5	0.43	2.3		
		45	0.77	2.8		
6"	250	11.25	0.48	2.4	⅝	17
		22.5	0.95	3.0		
		45	1.79	3.6		
8"	250	11.25	0.86	2.9	⅝	17
		22.5	1.65	3.5		
		45	3.22	4.4		
10"	250	11.25	1.39	3.3	⅝	17
		22.5	2.62	4.1		
		45	4.97	4.1		
12"	250	11.25	1.94	3.7	⅝	17
		22.5	3.91	4.7		
		45	6.89	5.7		
14"	250	11.25	2.62	4.1	⅝	17
		22.5	5.26	5.2		
		45	9.70	6.4		
16"	250	11.25	3.44	4.5	⅝	17
		22.5	6.89	5.7		
		45	12.63	7.0		

TEE

CROSS

STRADDLE

BEND

CROSS

TEE

CONVEX VERTICAL BEND

WYE

Stirrup (Typ.)

THRUST BLOCK BEARING AREA EQUATION

NOTE: WHEN THRUST BLOCK BEARING AREA IS NOT SPECIFIED ON THE PLANS OR DETERMINED BY THE ENGINEER, USE THE FOLLOWING PROCEDURE TO DETERMINE REQUIRED BEARING AREA.

- Determine thrust (T) for type of fitting or joint and size of pipe from Table A.
- Determine Design (Test) Pressure from Standard Specifications or Special Provisions.
- Determine Table Pressure from Table A.
- Determine Soil Bearing Capacity (B) of soil from Table B.
- Determine required bearing area (A) in sq. ft. as follows:

$$\text{Thrust Block Bearing Area} = A = \left(\frac{T}{B}\right) \left(\frac{\text{Design (Test) Pressure}}{\text{Table Pressure}}\right)$$

Example: Design (Test) Pressure = 150 PSI
Pipe = 14"
Fitting = Tee
Soil = Sand

From Table A, T = 37320
From Table B, B = 2000

$$A = \left(\frac{37320}{2000}\right) \left(\frac{150}{250}\right) = 11.2 \text{ sq.ft.}$$

GENERAL NOTES FOR ALL DETAILS ON THIS SHEET:

- Contractor to provide blocking adequate to withstand full test pressure.
- Pour concrete blocking against undisturbed earth.
- All concrete shall be commercial grade concrete.
- Wrap pipe and/or fittings with 2 layers of polyethylene film where in contact with concrete
- Keep concrete clear of all joints and accessories.
- Stirrups shall be deformed galvanized cold rolled steel AASHTO M31 (ASTM A615), Grade 60. Coat with coal tar epoxy after installation.
- See project plans for details not shown.

The selection and use of this Standard Drawing, while designed in accordance with generally accepted engineering principles and practices, is the sole responsibility of the user and should not be used without first consulting a Registered Professional Engineer.

OREGON STANDARD DRAWINGS

THRUST BLOCKING

2021

DATE

REVISION DESCRIPTION

CALC. BOOK NO. N/A

SDR DATE 28-JUL-2017

RD250

Effective Date: June 1, 2023 – November 30, 2023

HYDRANT ASSEMBLY

Valve box (Install valve box extension & operator extension, as reqd.)

36"x36"x6" concrete pad (optional)

6" min.

Breakaway flange

Wrap hydrant barrel with 2 layers of polyethylene film where in contact with concrete

2"-8" above concrete pad or surrounding datum

Depth of bury as reqd.

Concrete thrust block

6" gate valve mechanical joint to flange

6" HDPE PIPE TO HYDRANT

Mechanical joint x flange hydrant tee or tapping sleeve

Mechanical joint retainer gland PLUS ADAPTER

Min. ½ cubic yard drain rock to 6" above drain hole. Optional: wrap drain rock in geotextile fabric.

GENERAL NOTES FOR ALL DETAILS ON THIS SHEET:

- When pipe is shorter than 18', no joints allowed. Use mechanical joint retainer glands. Two ½" galvanized tie rods may be used in lieu of thrust blocks for installations less than 18' long. Coat the rods with two coats of coal tar epoxy.
- When pipe is longer than 18' retainer glands not required.
- There shall be a minimum of 18" horizontal clearance around hydrant.
- When placed adjacent to curb, hydrant port shall be 24" from face of curb.
- Concrete thrust blocks shall be constructed as per thrust blocking Std. Dwg. RD250. Do not block drain holes.
- Extensions required for hydrant systems shall be installed to the manufacturer's specifications.
- Hydrants shall be placed to provide a minimum of 5' clearance from driveways, poles, and other obstructions.
- Hydrant pumper port shall face direction of access.
- Set hydrant plumb in all directions.
- See project plans for details not shown.

The selection and use of this Standard Drawing, while designed in accordance with generally accepted engineering principles and practices, is the sole responsibility of the user and should not be used without first consulting a Registered Professional Engineer.

OREGON STANDARD DRAWINGS

HYDRANT INSTALLATION

2021

DATE

REVISION DESCRIPTION

CALC. BOOK NO. N/A

SDR DATE 28-JUL-2017

RD254

Effective Date: June 1, 2023 – November 30, 2023

COVER PLAN

Wrought iron rod

WATER

VALVE BOX ASSEMBLY DETAIL

Finish grade

Sliding type cast iron valve box and cover

Pavement or ground

PVC valve box extension

Operator extension (See detail this sheet)

¾"-0 compacted aggregate base (4" thick) or conc. block, (See general note 4)

VALVE BOX EXTENSION SECTION

Cast iron cover

Raised lettering

Finish grade

Adjustable From 12" max. to 6" min.

36" max.

* 4" min.

* See general note 8

Cast iron valve box (6" dia. min.)

PVC valve box extension

2" square operator nut welded to pipe shaft

Operator extension 1½" Schedule 80 pipe shaft

Rock guard, ½" steel plate welded to pipe shaft diameter = valve box extension inside diameter minus ½"

Flat bar 2½"x2½"x½"

¾"x¾" square head cupped capscrews

3"x3"x½"x2" long steel square tube welded all around to flat bar

Gravel bedding

GENERAL NOTES FOR ALL DETAILS ON THIS SHEET:

- Valve box not to rest on operating assembly.
- Operator extension required when valve nut is deeper than 4" from finish grade.
- Center valve box on axis of operator nut.
- Valves 12" and smaller shall be provided with compacted aggr. base on undisturbed ground. Valves greater than 12" shall be installed on precast concrete block, (4" thick).
- Welds shall be minimum ¼" all around.
- Hot dip galvanize operator extension after fabrication.
- Casting shall meet H20 load requirement.
- Provide concrete or asphalt pad (24" square, 4" thick), when required.
- See project plans for details not shown.

The selection and use of this Standard Drawing, while designed in accordance with generally accepted engineering principles and practices, is the sole responsibility of the user and should not be used without first consulting a Registered Professional Engineer.

OREGON STANDARD DRAWINGS

VALVE BOX AND OPERATOR EXTENSION

2021

DATE

REVISION DESCRIPTION

CALC. BOOK NO. N/A

SDR DATE 28-JUL-2017

RD258

Effective Date: June 1, 2023 – November 30, 2023

TYPICAL MAIN DEAD-END BLOWOFF ASSEMBLY

24"

20"

2" coupling with plug, assemble with anti-seize compound (hand tight)

Gravel bedding (Typical)

2" galvanized steel riser

2" galvanized steel pipe

2" malleable 90 deg. elbow with two ½" dia. drain holes and 1 cubic ft. of drain rock

Valve box (Typical)

2" iron body screwed gate valve with 2" standard operating nut

Notch PVC riser

Gravel bedding (Typ.)

Brass piping and fittings between tapped plug and gate valve (Typical)

Water main

Thrust block

Plug or cap with 2" I.P.T. tap, for eccentric tapped plugs, locate tap at lowest point of pipe.

GENERAL NOTES FOR ALL DETAILS ON THIS SHEET:

- Wrap main and fittings in thrust block zone with two layers of polyethylene film to facilitate future removal.
- In lieu of concrete thrust block, restrain pipe or pour concrete straddle block.
- See project plans for details not shown.

The selection and use of this Standard Drawing, while designed in accordance with generally accepted engineering principles and practices, is the sole responsibility of the user and should not be used without first consulting a Registered Professional Engineer.

OREGON STANDARD DRAWINGS

TYPICAL MAIN DEAD-END BLOWOFF ASSEMBLY

2021

DATE

REVISION DESCRIPTION

CALC. BOOK NO. N/A

SDR DATE 28-JUL-2017

RD262

Effective Date: June 1, 2023 – November 30, 2023

811

Know what's below.
Call before you dig.

CALL 2 BUSINESS DAYS BEFORE YOU DIG.
CAUTION UTILITY INFORMATION IS APPROXIMATE.
VERIFY ALL UTILITIES PRIOR TO CONSTRUCTION.

Revisions:		
1	8/24/2023	ADDENDUM #1
4	8/28/2023	ADDENDUM #4

LINE IS 1" ON FULL SCALE DRAWING

WINDSOR ENGINEERS

Ridgefield, WA
Duluth + Minneapolis, MN
www.windsorengineers.com
Project No: 20198.3
Copyright 2023 By Windsor Engineers, LLC
All Rights Reserved.

WATER RESILIENCY PROJECT
PHASE 1 - SEISMIC IMPROVEMENTS
CITY OF CANNON BEACH, OR 97110

ENGINEERING PLAN
Issue Date: 8/28/2023

Project Manager TWT
Drawn by TJM
Checked by MRL

WATER DETAILS


C590

BID PLAN SET - ADDENDUM #4

PLOT DATE: 11/16/2021 9:53 AM - FILE: C:\Users\jld@OneDrive - Windsor Engineers\20198.3_Cannon Beach Seismic Valves\02_Drawings\00_BIM\360 files\CAD Lines\20198-3_BRDR.dwg

Copyright 2022 By Windsor Engineers, LLC. All Rights Reserved.

INSTRUMENT CALLOUTS AND TAG SCHEMATIC

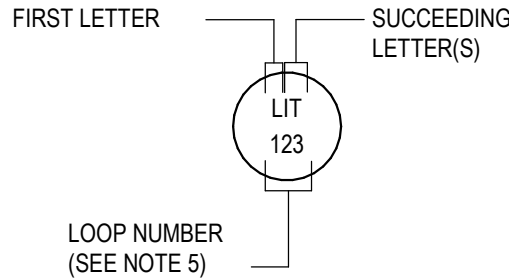

TYPICAL TAG FORMAT
LIT-123 INSTRUMENT TAG NUMBER
LIT FUNCTIONAL IDENTIFICATION
L FIRST LETTER
IT SUCCEEDING LETTER(S)
123 LOOP NUMBER

EXPANDED TAG FORMAT
20LIT-123A INSTRUMENT TAG NUMBER
20 AREA NUMBER
LIT FUNCTIONAL IDENTIFICATION
L FIRST LETTER
IT SUCCEEDING LETTER(S)
123 LOOP NUMBER
A OPTIONAL SUFFIX

FIRST LETTER (1)		SUCCEEDING LETTERS (15)			
MEASURED OR INITIATING VARIABLE	MODIFIER	READOUT OR PASSIVE FUNCTION	OUTPUT FUNCTION	MODIFIER	
A ANALYSIS (2)(3)(4)		ALARM			
B BURNER, COMBUSTION (2)		USER'S CHOICE (5)	USER'S CHOICE (5)	USER'S CHOICE (5)	
C USER'S CHOICE (3a)(5)			CONTROL (23a)(23e)	CLOSED (27b)	
D DENSITY	DIFFERENTIAL	DAMPER			
E VOLTAGE (2)		SENSOR (PRIMARY ELEMENT)			
F FLOW, FLOW RATE (2)	RATIO (FRACTION) (2b)				
G USER'S CHOICE		GLASS, VIEWING DEVICE (16)			
H HAND (2)				HIGH (27a)(28a)(29)	
I CURRENT (ELECTRICAL)(2)		INDICATE (17)			
J POWER (2)		SCAN (18)			
K TIME, TIME SCHEDULE (2)	TIME RATE OF CHANGE (12c)(13)		CONTROL STATION (24)		
L LEVEL (2)		LIGHT (19)		LOW (27b)(28)(29)	
M MOISTURE	MOMENTARY			MIDDLE, INTERMEDIATE	
N USER'S CHOICE (5)		USER'S CHOICE (5)	USER'S CHOICE (5)	USER'S CHOICE (5)	
O USER'S CHOICE (5)		ORIFICE, RESTRICTION		OPEN (27a)	
P PRESSURE, VACUUM (2)		POINT (TEST) CONNECTION			
Q QUANTITY (2)	INTEGRATE, TOTALIZE	INTEGRATE, TOTALIZE			
R RADIATION (2)		RECORD (20)		RUN	
S SPEED, FREQUENCY (2)	SAFETY (14)		SWITCH (23b)	STOP	
T TEMPERATURE (2)			TRANSMIT		
U MULTI VARIABLE (2)(6)		MULTIFUNCTION (21)	MULTIFUNCTION (21)	MULTIFUNCTION (21)	
V VIBRATION, MECHANICAL ANALYSIS (2)(4)(7)			VALVE, DAMPER, OR LOUVER (23c)(23e)		
W WEIGHT, FORCE (2)		WELL, PROBE			
X UNCLASSIFIED (8)	X AXIS (11c)	ACCESSORY DEVICES (22) UNCLASSIFIED (8)	UNCLASSIFIED (8)	UNCLASSIFIED (8)	
Y EVENT, STATE, PRESENCE (2)(9)	Y AXIS (11c)		RELAY, COMPUTE, CONVERT		
Z POSITION, DIMENSION (2)	Z AXIS (11c), SAFETY INSTRUMENT SYSTEM (30)		DRIVER, ACTUATOR, UNCLASSIFIED FINAL CONTROL ELEMENT		

NOTE: NUMBERS IN PARANTHESES REFER TO EXPLANATORY NOTES IN ANSI/ISA-5.1-2009, SECTION 4.2

FUNCTION DESIGNATIONS

SWITCHES

A/M AUTO-MANUAL
ESTOP EMERGENCY STOP
F-R FORWARD-REVERSE
H/A HAND-OFF-AUTO
H/R HAND-OFF-REMOTE
L/R LOCAL-REMOTE
LOR LOCAL-OFF-REMOTE
O/C OPEN-CLOSE
OCA OPEN-CLOSE-AUTO
O-O ON-OFF
OSC OPEN-STOP-CLOSE
POT POTENTIOMETER
RST RESET
S-S START-STOP

ANALYTICAL INSTRUMENTS





ALK ALKALINITY
CL2 CHLORINE CONCENTRATION
COMB COMBUSTIBLE GAS
COND CONDUCTIVITY
DO DISSOLVED OXYGEN
H2S HYDROGEN SULFIDE
LEL LOWER EXPLOSIVE LIMIT
NO3 NITRATE
O2 OXYGEN CONCENTRATION
O3 OZONE
ORP OXIDATION REDUCTION POTENTIAL
PH HYDROGEN ION CONCENTRATION
SO2 SULFUR DIOXIDE
TH TOTAL HARDNESS
TURB TURBIDITY
UV ULTRAVIOLET TRANSMITTANCE
OR INTENSITY
* NOTED AS TOTAL OR FREE

NOTES

- SEE THE GENERAL AND ELECTRICAL DISCIPLINE DRAWINGS FOR ADDITIONAL SYMBOLS AND ABBREVIATIONS.
- SEE THE GENERAL DISCIPLINE DRAWINGS FOR EQUIPMENT DESIGNATIONS AND PROCESS IDENTIFICATION CODES.
- THIS IS A GENERALIZED LEGEND SHEET. SEE ALSO ISA S5.1, S5.3 AND S7.3.
- FOR INSTRUMENT AIR QUALITY STANDARDS, REFER TO ISA RP7.7.
- SEE SPECIFICATION 40 FOR COMPLETE DETAILS OF LOOP DRAWING AND INTERCONNECTION DRAWING SUBMITTAL REQUIREMENTS.
- POWER SUPPLIES FOR INSTRUMENT LOOPS OR SYSTEMS SHALL BE PROVIDED BY THE INSTRUMENTATION SUPPLIER TO MEET THE VOLTAGE AND CURRENT REQUIREMENTS OF THE COMPONENTS IN EACH LOOP OR SYSTEM.
- FIELD SWITCHES FOR ELECTRICAL MOTOR OPERATION SHALL BE SUPPLIED BY THE ELECTRICAL CONTRACTOR UNLESS THEY ARE PART OF A VENDOR PACKAGE.

LINE SYMBOLOGY

— O — — O — — O — — O — — DATA LINK (SOFTWARE) CONNECTION

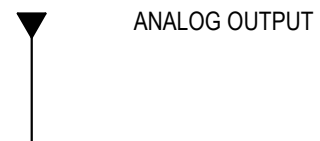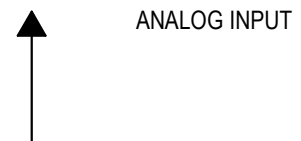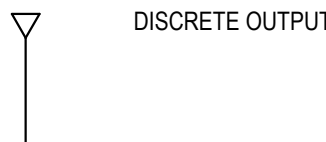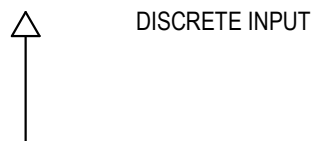

RECEPTACLE SYMBOLS LEGEND

- SINGLE RECEPTACLE
- DUPLEX RECEPTACLE
- DOUBLE DUPLEX RECEPTACLE
- DUPLEX RECEPTACLE ABOVE COUNTER
- DOUBLE DUPLEX RECEPTACLE ABOVE COUNTER
- DUPLEX RECEPTACLE W/ GFCI
- DOUBLE DUPLEX RECEPTACLE W/ GFCI
- DUPLEX RECEPTACLE W/ GFCI ABOVE COUNTER
- DOUBLE DUPLEX RECEPTACLE ON CEILING
- DOUBLE DUPLEX RECEPTACLE ON CEILING
- DUPLEX RECEPTACLE, HALF SWITCHED
- DUPLEX RECEPTACLE, FULL SWITCHED
- SPECIAL PURPOSE RECEPTACLE. VERIFY NEMA CONFIGURATION
- SPECIAL PURPOSE RECEPTACLE ON CEILING, VERIFY NEMA CONFIGURATION
- RECEPTACLE W/ CEILING CORD DROP
- FLOORBOX W/ DUPLEX RECEPTACLE
- FLOORBOX W/ DOUBLE DUPLEX RECEPTACLE
- COMBINATION FLOORBOX W/ POWER AND LOW VOLTAGE

CONNECTIONS/EQUIPMENT SYMBOLS LEGEND

- EQUIPMENT ELECTRICAL CONNECTION
- MOTOR CONNECTION
- MOTOR RATED SWITCH W/ THERMAL OVERLOAD
- DISCONNECT SWITCH
- FUSED DISCONNECT SWITCH
- JUNCTION BOX
- LINE VOLTAGE THERMOSTAT
- UTILITY METER
- EQUIPMENT CABINET AS NOTED
- ELECTRIC WALL HEATER
- BRANCH PANEL RECESSED
- BRANCH PANEL SURFACE
- TRANSFORMER
- SWITCHBOARD

ONE-LINE SYMBOLS LEGEND


- CIRCUIT BREAKER
- BUS DUCT PLUG-IN CIRCUIT BREAKER
- FUSED SWITCH
- CURRENT TRANSFORMERS
- GROUND CONNECTION
- CONDUIT CONTINUATION
- CONDUIT CAP
- FEEDER CALLOUT
- SURGE PROTECTIVE DEVICE
- AUTOMATIC TRANSFER SWITCH
- TRANSFORMER
- ELECTRICITY METER
- GENERATOR

LIGHTING SYMBOLS LEGEND

NOTE: SHADING LUMINAIRE INDICATES EMERGENCY POWER

- RECESSED DOWNLIGHT - ROUND/SQUARE
- SURFACE DOWNLIGHT - ROUND/SQUARE
- PENDANT OR FLUSH MOUNT LUMINAIRE
- LINEAR RECESSED LUMINAIRE
- LINEAR SURFACE LUMINAIRE
- LINEAR PENDANT LUMINAIRE
- LINEAR WALL LUMINAIRE
- LINEAR STRIP LUMINAIRE
- CONTINUOUS TAPE OR UNDERCABINET LUMINAIRE
- RECESSED HEAT LAMP
- RECESSED 2x2 LUMINAIRE
- RECESSED 2x4 LUMINAIRE
- SURFACE OR PENDANT 2x2 LUMINAIRE
- SURFACE OR PENDANT 2x4 LUMINAIRE
- WALL MOUNTED LUMINAIRE
- RECESSED STEP LIGHT
- GROUND MOUNT FLOOD
- POLE MOUNTED AREA LUMINAIRE
- BOLLARD OR POST TOP LUMINAIRE
- EMERGENCY BUGEYE
- EXIT SIGN, SHADING INDICATES FACES, ARROWS PER PLAN

TYPICAL LUMINAIRE LABELING

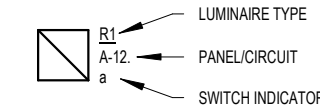

LIGHTING CONTROLS SYMBOLS LEGEND

NOTE: ANY COMBINATION OF LETTERS MAY APPLY TO A SWITCH FOR MULTIPLE FUNCTIONS

- STANDARD SWITCH
- STANDARD SWITCH W/ SWITCHING SUBSCRIPT
- 3-WAY SWITCH
- 4-WAY SWITCH
- LOW VOLTAGE SWITCH
- LOW VOLTAGE SWITCH PER SCHEDULE
- OCCUPANCY SENSOR SWITCH
- KEYED SWITCH
- DIMMER SWITCH
- TIMER SWITCH
- OCCUPANCY SENSOR CEILING MOUNT
- PHOTOCELL CEILING MOUNT
- OCCUPANCY SENSOR WALL MOUNT
- PHOTOCELL WALL MOUNT

GENERAL SYMBOLS LEGEND

- MECHANICAL EQUIPMENT TAG
- KITCHEN EQUIPMENT TAG
- DWELLING UNIT CIRCUIT TAG
- KEYNOTE
- REVISION TAG
- REVISION CLOUD
- DETAIL/PLAN CALLOUT
- NORTH ARROW
- MATCHLINE
- DWELLING UNIT CALLOUT TAG W/ UNIT TYPE AND CIRCUIT NUMBER

ABBREVIATIONS

- AMPERES
- ARC FAULT CIRCUIT INTERRUPTER
- ABOVE FINISHED FLOOR
- AMPERE INTERRUPTING CAPACITY
- ALUMINUM
- AUTOMATIC TRANSFER SWITCH
- AMERICAN WIRE GAUGE
- AUDIO VISUAL
- BREAKER
- CONDUIT
- CIRCUIT
- COND. ONLY
- COPPER
- CEILING
- CURRENT TRANSFORMER
- DISTRIBUTED ANTENNA SYSTEM
- DIAMETER
- EXISTING
- EQUIPMENT GROUNDING CONDUCTOR
- EMERGENCY RESPONDER RADIO COVERAGE
- FUSE
- FIRE ALARM CONTROL PANEL
- FOOT CANDLE
- FULL LOAD AMPERES
- FIRE SMOKE DAMPER
- GROUNDING ELECTRODE CONDUCTOR
- GROUND FAULT CIRCUIT INTERRUPTER
- GROUND FAULT PROTECTION OF EQUIPMENT
- HORSEPOWER
- INTERMEDIATE DISTRIBUTION FRAME
- ISOLATED GROUND
- THOUSAND CIRCULAR MIL
- KILOVOLT-AMP
- KILOWATT
- LIGHTING
- MINIMUM CIRCUIT AMPERES
- MAIN CIRCUIT BREAKER
- MOTOR CONTROL CENTER
- MAIN DISTRIBUTION FRAME
- MAIN DISTRIBUTION PANEL
- MEDIA DISTRIBUTION UNIT
- MINIMUM
- MAIN LUG ONLY
- MOCP
- MANUAL TRANSFER SWITCH
- NEW
- NOTIFICATION APPLIANCE CIRCUIT
- ON CENTER
- POLE
- PHASE
- PANEL
- POWER
- RELOCATE
- RIGHT-OF-WAY
- SWITCH
- SUB-DISTRIBUTION PANEL
- SIMILAR
- SURGE PROTECTIVE DEVICE
- TAMPER RESISTANT
- TYPICAL
- UNLESS NOTED OTHERWISE
- UNINTERRUPTIBLE POWER SUPPLY
- VOLTS
- VOLT-AMPERES
- VARIABLE FREQUENCY DRIVE
- WIRE
- WEATHERPROOF
- DEMOLISH
- TRANSFORMER

TYPICAL DEVICE MOUNTING HEIGHTS

- RECEPTACLES +18" AFF
- RECEPTACLES, ABOVE COUNTER +6" ABOVE COUNTER, +46" AFF MAX, COORDINATE WITH CASEWORK
- PHONE/DATA/CATV OUTLET +18" AFF
- SWITCHES +46" AFF
- THERMOSTATS +46" AFF
- CARD READERS +46" AFF
- PANELBOARDS +72" TO TOP OR PER NEC 404.8
- RESIDENTIAL PANEL +48" TO HIGHEST OPERABLE CONTROL
- CONTROL PANELS +72" TO TOP

NOTES:

- MEASUREMENTS ARE TYPICAL UNO ON PLANS
- MEASUREMENTS ARE TO CENTER OF BOX UNO
- COMPLY WITH ALL ADA ACCESSIBILITY GUIDELINES

GENERAL PROJECT NOTES

- COMPLETED INSTALLATION SHALL COMPLY WITH NEC AND ALL LOCAL LAWS, ORDINANCES, AND REGULATIONS.
- ALL NEW ELECTRICAL SERVICE INSTALLATIONS SHALL COMPLY WITH PACIFICORP'S 2022 ELECTRICAL SERVICE REQUIREMENTS MANUAL.
- CODE BASIS OF DESIGN: 2020 NATIONAL ELECTRICAL CODE WITH OREGON STATE MODIFICATIONS (NFPA 70), 2018 INTERNATIONAL BUILDING CODE, 2018 OREGON STATE ENERGY CODE.
- PLANS ARE DIAGRAMMATIC IN NATURE TO COMMUNICATE SCOPE OF WORK AND GENERAL INTENT. CONTRACTOR SHALL PROVIDE ALL FITTINGS, BOXES, AND APPURTENANCES NECESSARY FOR A COMPLETE AND OPERABLE ELECTRICAL SYSTEM.
- DEVICE LOCATIONS ON PLANS MAY NOT BE EXACT. REFER TO ARCHITECTURAL PLANS FOR MORE DETAILED INFORMATION REGARDING DIMENSIONS AND LAYOUTS. COORDINATE ALL DEVICE AND EQUIPMENT LOCATIONS WITH ARCHITECTURAL AND OTHER TRADES.
- EQUIPMENT FOR OTHER DISCIPLINES MAY BE SHOWN FOR REFERENCE ONLY. REFER TO OTHER DISCIPLINES' DRAWINGS FOR MORE DETAIL REGARDING EQUIPMENT SPECIFICATIONS AND INFORMATION.
- PLANS SHALL GOVERN IN MATTERS OF QUANTITY. SPECIFICATIONS SHALL GOVERN IN MATTERS OF QUALITY. IN CASE OF DISCREPANCY BETWEEN DRAWINGS AND SPECIFICATIONS, THE SPECIFICATIONS SHALL GOVERN. PLANS ARE TO BE TIED TO SPECIFICATIONS FOR A COMPLETE DESIGN PACKAGE.
- ANYTHING MENTIONED IN THE SPECIFICATIONS AND NOT SHOWN ON THE DRAWINGS, OR SHOWN ON THE DRAWINGS AND NOT MENTIONED IN THE SPECIFICATIONS, SHALL BE OF LIKE EFFECT AS IF SHOWN OR MENTIONED IN BOTH.
- WIRE SIZE AND QUANTITIES ARE NOT GENERALLY INDICATED ON PLANS. FOR A TYPICAL 20A/1P CIRCUIT BREAKER, PROVIDE (3) #12 CU CONDUCTORS (PHASE, NEUTRAL, GROUND). FOR A TYPICAL 20A/2P CIRCUIT BREAKER, PROVIDE (3) #12 CU CONDUCTORS (PHASE, PHASE, GROUND). FOR A TYPICAL 20A/3P CIRCUIT BREAKER, PROVIDE (4) #12 CU CONDUCTORS (THREE PHASES PLUS GROUND).
- TO COMPENSATE FOR VOLTAGE DROP, ON 20A, 120V CIRCUITS: OVER 100 FEET, PROVIDE #10 AWG, OVER 150 FEET, PROVIDE #8 AWG. ON 20A, 277V CIRCUITS: OVER 250 FEET, PROVIDE #10 AWG.
- CIRCUIT NUMBERS ARE GENERALLY INDICATED AS XX-##, WHERE (XX) INDICATES PANEL NAME AND (##) INDICATES THE CIRCUIT NUMBER. IN SOME CASES THE PANEL MAY BE COMMON TO A LARGE AREA, AND THE CIRCUIT NUMBER ONLY MAY BE CALLED OUT ON THE PLANS.
- MAINTAIN AT LEAST 12" SEPARATION BETWEEN POWER AND COMMUNICATIONS WIRING ROUTED PARALLEL. SMALLER SEPARATION MAY BE ALLOWED WHEN CROSSING.
- ELECTRICAL EQUIPMENT IS DESIGNED BASED ON A SPECIFIC MANUFACTURER. VERIFY FINAL CLEARANCES AND SPACE REQUIREMENTS WITH EQUIPMENT SUBMITTALS. THE CONTRACTOR IS RESPONSIBLE FOR ANY REDESIGN OR RELOCATION OF EQUIPMENT IF APPROVED EQUIPMENT DOES NOT MATCH BASIS OF DESIGN.
- PROVIDE 4" HIGH CONCRETE "HOUSEKEEPING PADS" FOR FREE STANDING AND FLOOR MOUNTED ELECTRICAL EQUIPMENT.
- ALL CONDUIT ROUTING SHALL FOLLOW BUILDING LINES WHERE POSSIBLE. COORDINATE ROUTING WITH ARCHITECTURAL ELEMENTS. ALL ROUTING OF EXPOSED CONDUITS SHALL BE APPROVED BY THE ARCHITECT.
- COORDINATE UNDERGROUND CONDUIT ROUTING WITH CIVIL AND STRUCTURAL PLANS.
- CONSULT STRUCTURAL ENGINEER OF RECORD FOR ALL STRUCTURAL PENETRATIONS.

ELECTRICAL SHEET INDEX

- E001 COVER SHEET - ELECTRICAL
- E101 SITE PLAN - MAIN RESERVOIR
- E102 SITE PLAN - SOUTH/TOLOVANA RESERVOIR
- E103 SITE PLAN - NORTH RESERVOIR
- E204 SITE PLAN ISOLATION VALVE 4
- E501 DETAILS - ELECTRICAL
- E502 DETAILS - ELECTRICAL
- E601 RESERVOIR ONE-LINE DIAGRAM
- E602 ISOLATION VALVE ONE-LINE DIAGRAM
- E701 TYPICAL CONTROL PANEL ELEVATIONS
- E801 SCADA NETWORK DIAGRAM

NOTE

ALL OF GENERAL NOTES ON THIS SHEET ARE TO BE APPLIED TO ALL OTHER DRAWINGS IN THIS SET. THE SYMBOLS AND ABBREVIATIONS SHOWN ON THIS SHEET MAY OR MAY NOT BE USED IN THIS SET OF DRAWINGS.



Know what's below.
Call before you dig.

CALL 2 BUSINESS DAYS BEFORE YOU DIG.
CAUTION: UTILITY INFORMATION IS APPROXIMATE.
VERIFY ALL UTILITIES PRIOR TO CONSTRUCTION.

Revisions:

1	8/24/2023	ADDENDUM #1
4	8/28/2023	ADDENDUM #4

LINE IS 1" ON FULL SCALE DRAWING



WINDSOR ENGINEERS

Ridgefield, WA
Duluth + Minneapolis, MN
www.windsorengineers.com
Project No: 20198.3

Copyright 2023 By Windsor Engineers, LLC
All Rights Reserved.



EXPIRES: 06/30/24

WATER RESILIENCY PROJECT
PHASE 1 - SEISMIC IMPROVEMENTS
CITY OF CANNON BEACH, OR 97110

ENGINEERING PLAN

Issue Date: 7/14/2023


COVER SHEET -
ELECTRICAL

E001


Project Manager: TWT
Drawn by: JRB
Checked by: SEW

PLOT DATE: 11/6/2021 9:53 AM - FILE: C:\Users\Jed\OneDrive - Windsor Engineers\20198.3 Cannon Beach Seismic Valves\02_Drawings\00_BIM 360 files\CAD Units\20198-3_BRDR.dwg


Copyright 2022 By Windsor Engineers, LLC. All Rights Reserved.

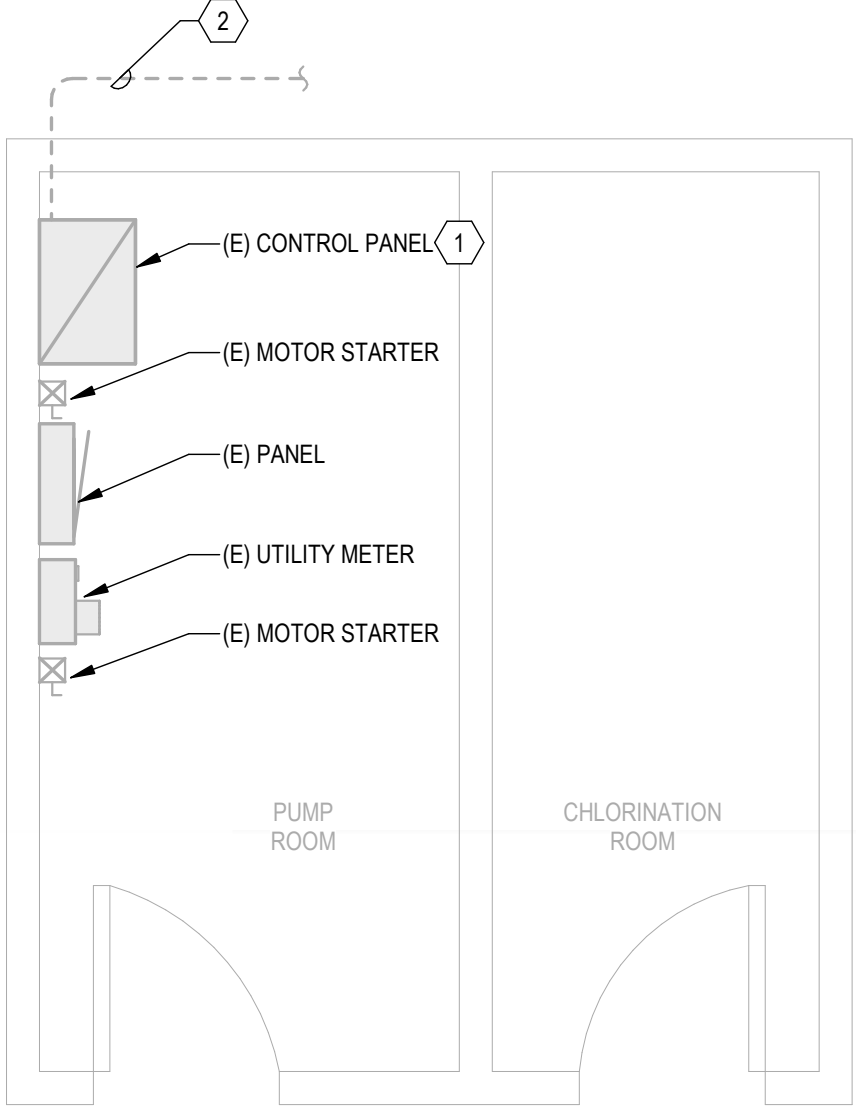

3 MAIN RESERVOIR - PUMP STATION
SCALE: 3/8" = 1'-0"

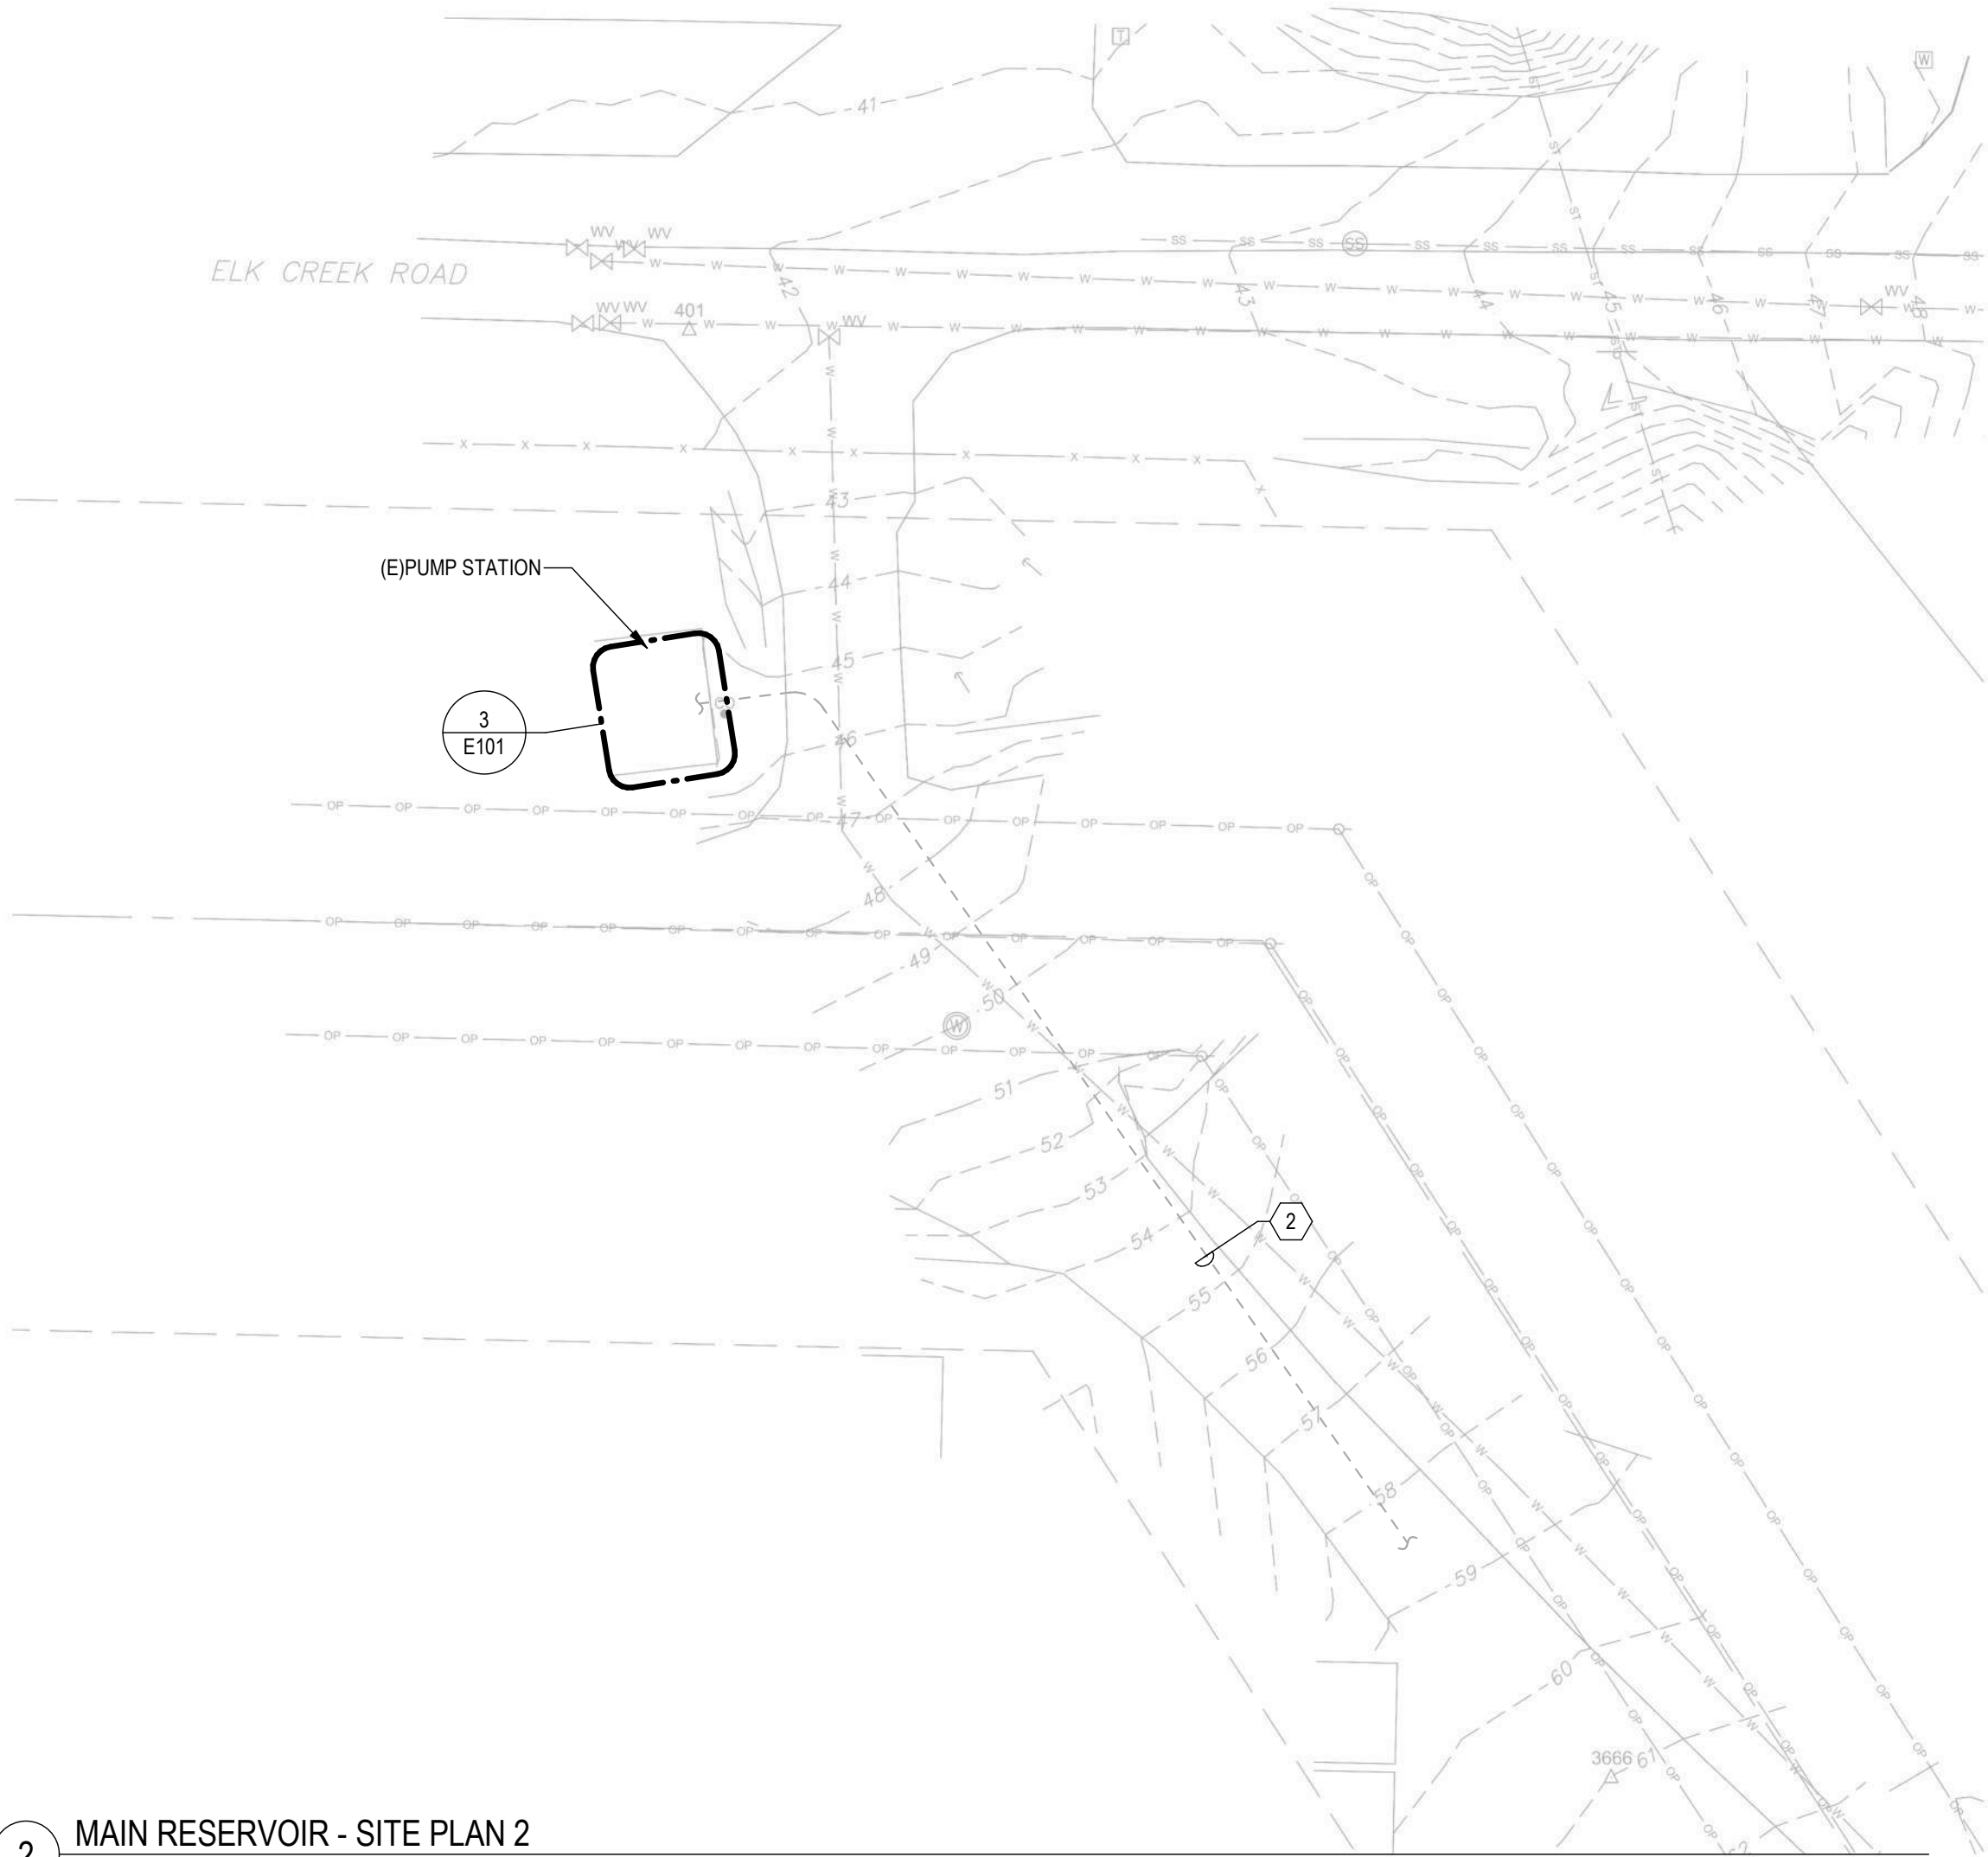

2 MAIN RESERVOIR - SITE PLAN 2
SCALE: 1" = 20'-0"

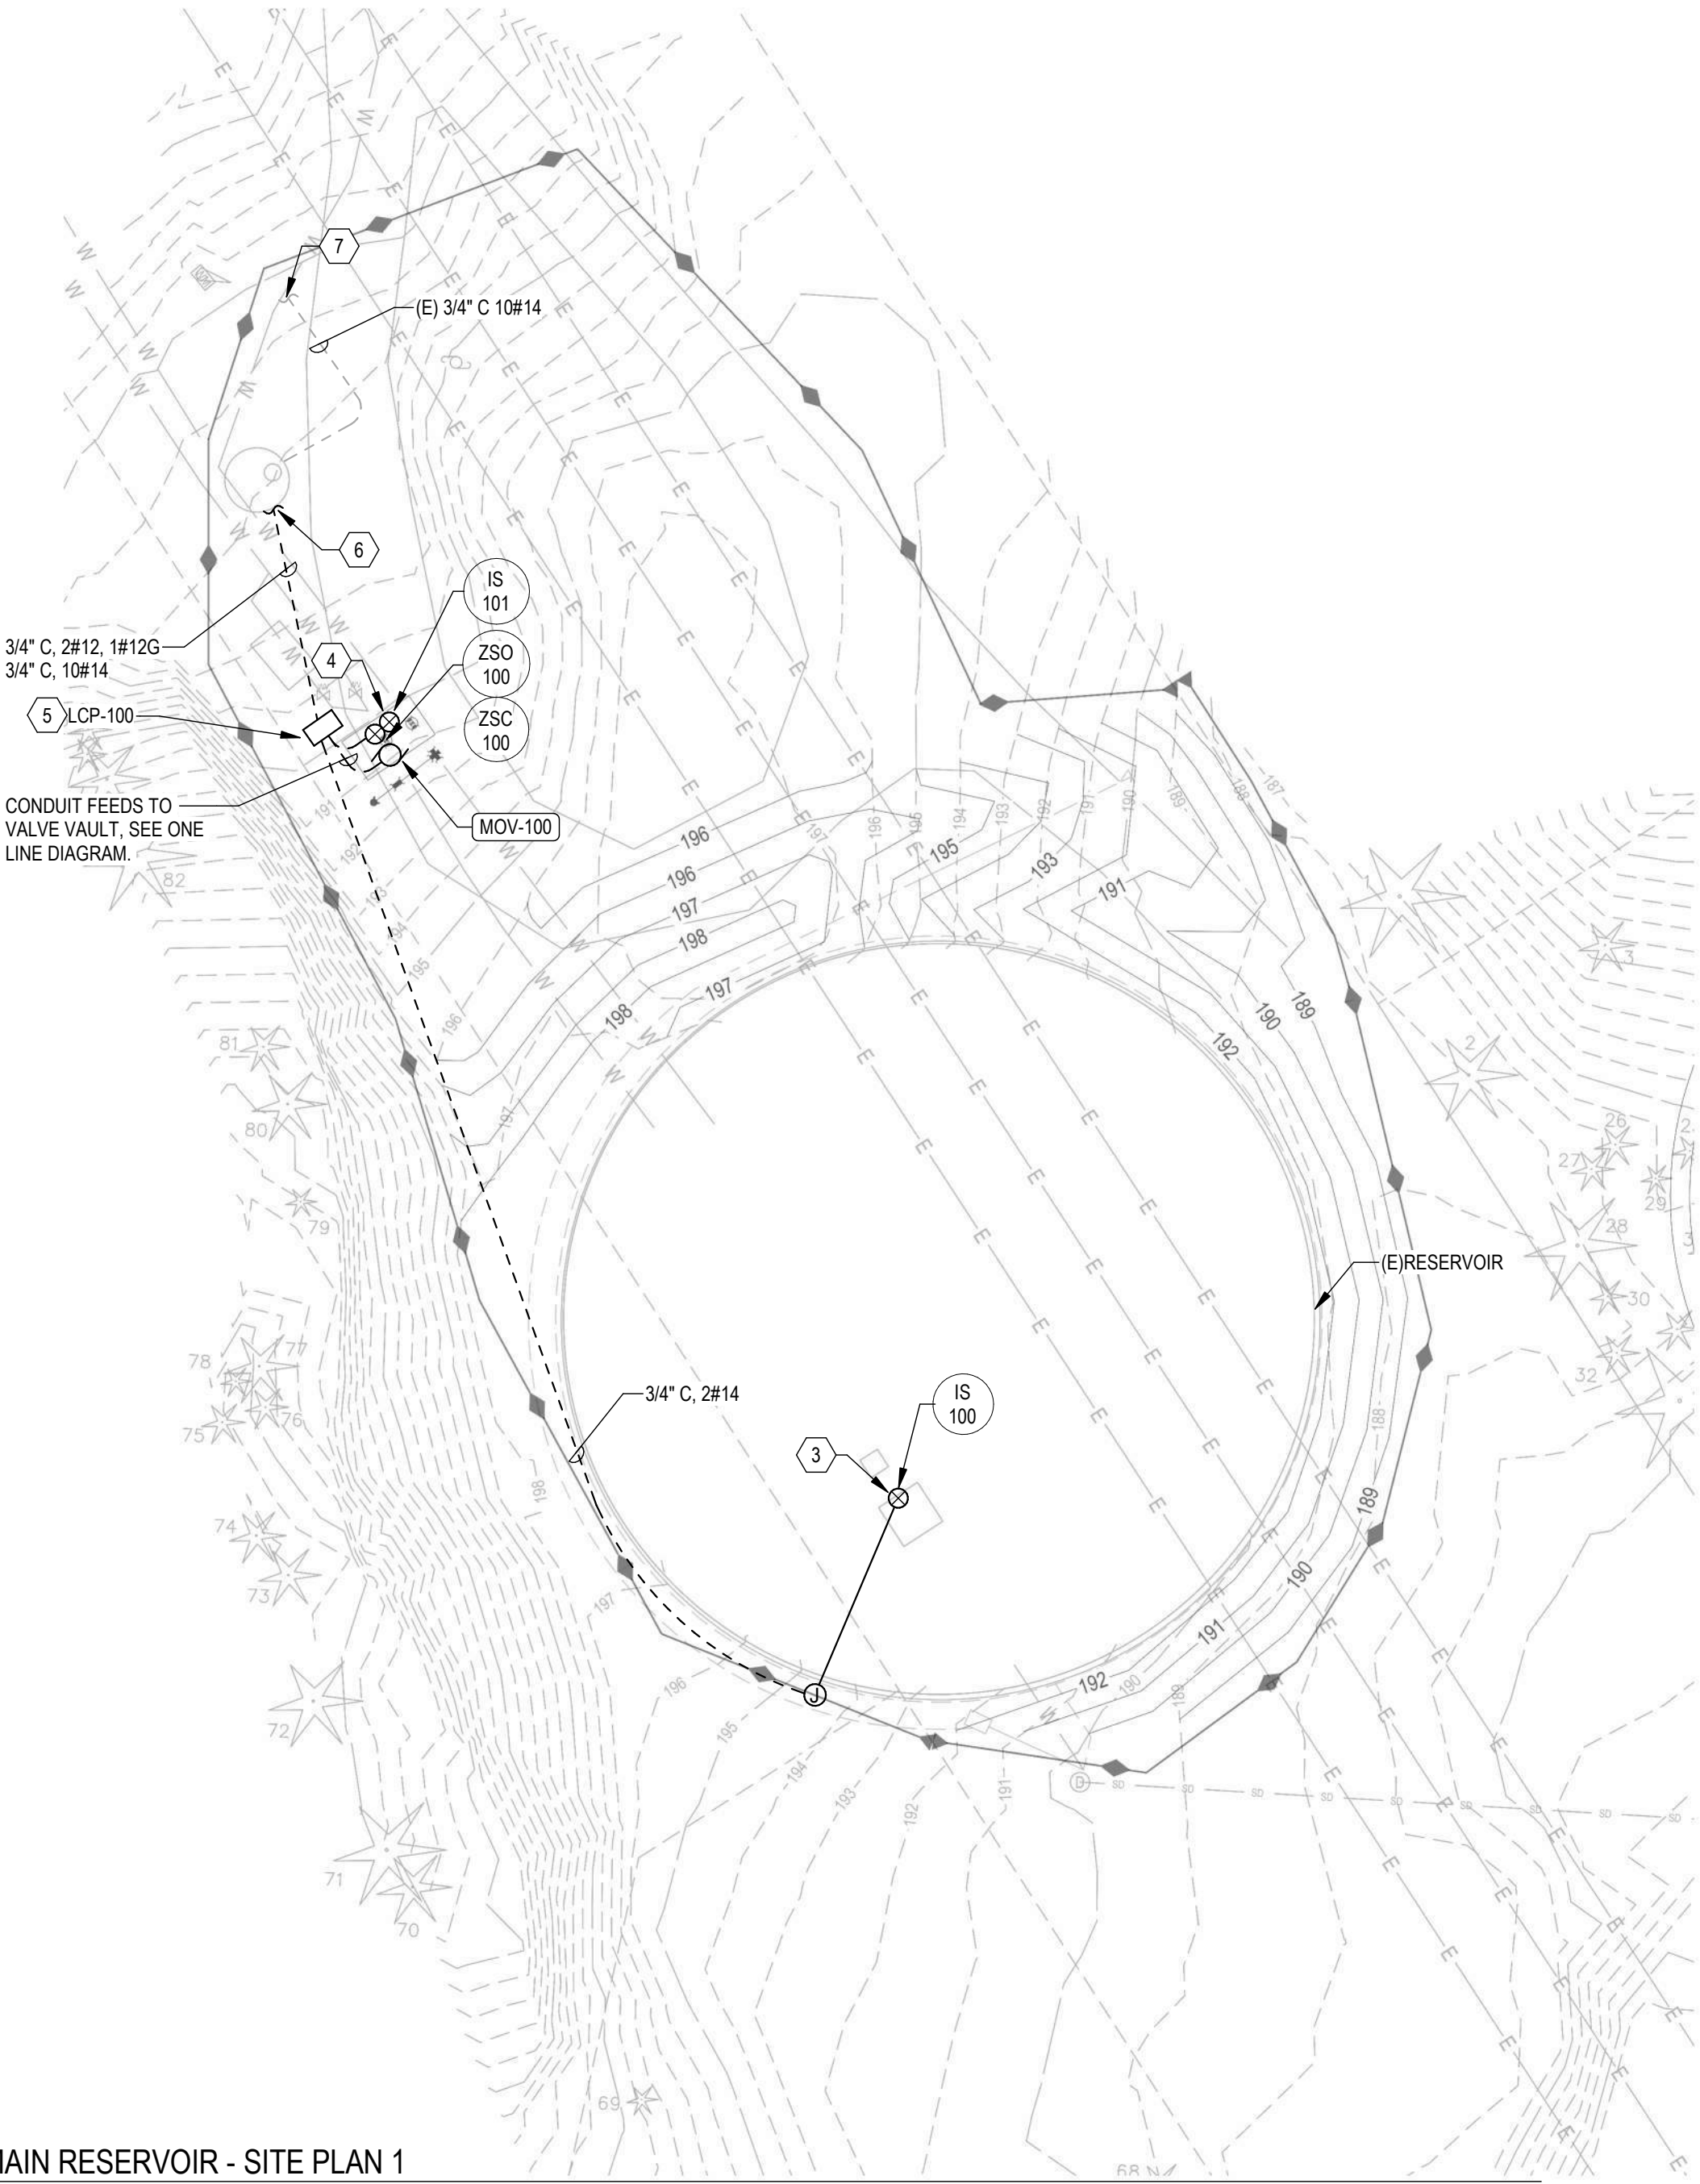

1 MAIN RESERVOIR - SITE PLAN 1
SCALE: 1" = 20'-0"

GENERAL SHEET NOTES

- EXISTING ELECTRICAL AND INSTRUMENTATION EQUIPMENT IS APPROXIMATE. CONTRACTOR TO VERIFY EXACT LOCATIONS.
- REFER TO GENERAL SHEET DRAWINGS G004, G005, AND G006 FOR SITE LOCATIONS AND KEY PLANS.
- ALL UNDERGROUND CONDUITS SHALL BE A MINIMUM OF 24" BELOW GRADE.
- ALL CONDUIT SHALL HAVE MINIMUM 12" OF SEPARATION FROM ANY OTHER COMMUNICATION OR GAS FACILITIES AND SHALL BE MINIMUM OF 36" FROM ANY WATER OR SEWER LINES.
- GRAY LINES INDICATE EXISTING TO REMAIN. BOLD LINES INDICATE NEW SCOPE.
- DASHED CONDUIT LINETYPE INDICATES UNDERGROUND ROUTING. COORDINATE NEW UNDERGROUND CONDUITS WITH EXISTING CONDITIONS.

KEYNOTES

- EXISTING SCADA RTU IS MISSION MYDRO 850. REFER TO MANUFACTURER INSTALLATION INSTRUCTIONS TO ACCOMMODATE ADDITIONAL INPUTS AND OUTPUTS. SCADA AND VALVE PROGRAMMING BY CONTRACTOR.
- EXISTING 3/4" CONDUIT TO ALTITUDE CONTROL VALVE VAULT LOCATED NEAR RESERVOIR.
- PROVIDE RESERVOIR INTRUSION SWITCH. SEE INSTALLATION DETAIL ON SHEET E501. INTRUSION SWITCH SHALL BE WIRED TO EXISTING MISSION SCADA RTU LOCATED IN PUMP HOUSE TO MONITOR SWITCH STATUS.
- PROVIDE VAULT INTRUSION SWITCH. SEE INSTALLATION DETAIL ON SHEET E501. INTRUSION SWITCH SHALL BE WIRED TO EXISTING MISSION SCADA RTU LOCATED IN PUMP HOUSE TO MONITOR SWITCH STATUS.
- SEE DETAIL SHEET E501. FIELD COORDINATE EXACT LOCATION.
- PROVIDE 20A/120V CIRCUIT FROM EXISTING PANEL IN VALVE VAULT TO LOCAL CONTROL PANEL.
- PULL NEW CONTROL WIRE THROUGH EXISTING 3/4" SPARE CONDUIT BACK TO RTU IN PUMP HOUSE. SEE ONE-LINE DIAGRAM SHEET E601.


MAIN RESERVOIR QUANTITIES		
ITEM	UNITS	QUANTITY
SHAKE ALARM CONTROL	EA	1
MODIFY EXISTING SCADA IMISSION RTU	EA	1
MISSION RTU RADIO BACKUP	EA	1
CONNECT TO METER	EA	1
EQUIPMENT STAND	EA	1
3/4" CONDUIT	LF	200
1" CONDUIT	LF	1300
#14 WIRE	LF	16000
POWER SUPPLY WITH ELECTRICAL BOX	LF	0
INTRUSION SWITCHES	EA	2



Know what's **below.**
Call before you dig.

CALL 2 BUSINESS DAYS BEFORE YOU DIG.
CAUTION: UTILITY INFORMATION IS APPROXIMATE.
VERIFY ALL UTILITIES PRIOR TO CONSTRUCTION.

Revisions:

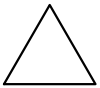

NO.	DATE	DESCRIPTION
1	8/24/2023	ADDENDUM #1
4	8/28/2023	ADDENDUM #4

LINE IS 1" ON FULL
SCALE DRAWING



WINDSOR ENGINEERS

Ridgefield, WA
Duluth + Minneapolis, MN
www.windsorengineers.com
Project No: 20198.3

Copyright 2023 By Windsor Engineers, LLC
All Rights Reserved.




**WATER RESILIENCY PROJECT
PHASE 1 - SEISMIC IMPROVEMENTS**
CITY OF CANNON BEACH, OR 97110


ENGINEERING PLAN
Issue Date: 7/14/2023

Project Manager TWT
Drawn by JRB
Checked by SEW

SITE PLAN - MAIN
RESERVOIR

E101

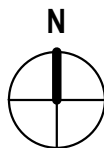

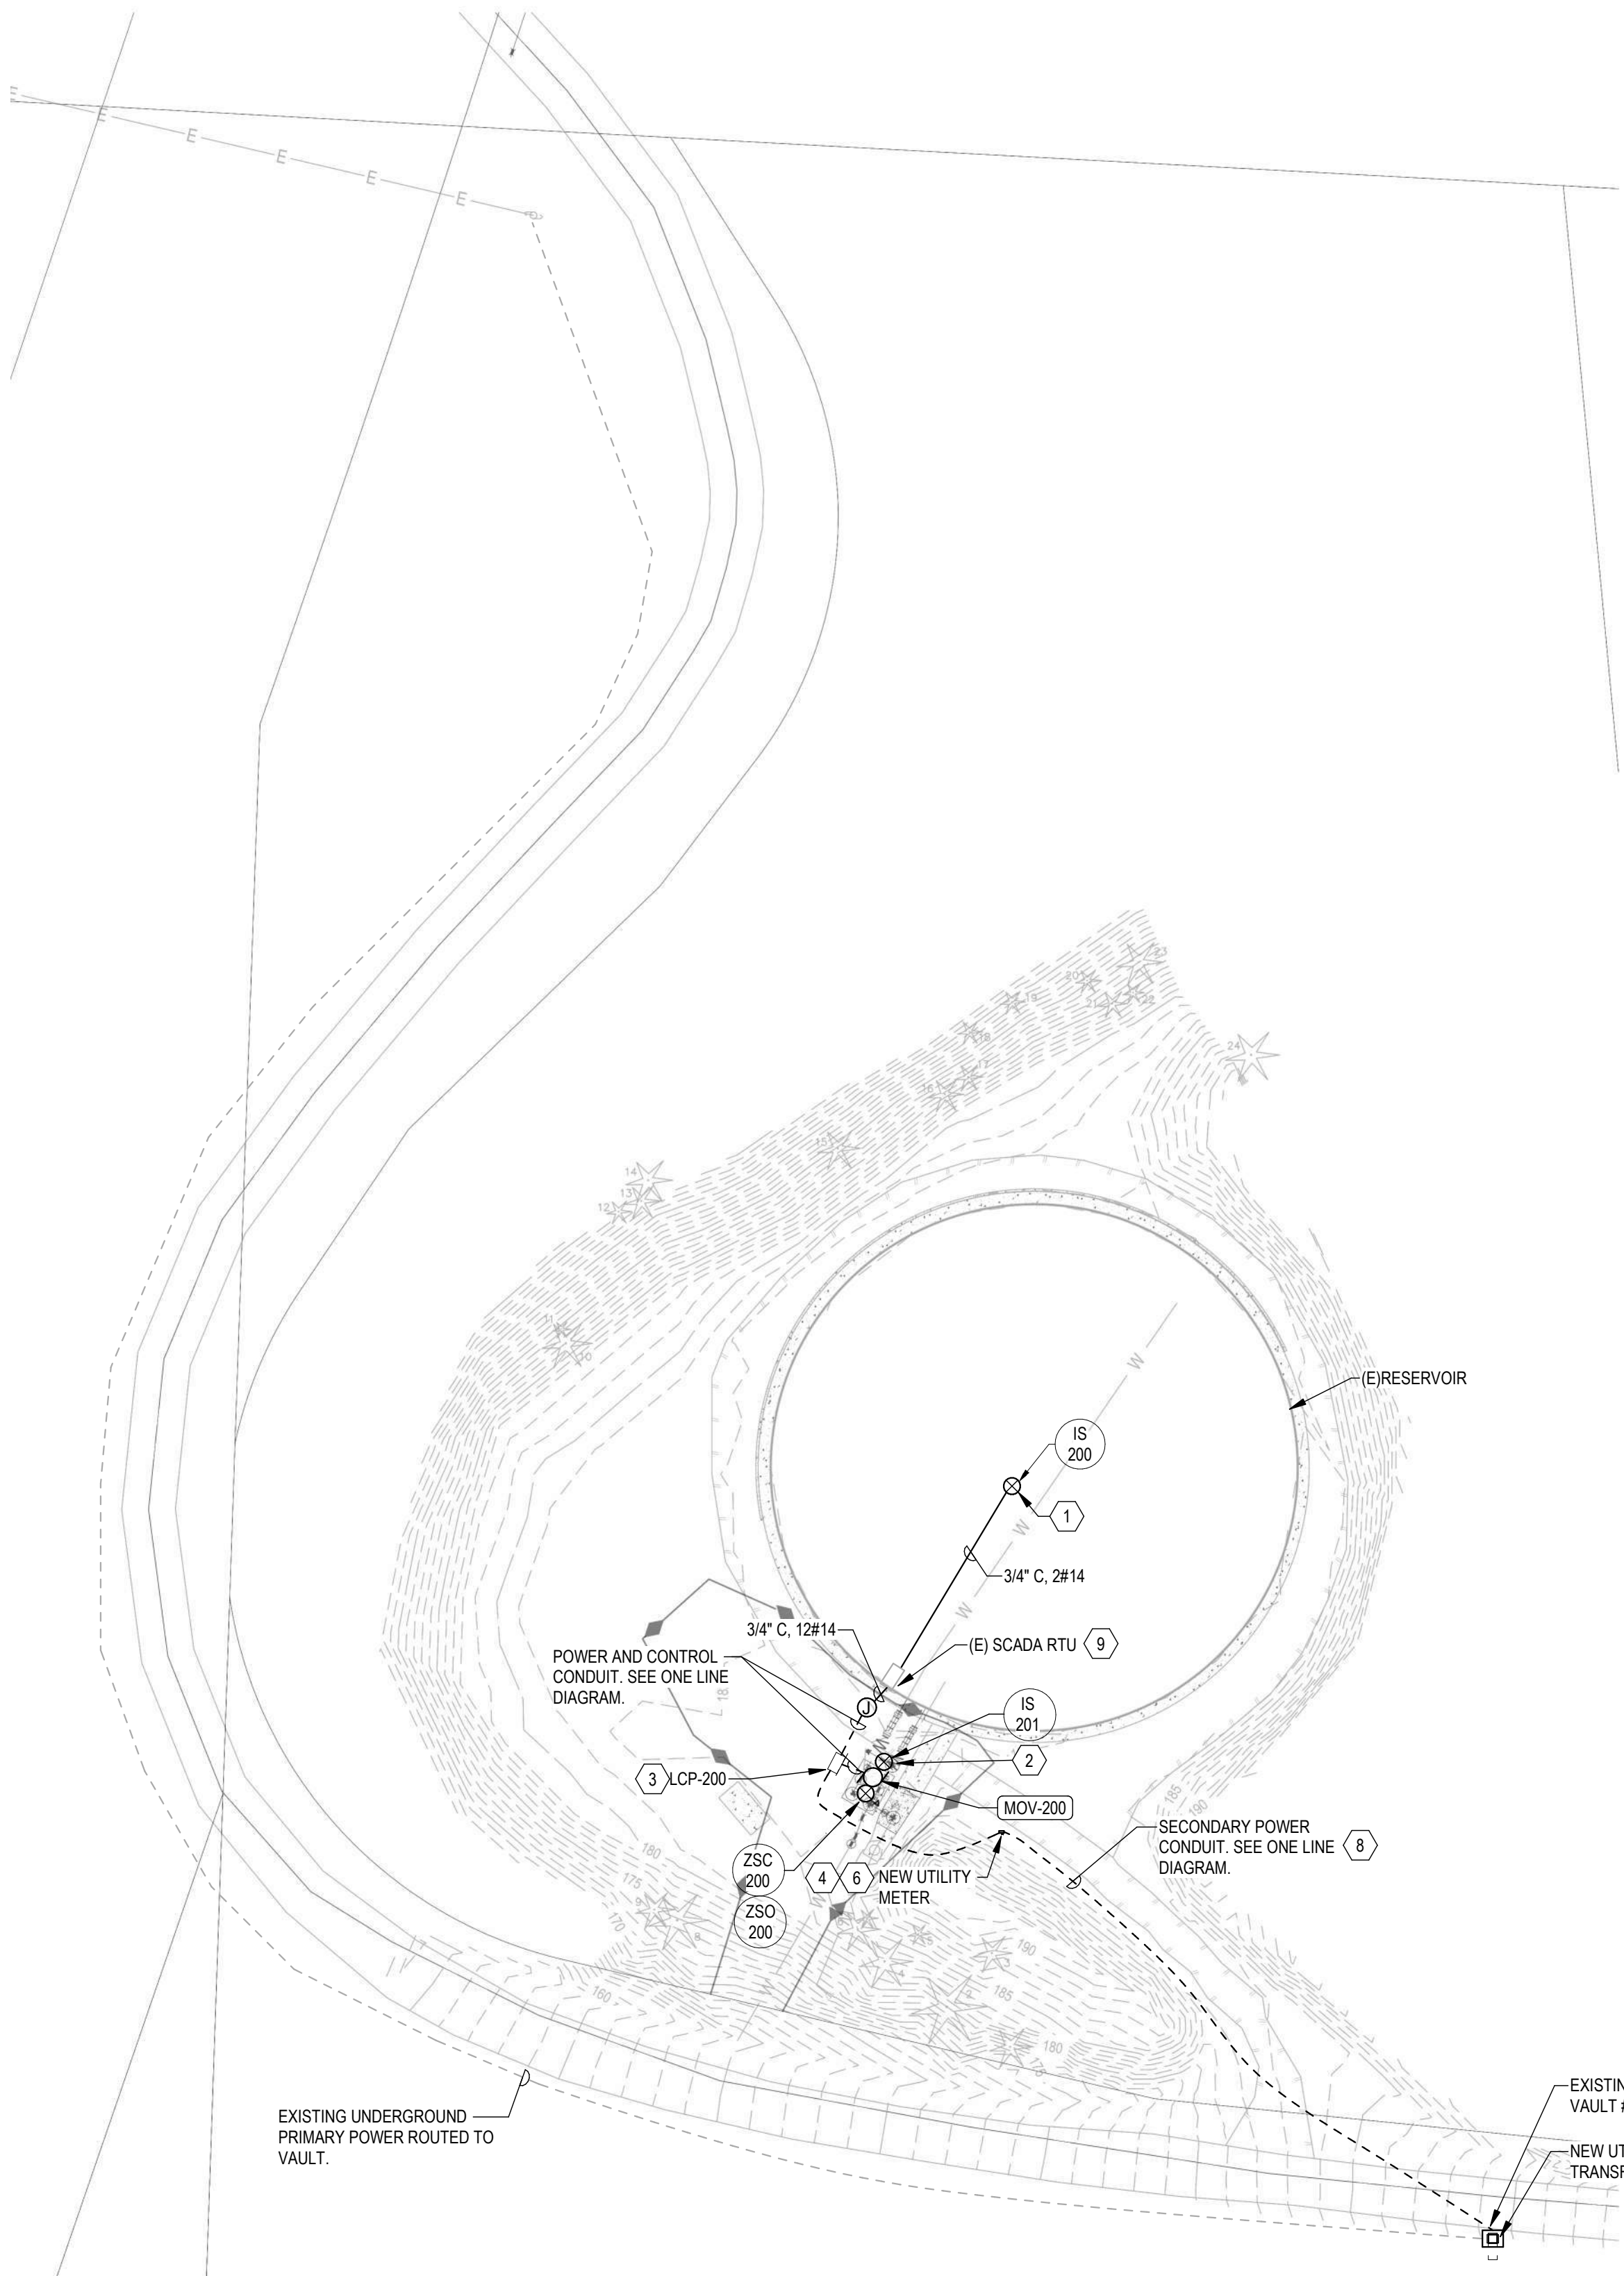

1 SOUTH/TOLOVANA RESERVOIR SITE PLAN
SCALE: 1/32" = 1'-0"


GENERAL SHEET NOTES

- A. EXISTING ELECTRICAL AND INSTRUMENTATION EQUIPMENT IS APPROXIMATE. CONTRACTOR TO VERIFY EXACT LOCATIONS.
B. REFER TO GENERAL SHEET DRAWINGS G004, G005, AND G006 FOR SITE LOCATIONS AND KEY PLANS.
C. ALL UNDERGROUND CONDUITS SHALL BE A MINIMUM OF 24" BELOW GRADE.
D. ALL CONDUIT SHALL HAVE MINIMUM 12" OF SEPARATION FROM ANY OTHER COMMUNICATION OR GAS FACILITIES AND SHALL BE MINIMUM OF 36" FROM ANY WATER OR SEWER LINES.
E. GRAY LINES INDICATE EXISTING TO REMAIN. BOLD LINES INDICATE NEW SCOPE.
F. DASHED CONDUIT LINETYPE INDICATES UNDERGROUND ROUTING. COORDINATE NEW UNDERGROUND CONDUITS WITH EXISTING CONDITIONS.

KEYNOTES


- 1 PROVIDE RESERVOIR INTRUSION SWITCH. SEE INSTALLATION DETAIL ON SHEET E501. INTRUSION SWITCH SHALL BE WIRED TO EXISTING MISSION SCADA RTU TO MONITOR SWITCH STATUS.
2 PROVIDE VAULT INTRUSION SWITCH. SEE INSTALLATION DETAIL ON SHEET E501. INTRUSION SWITCH SHALL BE WIRED TO EXISTING MISSION SCADA RTU TO MONITOR SWITCH STATUS.
3 SEE DETAIL SHEET E501. FIELD COORDINATE EXACT LOCATION.
4 INSTALL UTILITY METER PER PACIFICORP REQUIREMENTS. SEE DETAIL ON SHEET E502.
5 SEE SHEET E501 FOR DIVISION OF RESPONSIBILITY MATRIX.
6 FIELD COORDINATE EXACT LOCATION WITH CITY AND PACIFICORP.
7 CONNECT TO EXISTING PULL BOX PER PACIFICORP REQUIREMENTS. FURNISH NEW TRANSFORMER VAULT LID PER REQUIREMENTS ON SHEET E502. STORE NEW LID ON SITE NEAR VAULT TO BE INSTALLED BY PACIFICORP.
8 COORDINATE FINAL CONDUIT AND TRENCHING ROUTING WITH CITY OF CANNON BEACH WATER DEPARTMENT PRIOR TO INSTALLATION.
9 EXISTING SCADA RTU IS MISSION MYDRO 850. REFER TO MANUFACTURER INSTALLATION INSTRUCTIONS TO ACCOMMODATE ADDITIONAL INPUTS AND OUTPUTS. SCADA AND VALVE PROGRAMMING BY CONTRACTOR.

SOUTH RESERVOIR QUANTITIES		
ITEM	UNITS	QUANTITY
SHAKE ALARM CONTROL	EA	0
MODIFY EXISTING SCADA IMISSION RTU	EA	1
MISSION RTU RADIO BACKUP	EA	1
CONNECT TO METER	EA	1
EQUIPMENT STAND	EA	1
3/4" CONDUIT	LF	180
1" CONDUIT	LF	40
#14 WIRE	LF	500
POWER SUPPLY WITH ELECTRICAL BOX	LF	700
INTRUSION SWITCHES	EA	3

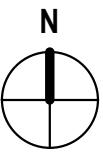


Know what's **below.**
Call before you dig.
CALL 2 BUSINESS DAYS BEFORE YOU DIG.
CAUTION: UTILITY INFORMATION IS APPROXIMATE.
VERIFY ALL UTILITIES PRIOR TO CONSTRUCTION.

Revisions:

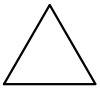

1	8/24/2023	ADDENDUM #1
4	8/28/2023	ADDENDUM #4

LINE IS 1" ON FULL
SCALE DRAWING

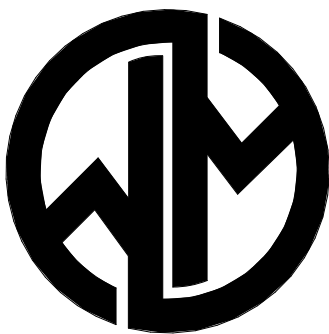

WINDSOR ENGINEERS

Ridgefield, WA
Duluth + Minneapolis, MN
www.windsorengineers.com
Project No: 20198.3

Copyright 2023 By Windsor Engineers, LLC
All Rights Reserved.



EXPIRES: 06/30/24

WATER RESILIENCY PROJECT
PHASE 1 - SEISMIC IMPROVEMENTS
CITY OF CANNON BEACH, OR 97110


ENGINEERING PLAN

Issue Date: 7/14/2023

Project Manager TWT
Drawn by JRB
Checked by SEW

SITE PLAN -
SOUTH/TOLOVANA
RESERVOIR

E102

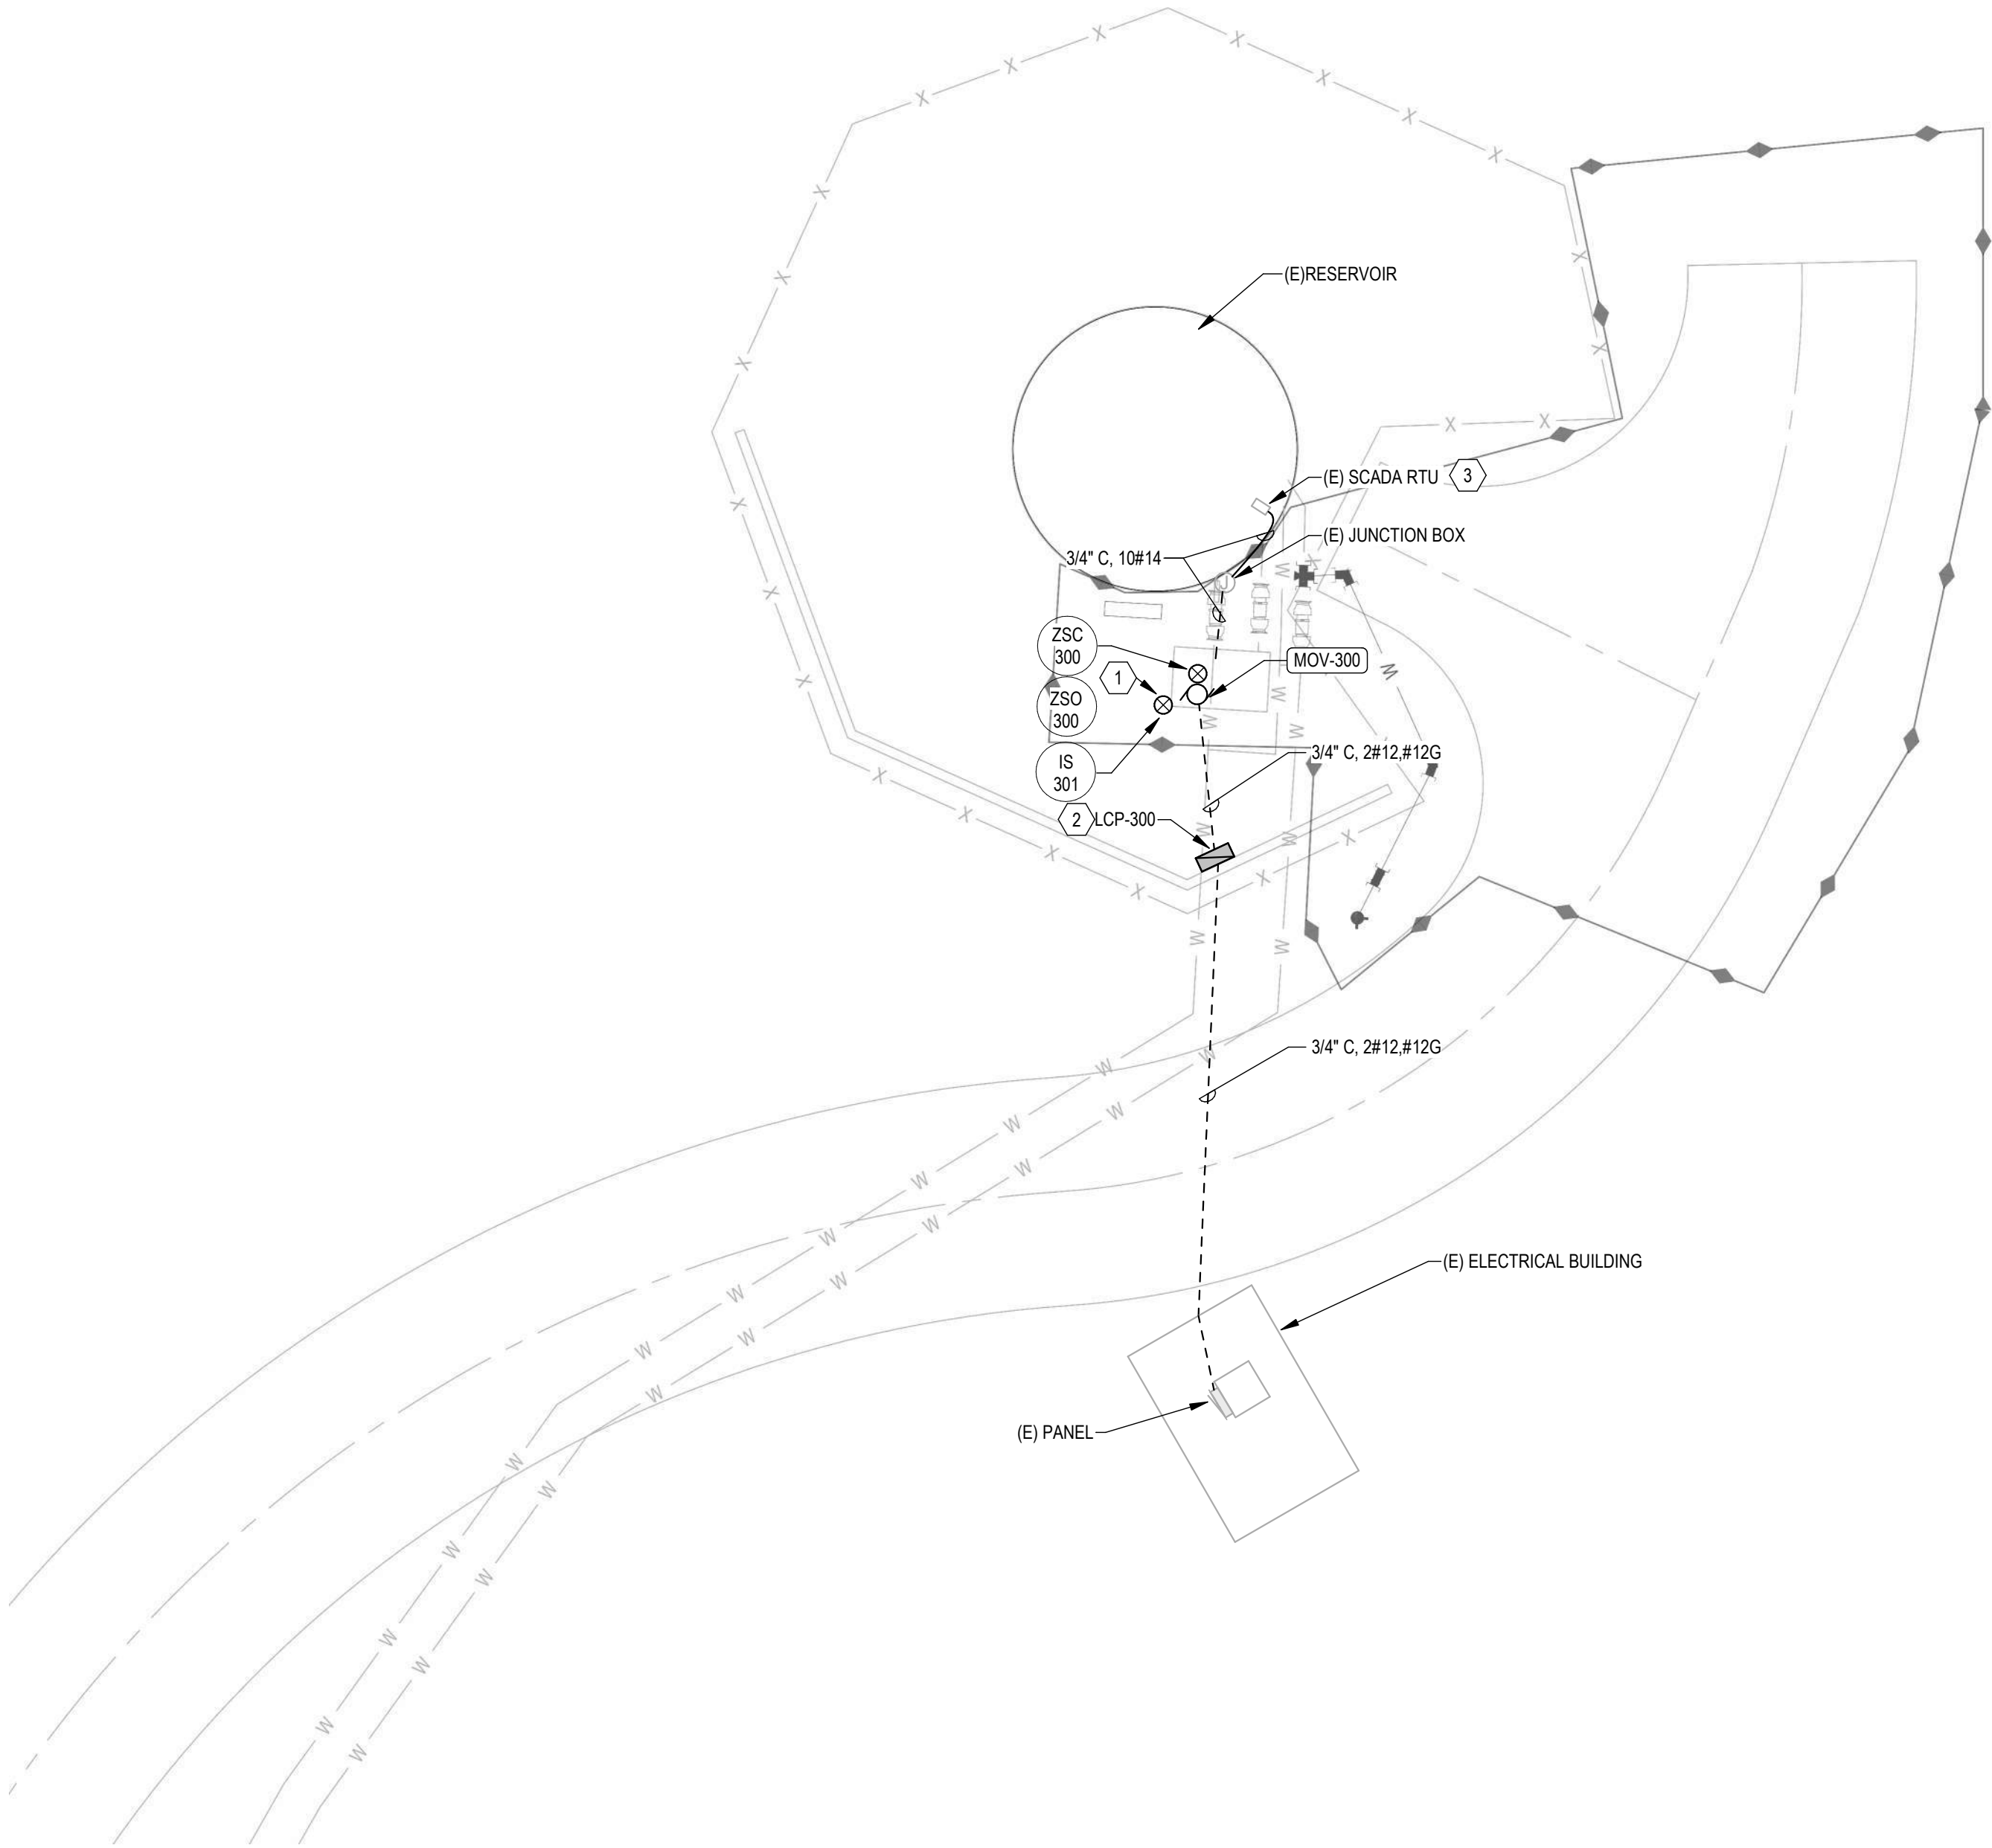

1 NORTH RESERVOIR SITE PLAN
SCALE: 1/8" = 1'-0"


GENERAL SHEET NOTES

- A. EXISTING ELECTRICAL AND INSTRUMENTATION EQUIPMENT IS APPROXIMATE. CONTRACTOR TO VERIFY EXACT LOCATIONS.
B. REFER TO GENERAL SHEET DRAWINGS G004, G005, AND G006 FOR SITE LOCATIONS AND KEY PLANS.
C. ALL UNDERGROUND CONDUITS SHALL BE A MINIMUM OF 24" BELOW GRADE.
D. ALL CONDUIT SHALL HAVE MINIMUM 12" OF SEPARATION FROM ANY OTHER COMMUNICATION OR GAS FACILITIES AND SHALL BE MINIMUM OF 36" FROM ANY WATER OR SEWER LINES.
E. GRAY LINES INDICATE EXISTING TO REMAIN. BOLD LINES INDICATE NEW SCOPE.
F. DASHED CONDUIT LINETYPE INDICATES UNDERGROUND ROUTING. COORDINATE NEW UNDERGROUND CONDUITS WITH EXISTING CONDITIONS.

KEYNOTES


1. PROVIDE VAULT INTRUSION SWITCH. SEE INSTALLATION DETAIL ON SHEET E501. INTRUSION SWITCH SHALL BE WIRED TO EXISTING MISSION SCADA RTU TO MONITOR SWITCH STATUS.
2. CONTROL PANEL MOUNTED TO EXISTING CONCRETE WALL. FINAL CONTROL PANEL LOCATION TO BE APPROVED BY OWNER/ENGINEER. PROVIDE 20A, 120V CIRCUIT TO LOCAL CONTROL PANEL FROM EXISTING PANEL.
3. EXISTING SCADA RTU IS MISSION MYDRO 850. REFER TO MANUFACTURER INSTALLATION INSTRUCTIONS TO ACCOMMODATE ADDITIONAL INPUTS AND OUTPUTS. SCADA AND VALVE PROGRAMMING BY CONTRACTOR.

NORTH RESERVOIR QUANTITIES		
ITEM	UNITS	QUANTITY
SHAKE ALARM CONTROL	EA	0
MODIFY EXISTING SCADA MISSION RTU	EA	1
MISSION RTU RADIO BACKUP	EA	1
CONNECT TO METER	EA	1
EQUIPMENT STAND	EA	1
3/4" CONDUIT	LF	120
1" CONDUIT	LF	80
#14 WIRE	LF	1000
POWER SUPPLY WITH ELECTRICAL BOX	LF	0
INTRUSION SWITCHES	EA	3

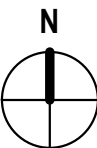

Know what's **below.**
Call before you dig.
CALL 2 BUSINESS DAYS BEFORE YOU DIG.
CAUTION: UTILITY INFORMATION IS APPROXIMATE.
VERIFY ALL UTILITIES PRIOR TO CONSTRUCTION.

Revisions:

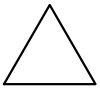

1	8/24/2023	ADDENDUM #1
4	8/28/2023	ADDENDUM #4

LINE IS 1" ON FULL
SCALE DRAWING



WINDSOR ENGINEERS

Ridgefield, WA
Duluth + Minneapolis, MN
www.windsorengineers.com
Project No: 20198.3

Copyright 2023 By Windsor Engineers, LLC
All Rights Reserved.



WATER RESILIENCY PROJECT
PHASE 1 - SEISMIC IMPROVEMENTS
CITY OF CANNON BEACH, OR 97110

ENGINEERING PLAN
Issue Date: 7/14/2023

Project Manager: TWT
Drawn by: JRB
Checked by: SEW

SITE PLAN - NORTH
RESERVOIR

E103

1

The supply for location 3339 S Hemlock St.:

- Looks like the proposed SW corner of S Hemlock & Fernwood St. my map is showing existing underground secondary voltage facilities but I will need to verify what's available to use and exact location. Worst case we have a pole on that corner and also a pole to the West that would work. We would bill you for (1) service riser for this location or any modification's needed to existing underground facilities.
- **We will install a 2" riser on pole#319405 to your metered location.**
- **We will need 3 Flaggers at this location.**


GENERAL SHEET NOTES

- A. EXISTING ELECTRICAL AND INSTRUMENTATION EQUIPMENT IS APPROXIMATE. CONTRACTOR TO VERIFY EXACT LOCATIONS.
- B. REFER TO GENERAL SHEET DRAWINGS G004, G005, AND G006 FOR SITE LOCATIONS AND KEY PLANS.
- C. ALL UNDERGROUND CONDUITS SHALL BE A MINIMUM OF 24" BELOW GRADE.
- D. ALL CONDUIT SHALL HAVE MINIMUM 12" OF SEPARATION FROM ANY OTHER COMMUNICATION OR GAS FACILITIES AND SHALL BE MINIMUM OF 36" FROM ANY WATER OR SEWER LINES.
- E. GRAY LINES INDICATE EXISTING TO REMAIN. BOLD LINES INDICATE NEW SCOPE.
- F. DASHED CONDUIT LINETYPE INDICATES UNDERGROUND ROUTING. COORDINATE NEW UNDERGROUND CONDUITS WITH EXISTING CONDITIONS.

KEYNOTES

- 1 SEE DETAIL SHEET E501. COORDINATE EXACT LOCATION WITH UTILITY AND CITY OF CANNON BEACH.
- 2 SEE SHEET E601 FOR DIVISION OF RESPONSIBILITY MATRIX AND SHEET E501 FOR INSTALLATION DETAIL. INSTALL SWEEP 7-1/2" FROM POLE. RED CAUTION TAPE SHALL BE INSTALLED 12 TO 18 INCHES ABOVE ALL ELECTRICAL CONDUITS. 3M SCOTCH #368 OR EQUIVELENT.

ISOLATION VALVE 4 QUANTITIES		
ITEM	UNITS	QUANTITY
CONNECT TO METER	EA	1
CONTROL PANEL	EA	1
CABINET	EA	1
1" CONDUIT	LF	40
3" - 20' POLE	EA	1
#14 WIRE	LF	320

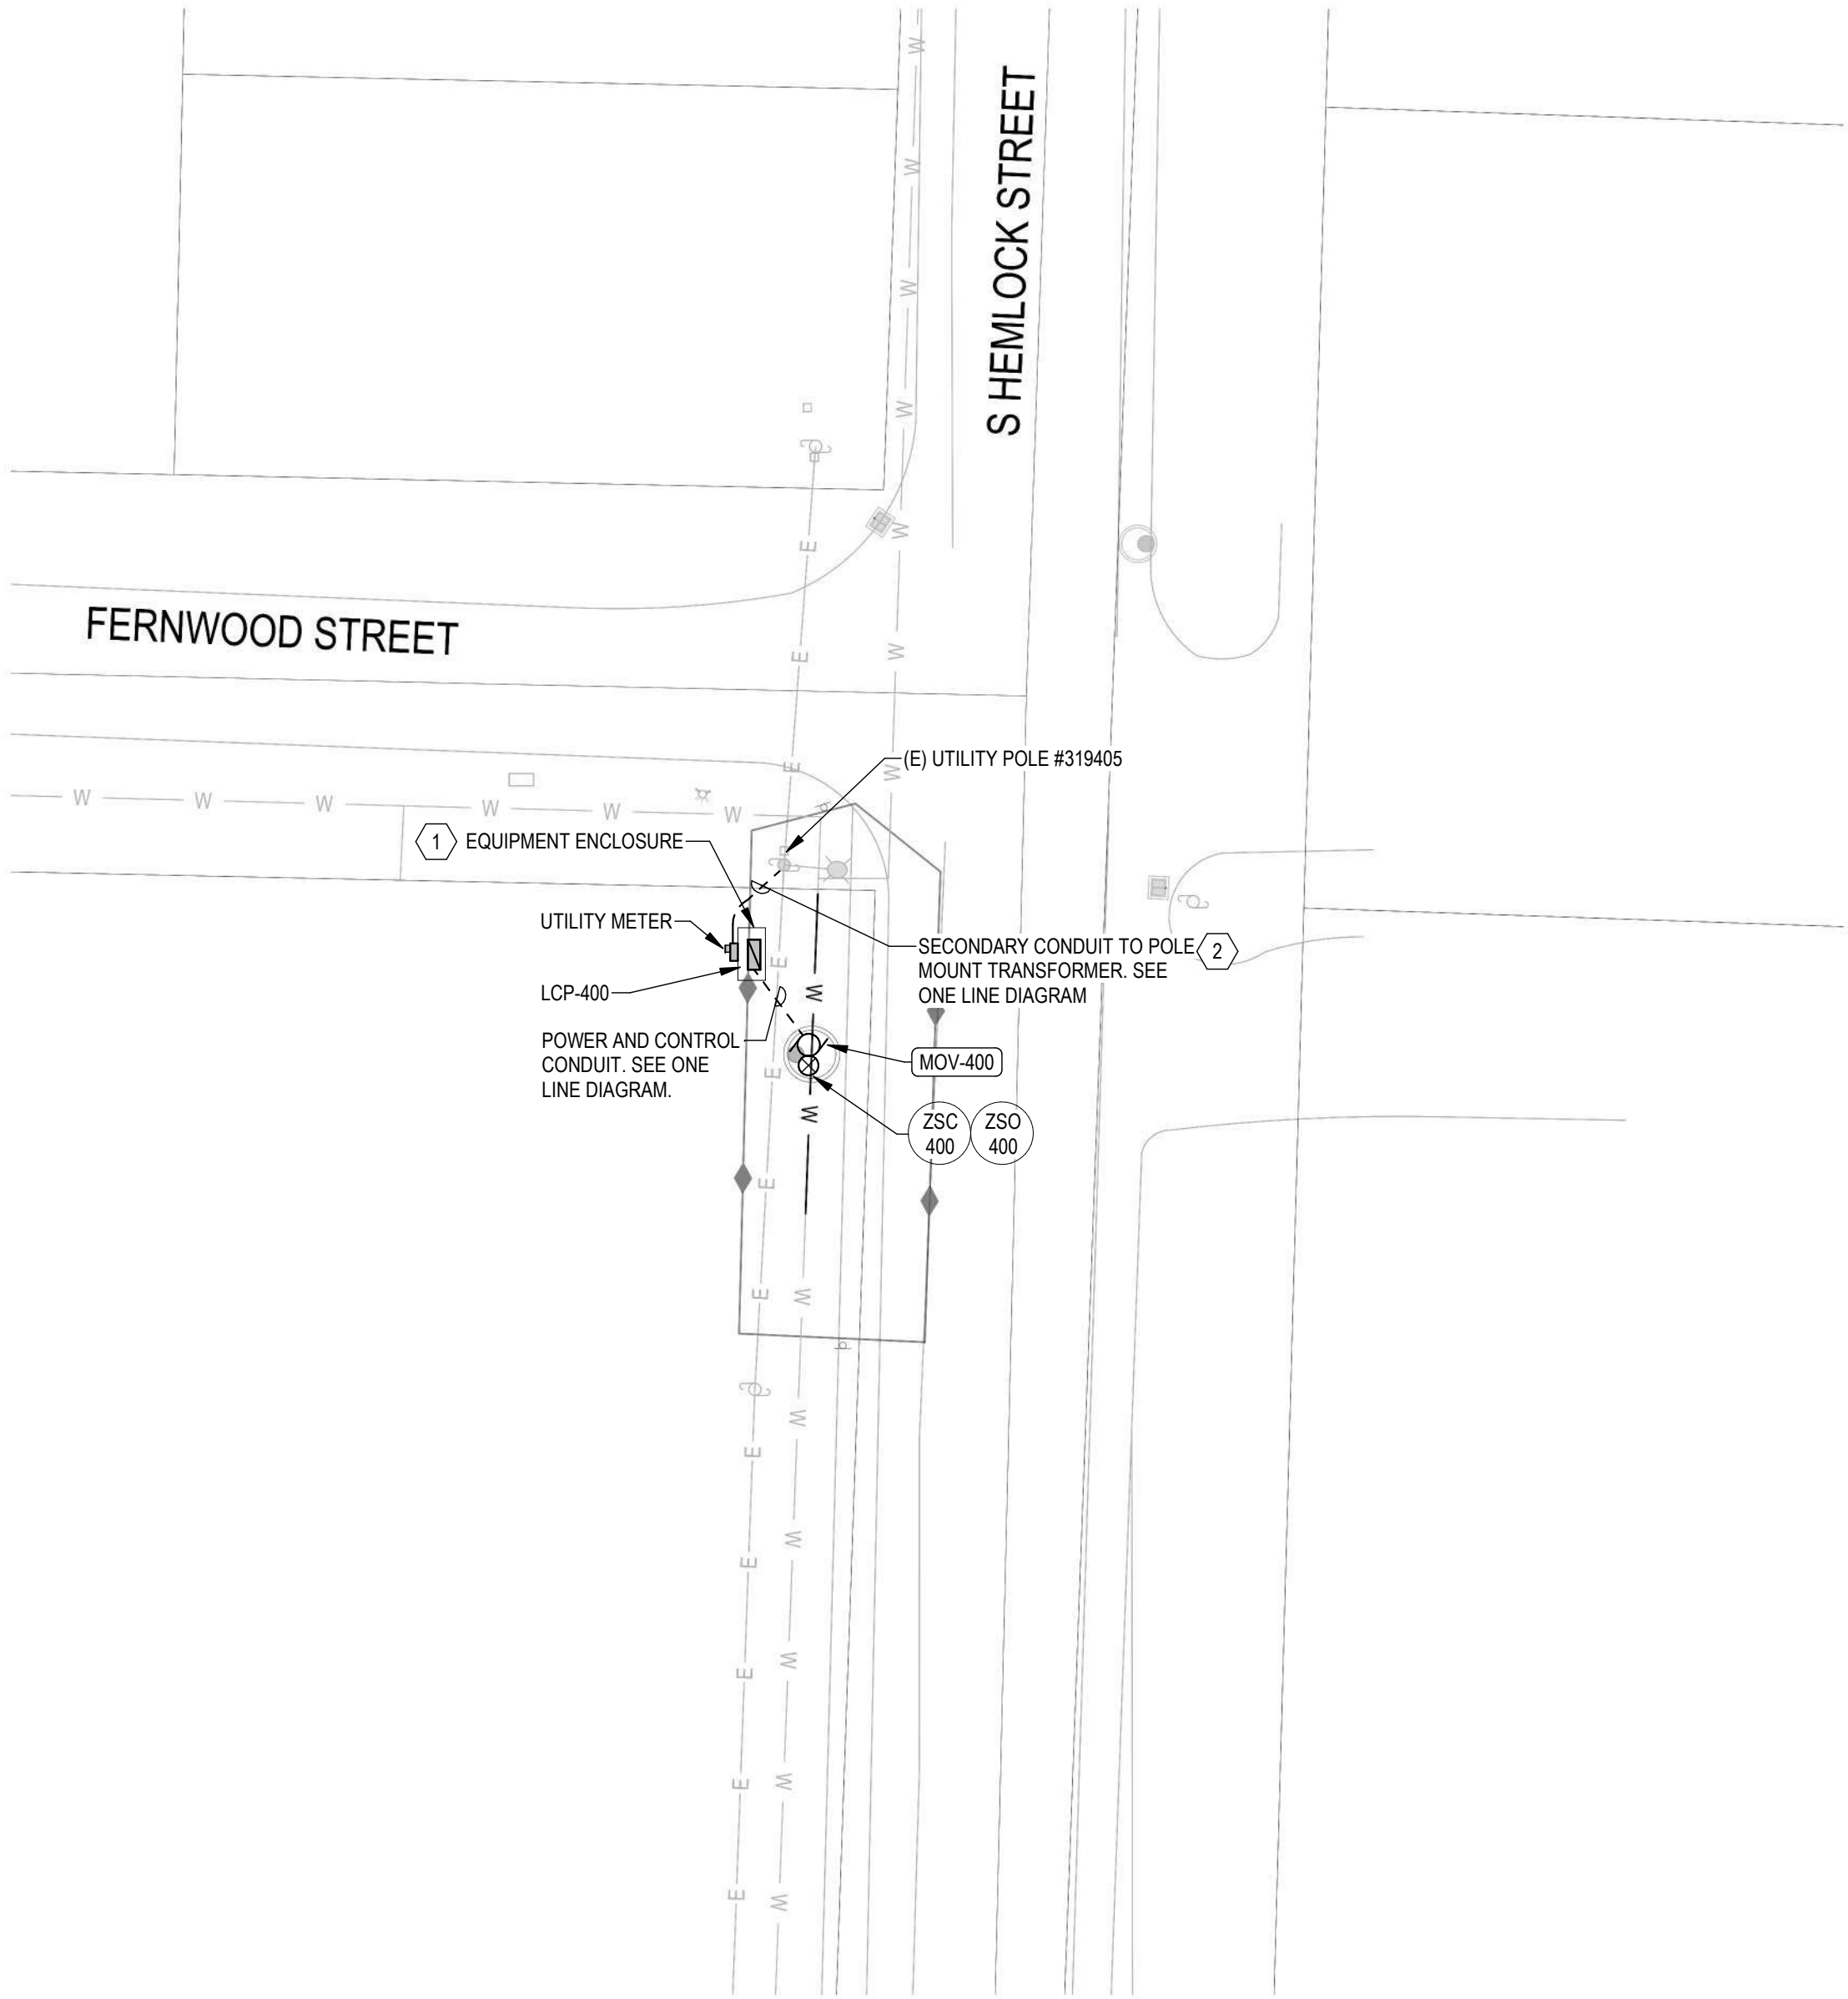


1 ISOLATION VALVE 4
SCALE: 3/32" = 1'-0"



Know what's **below.**
Call before you dig.
CALL 2 BUSINESS DAYS BEFORE YOU DIG.
CAUTION: UTILITY INFORMATION IS APPROXIMATE.
VERIFY ALL UTILITIES PRIOR TO CONSTRUCTION.

Revisions:

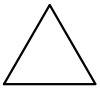

1	8/24/2023	ADDENDUM #1
4	8/28/2023	ADDENDUM #4

LINE IS 1" ON FULL
SCALE DRAWING



WINDSOR ENGINEERS

Ridgefield, WA
Duluth + Minneapolis, MN
www.windsorengineers.com
Project No: 20198.3
Copyright 2023 By Windsor Engineers, LLC
All Rights Reserved.




WATER RESILIENCY PROJECT
PHASE 1 - SEISMIC IMPROVEMENTS
CITY OF CANNON BEACH, OR 97110


ENGINEERING PLAN
Issue Date: 7/14/2023

Project Manager TWT
Drawn by JRB
Checked by SEW

SITE PLAN ISOLATION
VALVE 4


E204

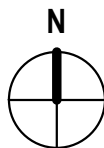

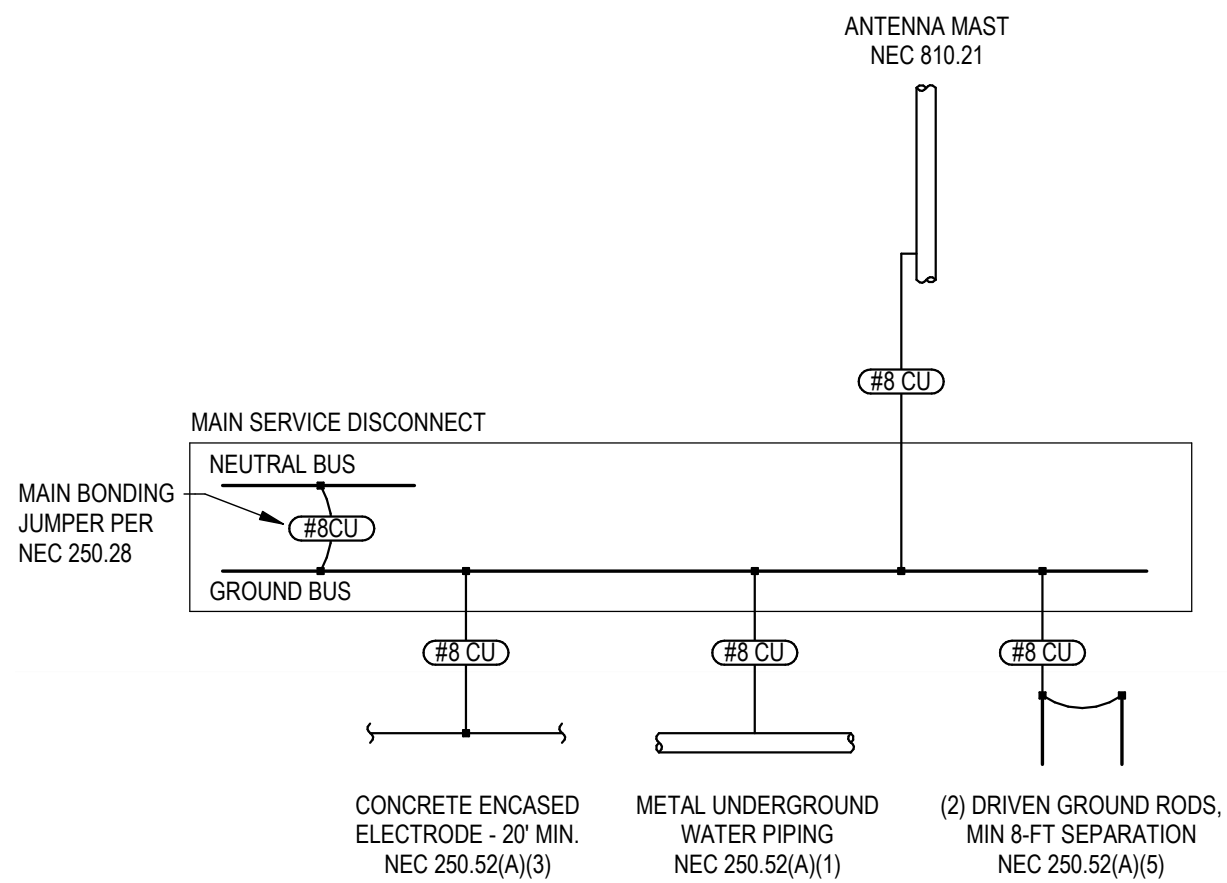


6 GROUNDING DIAGRAM
NOT TO SCALE

Figure 24—Underground Service to Dwellings with Permanent Foundations

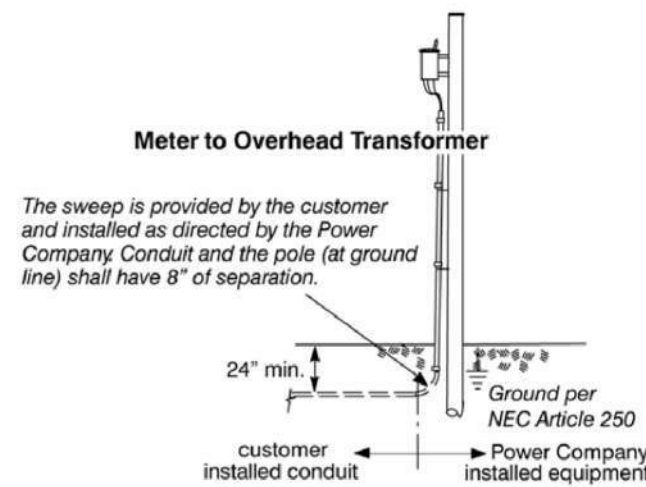


This manual shall be distributed and interpreted in its entirety. Individual pages will not represent all the requirements necessary for an installation. Printed versions of this document may be out of date. Please consult the Power Company websites for the most recent version. © 2022 PacifiCorp.


5 POLE CONDUIT INSTALLATION DETAIL
NOT TO SCALE

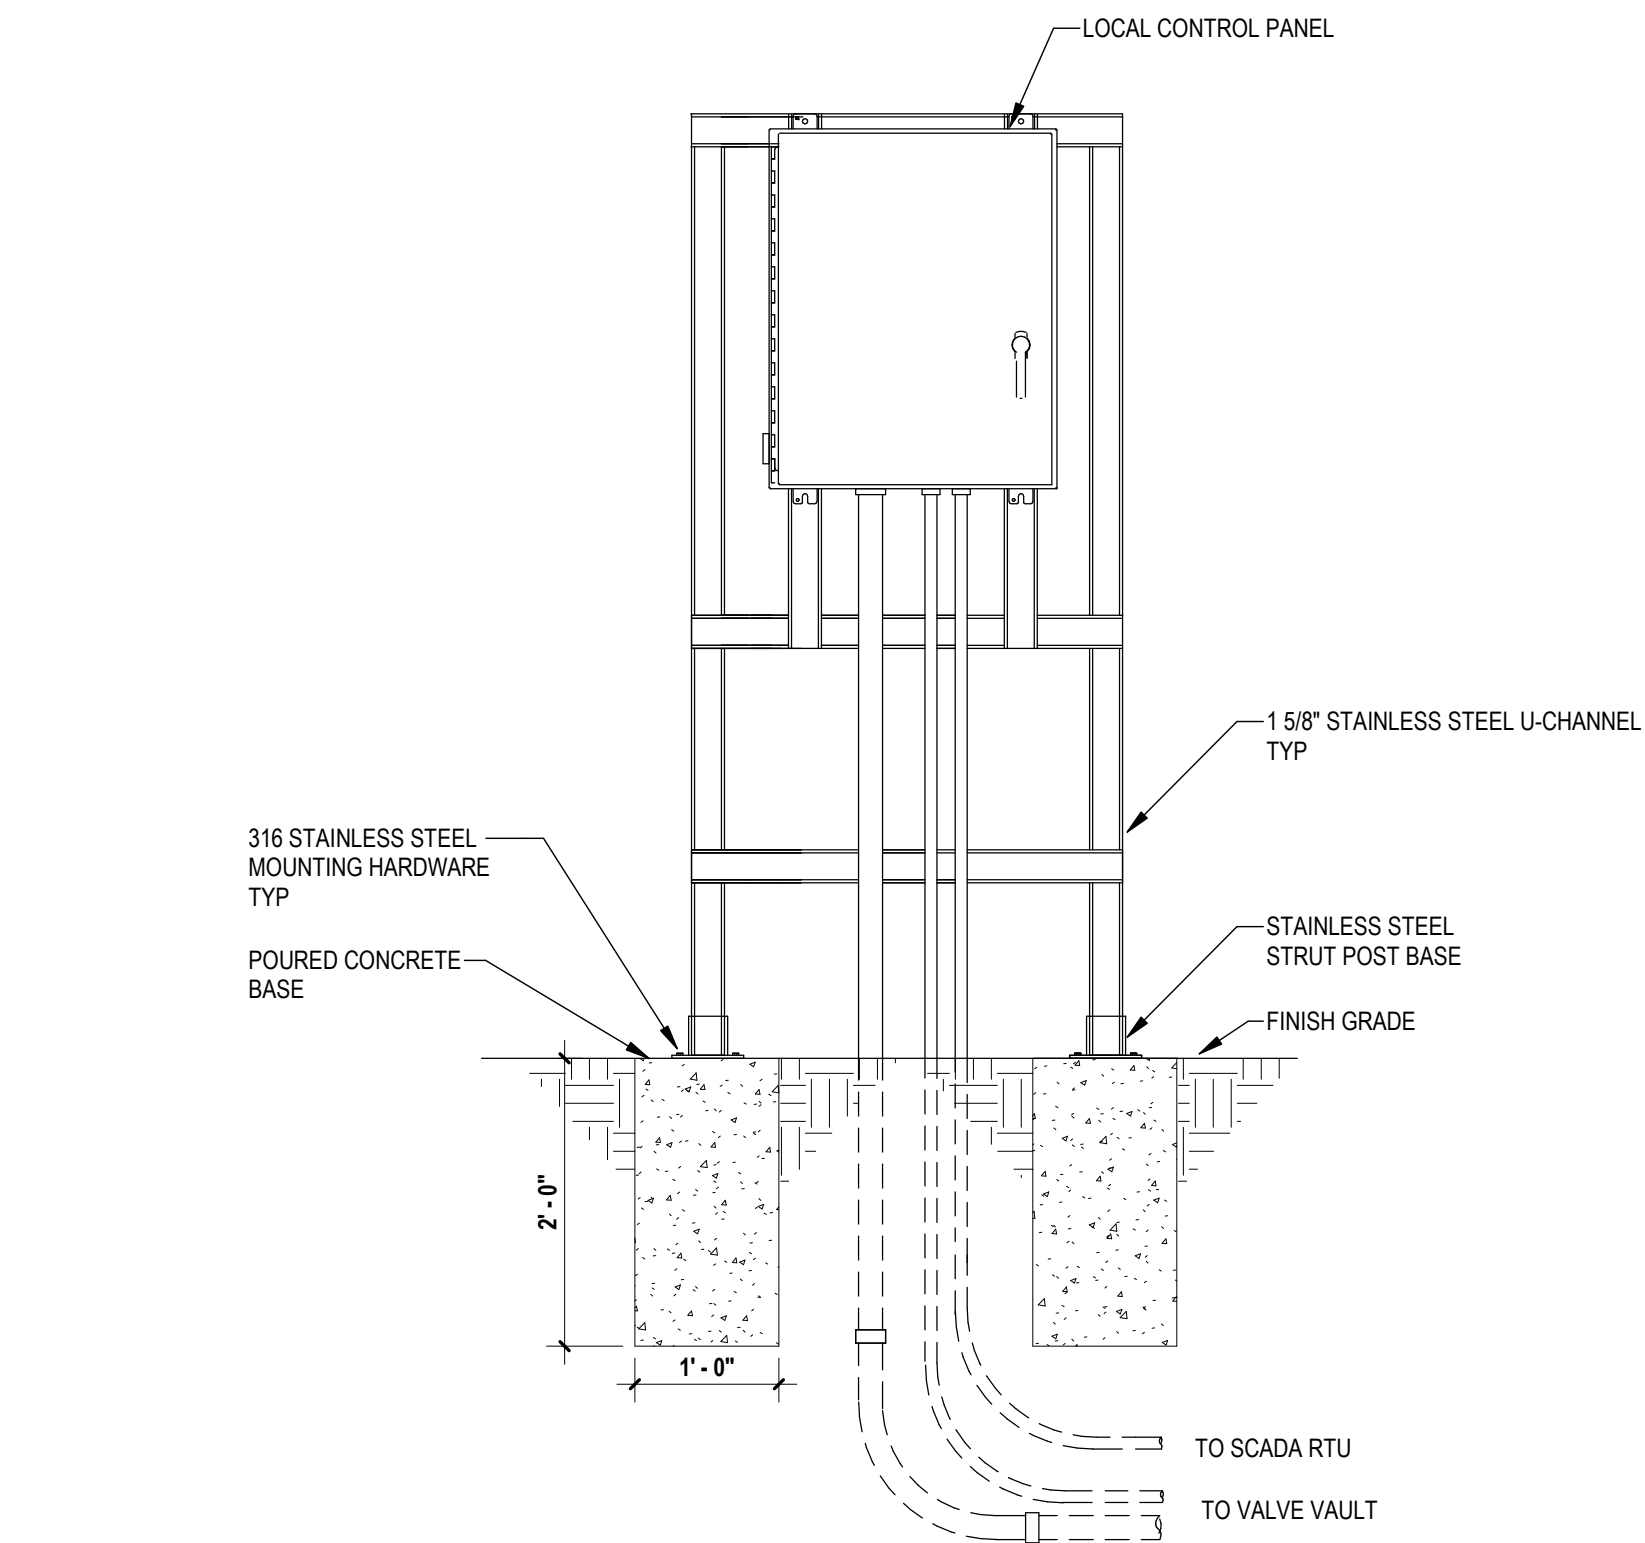

2 LOCAL CONTROL PANEL INSTALLATION
NOT TO SCALE

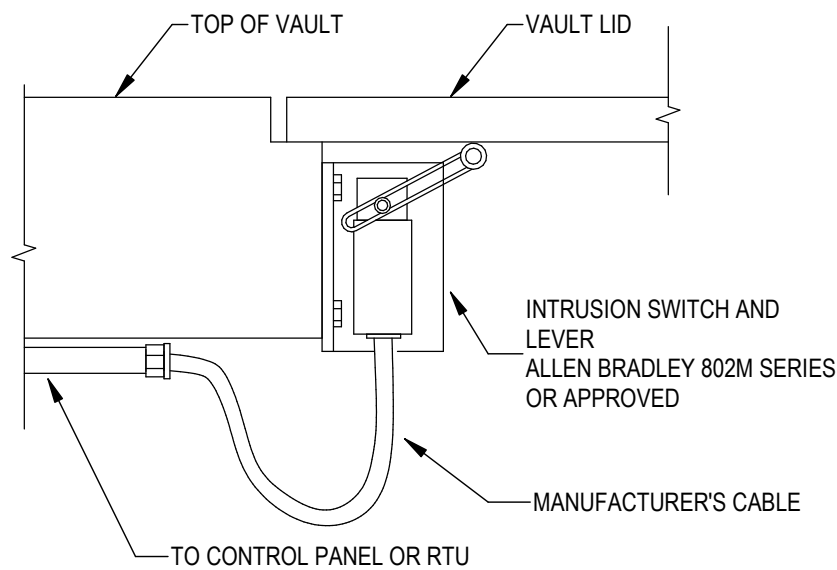


4 VAULT INTRUSION SWITCH INSTALLATION
NOT TO SCALE

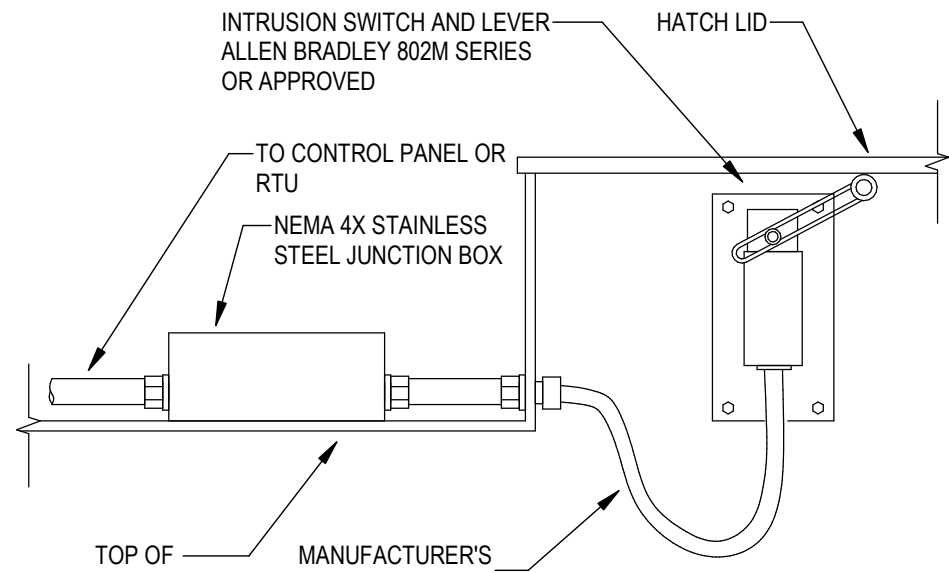

* ALL MOUNTING HARDWARE SHALL BE 316 STAINLESS STEEL

3 RESERVOIR INTRUSION SWITCH INSTALLATION
NOT TO SCALE

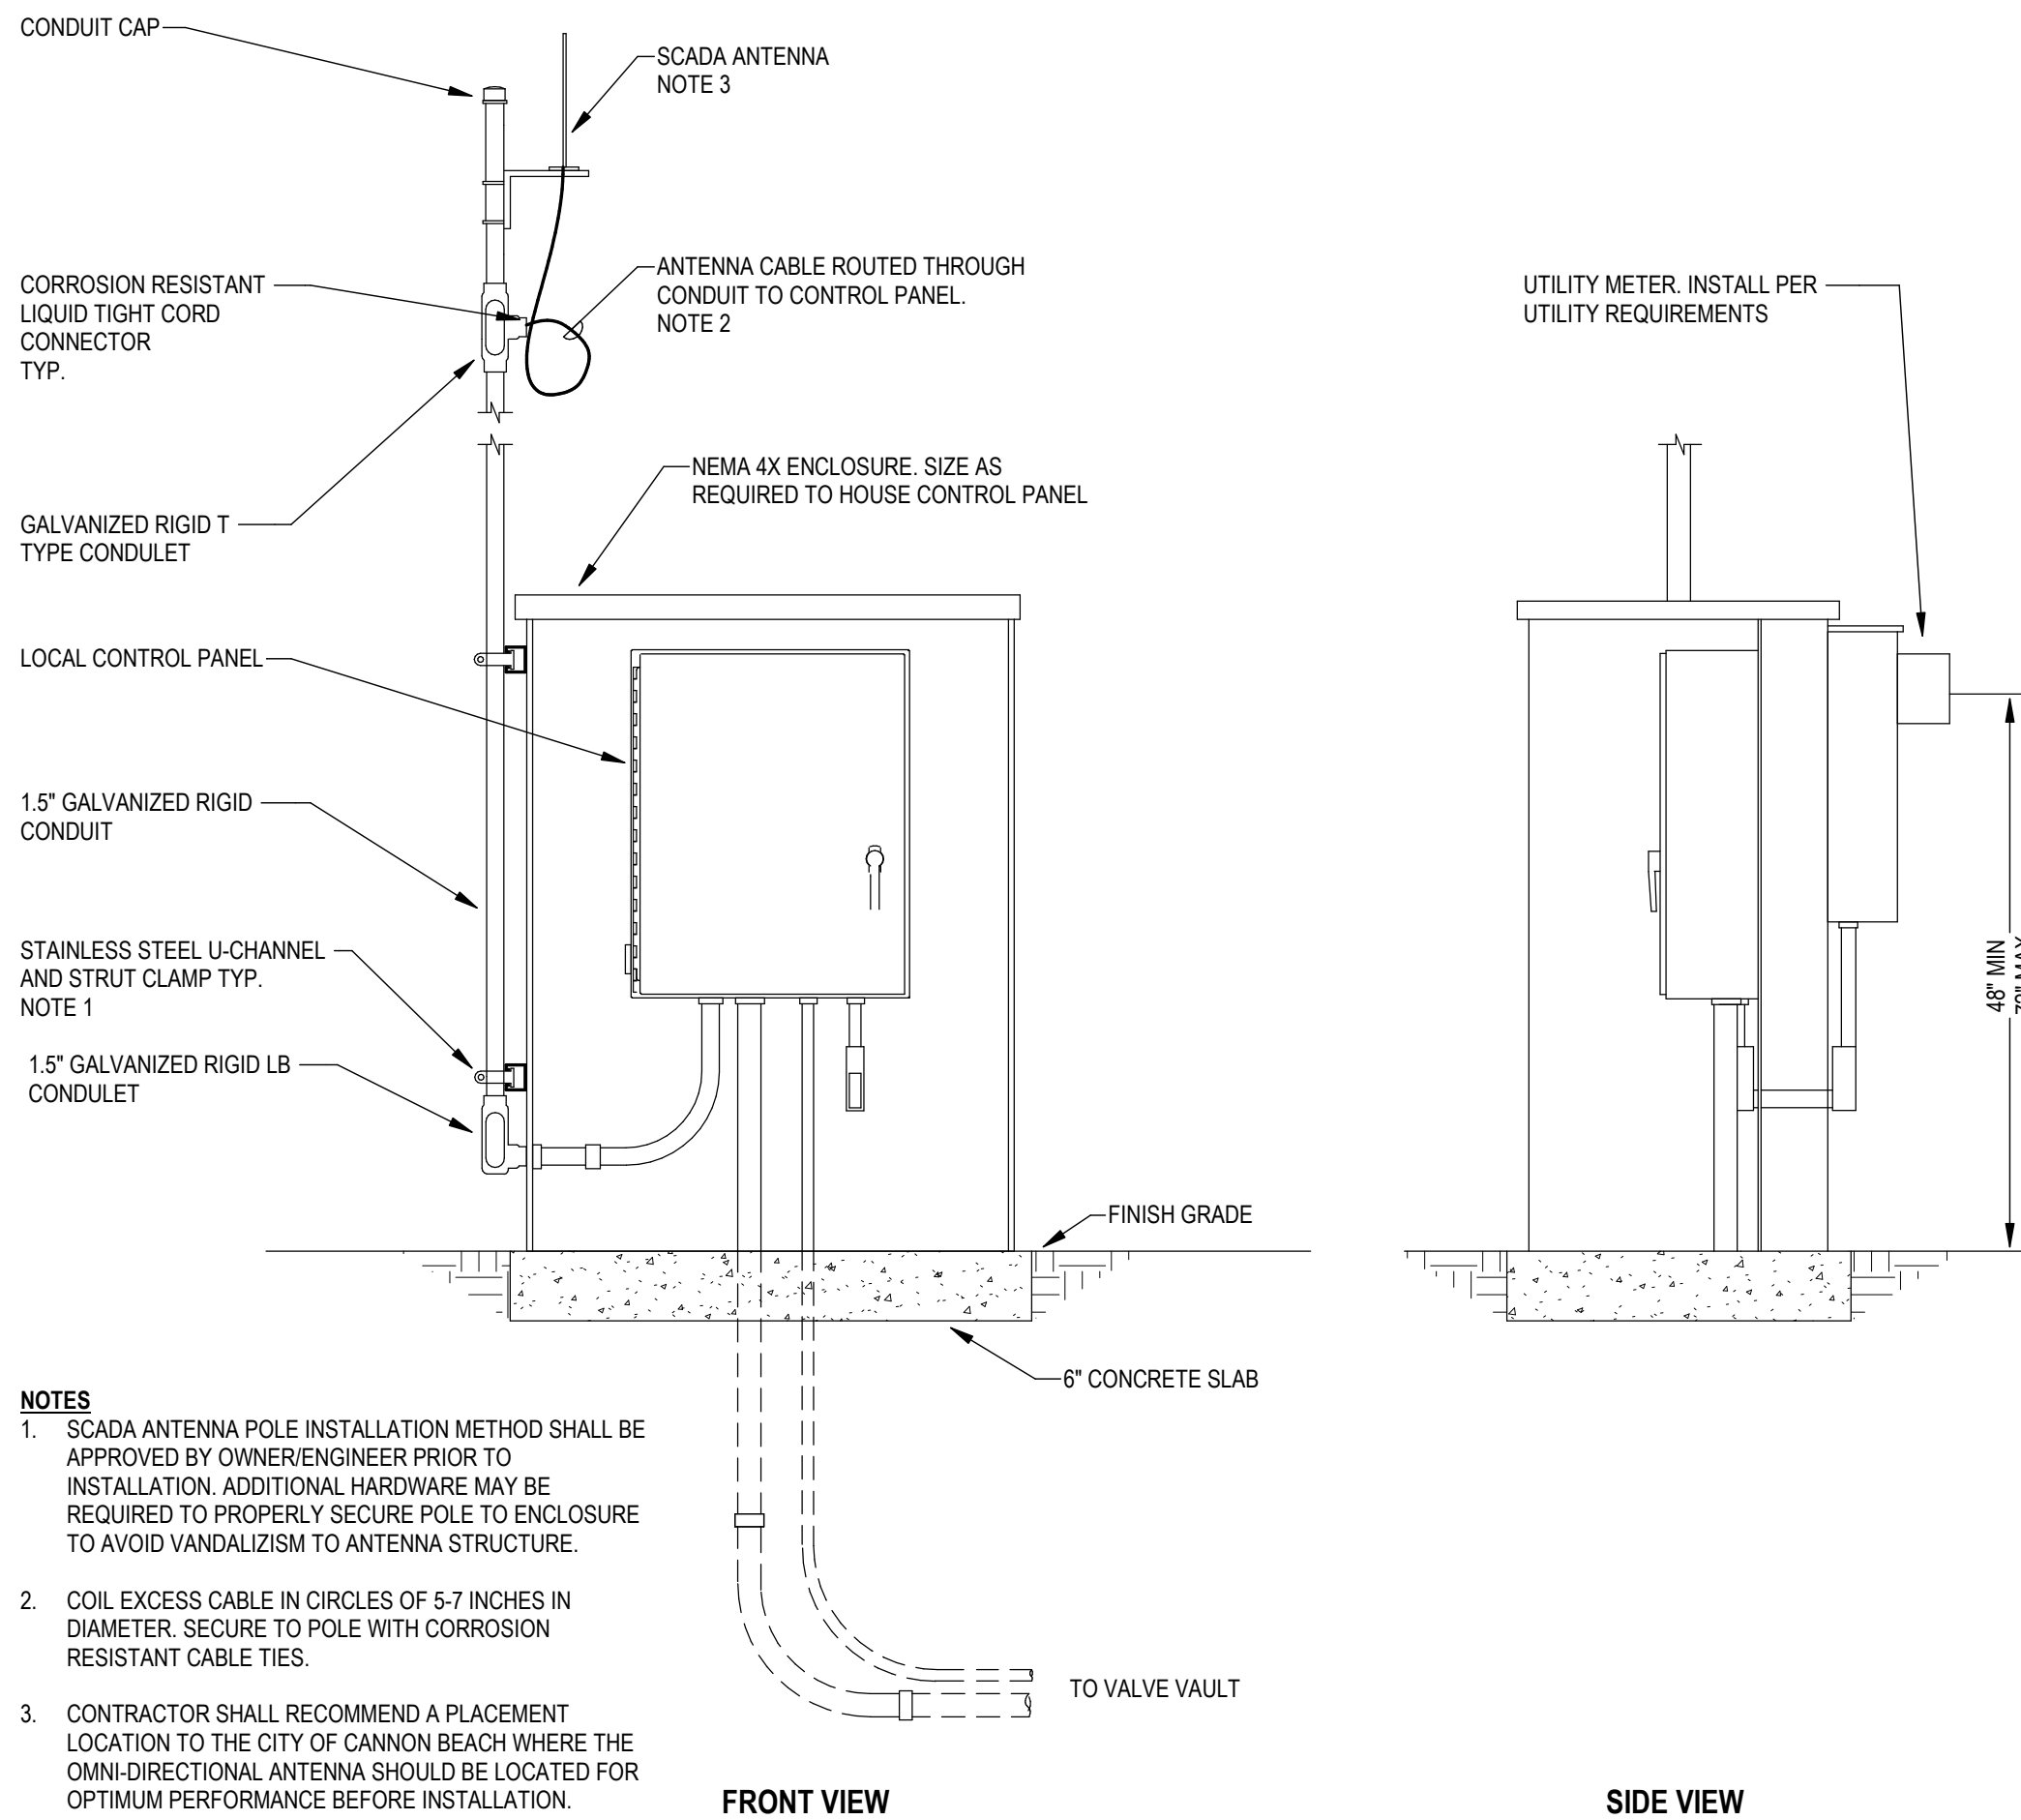

- NOTES**
- SCADA ANTENNA POLE INSTALLATION METHOD SHALL BE APPROVED BY OWNER/ENGINEER PRIOR TO INSTALLATION. ADDITIONAL HARDWARE MAY BE REQUIRED TO PROPERLY SECURE POLE TO ENCLOSURE TO AVOID VANDALISM TO ANTENNA STRUCTURE.
 - COIL EXCESS CABLE IN CIRCLES OF 5-7 INCHES IN DIAMETER. SECURE TO POLE WITH CORROSION RESISTANT CABLE TIES.
 - CONTRACTOR SHALL RECOMMEND A PLACEMENT LOCATION TO THE CITY OF CANNON BEACH WHERE THE OMNI-DIRECTIONAL ANTENNA SHOULD BE LOCATED FOR OPTIMUM PERFORMANCE BEFORE INSTALLATION.

1 ISOLATION VALVE EQUIPMENT ENCLOSURE
NOT TO SCALE



Know what's below.
Call before you dig.
CALL 2 BUSINESS DAYS BEFORE YOU DIG.
CAUTION: UTILITY INFORMATION IS APPROXIMATE.
VERIFY ALL UTILITIES PRIOR TO CONSTRUCTION.

Revisions:		
1	8/24/2023	ADDENDUM #1
4	8/28/2023	ADDENDUM #4

LINE IS 1" ON FULL
SCALE DRAWING



WINDSOR ENGINEERS
Ridgefield, WA
Duluth + Minneapolis, MN
www.windsorengineers.com
Project No: 20198.3
Copyright 2023 By Windsor Engineers, LLC
All Rights Reserved.



**WATER RESILIENCY PROJECT
PHASE 1 - SEISMIC IMPROVEMENTS**
CITY OF CANNON BEACH, OR 97110

ENGINEERING PLAN
Issue Date: 7/14/2023

Project Manager TWT
Drawn by JBB
Checked by SEW

DETAILS - ELECTRICAL

E501




Delivering Reliability

444-TRANS-SECT-PCORP

4 x 4, Single Phase Transformer / Sectionalizing Padvault, Stock Item 7999607

TOP
SINGLE PHASE TRANSFORMER / SECTIONALIZING
No. 44-1626-PCORP
PCORP #7999607
1,040 lbs.

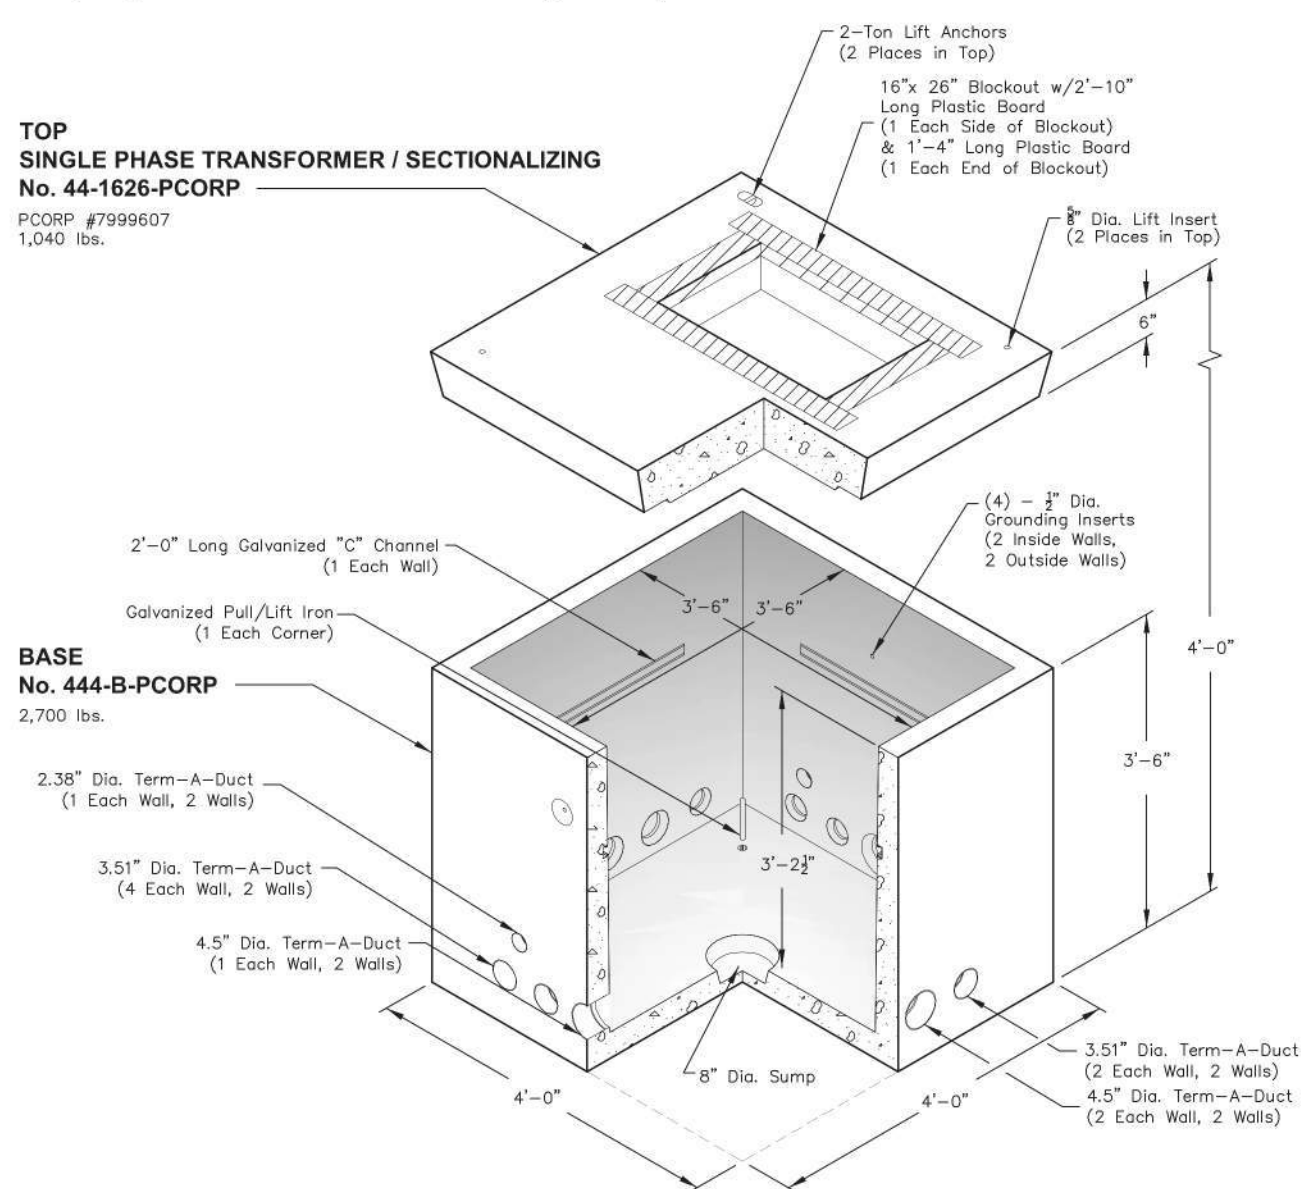

Scale: $1/2" = 1'-0"$

Non Skid Covers Available
FOR DETAILS, SEE REVERSE>>
 Items Shown Are Subject To Change Without Notice

43

© 2016 Oldcastle Precast, Inc.

Mailing Address: PO Box 588
Auburn, WA 98071

Phone: 800-892-1538
Fax: 253-735-4201
Email: opauburn@oldcastle.com

opauburn.com


2 TRANSFORMER VAULT DETAIL
NOT TO SCALE



Know what's **below**.
Call before you dig.


**CALL 2 BUSINESS DAYS BEFORE YOU DIG.
CAUTION UTILITY INFORMATION IS APPROXIMATE
VERIFY ALL UTILITIES PRIOR TO CONSTRUCTION.**

Revisions:

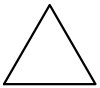

1	8/24/2023	ADDENDUM #1
4	8/28/2023	ADDENDUM #4

LINE IS 1" ON FULL
SCALE DRAWING

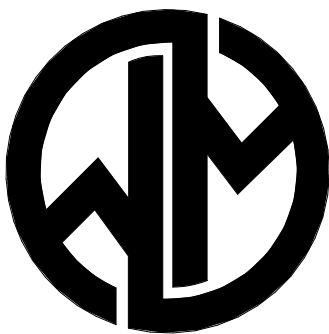

WINDSOR ENGINEERS


Ridgefield, WA
Duluth + Minneapolis, MN
www.windsorengineers.com
Project No: 20198.3

Copyright 2023 By Windsor Engineers, LLC
All Rights Reserved.




Delivering Reliability

444-TRANS-SECT-PCORP

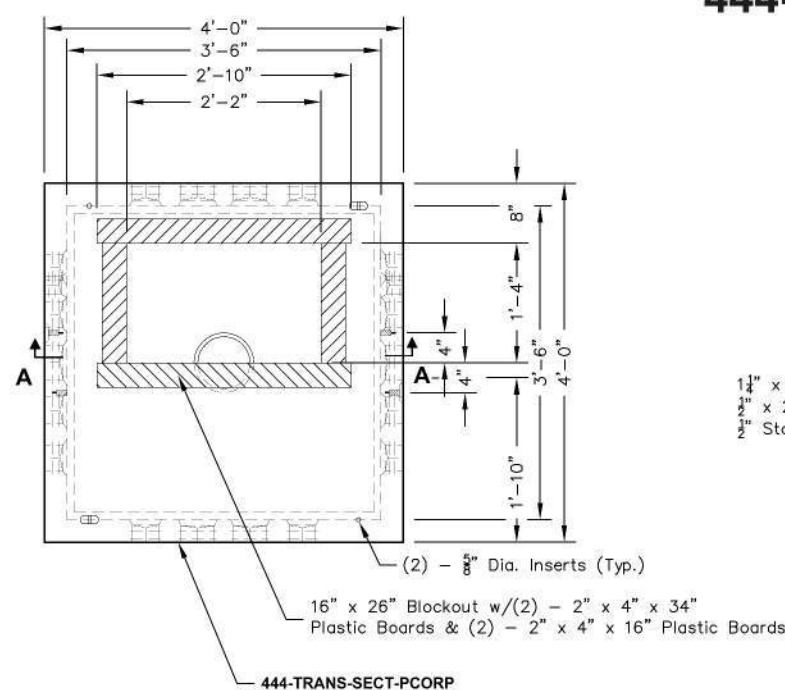

PLAN VIEW

No. 44-1626-PCORP (SINGLE PHASE TRANSFORMER / SECTIONALIZING TOP)
PCORP #7999607

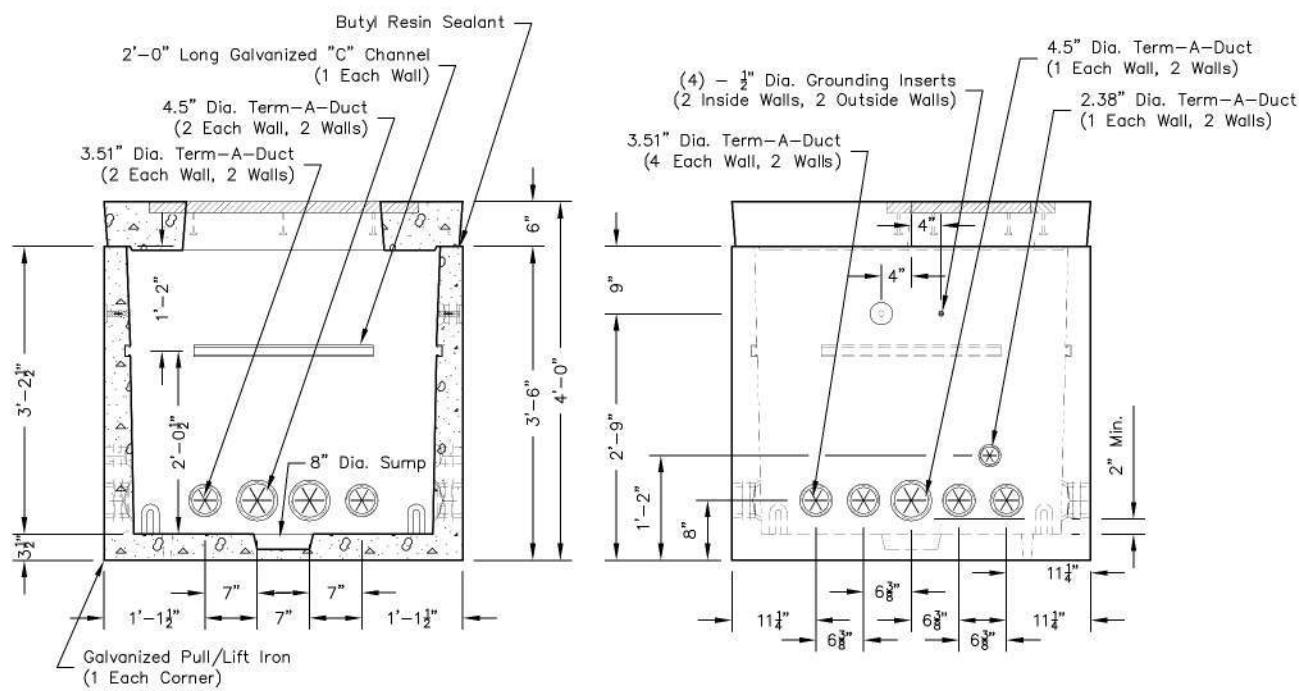

SECTION AA

Scale: $1/2" = 1'-0"$

END VIEW

© 2016 Oldcastle Precast, Inc.

opauburn.com



EXPIRES: 06/30/24

**WATER RESILIENCY PROJECT
PHASE 1 - SEISMIC IMPROVEMENTS
CITY OF CANNON BEACH, OR 97110**

ENGINEERING PLAN


Issue Date: 7/14/2023

1 METER INSTALLATION DETAIL
NOT TO SCALE


Project Manager	TWT
Drawn by	JRB
Checked by	SEW

DETAILS - ELECTRICAL

E502

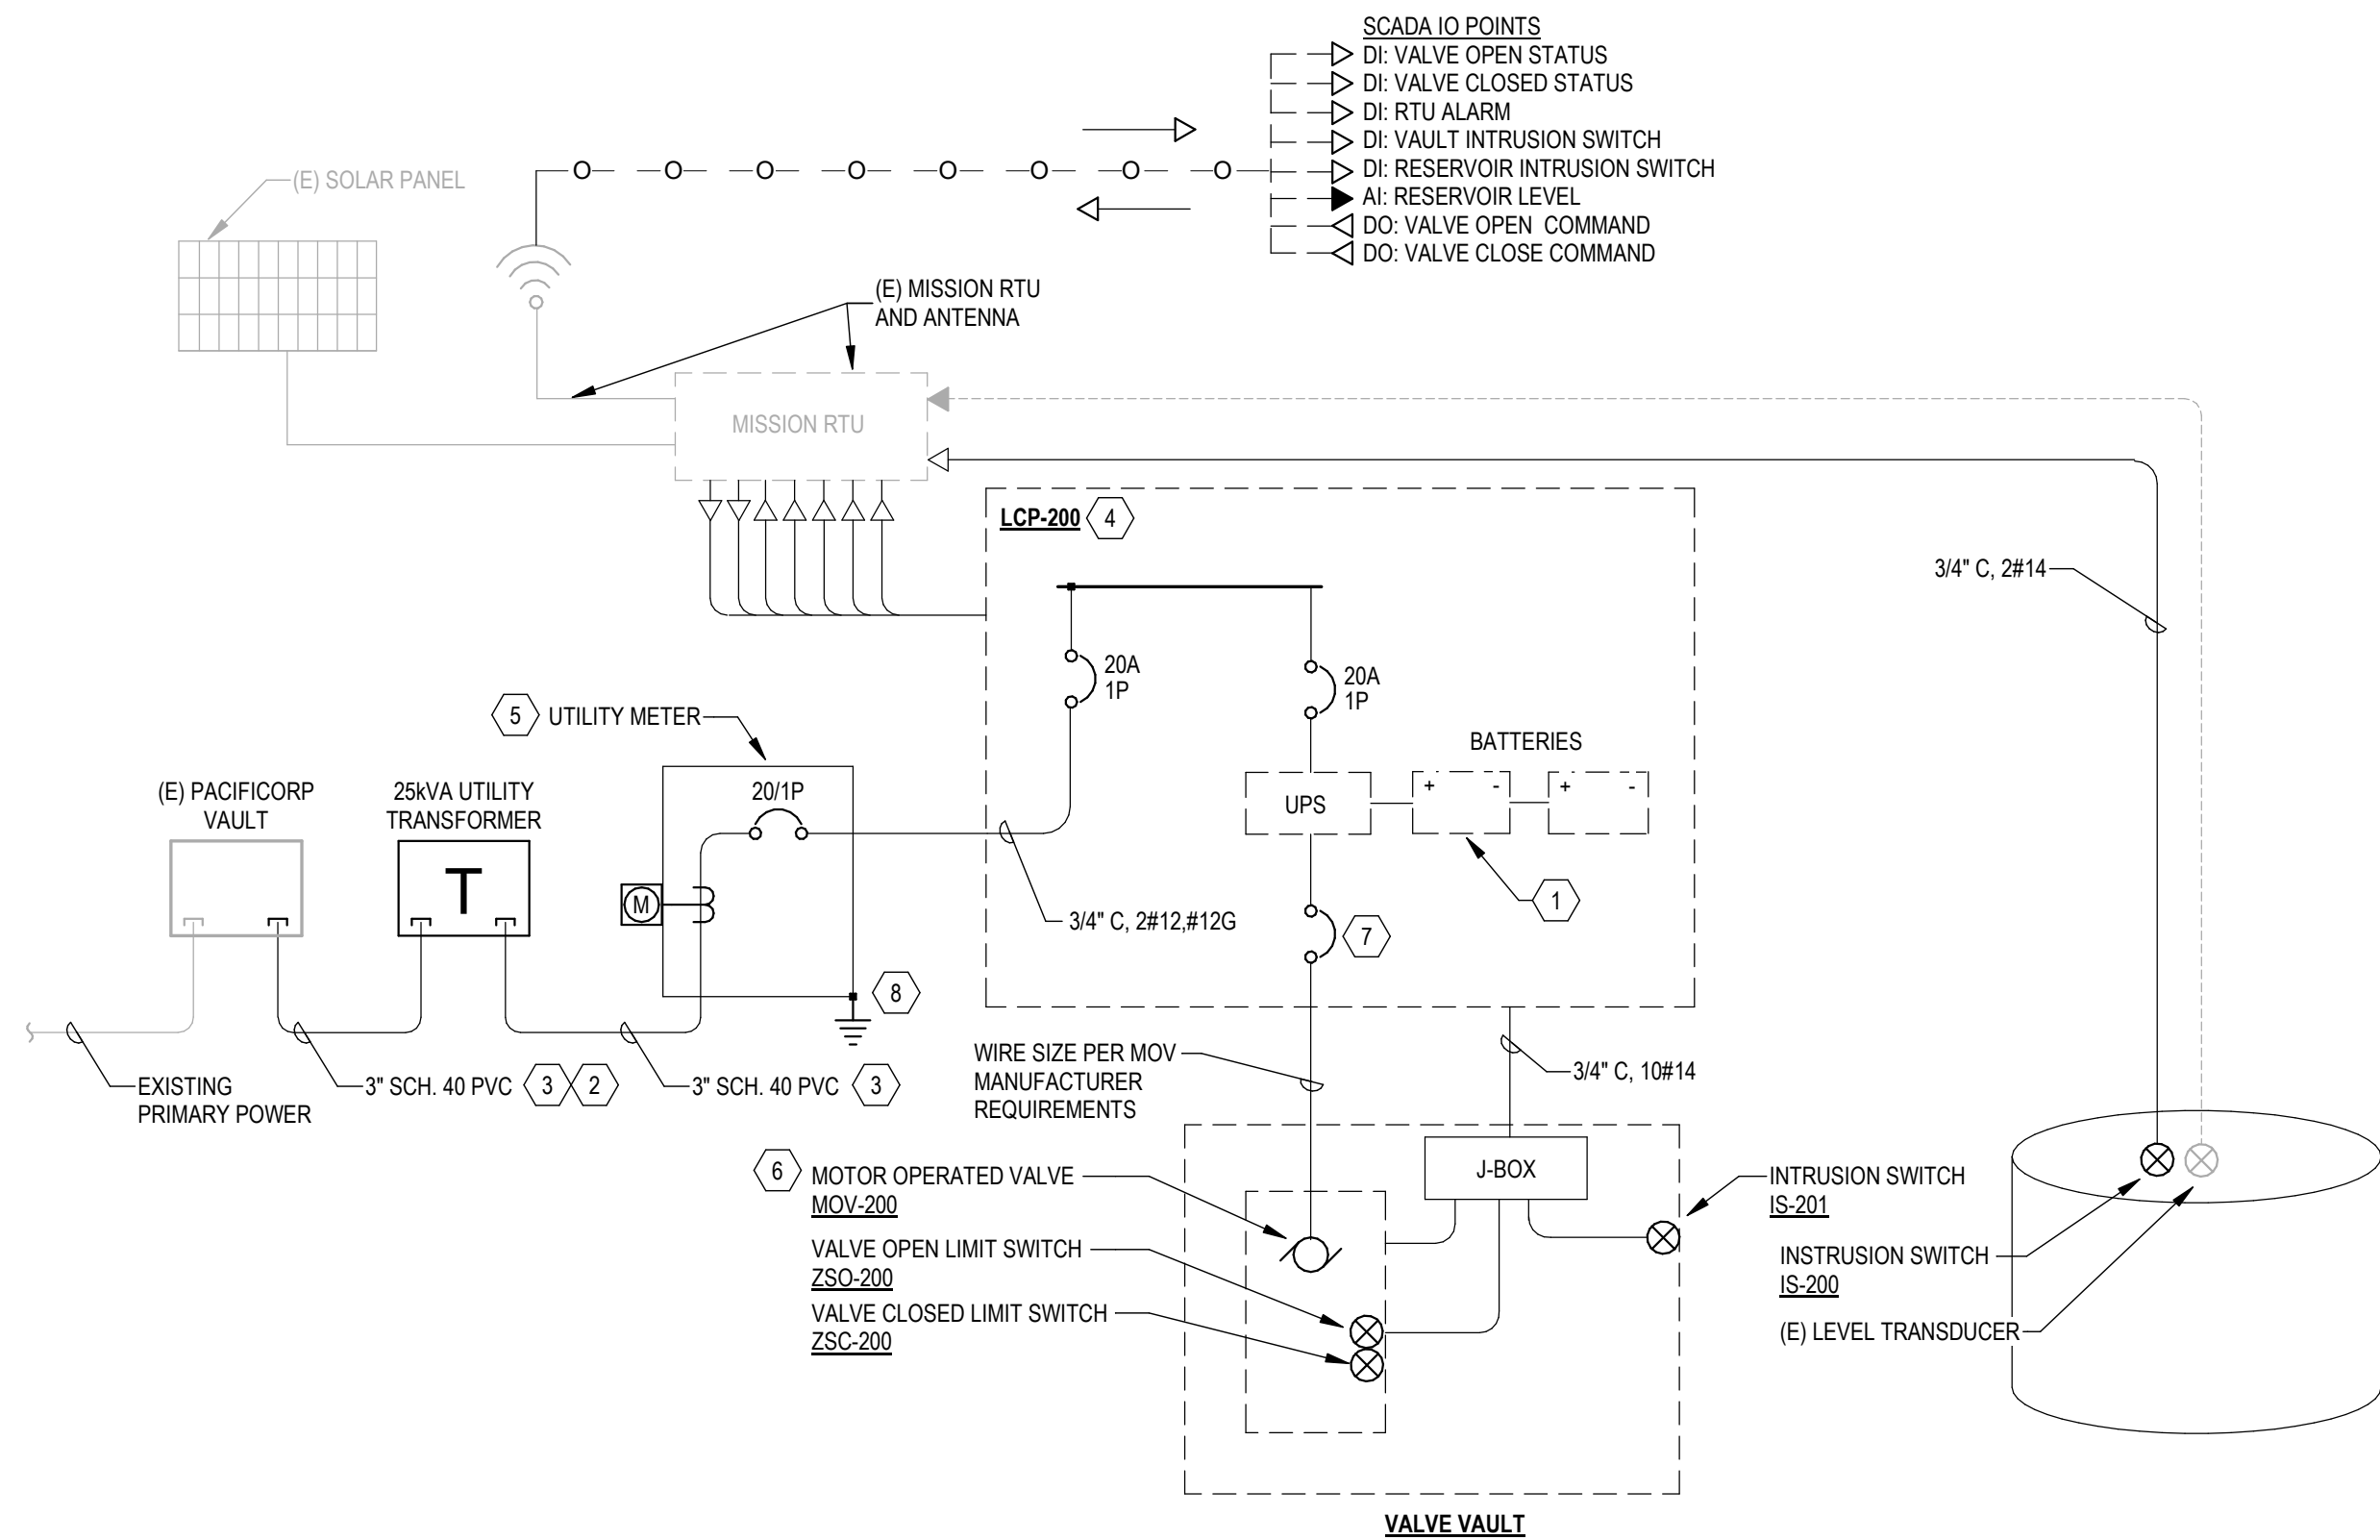

2 TOLOVANA RESERVOIR ONE-LINE DIAGRAM - ELECTRICAL & CONTROLS
NOT TO SCALE

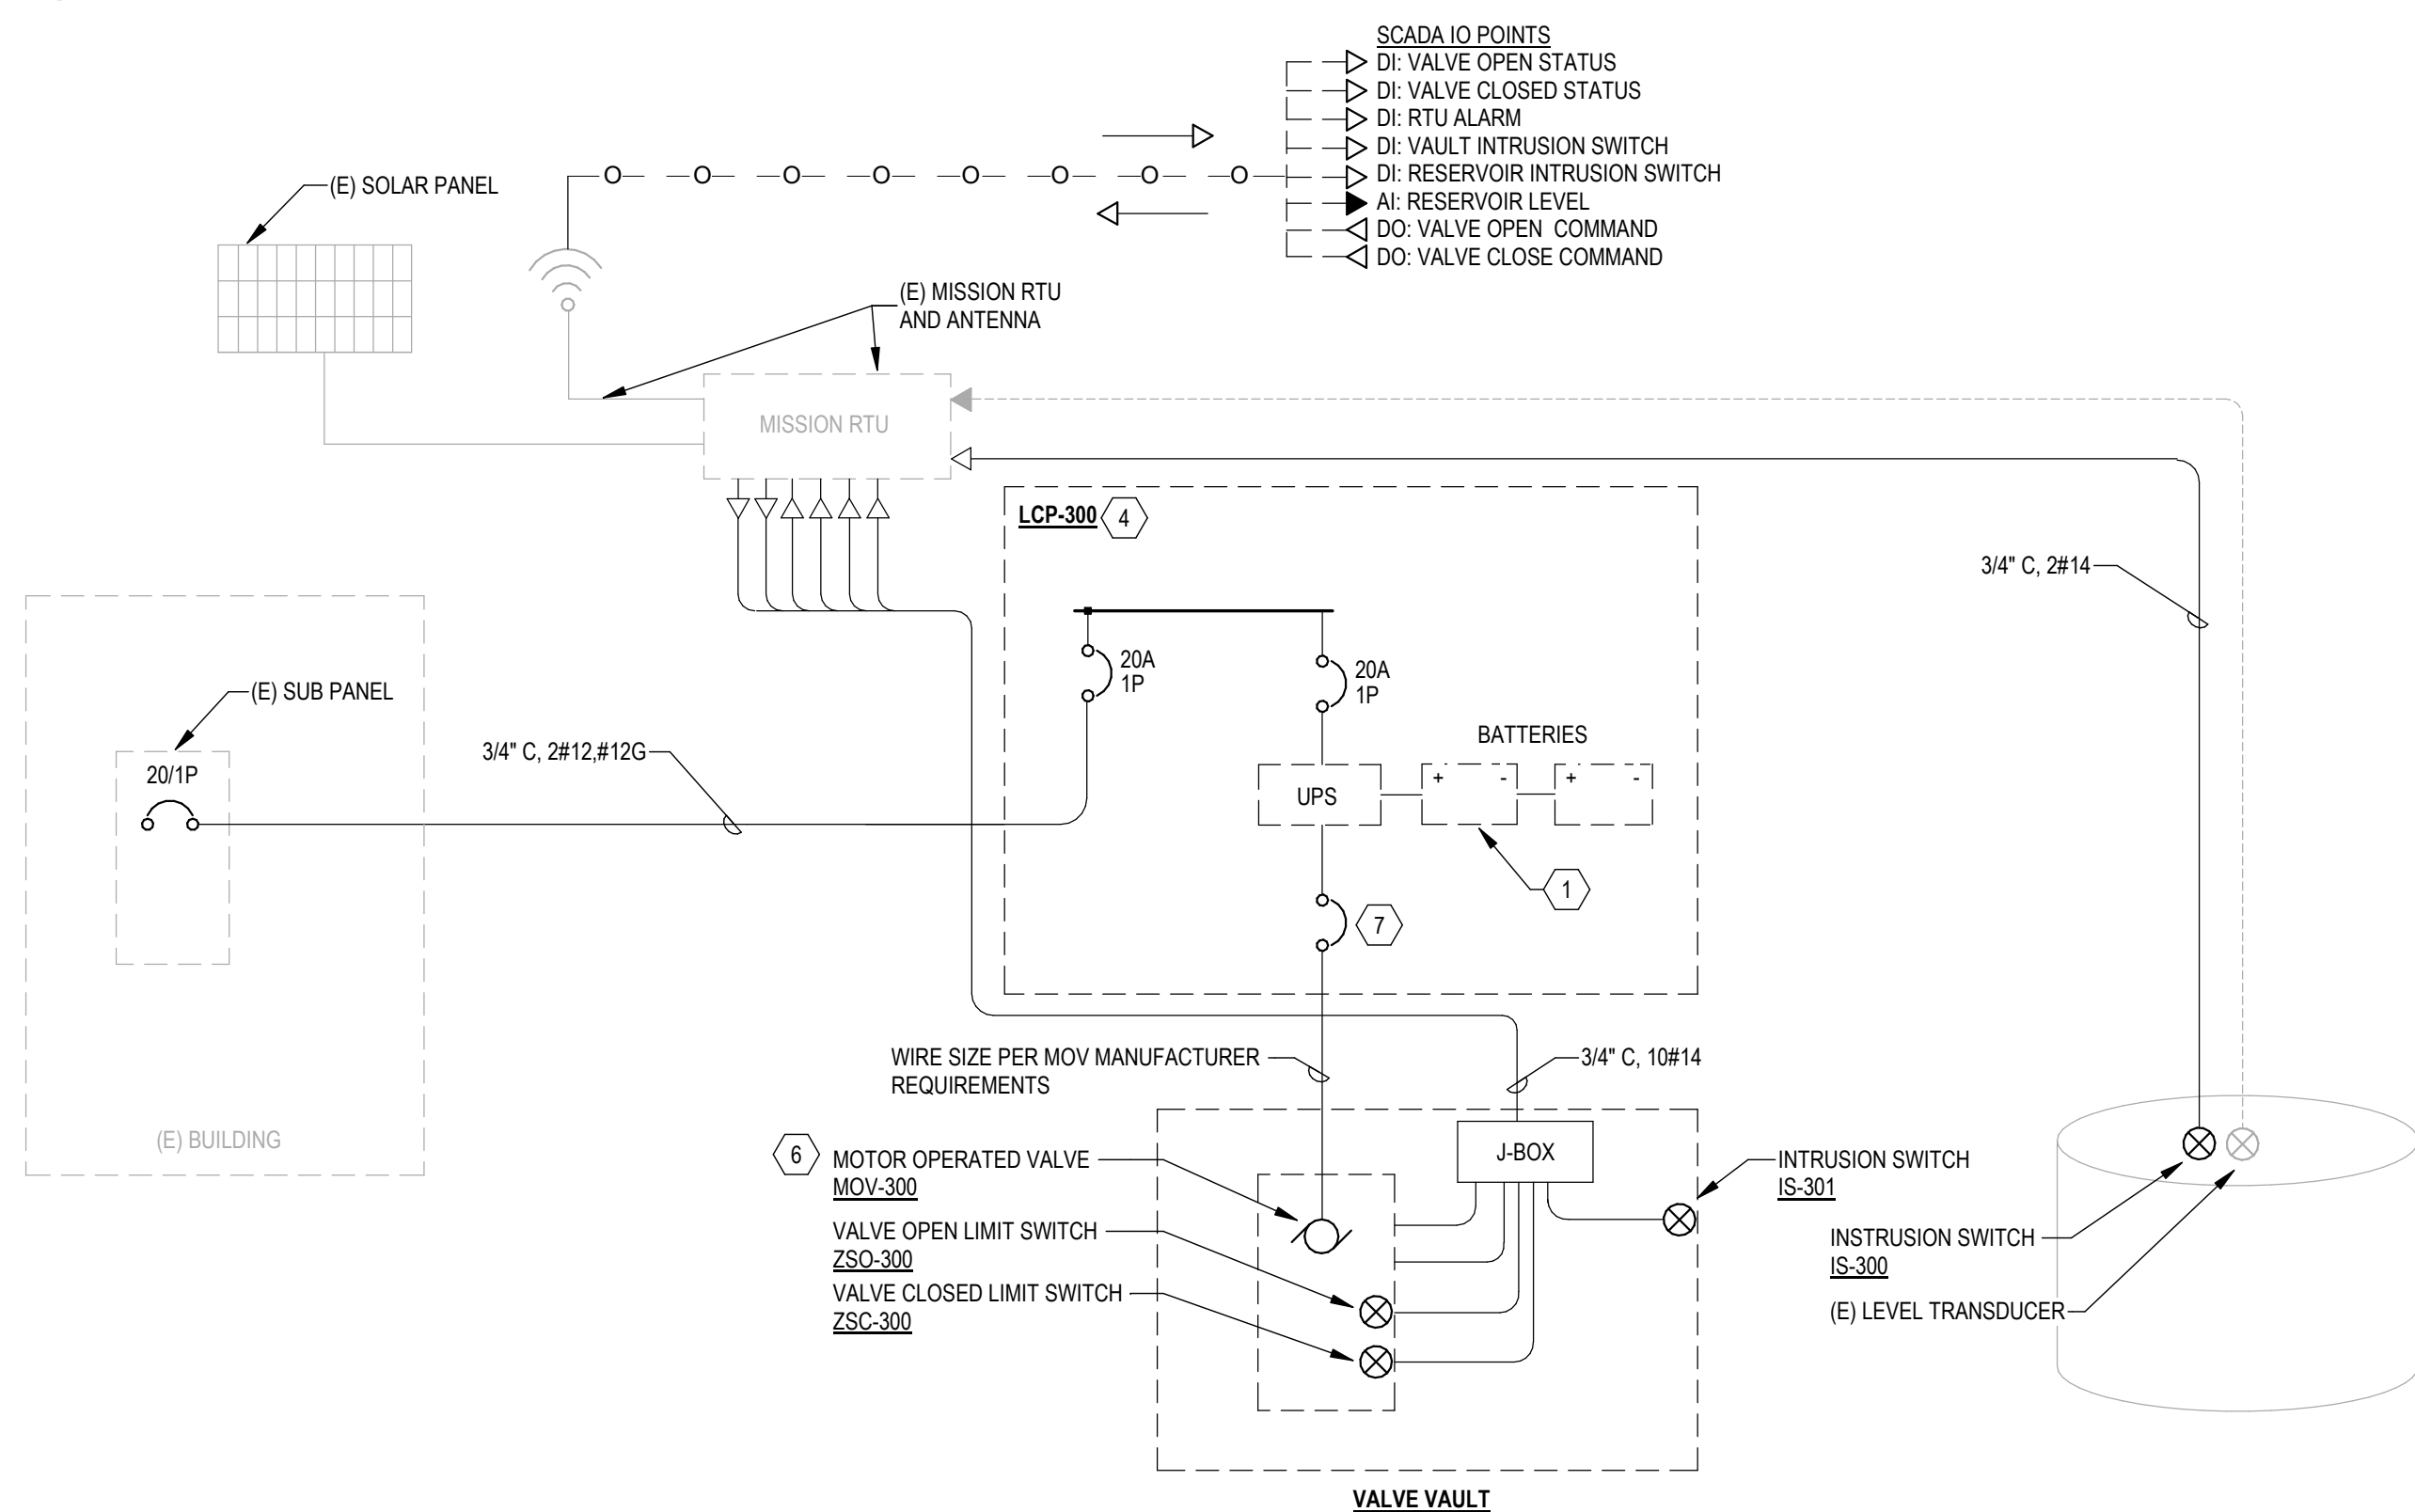

3 NORTH RESERVOIR ONE-LINE DIAGRAM - ELECTRICAL & CONTROLS
NOT TO SCALE



Know what's **below.**
Call before you dig.
 CALL 2 BUSINESS DAYS BEFORE YOU DIG.
 CAUTION UTILITY INFORMATION IS APPROXIMATE.
 VERIFY ALL UTILITIES PRIOR TO CONSTRUCTION.

Revisions:

1	8/24/2023	ADDENDUM #1
4	8/28/2023	ADDENDUM #4

LINE IS 1" ON FULL
SCALE DRAWING



WINDSOR ENGINEERS

Ridgefield, WA
Duluth + Minneapolis, MN
www.windsorengineers.com
Project No: 20198.3

Copyright 2023 By Windsor Engineers, LLC
All Rights Reserved.



EXPIRES: 06/30/24

**WATER RESILIENCY PROJECT
PHASE 1 - SEISMIC IMPROVEMENTS
CITY OF CANNON BEACH, OR 97110**

ENGINEERING PLAN

Issue Date: 7/14/2023

Project Manager	TWT
Drawn by	JRB
Checked by	SEW

RESERVOIR ONE-LINE
DIAGRAM


E601

GENERAL SHEET NOTES


- A. GRAY LINES INDICATE EXISTING TO REMAIN. BOLD LINES INDICATE NEW SCOPE.
- B. DASHED CONDUIT LINETYPE INDICATES UNDERGROUND ROUTING. COORDINATE NEW UNDERGROUND CONDUITS WITH EXISTING CONDITIONS.
- C. NEW SCADA AND VALVE PROGRAMMING BY CONTRACTOR.

KEYNOTES

1. PROVIDE BATTERY BACKUP. BATTERY SHALL HAVE CAPACITY TO COMPLETE A MINIMUM OF (2) CLOSE/OOPEN CYCLES IN THE EVENT OF A POWER OUTAGE. SEE SPECIFICATION FOR MORE INFORMATION.
2. PRIMARY CONDUIT SHALL BE 36" BELOW GRADE.
3. PRIMARY AND SECONDARY CONDUITS PER PACIFICORP ELECTRIC SERVICE REQUIREMENTS. TRENCHING SHALL BE INSPECTED AND APPROVED BY PACIFICORP BEFORE BACKFILL.
4. PROVIDE NECESSARY RELAYS, TERMINAL BLOCKS, CIRCUIT BREAKERS, ETC. REQUIREMENTS TO ENSURE COMPLETE CONTROL AND SCADA INTEGRATION TO THE MOTOR OPERATED VALVE. SUBMIT CONTROL SYSTEM SCHEMATICS FOR APPROVAL PRIOR TO INSTALLATION. SEE TYPICAL PANEL LAYOUT DRAWING
5. PROVIDE STAINLESS STEEL METEERMAIN COMB. 120V/240V, 1PH, 3W, MIN. 100A RATED, 22KACI, NEMA 3P. PROVIDE 100A/2P MAIN BREAKER AND (1) 20A/1P OUTPUT BREAKER. SEE INSTALLATION DETAIL ON SHEET E501. ACCEPTABLE METER SOCKETS SHALL BE PER PACIFIC POWER REQUIREMENTS AND APPROVE
6. ROTORK AUTOMATIC ELECTRIC ACTUATOR, FULL CLOSE, NON-THROTTLING, N.O. PLUG VALVE CLOSING ON FURTHER ALARM ALERT. (24 VDC APPLIED TO CONTROL ASSEMBLY AND OPENS AFTER SETPOINT VDC APPLIED TO CONTROL ASSEMBLY) SEE SPECIFICATIONS FOR FURTHER INFORMATION.
7. PROVIDE CIRCUIT PROTECTION AND WIRE SIZE PER MOTOR ACTUATED VALVE MANUFACTURER REQUIREMENTS.
8. REFER TO GROUNDING DIAGRAM ON SHEET E501.

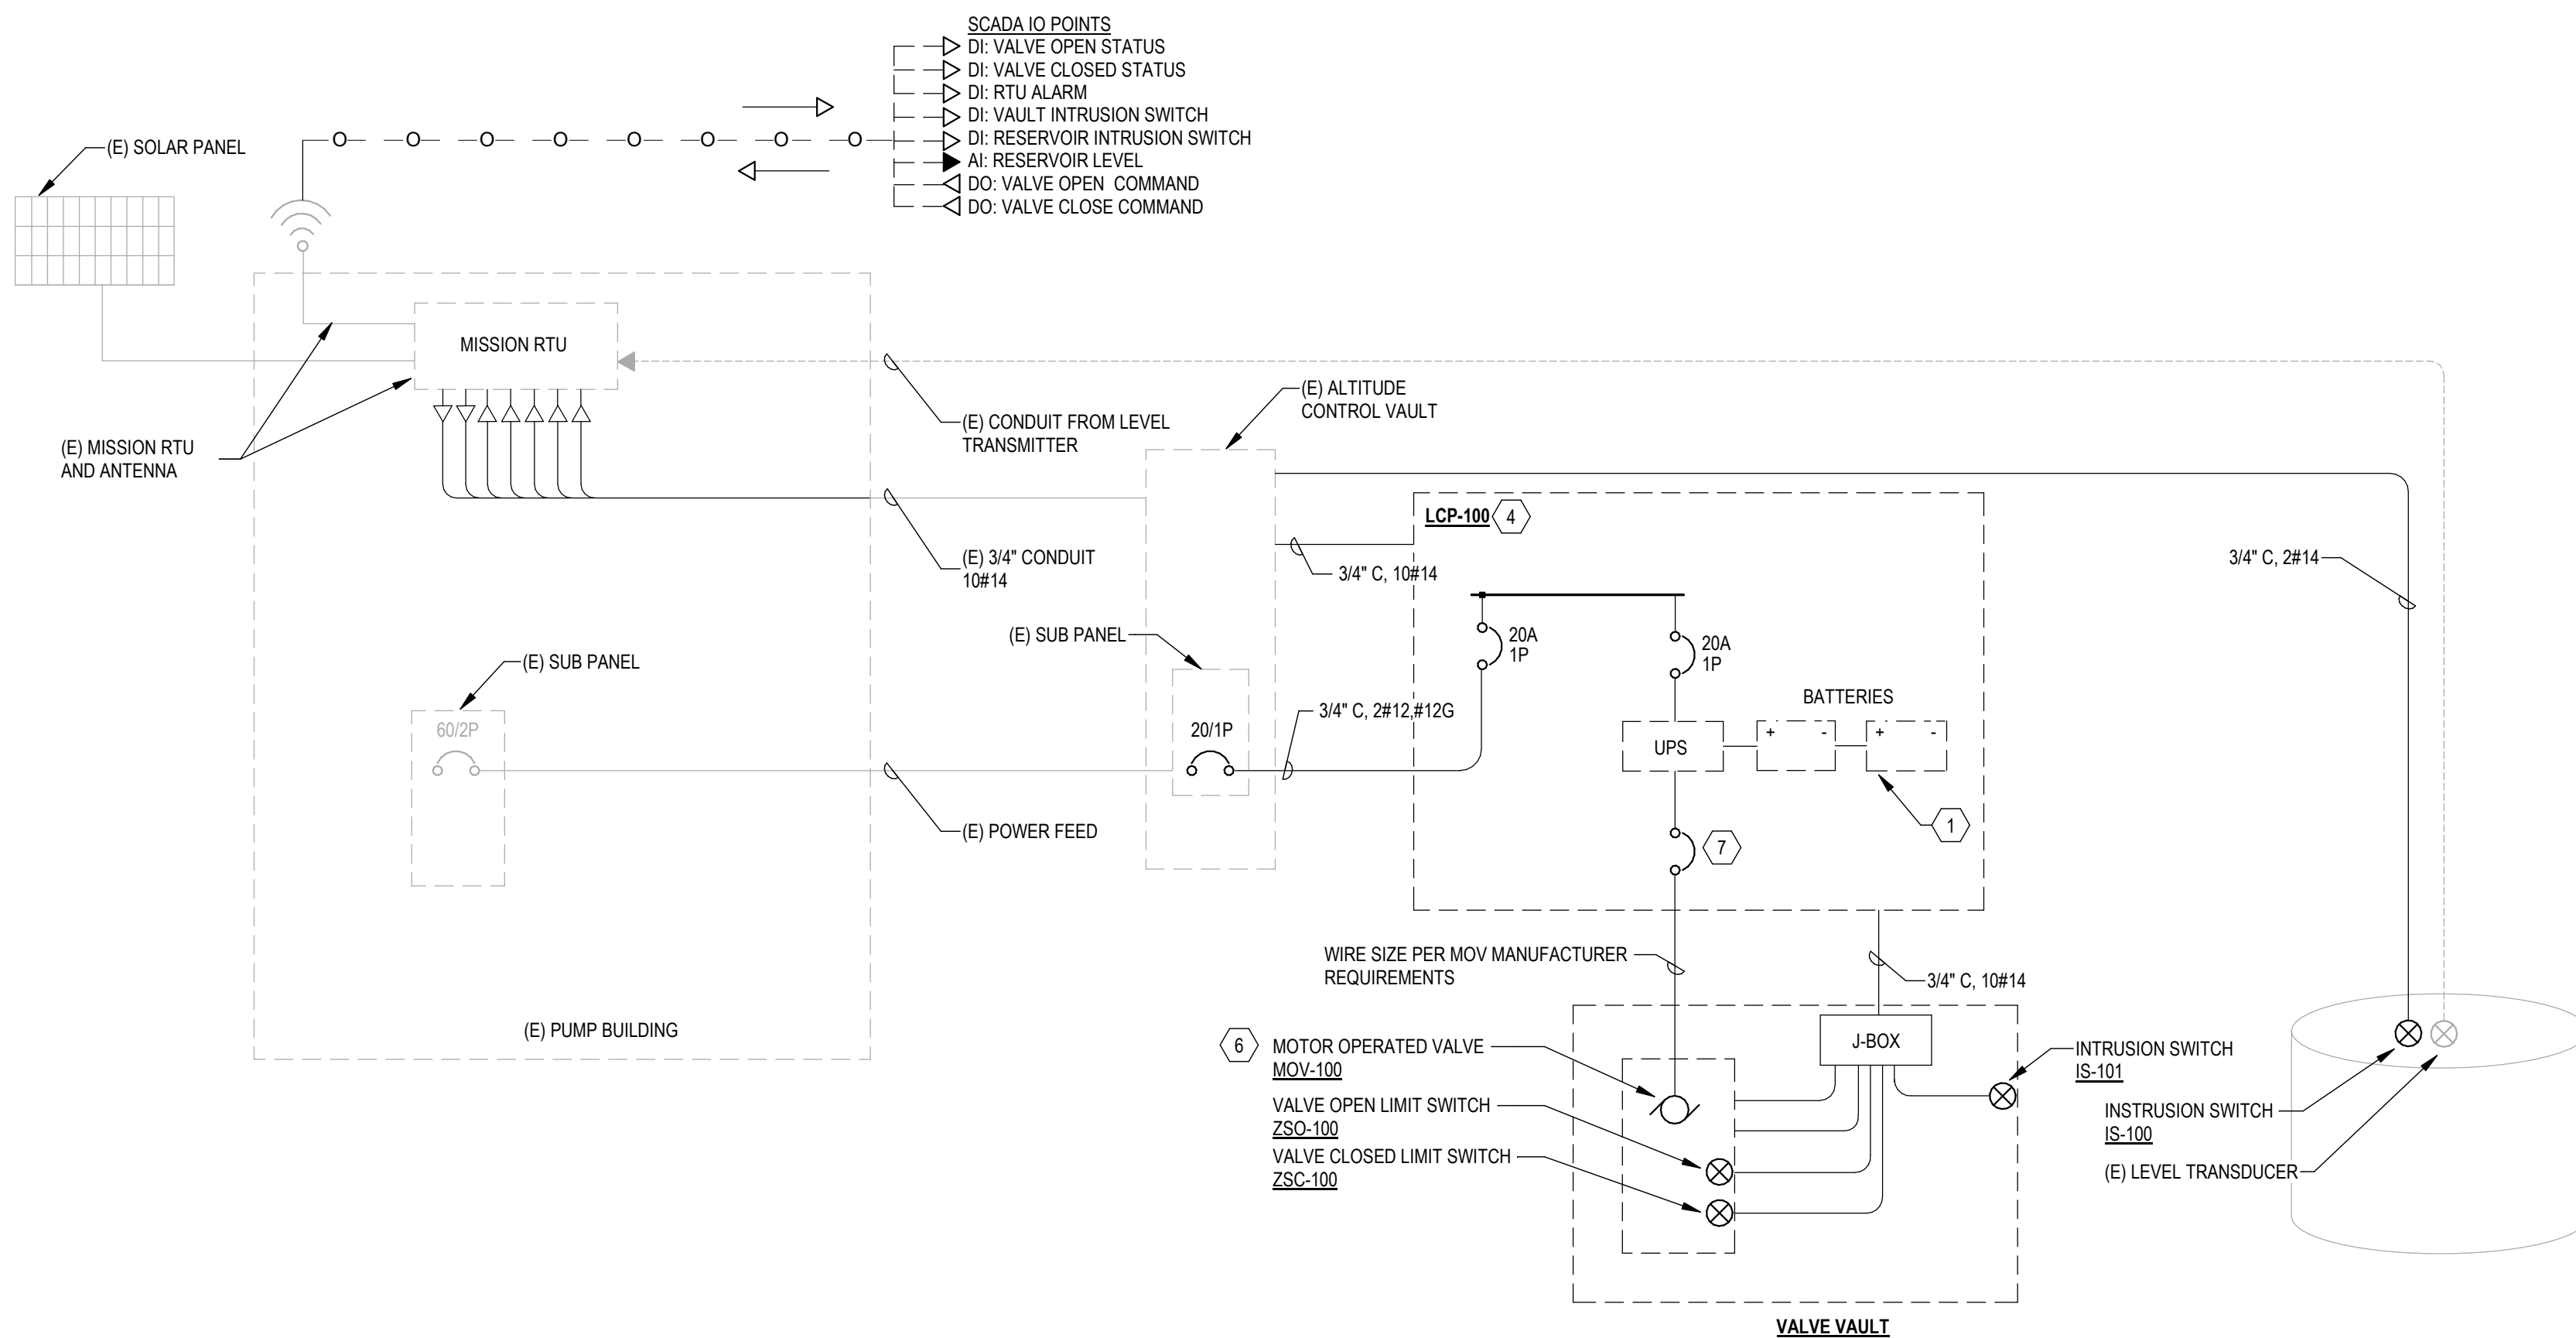

1 MAIN RESERVOIR ONE-LINE DIAGRAM - ELECTRICAL & CONTROLS
NOT TO SCALE

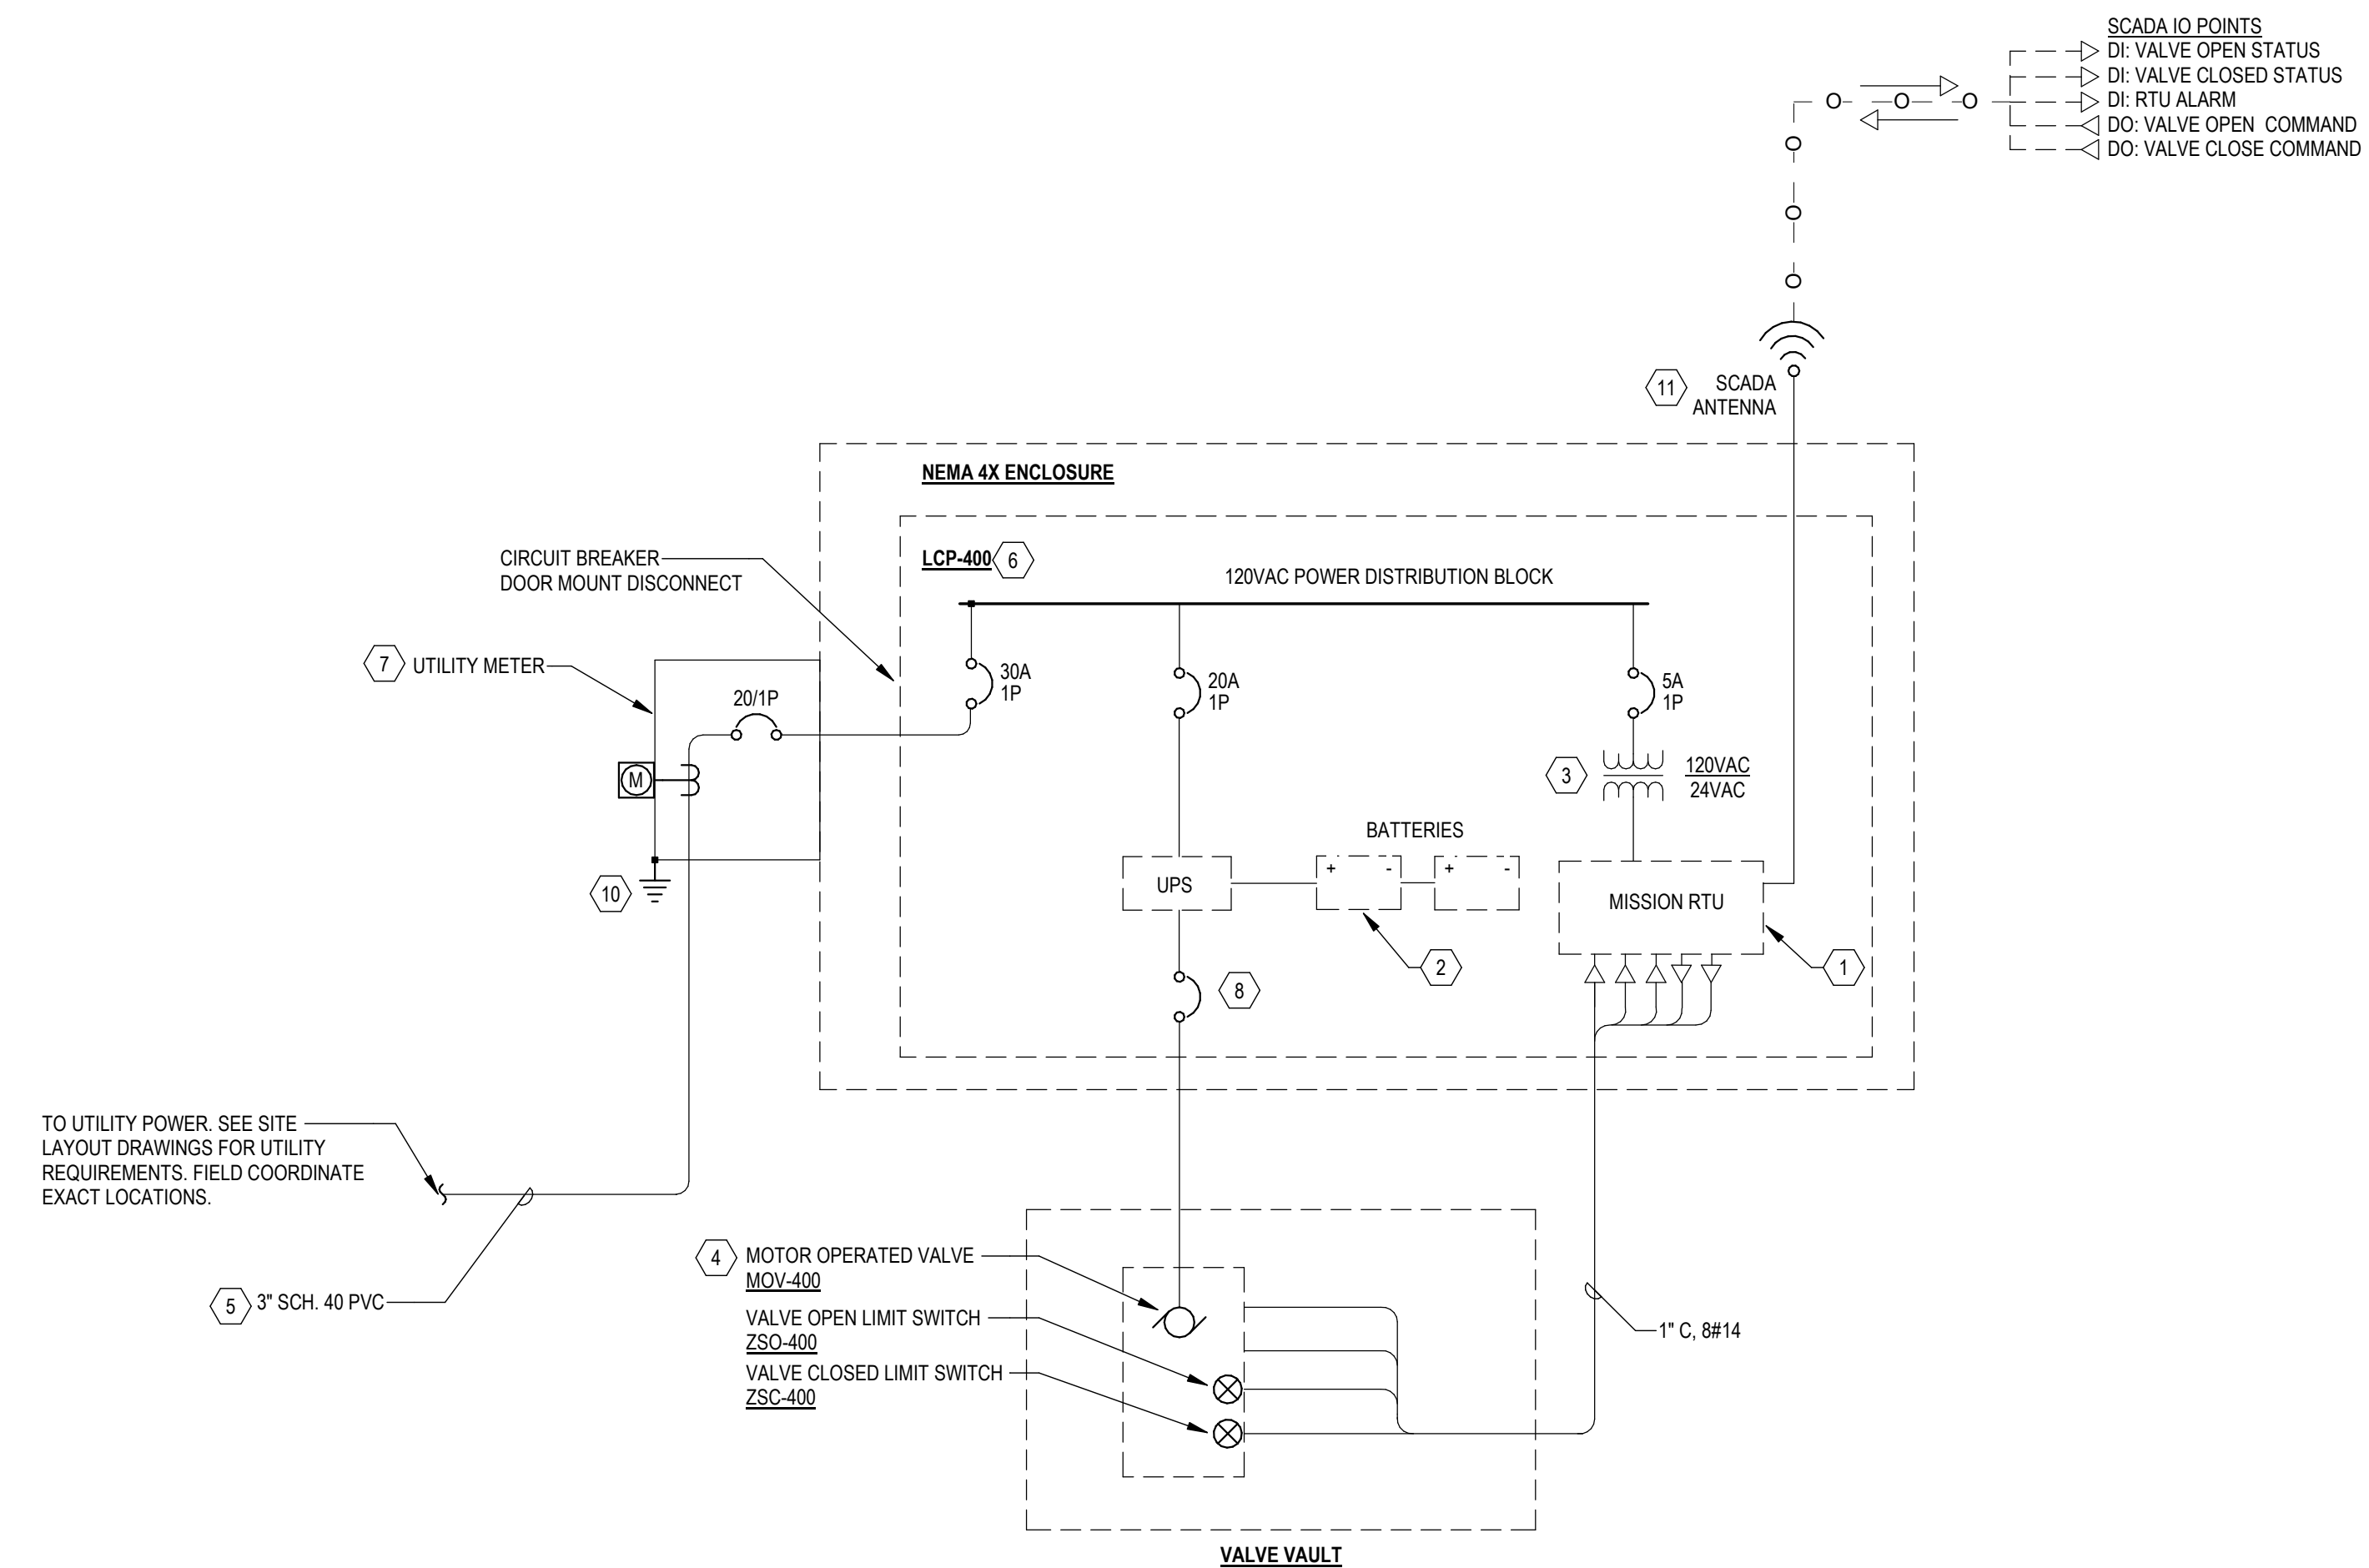


1 ISOLATION VALVE 4 SITE ONE-LINE DIAGRAM - ELECTRICAL & CONTROLS
NOT TO SCALE



Know what's **below.**
Call before you dig.
 CALL 2 BUSINESS DAYS BEFORE YOU DIG.
 CAUTION UTILITY INFORMATION IS APPROXIMATE.
 VERIFY ALL UTILITIES PRIOR TO CONSTRUCTION.

Revisions:

<u>Revisions:</u>			LINE IS 1" ON FULL SCALE DRAWING
1	8/24/2023	ADDENDUM #1	
4	8/28/2023	ADDENDUM #4	

LINE IS 1" ON FULL
SCALE DRAWING



WINDSOR ENGINEERS

Ridgefield, WA
Duluth + Minneapolis, MN
www.windsorengineers.com
Project No: 20198.3

Copyright 2023 By Windsor Engineers, LLC
All Rights Reserved.



EXPIRES: 06/30/24

**WATER RESILIENCY PROJECT
PHASE 1 - SEISMIC IMPROVEMENTS
CITY OF CANNON BEACH, OR 97110**

ENGINEERING PLAN

Issue Date: 7/14/2023

Project Manager	TWT
Drawn by	JRB
Checked by	SEW

ISOLATION VALVE ONE-LINE DIAGRAM

E602

GENERAL SHEET NOTES


- A. ALL UNDERGROUND CONDUITS SHALL BE A MINIMUM OF 24" BELOW GRADE.
- B. ALL CONDUIT SHALL HAVE MINIMUM 12" OF SEPARATION FROM ANY OTHER COMMUNICATION OR GAS FACILITIES AND SHALL BE MINIMUM OF 36" FROM ANY WATER OR SEWER LINES.
- C. NEW SCADA AND VALVE PROGRAMMING BY CONTRACTOR.

KEYNOTES


- 1 FURNISH AND INSTALL MISSION MYDRO 850.
- 2 PROVIDE BATTERY BACKUP. BATTERY SHALL HAVE CAPACITY TO COMPLETE A MINIMUM OF (2) CLOSE/OPEN CYCLES IN THE EVENT OF A POWER OUTAGE. SEE SPECIFICATION FOR MORE INFORMATION.
- 3 PROVIDE 120VAC TO 12 VAC, 1.2A POWER SUPPLY TO POWER RTU PER MISSION RTU REQUIREMENTS.
- 4 ROTORK AUTOMATIC ELECTRIC ACTUATOR, FULL CLOSE, NON-THROTTLING, N.O. PILOT. VALVE CLOSURE ON EARTHQUAKE ALERT, (24 VDC APPLIED TO CONTROL ASSEMBLY) AND OPENS AFTER RESET (0 VDC APPLIED TO CONTROL ASSEMBLY). SEE SPECIFICATIONS FOR FURTHER INFORMATION.
- 5 SEE SHEET E601 FOR DIVISION OF RESPONSIBILITY MATRIX..
- 6 PROVIDE NON-ESSENTIAL RELAYS, TERMINAL BLOCKS, CIRCUIT BREAKERS, ETC. REFER TO ENSURE COMPLETE CONTROL AND SCADA INTEGRATION TO THE MOTOR OPERATED VALVE. SUBMIT CONTROL SYSTEM SCHEMATICS FOR APPROVAL PRIOR TO INSTALLATION. SEE TYPICAL PANEL LAYOUT DRAWING SHEET E701.
- 7 PROVIDE STAINLESS STEEL METEERMAIN COMBO, 120V/240V, 1PH, 3W, MIN. 100Amp, 22KACI, NEMA 3P. PROVIDE 100A/2P MAIN BREAKER AND (1) 20A/1P OUTPUT BREAKER. SEE INSTALLATION DETAIL ON SHEET E501. ACCEPTABLE METER SOCKETS SHALL BE PER PACIFIC POWER REQUIREMENTS AND APPROVED MANUFACTURER LIST.
- 8 PROVIDE CIRCUIT PROTECTION AND WIRE SIZE PER MOTOR ACTUATED VALVE MANUFACTURER REQUIREMENTS.
- 9 SHAKEALARM UNIT EQUIPMENT PROVIDED BY VARIUS INC. INSTALLATION, WIRING CONDUCTED BY EL ELECTRICAL CONTRACTOR. MOUNT NEW SHAKEALARM UNIT ADJACENT TO EXISTING MISSION CONTROL'S SCADA MASTER. SEE SPECIFICATIONS FOR INFORMATION AND REQUIREMENTS.
- 10 REFER TO GROUNDING DIAGRAM ON SHEET E501.
- 11 CONTRACTOR SHALL RECOMMEND A PLACEMENT LOCATION TO THE CITY OF CANNON BEACH WHERE THE OMNI-DIRECTIONAL ANTENNA SHOULD BE LOCATED FOR OPTIMUM PERFORMANCE BEFORE INSTALLATION.

GENERAL SHEET NOTES


- A. THIS PANEL ELEVATION IS A GENERAL ARRANGEMENT DRAWING AND SHOWS MAJOR COMPONENTS ONLY. NOT ALL MATERIALS NECESSARY FOR FABRICATION. SEE WIRING DIAGRAMS AND SPECIFICATIONS FOR ADDITIONAL INFORMATION TO PROVIDE A COMPLETE AND OPERABLE SYSTEM.

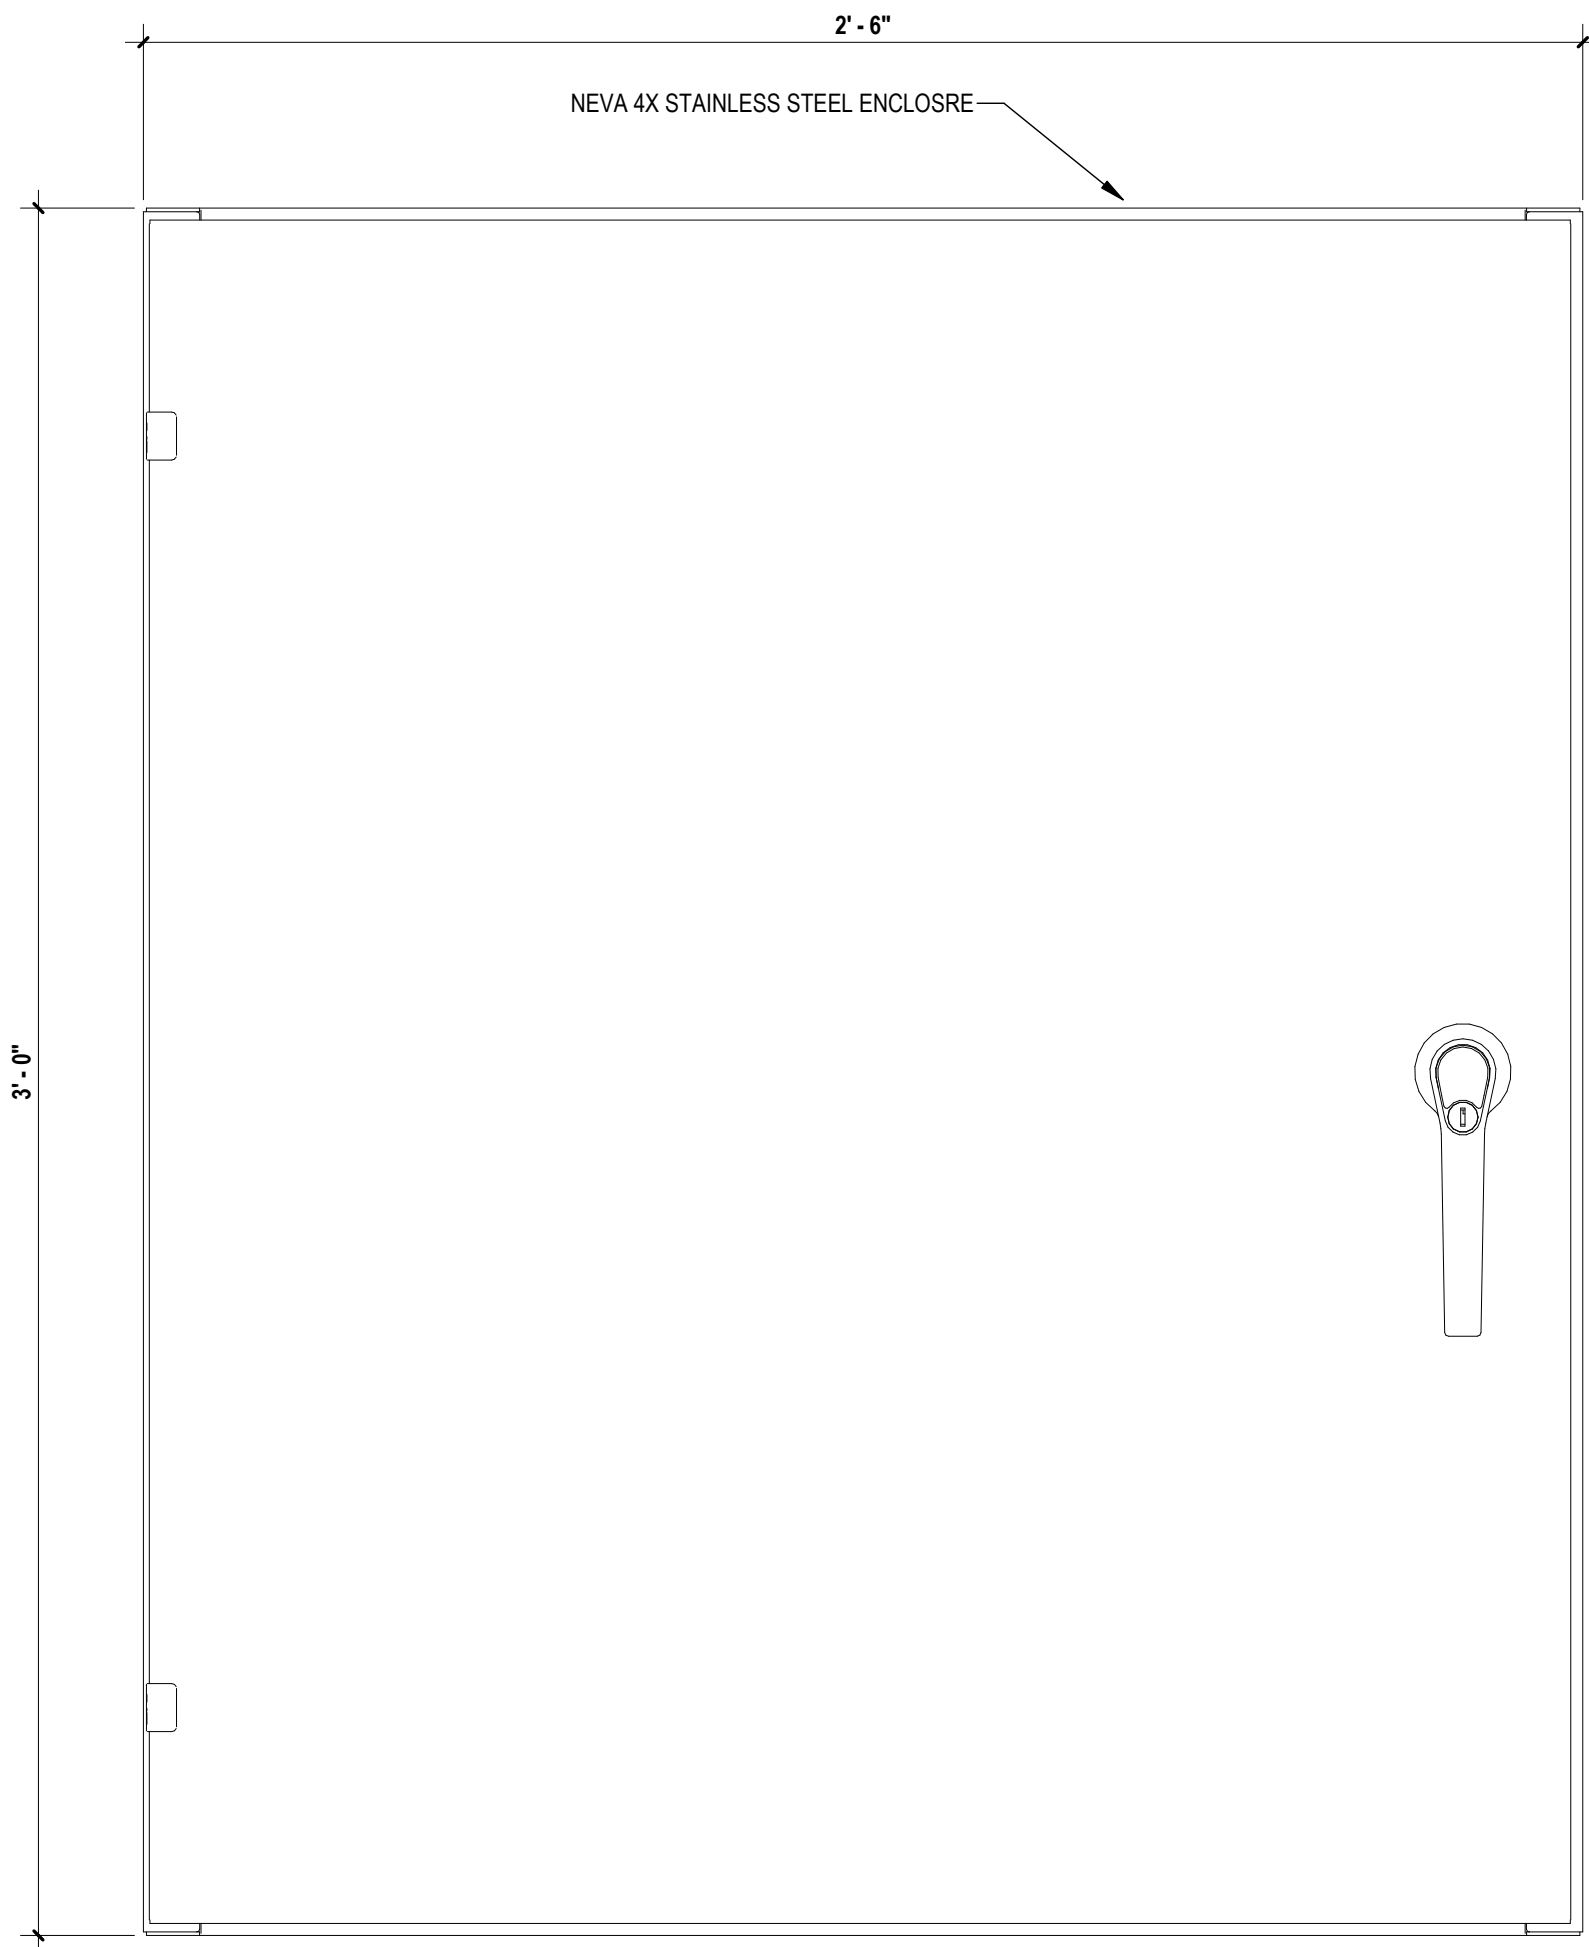

ENCLOSURE EXTERIOR

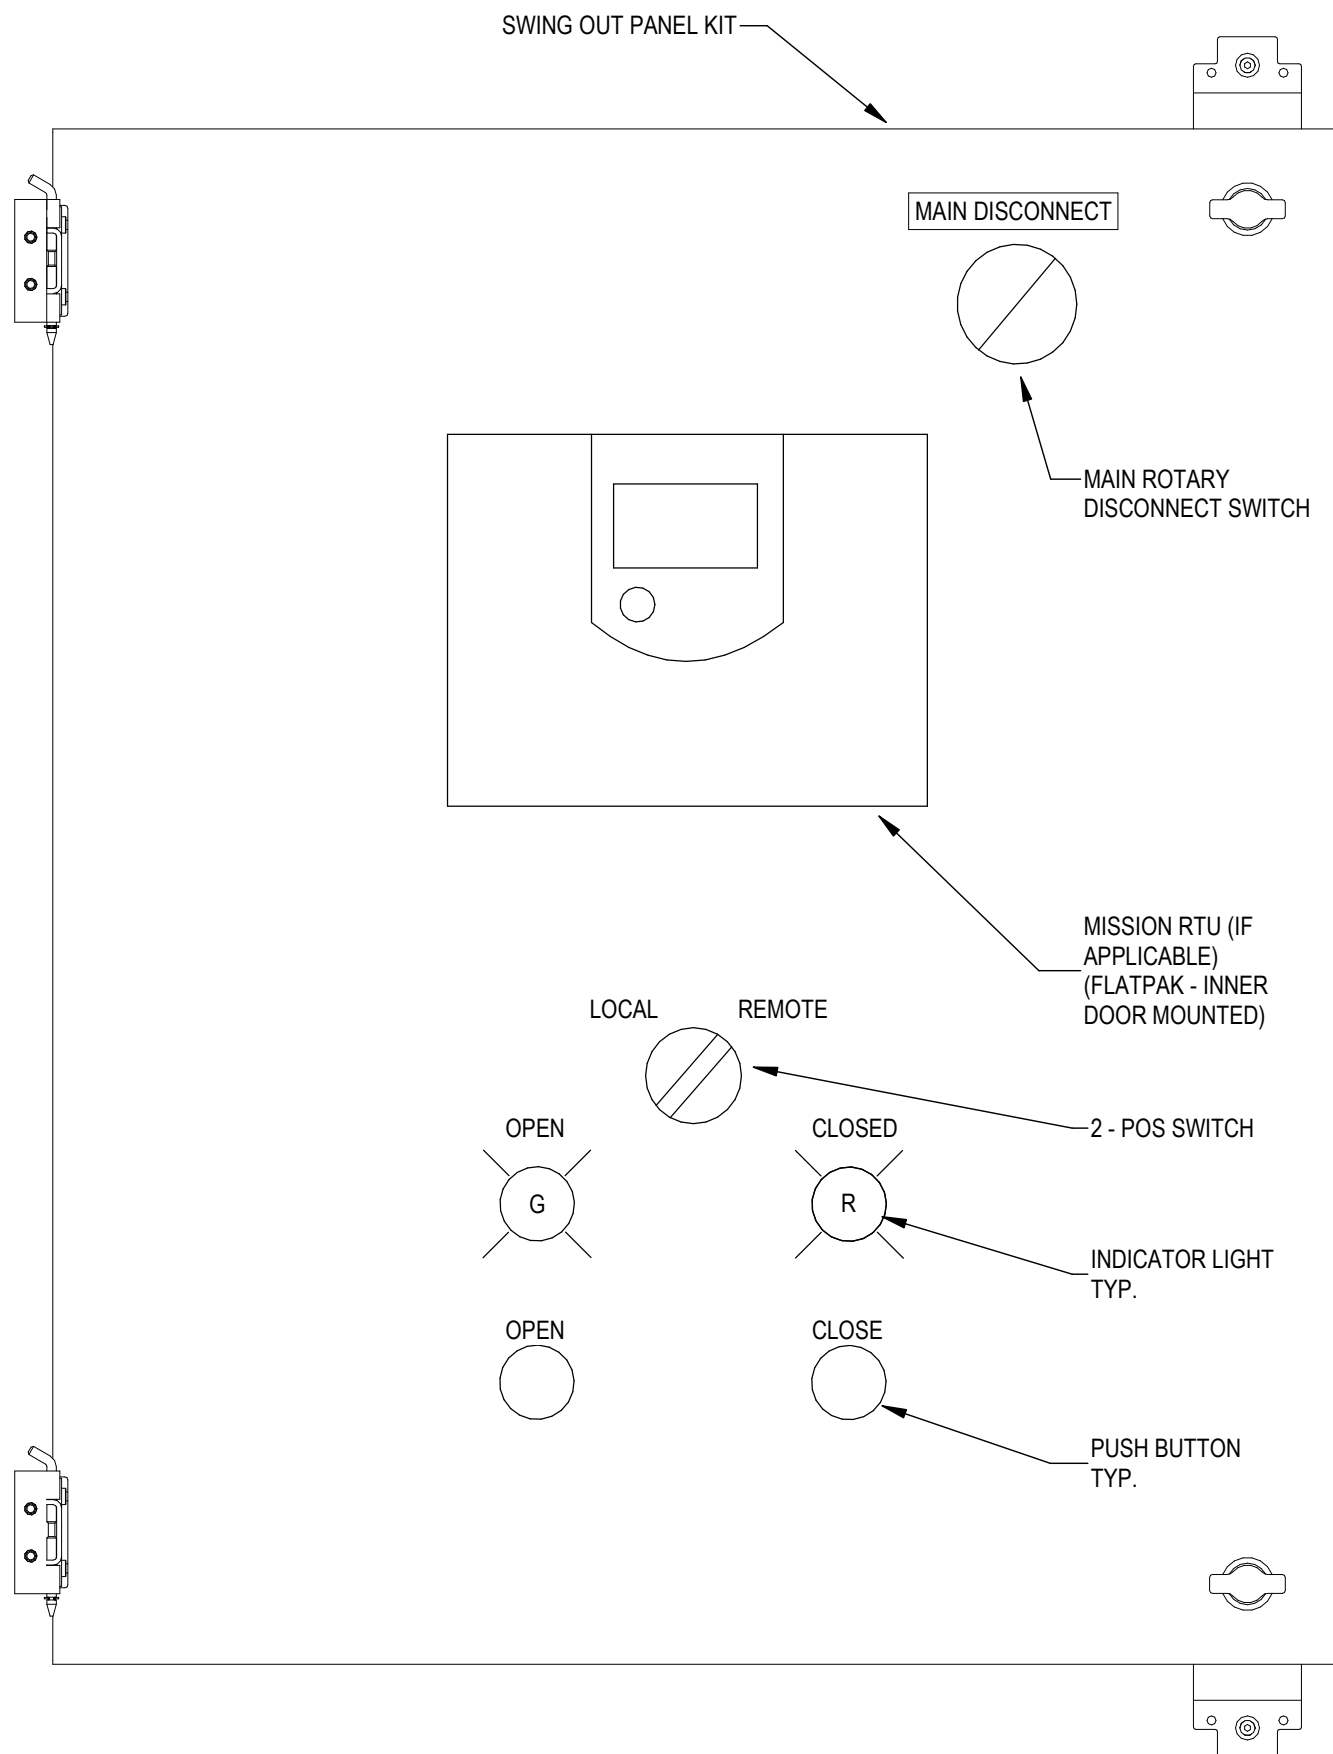

SWING OUT PANEL

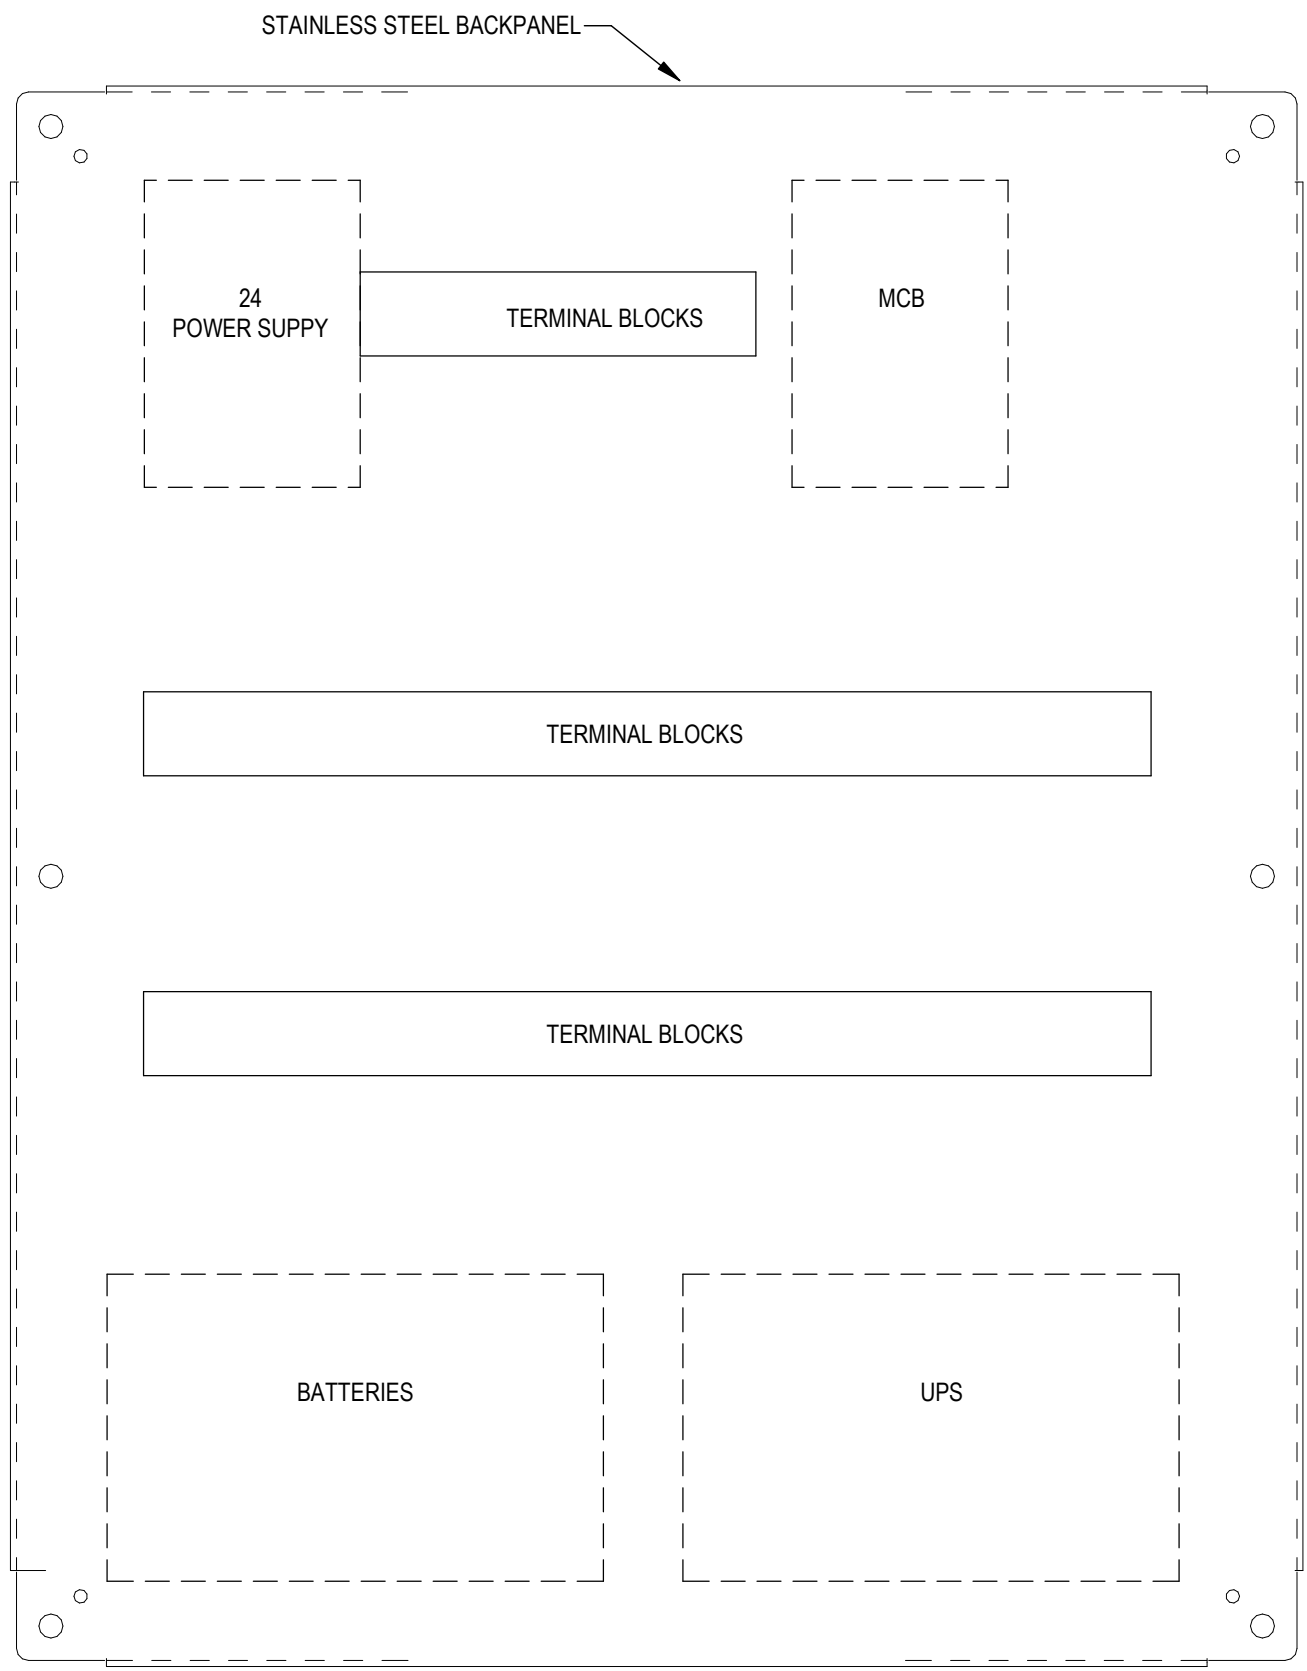


BACK PANEL



Know what's **below.**
Call before you dig.
CALL 2 BUSINESS DAYS BEFORE YOU DIG.
CAUTION: UTILITY INFORMATION IS APPROXIMATE.
VERIFY ALL UTILITIES PRIOR TO CONSTRUCTION.

Revisions:

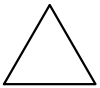

1	8/24/2023	ADDENDUM #1
4	8/28/2023	ADDENDUM #4

LINE IS 1" ON FULL
SCALE DRAWING



WINDSOR ENGINEERS

Ridgefield, WA
Duluth + Minneapolis, MN
www.windsorengineers.com
Project No: 20198.3

Copyright 2023 By Windsor Engineers, LLC
All Rights Reserved.



WATER RESILIENCY PROJECT
PHASE 1 - SEISMIC IMPROVEMENTS
CITY OF CANNON BEACH, OR 97110

ENGINEERING PLAN
Issue Date: 7/14/2023


Project Manager TWT
Drawn by JRB
Checked by SEW

TYPICAL CONTROL
PANEL ELEVATIONS

E701

PLOT DATE: 11/6/2021 9:53 AM - FILE: C:\Users\jld\OneDrive - Windsor Engineers\20198.3 Cannon Beach Seismic Valves\02_Drawings\00_BIM\360 files\CAD Links\20198.3_BRDR.dwg

Copyright 2022 By Windsor Engineers, LLC. All Rights Reserved.

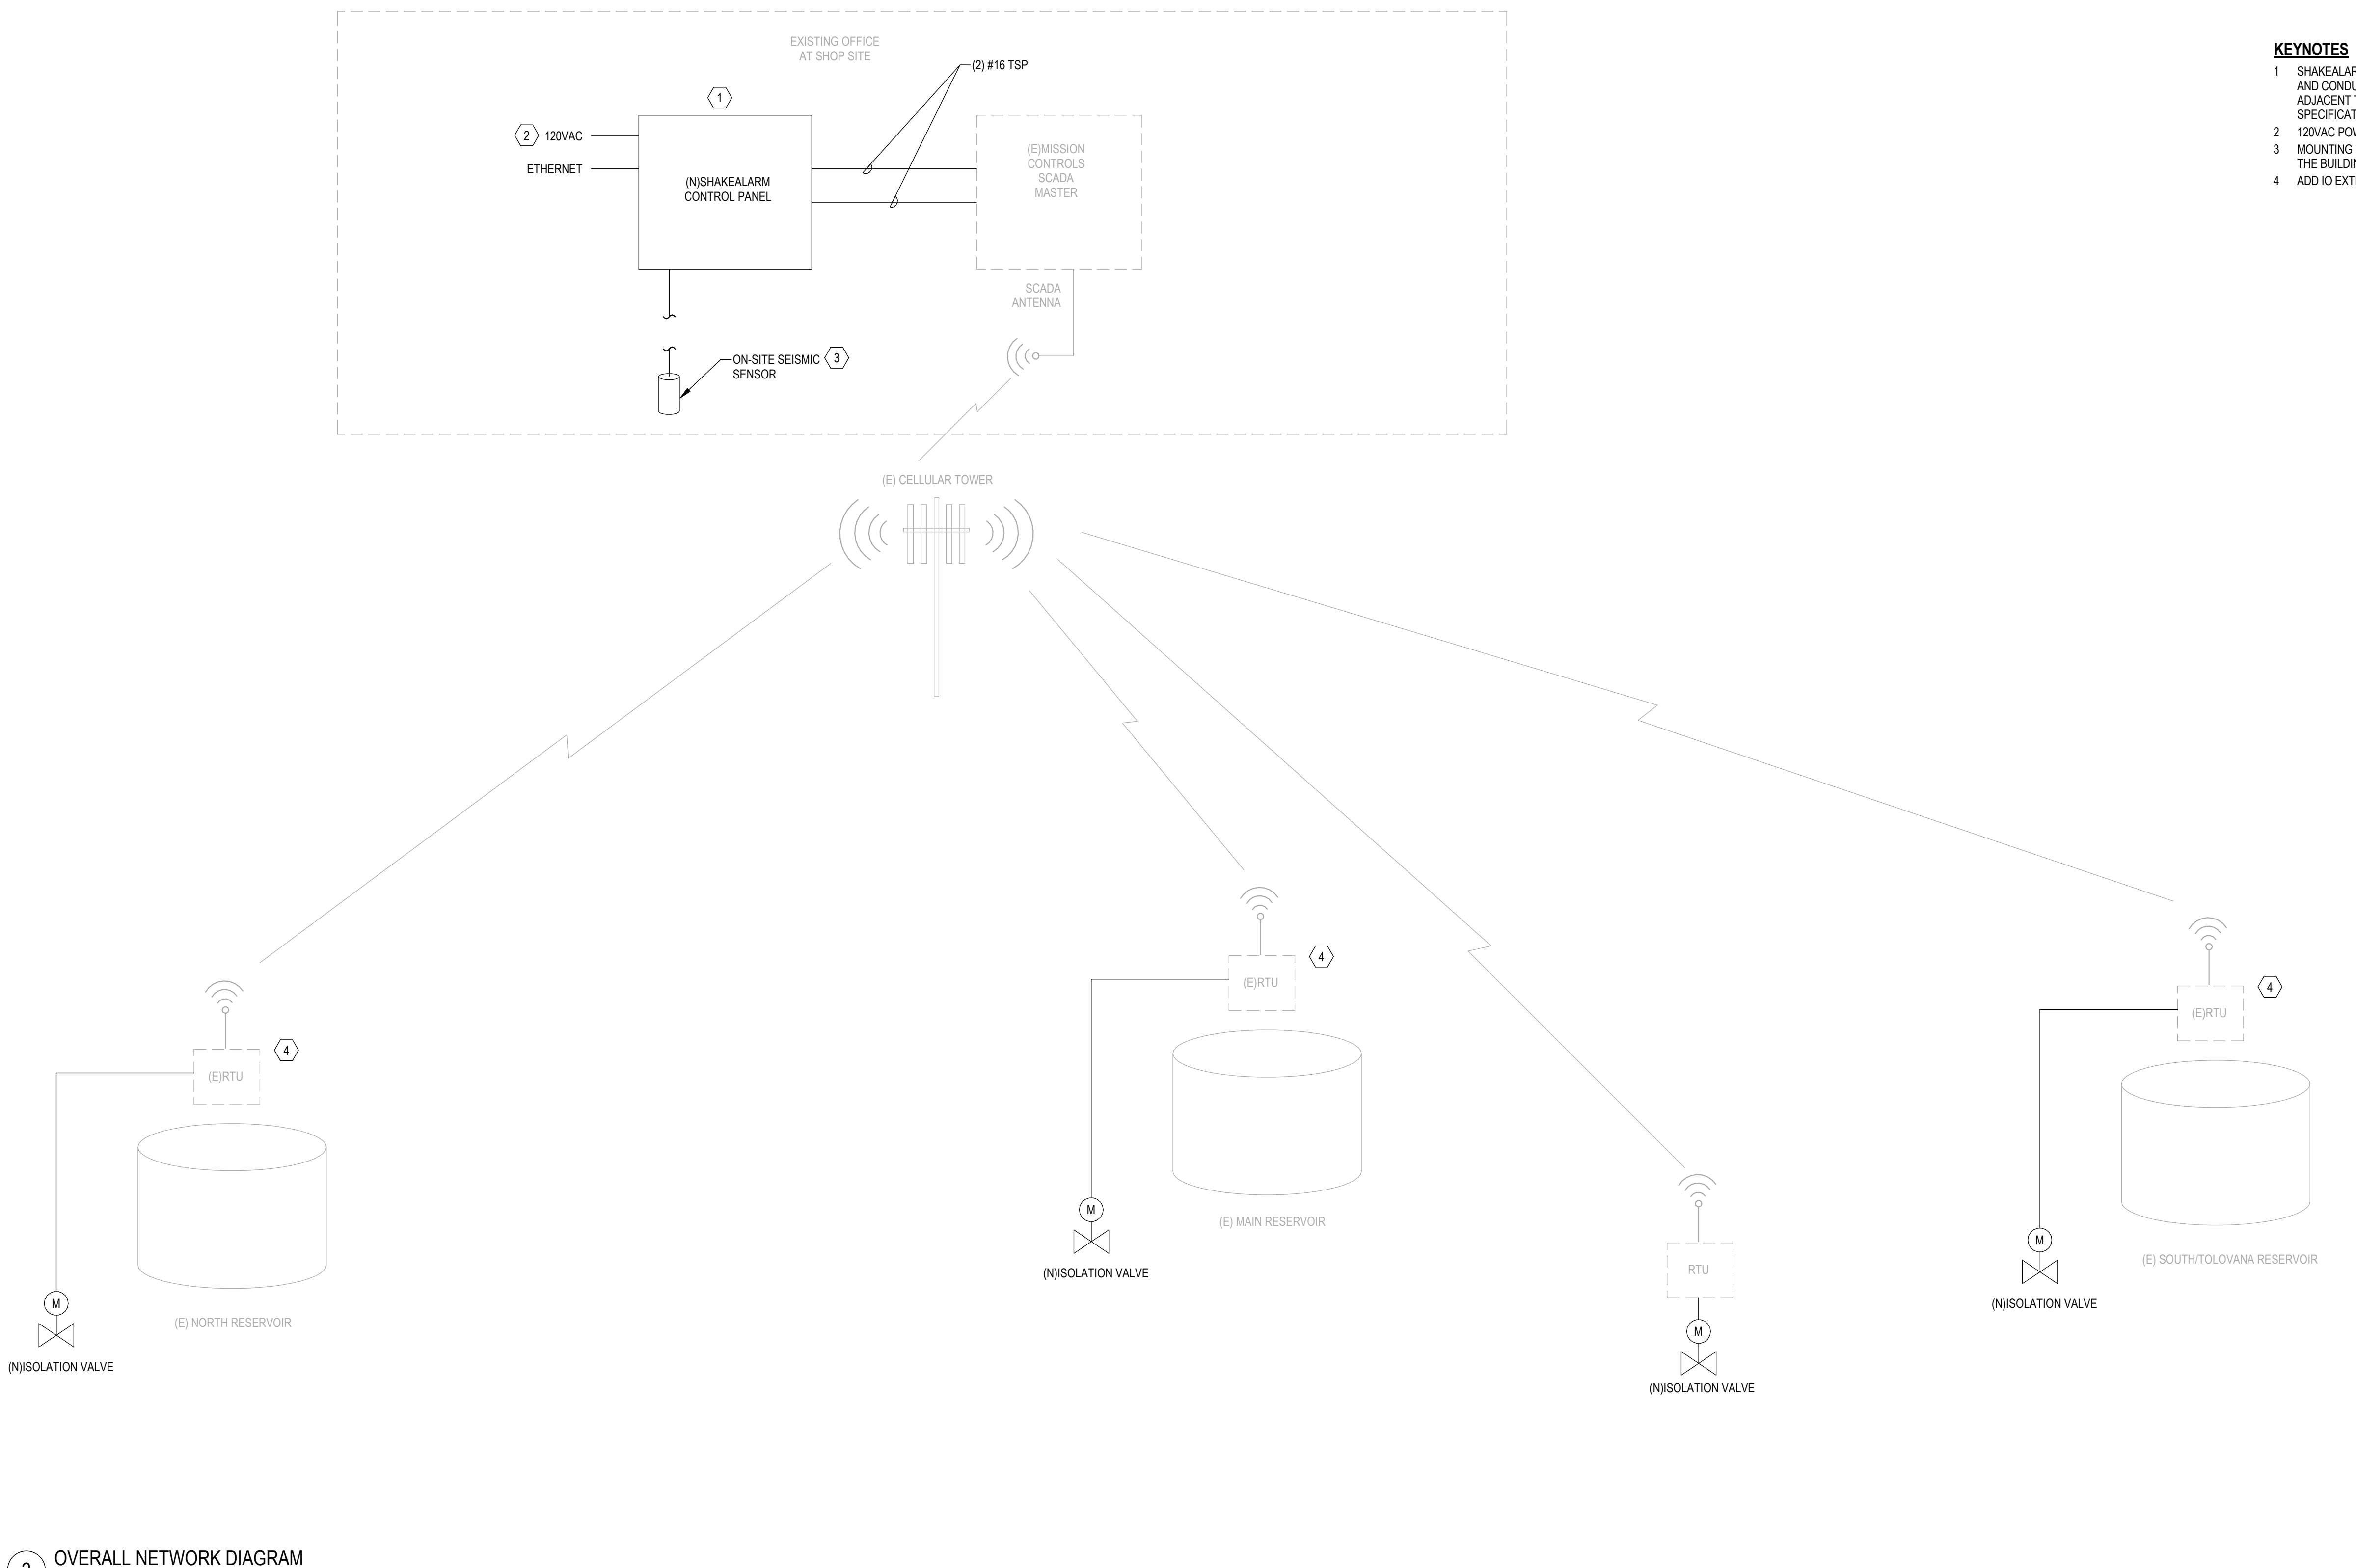

KEYNOTES


- 1 SHAKEALARM UNIT EQUIPMENT PROVIDED BY VARIUS INC. INSTALLATION, WIRING AND CONDUIT BY ELECTRICAL CONTRACTOR. MOUNT NEW SHAKEALARM UNIT ADJACENT TO EXISTING MISSION CONTROLS SCADA MASTER. SEE SPECIFICATIONS FOR FURTHER INFORMATION AND REQUIREMENTS.
- 2 120VAC POWER FROM NEAREST AVAILABLE CIRCUIT.
- 3 MOUNTING OF ON-SITE SEISMIC SENSOR SHALL BE INSTALLED ON AN ELEMENT OF THE BUILDING APPROVED BY ENGINEER.
- 4 ADD IO EXTENTION CARDS IF EXISTING RTUS DO NOT HAVE SUFFICIENT SPARES.

2 OVERALL NETWORK DIAGRAM
NOT TO SCALE



Know what's **below.**
Call before you dig.
CALL 2 BUSINESS DAYS BEFORE YOU DIG.
CAUTION UTILITY INFORMATION IS APPROXIMATE.
VERIFY ALL UTILITIES PRIOR TO CONSTRUCTION.

Revisions:

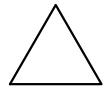

1	8/24/2023	ADDENDUM #1
4	8/28/2023	ADDENDUM #4

LINE IS 1" ON FULL
SCALE DRAWING



WINDSOR ENGINEERS

Ridgefield, WA
Duluth + Minneapolis, MN
www.windsorengineers.com
Project No: 20198.3
Copyright 2023 By Windsor Engineers, LLC
All Rights Reserved.



WATER RESILIENCY PROJECT
PHASE 1 - SEISMIC IMPROVEMENTS
CITY OF CANNON BEACH, OR 97110

ENGINEERING PLAN
Issue Date: 7/14/2023

Project Manager TWT
Drawn by JRB
Checked by SEW

SCADA NETWORK
DIAGRAM

E801